
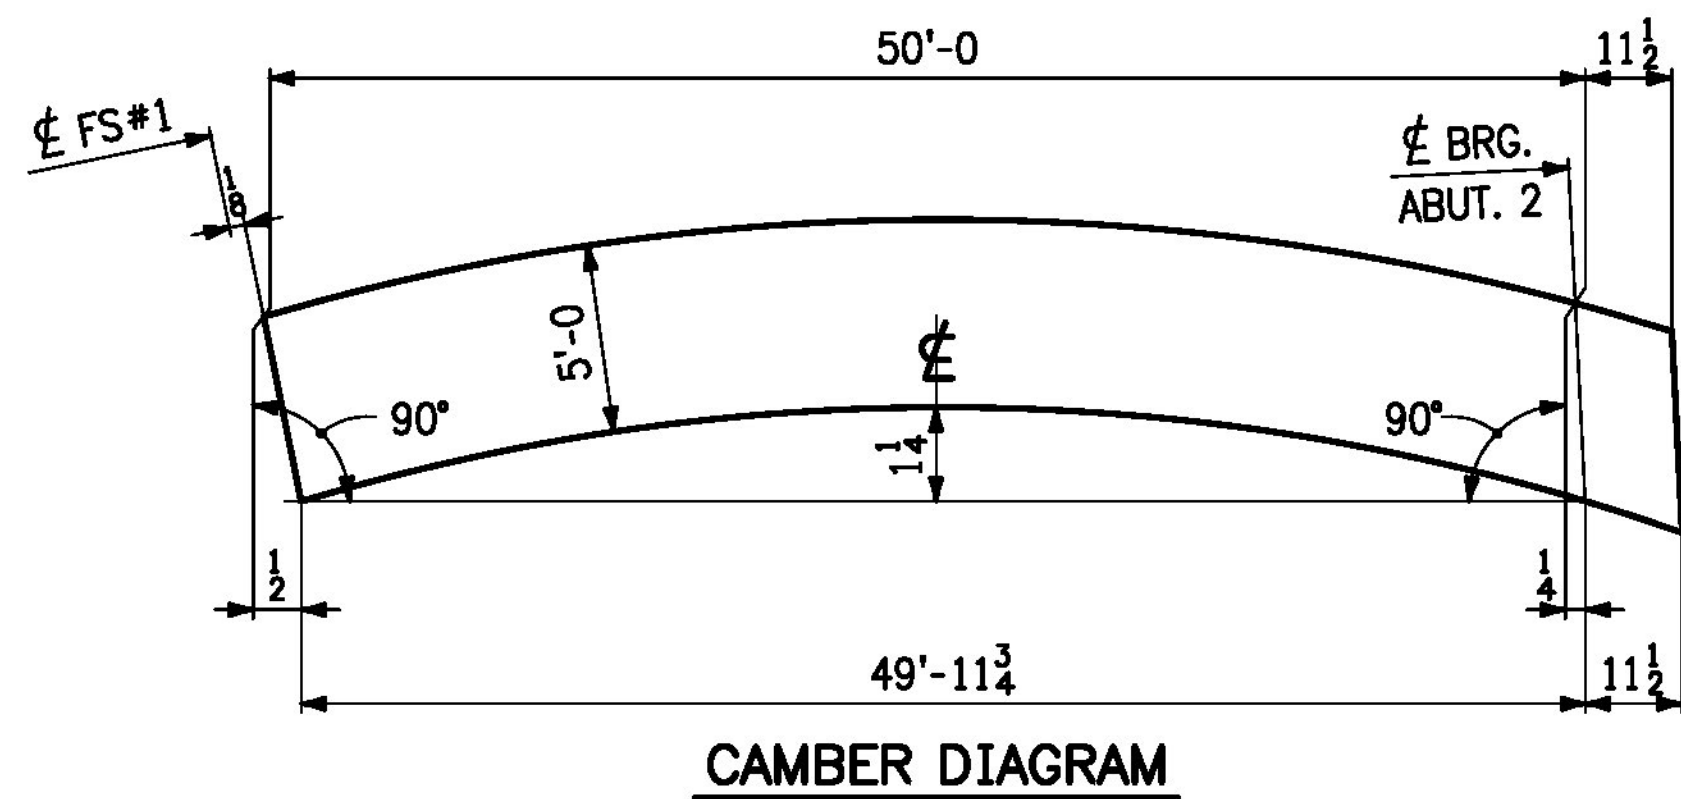


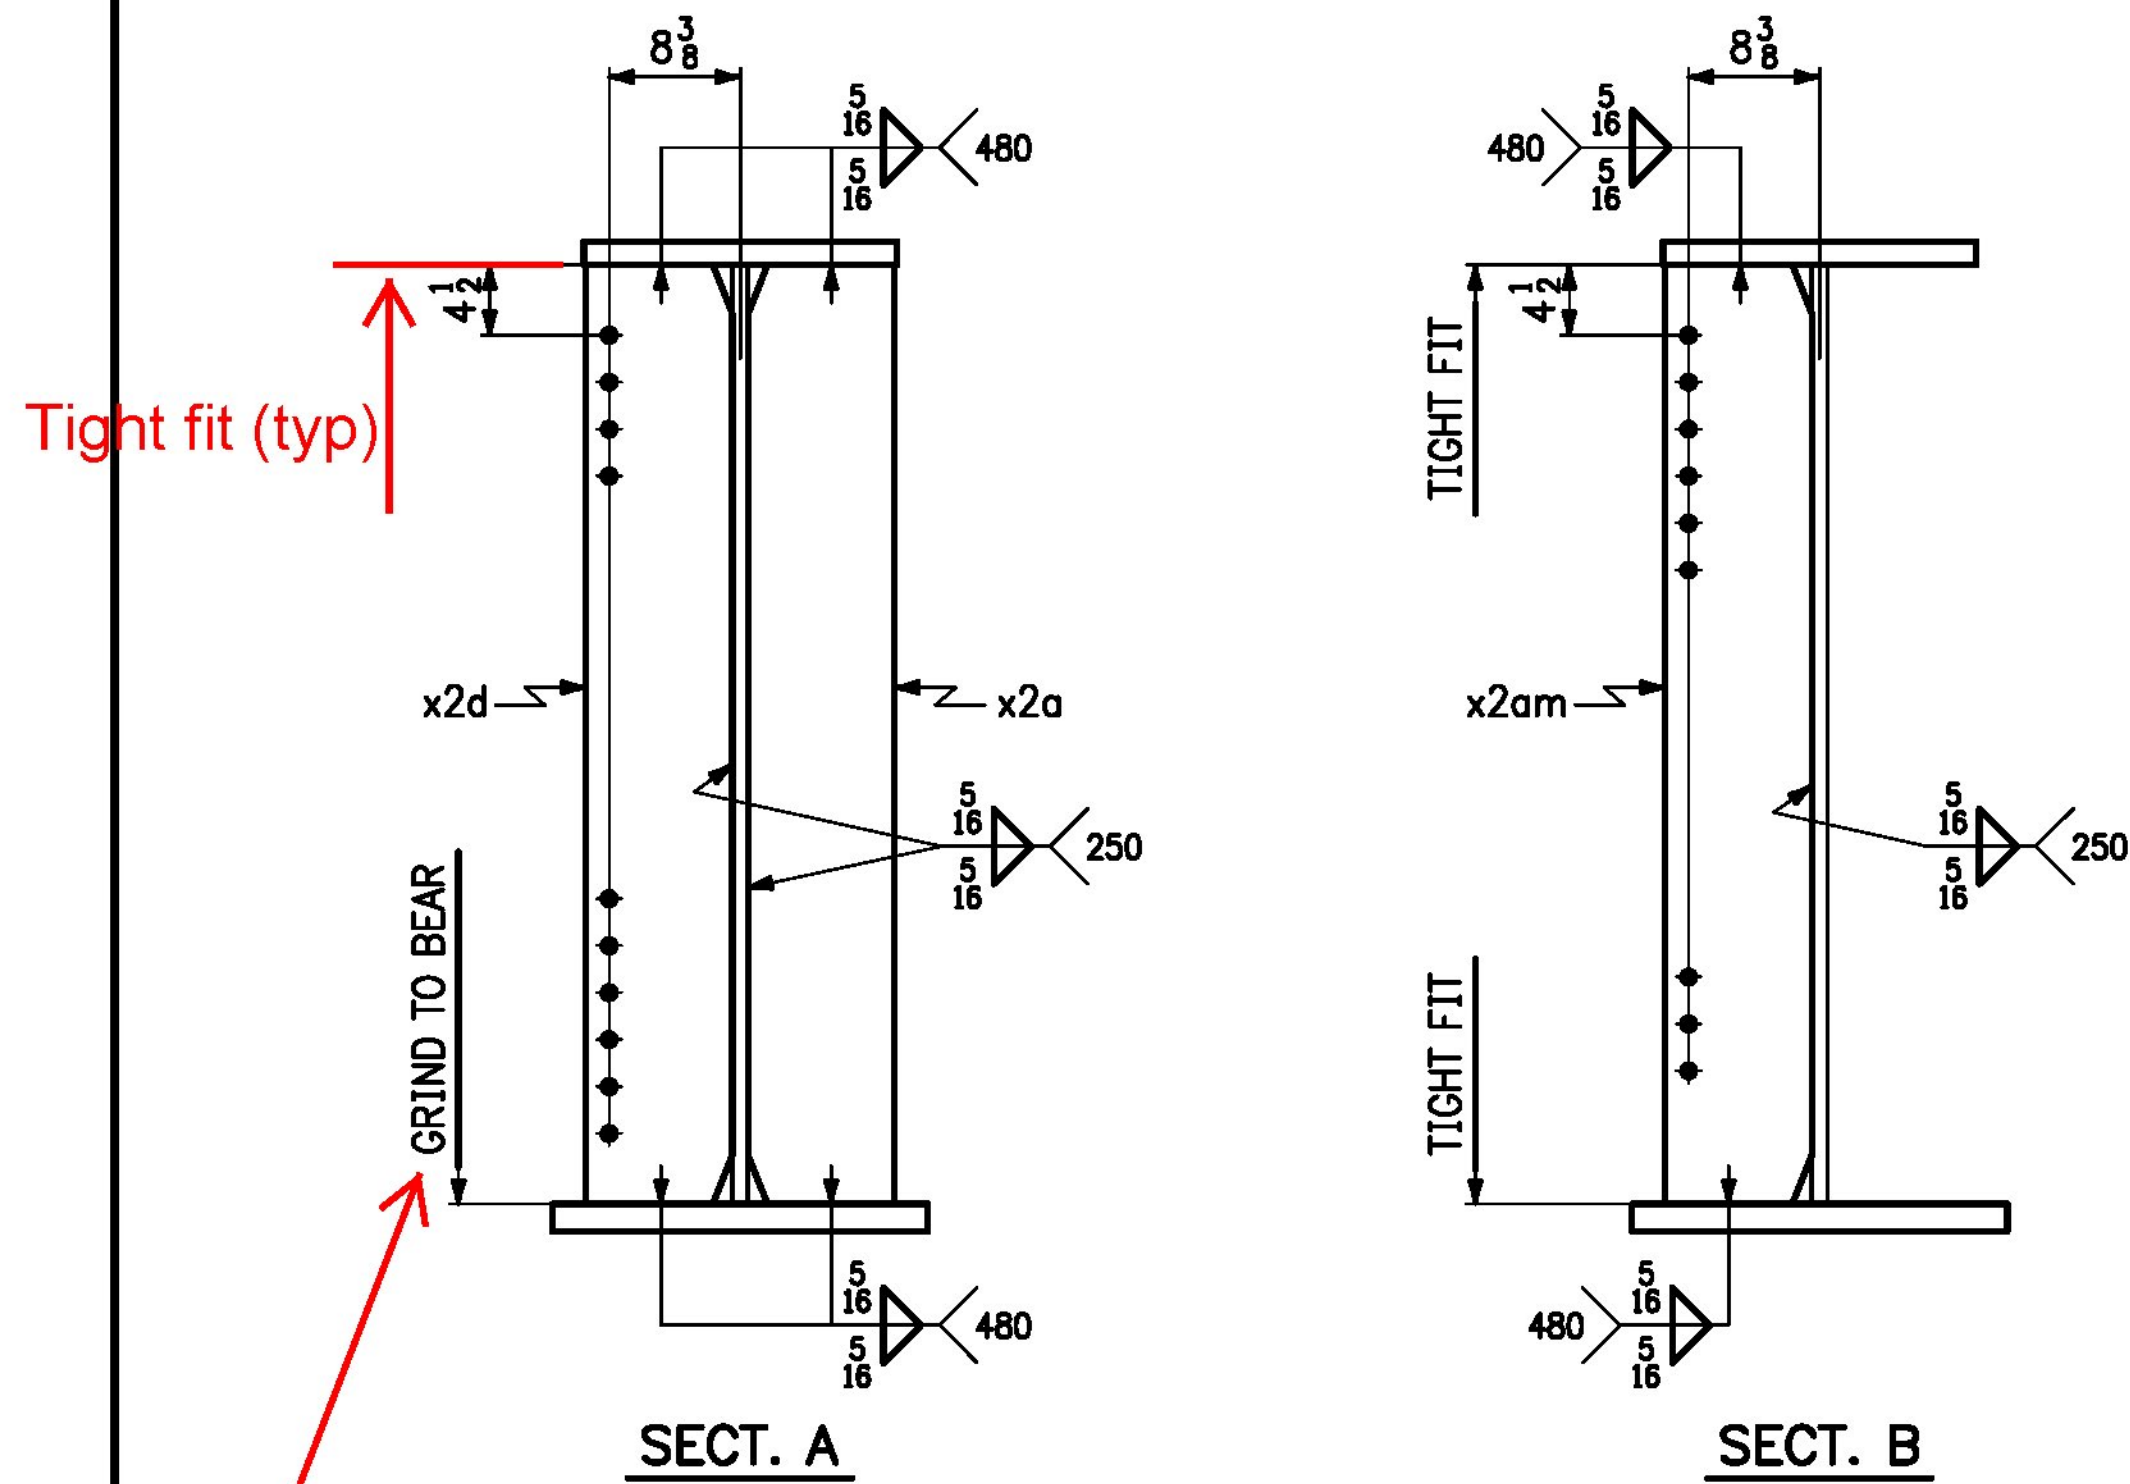

Vermont Agency of Transportation
RECEIVED
CK'D BY _____ OK'D BY Rob Young
April 4, 2016
RESUBMIT NO Approved AsNoted
BY Rob Young DATE 04/08/2016

Approved _____ X Approved As Noted
Rejected _____
This review is only for general conformance with the design concept and the information given in the Construction Documents. Corrections or comments made on the shop drawings during the review do not relieve the Contractor from compliance with the requirements of the Plans and Specifications. Review of a specific item shall not include review of an assembly of which an item is a component. The Contractor is responsible for dimensions to be confirmed and corrected at the job site; information that pertains solely to the fabrication process or to the means, methods, techniques, sequences and procedures of construction; coordination of the Work with that of other trades and performing all Work in a safe and satisfactory manner.
McFarland Johnson
Date 4/7/2016
By D. Kull

LINE	NO. OF PCS.	SHIP MARK	ASS'Y MARK	MATERIAL					REMARKS
				SHAPE	SECTION	LENGTH FT.	IN.	MATERIAL SPEC.	
1	1	6G1B			GIRDER				18,201 lbs.
2	1		wa	PL	3/4 x 60	50	11 3/8	M270-50W12	7806 lbs.
3	1		ta	PL	1 1/2 x 20	4	11 7/8	M270-50W	509 lbs.
4	1		tb	PL	1 1/2 x 20	45	11 5/8	M270-50W	3911 lbs.
5	1		ba	PL	1 1/4 x 24	4	11 1/8	M270-50W12	713 lbs.
6	1		bb	PL	1 1/4 x 24	45	11 3/8	M270-50W12	4691 lbs.
7									
8	1		x2a	PL	1 x 9 1/2	5	0	M270-50W	G1E 162 lbs.
9	1		x2d	PL	1 x 9 1/2	5	0	M270-50W	G1E 162 lbs.
10	3		x2am	PL	1/2 x 9 1/2	5	0	M270-50W	243 lbs.
11	1		x2av	PL	1/4 x 3 1/2	1	3 7/8	M270-50W	4 lbs.
12									
13									
NO.	DATE	REMARKS	BY
REVISIONS			
		CASCO BAY STEEL STRUCTURES ONE WALLACE AVENUE SOUTH PORTLAND, ME 04106 PHONE: 207-780-6722 FAX: 207-780-6726	
STRUCTURE VT 100 OVER MAD RIVER			
LOCATION TOWN OF WAITSFIELD, VERMONT			
PROJECT NO. PROJECT NO. BR 013-4(39) BRIDGE NO. 177			
ENGINEER MCFARLAND JOHNSON			
CUSTOMER A.L. ST. ONGE CONTRACTOR, INC.			
ITEM GIRDER ~ 6G1B			
SURFACE PREP. SSPC-SP10 OPEN HOLES 1/8"			
PAINT NONE			
APPROVAL	DRAWN VHM	1-28-16	SHEET NO. 6B
SHOP	CHECKED FM	3-9-16	JOB NO. 651