




NOTE:

GRADES SHOWN TO THE NEAREST
TENTH ARE EXISTING GRADE ALONG C

GRADES SHOWN TO THE NEAREST
HUNDREDTH ARE FINISH GRADE ALONG C

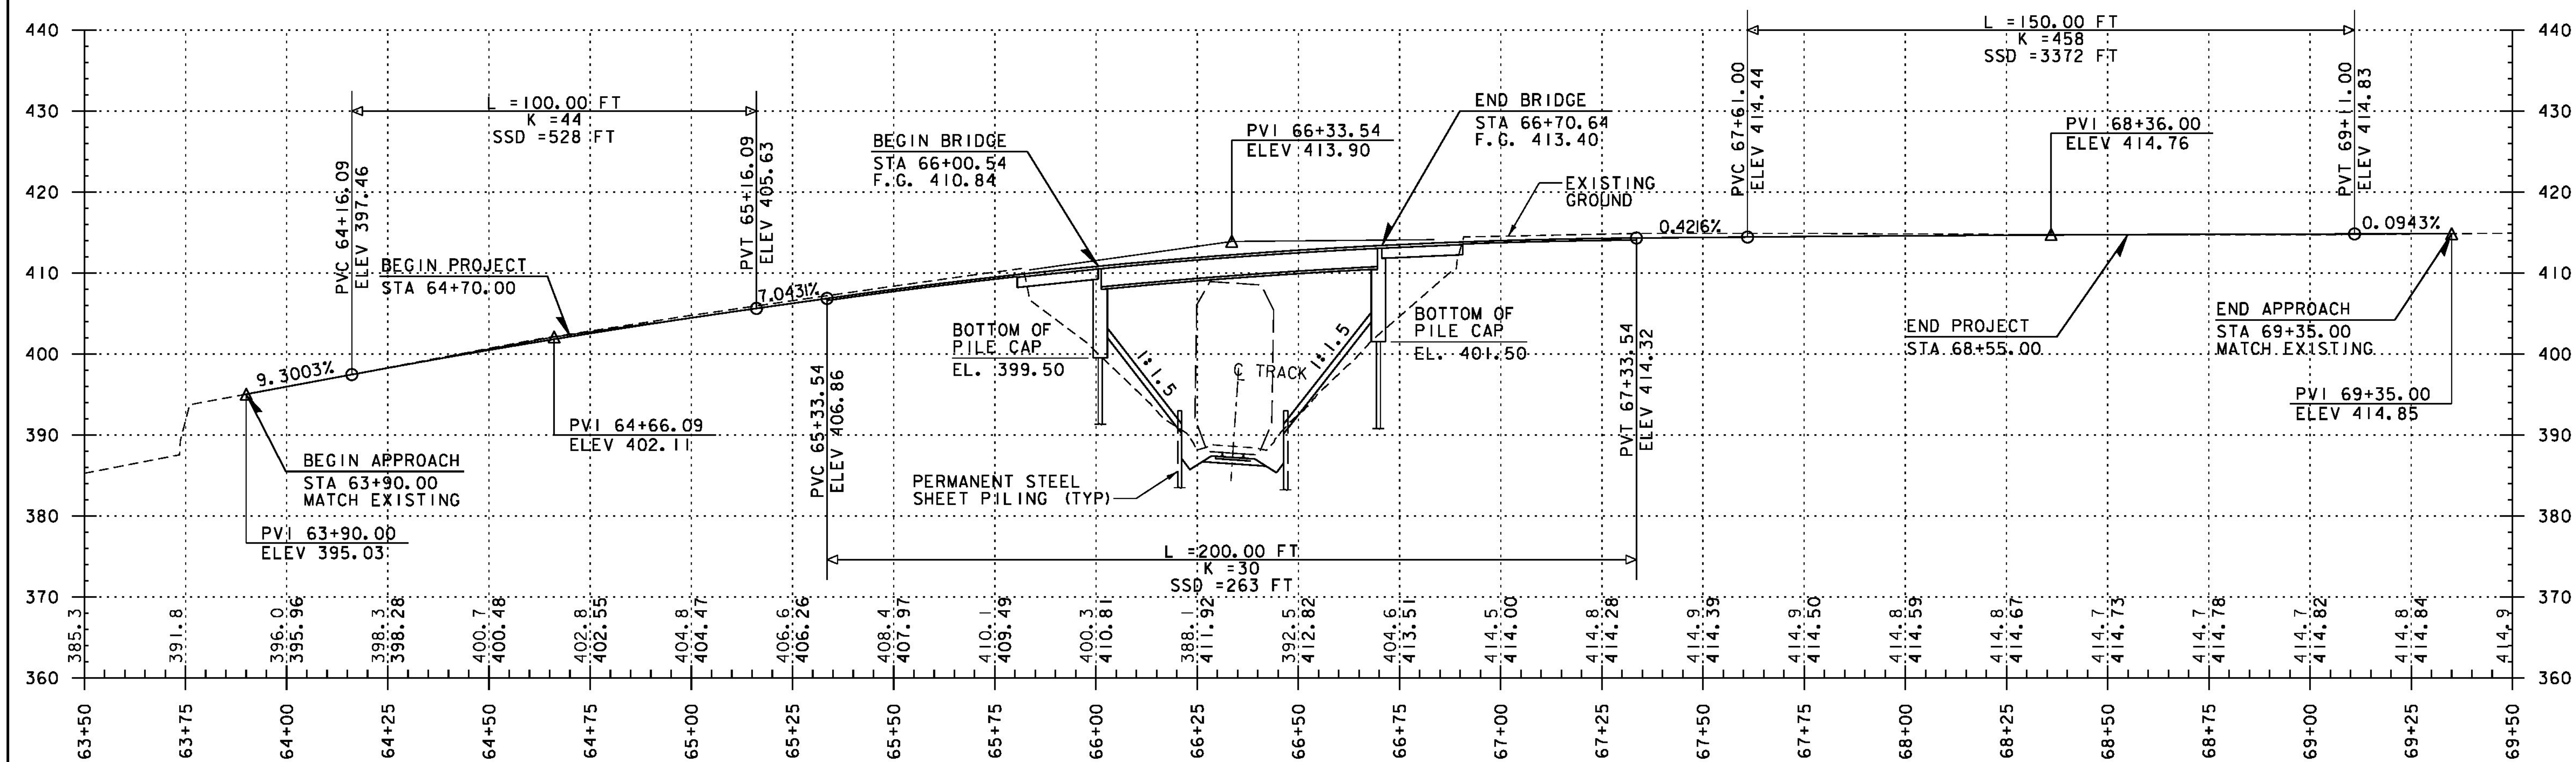

PROJECT NAME: CASTLETON	
PROJECT NUMBER: BRF 015-2(10)	
FILE NAME: z12b138pro.dgn	PLOT DATE: 9/19/2014
PROJECT LEADER: S.E. BURBANK	DRAWN BY: E.A. FIALA
DESIGNED BY: E.A. FIALA	CHECKED BY: S.E. BURBANK
ROADWAY PROFILE SHEET	SHEET 17 OF 82