

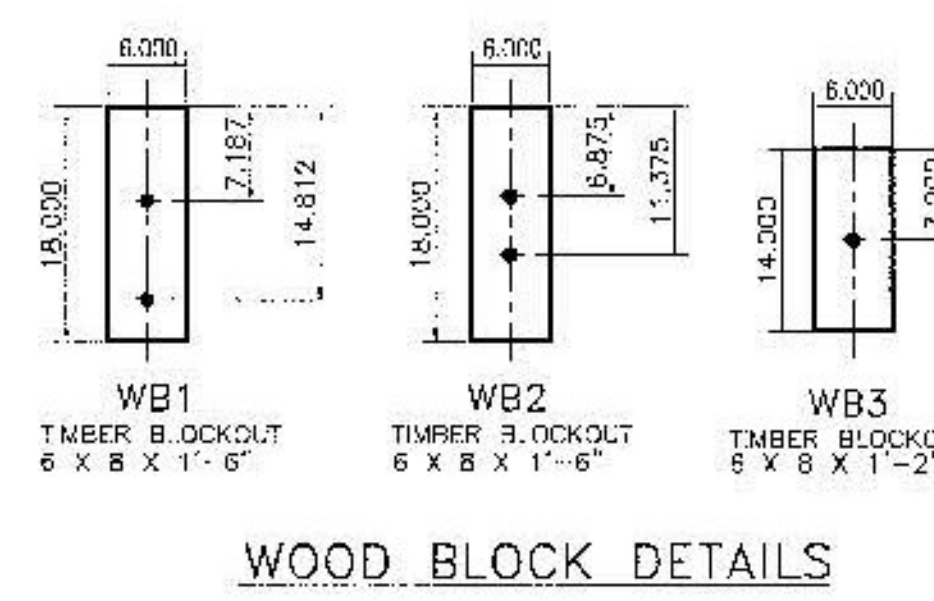
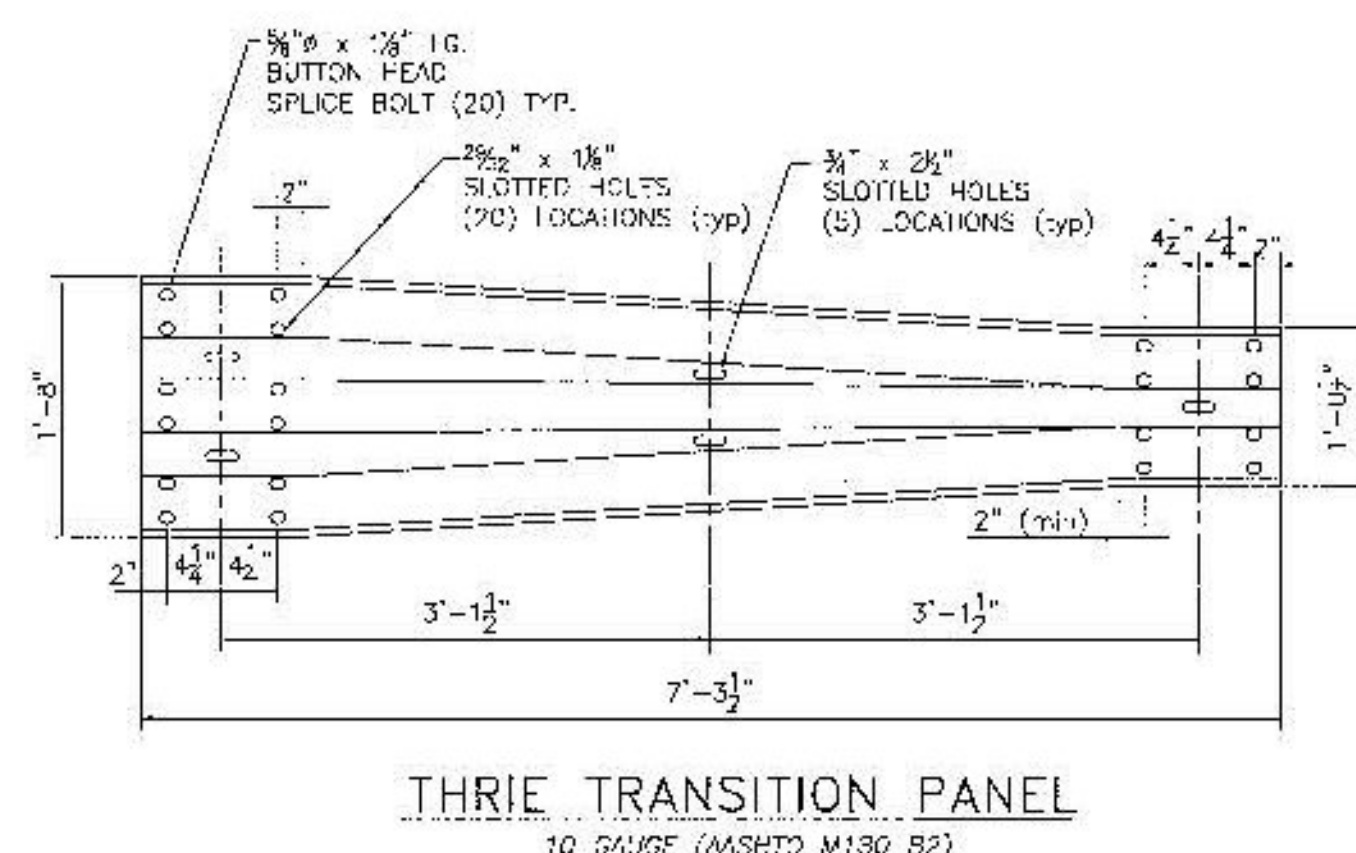
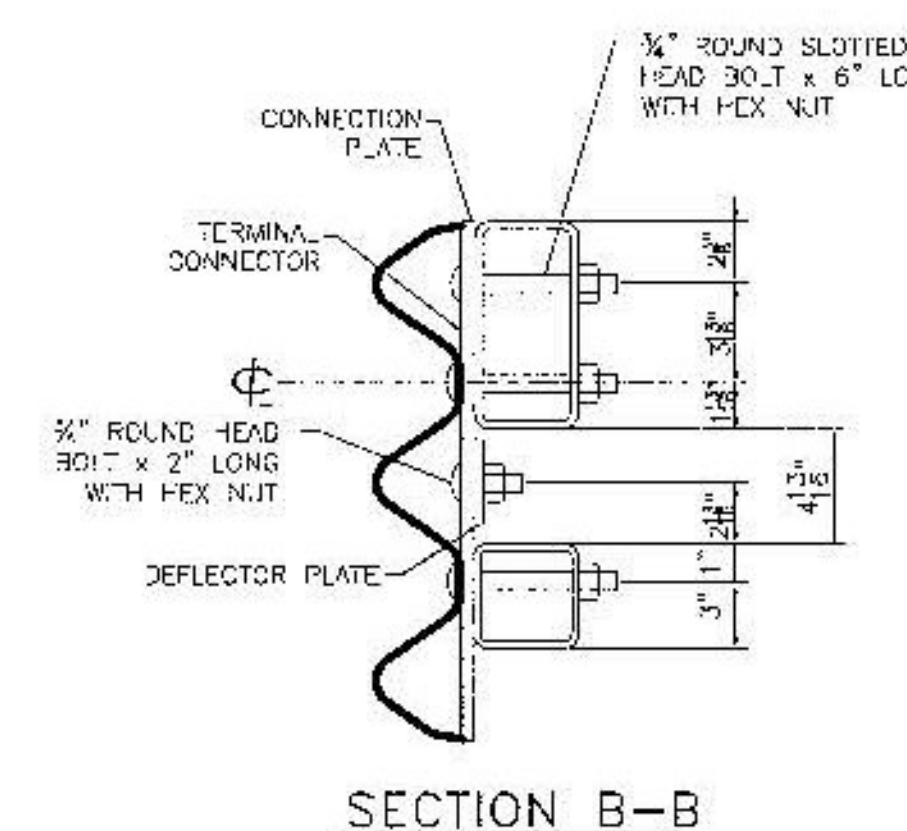
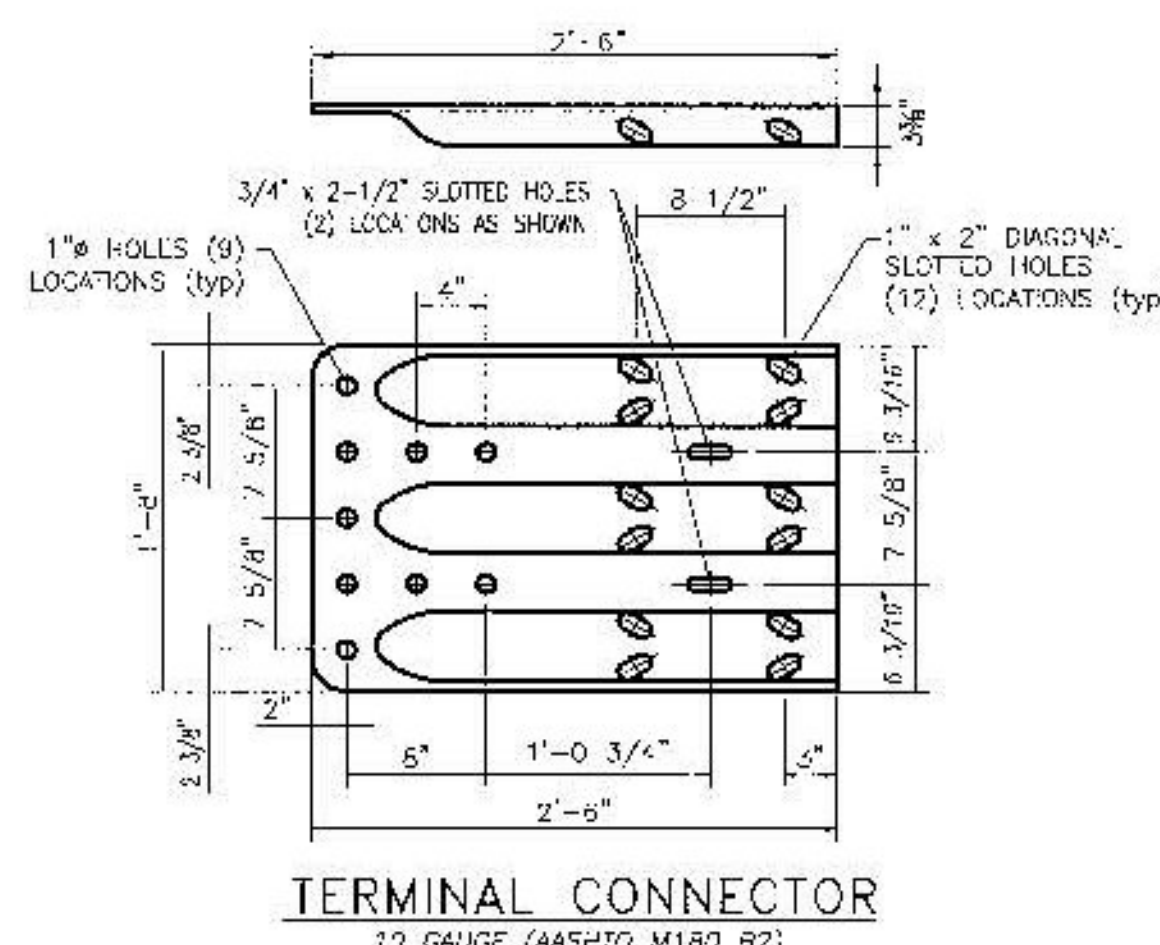
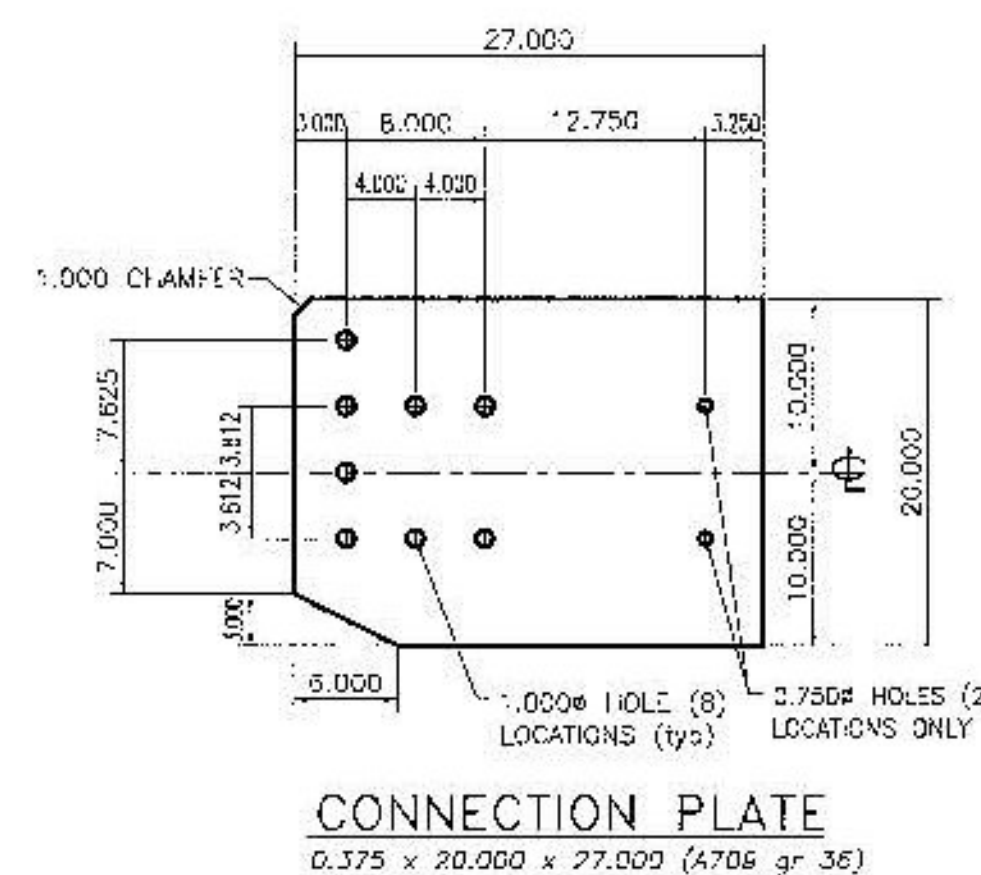
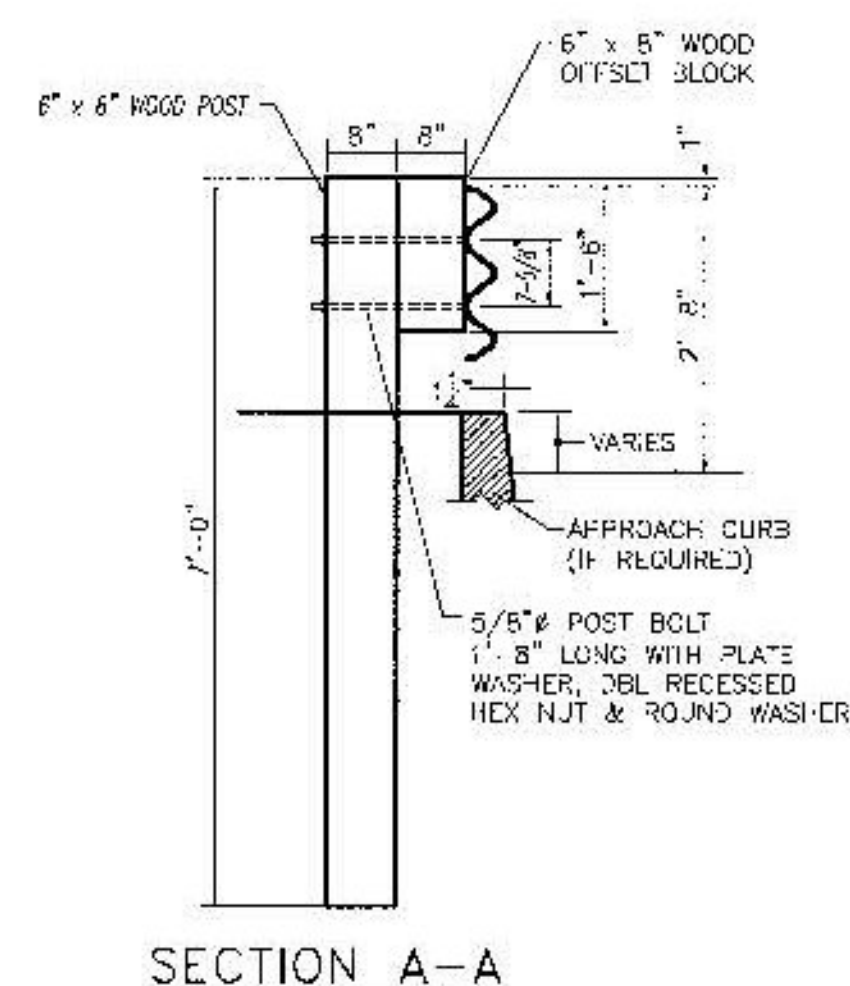
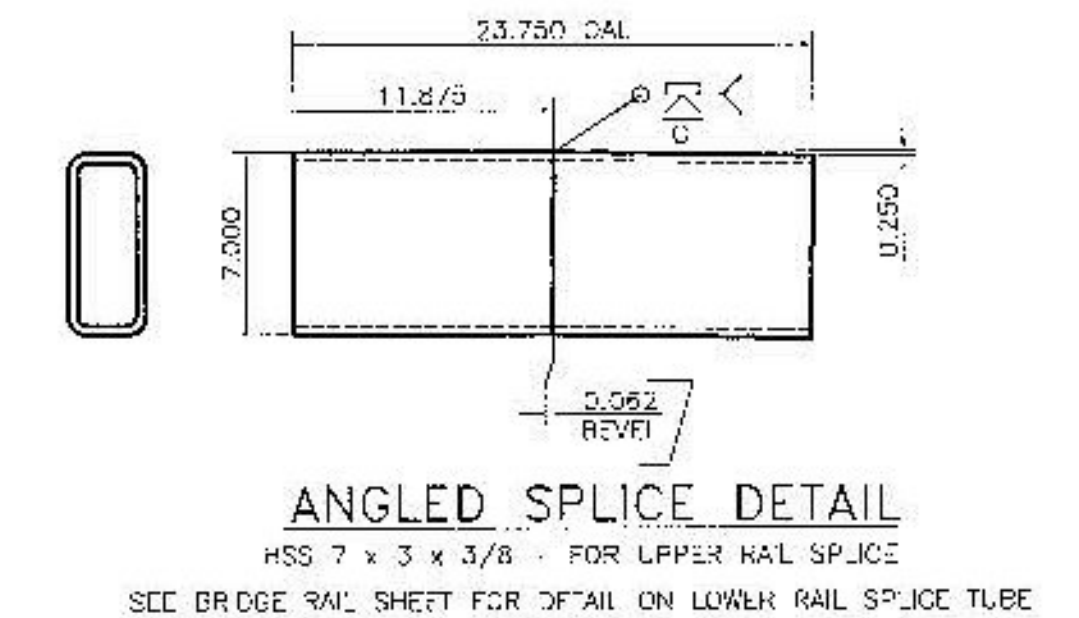
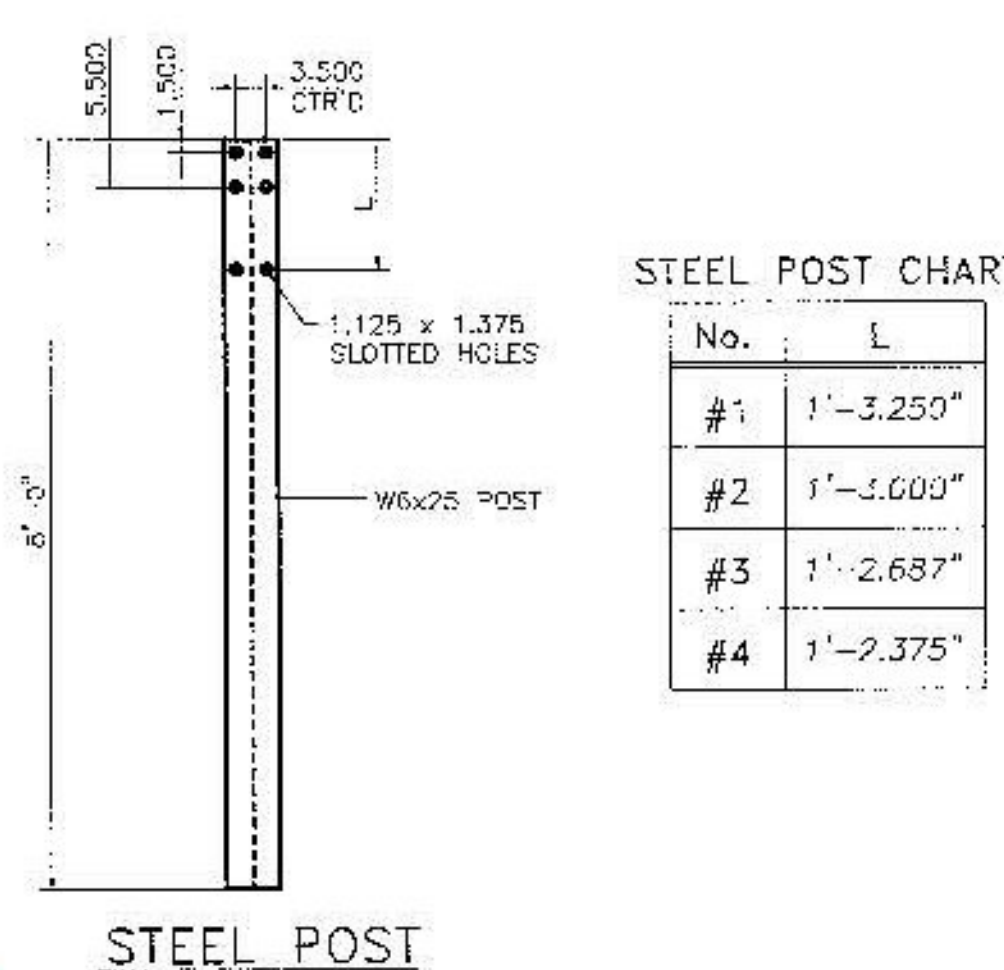


- NOTES:
1. PAYMENT FOR GUARDRAIL APPROACH SECTION - GALVANIZED 2 RAIL, SHALL INCLUDE THE TERMINAL CONNECTOR, THE CONNECTION PLATE, THE DEFLECTOR PLATE, RAIL, POSTS, BLOCKS AND ATTACHMENT HARDWARE.
 2. ALL APPROACH RAIL SPLICES SHALL BE LAPPED IN THE DIRECTION OF TRAFFIC FLOW.
 3. TUBE AND STEEL POST MATERIALS, DIMENSION SIZES AND NOTES SHALL BE THE SAME AS THOSE OF THE BRIDGE RAIL UNLESS OTHERWISE NOTED.
 4. APPROACH RAIL BOLTS SHALL BE ASTM A307 GRADE A AND NUTS SHALL BE ASTM A291 (ASIM 563 GRADE A OR BETTER (GALVANIZED). WASHERS SHALL BE ASTM F444.
 5. WELD TOP SPLICE BAR TO H1 WELD. USE COMPLETE PENETRATION W-F110 (B-L2).

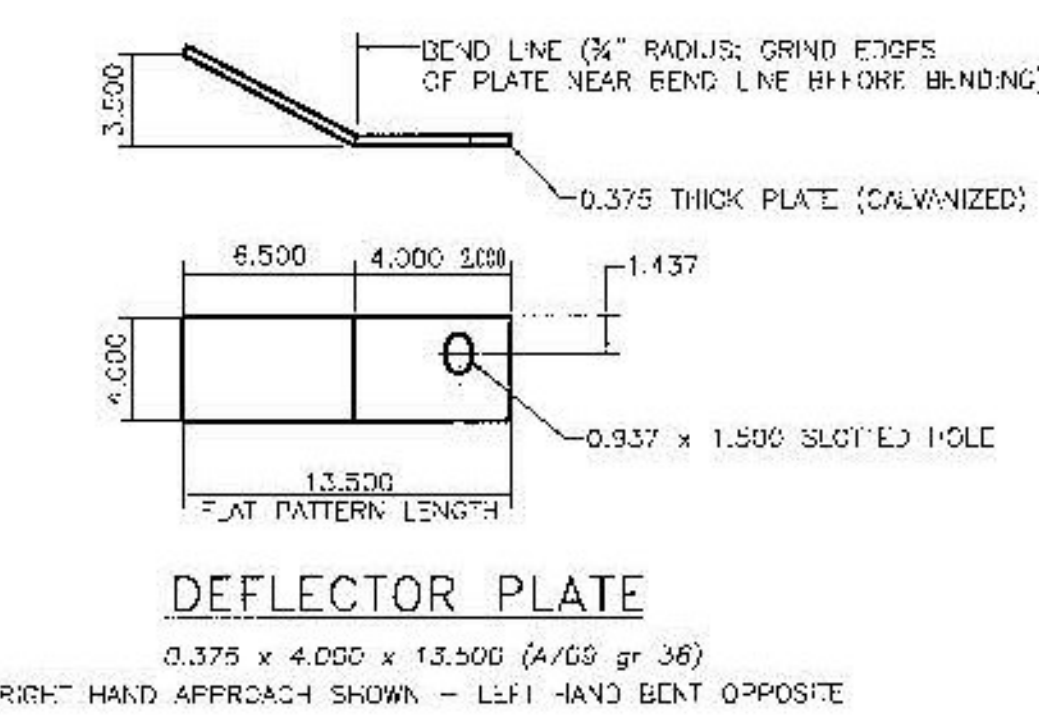

Vermont Agency of Transportation
RECEIVED
 ON: May 21, 2015
 and Checked for
CONFORMANCE
 BY: Jennifer Fitch DATE: 05/28/2015

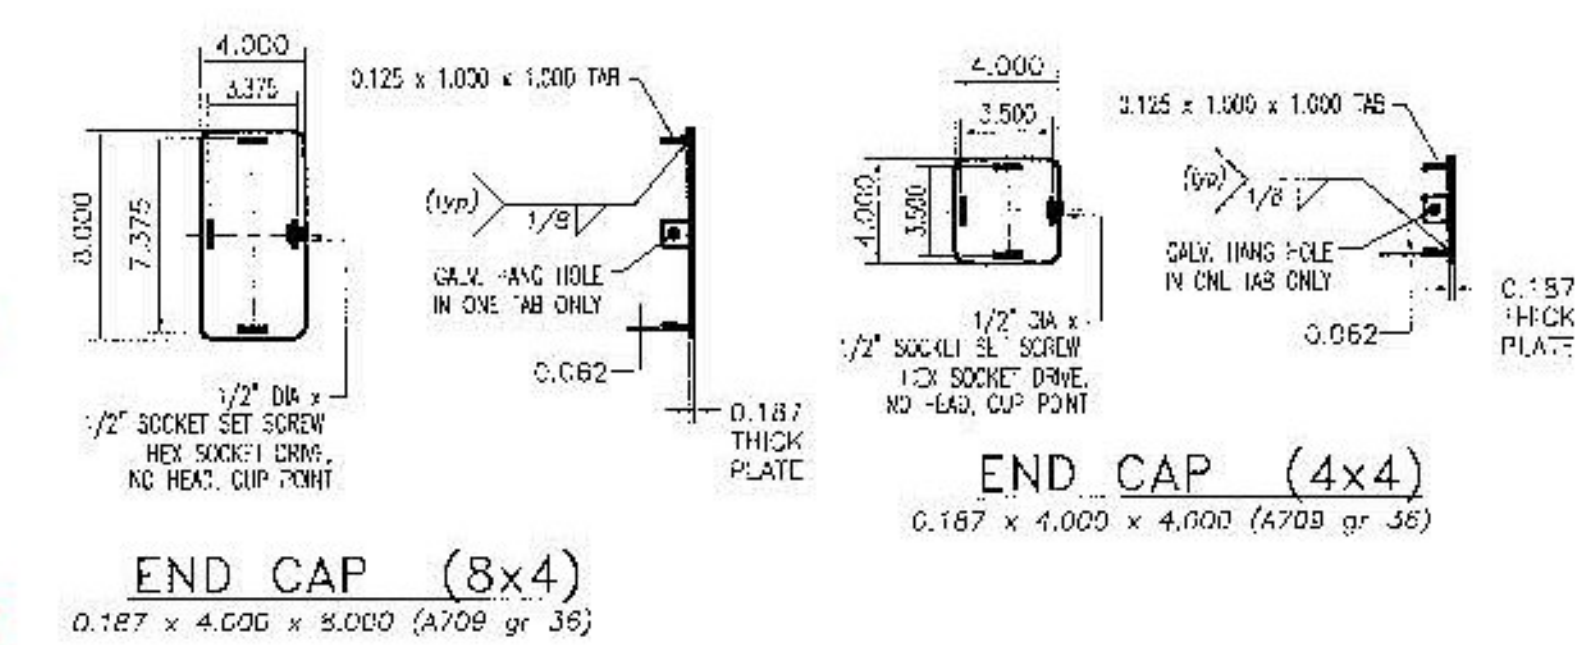

SHOP DRAWING REVIEW

REVIEWED AS REQUIRED BY THE CONSTRUCTION CONTRACT DOCUMENTS AND APPROVED, BUT ONLY FOR CONFORMANCE TO THE DESIGN CONCEPT OF THE WORK, AND SUBJECT TO FURTHER LIMITATIONS AND REQUIREMENTS CONTAINED IN THE CONSTRUCTION CONTRACT DOCUMENTS.

CORRECTIONS OR COMMENTS MADE ON THE SHOP DRAWINGS DURING THIS REVIEW DO NOT RELIEVE THE DESIGNER FROM LIABILITY FOR THE DESIGN AND SPECIFICATIONS. THE DESIGNER IS NOT RESPONSIBLE FOR REVIEW OF GENERAL CONFORMANCE WITH THE DESIGN CONCEPT OF THE PROJECT AND GENERAL CONFORMANCE WITH THE INFORMATION SHOWN IN THE CONTRACT DOCUMENTS. THE CONTRACTOR IS RESPONSIBLE FOR CONFIRMING AND CORRECTING ALL QUANTITIES AND DIMENSIONS; SELECTING FABRICATION PROCESSES AND TECHNIQUES OF CONSTRUCTION; COORDINATING HIS WORK WITH THAT OF ALL OTHER TRADING; AND PERFORMING HIS WORK IN A SAFE AND SATISFACTORY MANNER.

40 OX Drive
 Building 100, Suite 200
 South Burlington, VT 05403
 802.497.6100

Job Number: BRP-015-2(10)
 Reviewed by: S. L. Amosworth
 Date: May 26, 2015

HIGHWAY SAFETY CORP
 GLASTONBURY, CT
 860-633-9445

ITEM 525.33 BRIDGE RAILING, GALVANIZED 2 RAIL BOX BEAM (S-360A)
 ITEM 621.72 GUARDRAIL APPROACH SECTION, GALVANIZED 2 RAIL BOX BEAM (S-360B)
 BRN' 015-2(10)
 VT ROUTE 30 - BRIDGE 93
 TOWN OF CASTLETON, RUTLAND COUNTY VT

CERTIFIED FABRICATOR

2043

3 of 4