



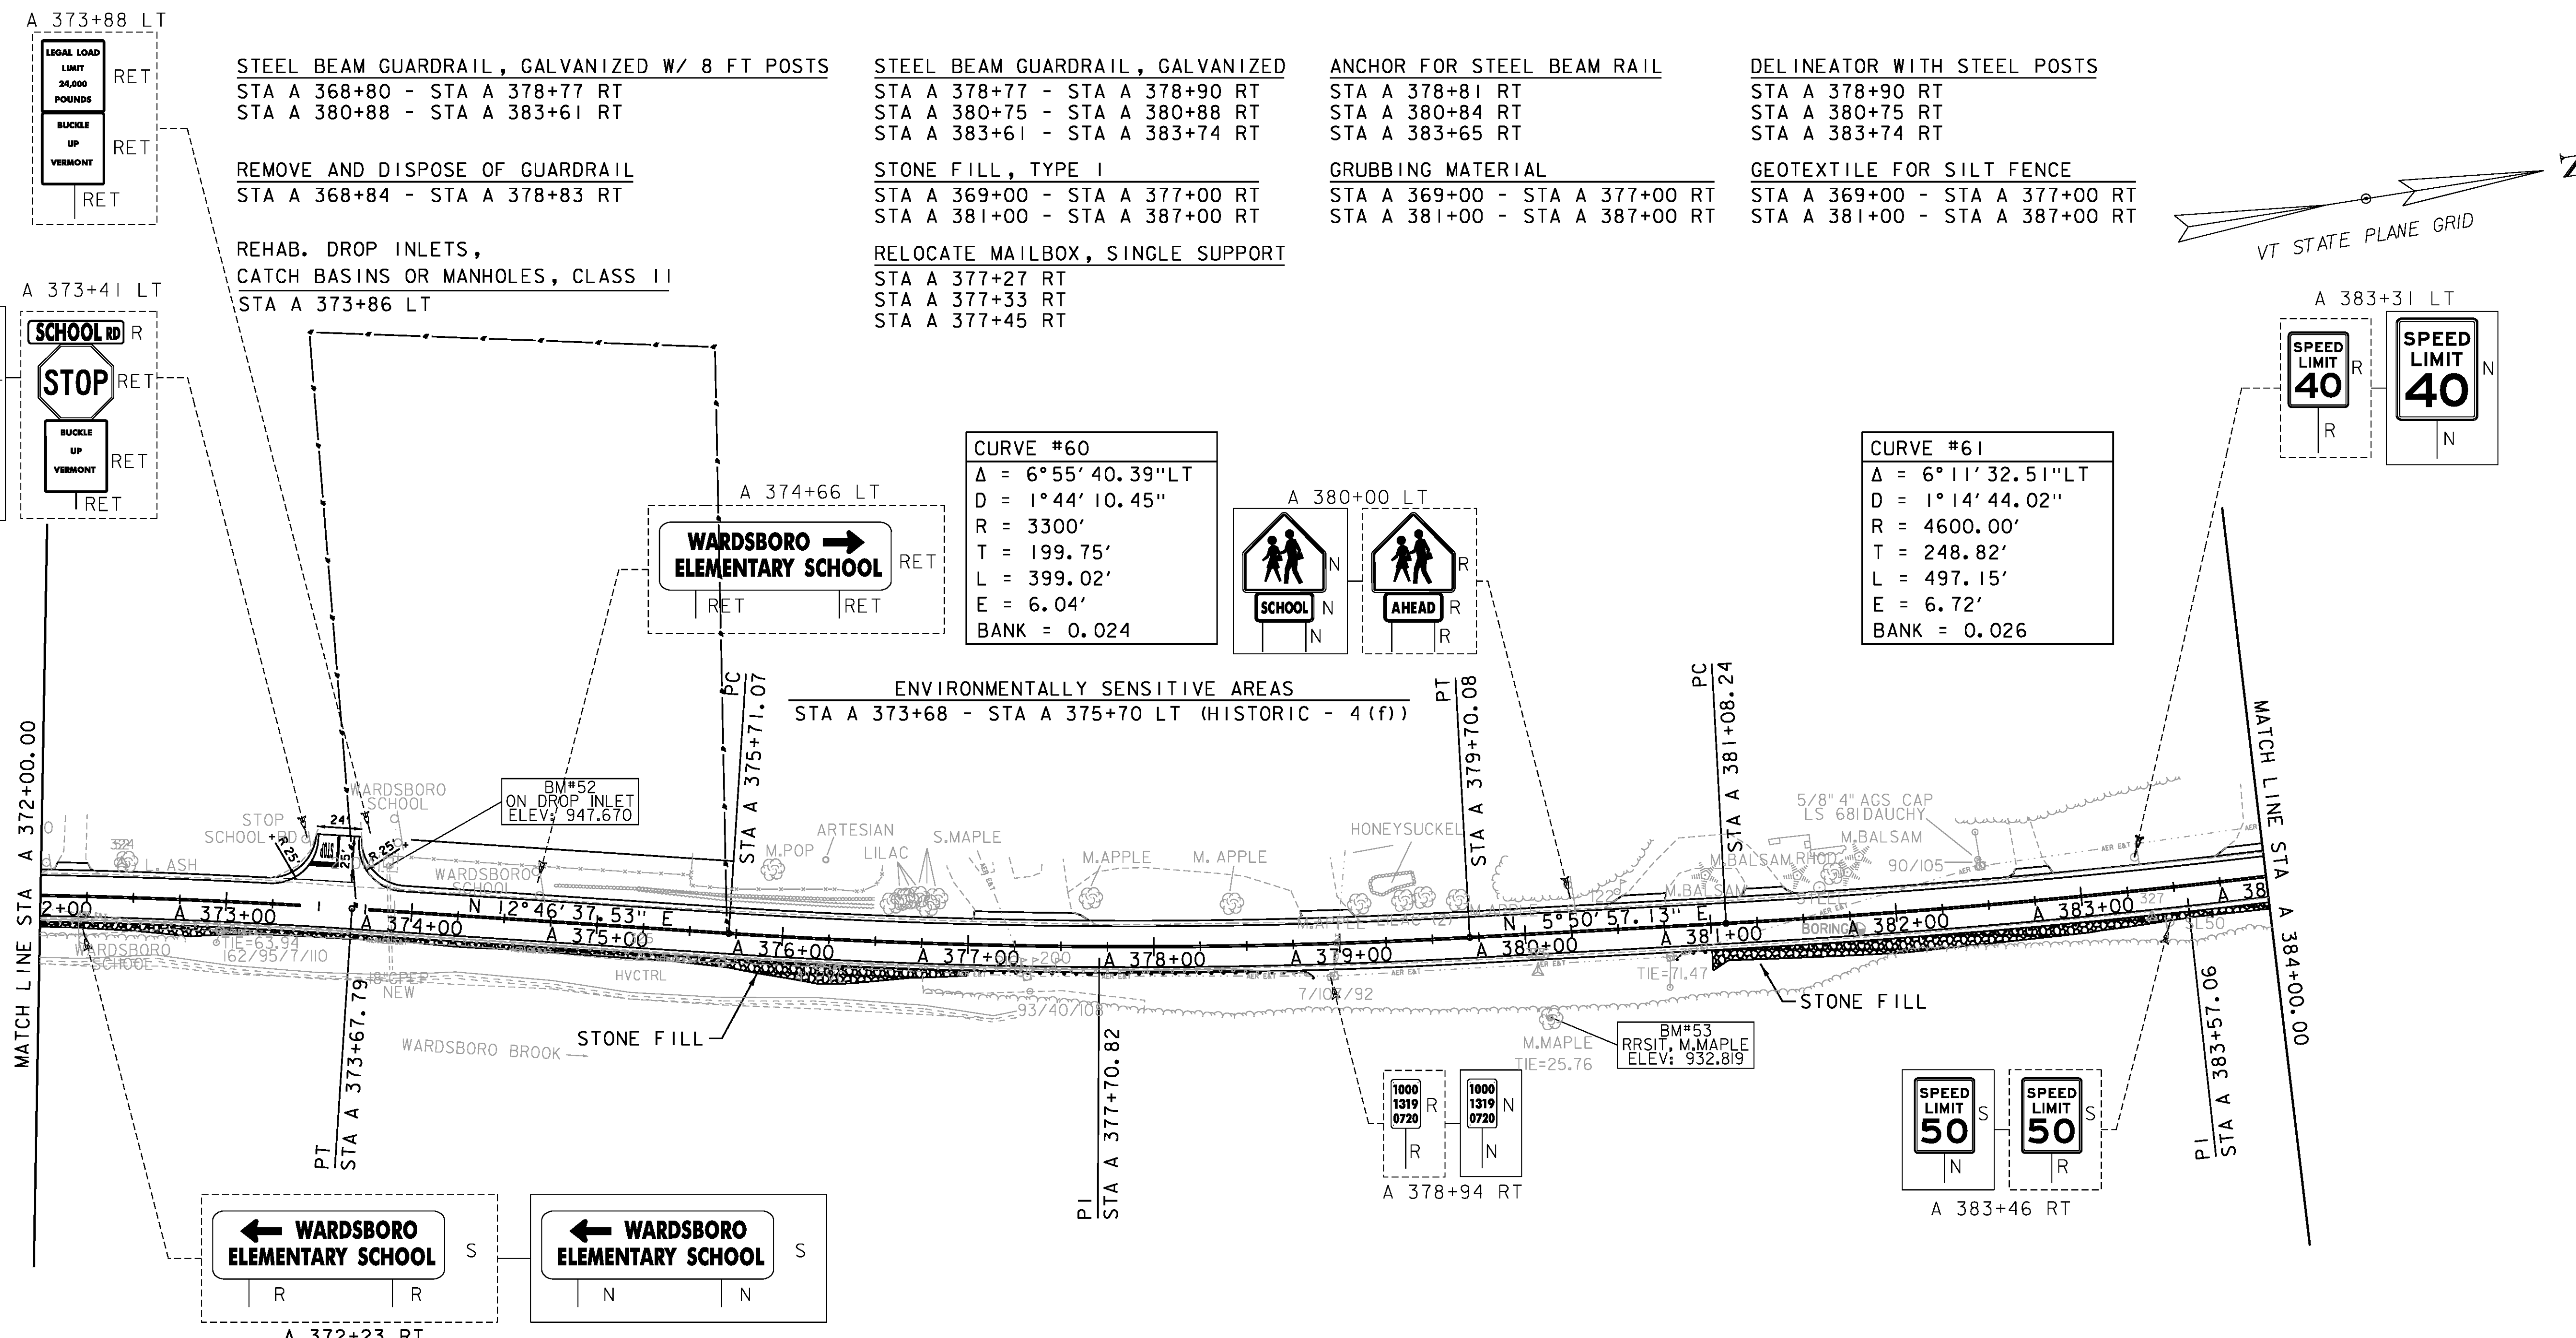






- LEGAL LOAD LIMIT 24,000 POUNDS RET
- BUCKLE UP VERMONT RET
- STEEL BEAM GUARDRAIL, GALVANIZED W/ 8 FT POSTS
STA A 368+80 - STA A 378+77 RT
STA A 380+88 - STA A 383+61 RT
- REMOVE AND DISPOSE OF GUARDRAIL
STA A 368+84 - STA A 378+83 RT
- REHAB. DROP INLETS, CATCH BASINS OR MANHOLES, CLASS II
STA A 373+86 LT
- STEEL BEAM GUARDRAIL, GALVANIZED
STA A 378+77 - STA A 378+90 RT
STA A 380+75 - STA A 380+88 RT
STA A 383+61 - STA A 383+74 RT
- STONE FILL, TYPE I
STA A 369+00 - STA A 377+00 RT
STA A 381+00 - STA A 387+00 RT
- RELOCATE MAILBOX, SINGLE SUPPORT
STA A 377+27 RT
STA A 377+33 RT
STA A 377+45 RT
- ANCHOR FOR STEEL BEAM RAIL
STA A 378+81 RT
STA A 380+84 RT
STA A 383+65 RT
- GRUBBING MATERIAL
STA A 369+00 - STA A 377+00 RT
STA A 381+00 - STA A 387+00 RT
- DELINEATOR WITH STEEL POSTS
STA A 378+90 RT
STA A 380+75 RT
STA A 383+74 RT
- GEOTEXTILE FOR SILT FENCE
STA A 369+00 - STA A 377+00 RT
STA A 381+00 - STA A 387+00 RT

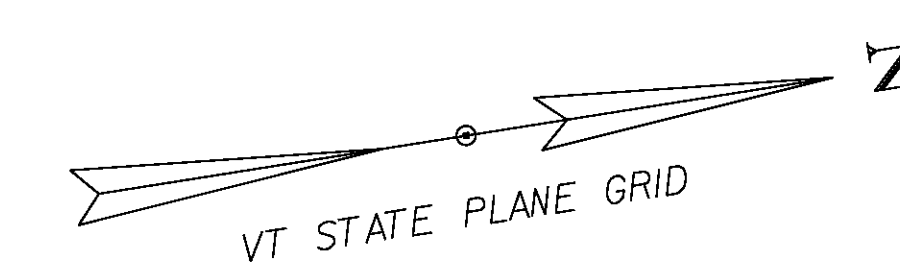

CURVE #60
Δ = 6°55'40.39"LT
D = 1°44'10.45"
R = 3300'
T = 199.75'
L = 399.02'
E = 6.04'
BANK = 0.024

CURVE #61
Δ = 6°11'32.51"LT
D = 1°14'44.02"
R = 4600.00'
T = 248.82'
L = 497.15'
E = 6.72'
BANK = 0.026

ENVIRONMENTALLY SENSITIVE AREAS
STA A 373+68 - STA A 375+70 LT (HISTORIC - 4(f))

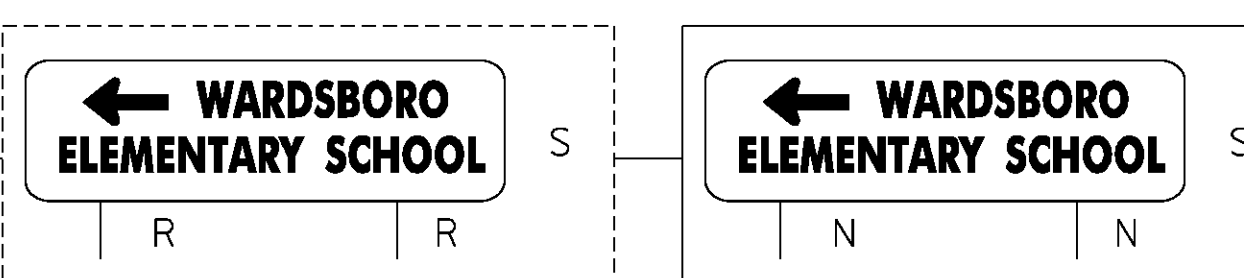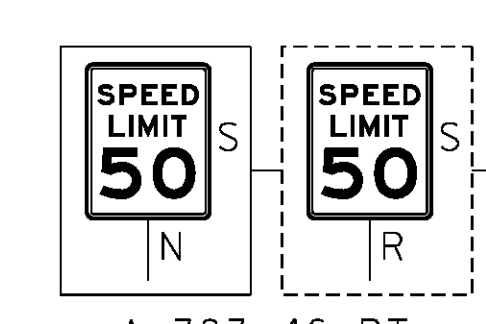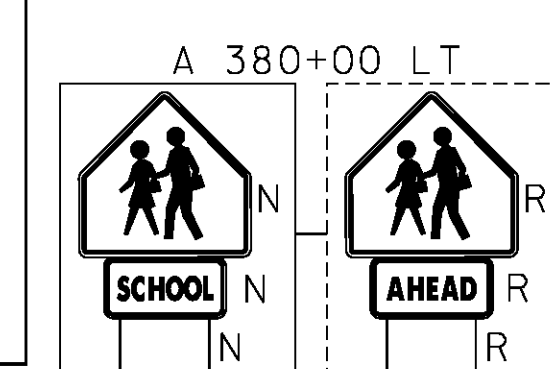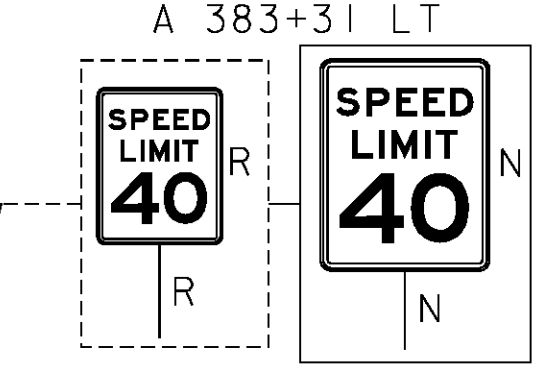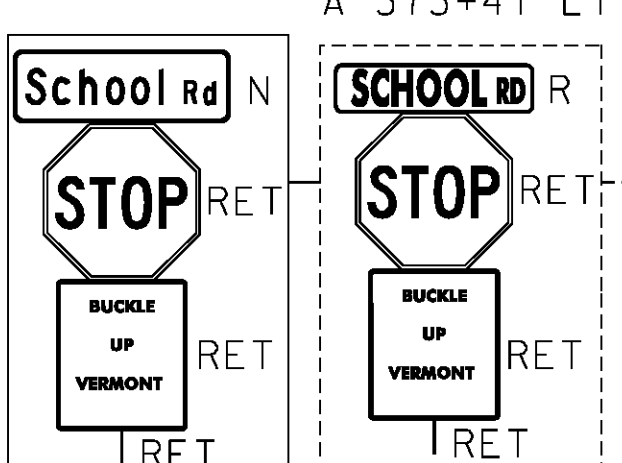

- DURABLE 4 INCH WHITE LINE (SEE OPTION ITEMS)
STA A 343+77 - STA A 373+47 (SOLID LT)
STA A 373+69 - STA B 119+24 (SOLID LT)
STA A 346+96 - STA B 118+68 (SOLID RT)
- DURABLE 4 INCH YELLOW LINE (SEE OPTION ITEMS)
STA A 346+97 - STA A 373+40 (SOLID LT + RT)
STA 373+58 LT (CENTERLINES TH #45)
STA A 373+76 - STA B 118+58 (SOLID LT + RT)
- TEMPORARY 4 INCH WHITE LINE
STA A 343+77 - STA A 373+47 (SOLID LT)
STA A 373+69 - STA B 119+24 (SOLID LT)
STA A 346+96 - STA B 118+68 (SOLID RT)
- TEMPORARY 4 INCH YELLOW LINE
STA A 346+97 - STA A 373+40 (SOLID LT + RT)
STA A 373+58 LT (CENTERLINES TH #45)
STA A 373+76 - STA B 118+58 (SOLID LT +RT)
- DURABLE LETTER OR SYMBOL (SEE OPTION ITEMS)
STA A 373+52 LT "STOP"
STA A 380+25 LT "SCHOOL"
- DURABLE 24 INCH STOP BAR (SEE OPTION ITEMS)
STA A 373+52 LT



- SIGN LEGEND**
- R = REMOVE
 - S = SALVAGE
 - N = NEW
 - RET = RETAIN
 - T&T = THINNING & TRIMMING
 - B-B = BACK TO BACK
 - EXISTING =
 - NEW =

PROJECT NAME:	WARDSBORO-JAMAICA
PROJECT NUMBER:	ER STP 013-K(17)
FILE NAME:	d12b236_bdr.dgn
PROJECT LEADER:	K. UPMAL
DESIGNED BY:	B. KIPP
PLAN SHEET	32
PLOT DATE:	2/26/2014
DRAWN BY:	B. KIPP
CHECKED BY:	A. KEMPTON
SHEET	115 OF 444