



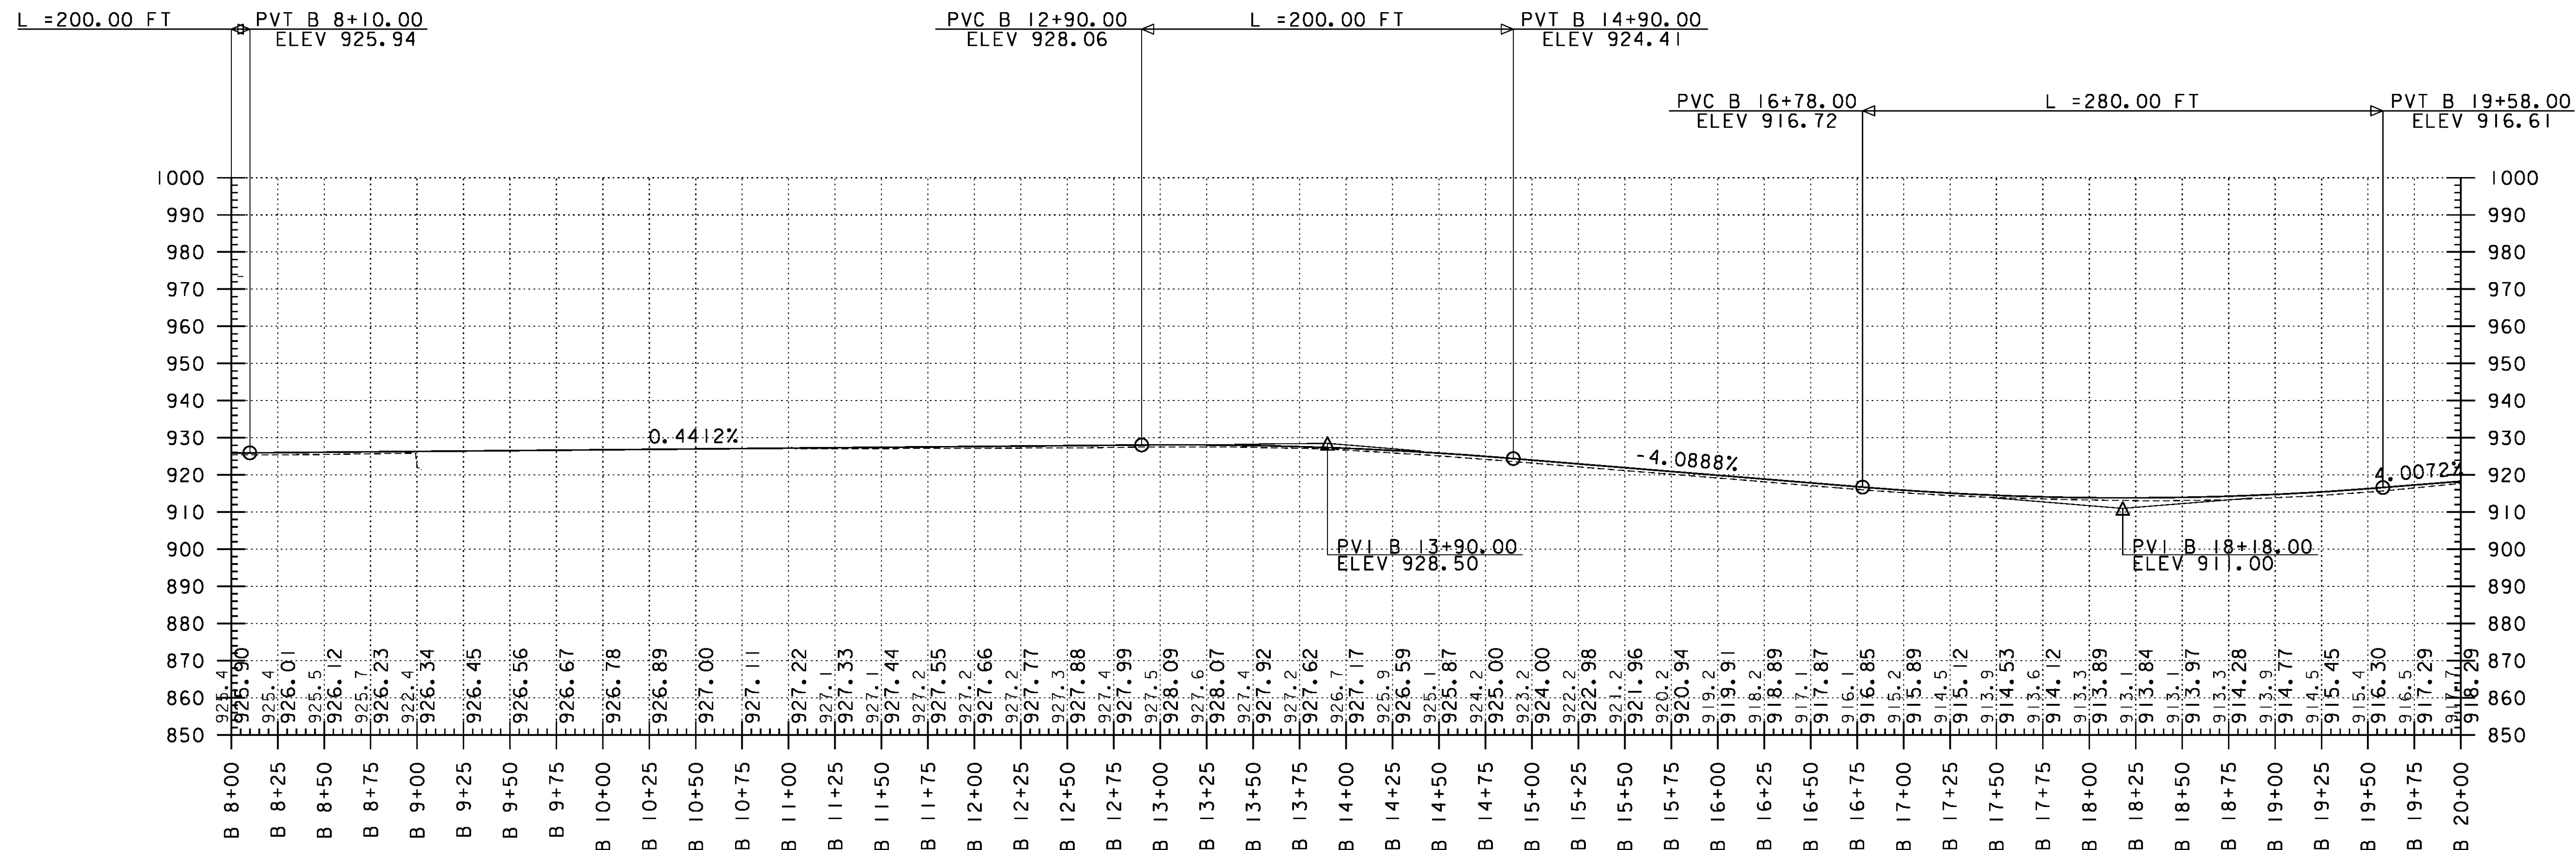

PROFILE

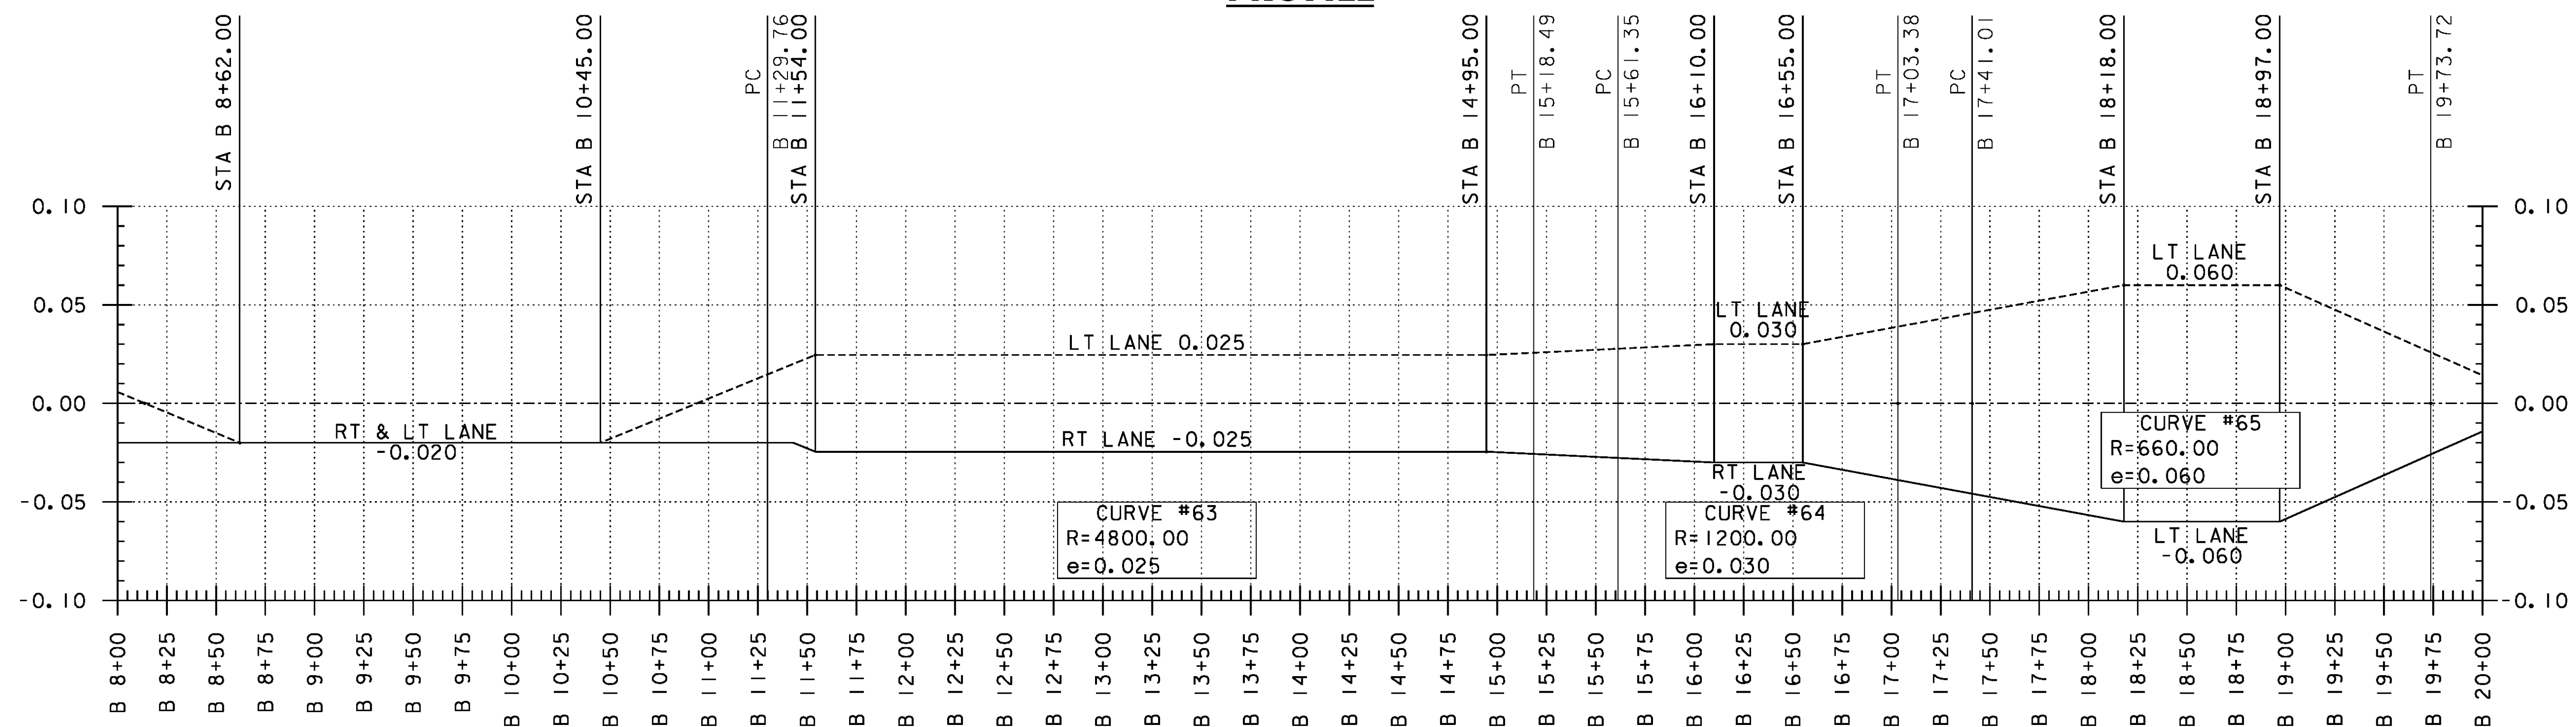

BANKING DIAGRAM

THE GRADES SHOWN TO THE NEAREST TENTH OF A FOOT ARE THE ORIGINAL GROUND ELEVATIONS ALONG THE PROPOSED ALIGNMENT. THE GRADES SHOWN TO THE NEAREST HUNDRETH OF A FOOT ARE FINISH GRADES FOR THE PROPOSED ALIGNMENT. SUPERELEVATIONS ARE SHOWN IN PERCENTAGES.

PROJECT NAME: WARDBORO-JAMAICA
PROJECT NUMBER: ER STP 013-K(17)

FILE NAME: d12b236_pro.bnk
PROJECT LEADER: K. UPMAL
DESIGNED BY: B. KIPP
VT 100 PROFILE & BANKING DIAGRAM

PLOT DATE: 2/26/2014
DRAWN BY: B. KIPP
CHECKED BY: A. KEMPTON
SHEET 120 OF 444