




A 284+25

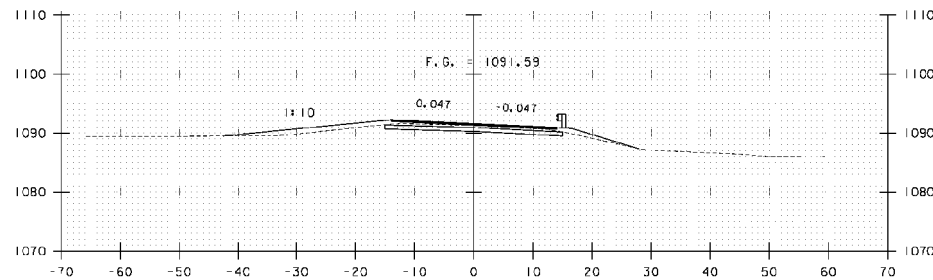


A 284+75

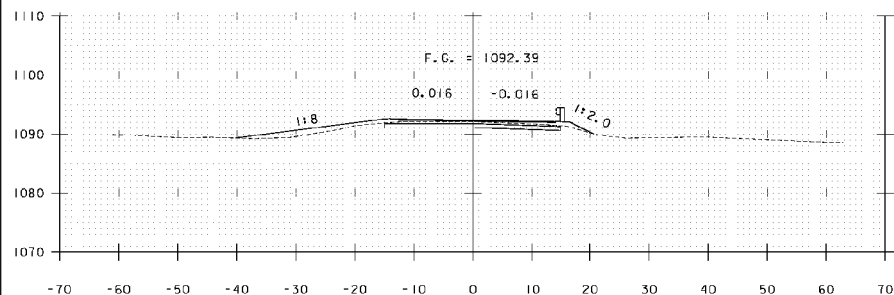


A 284+00

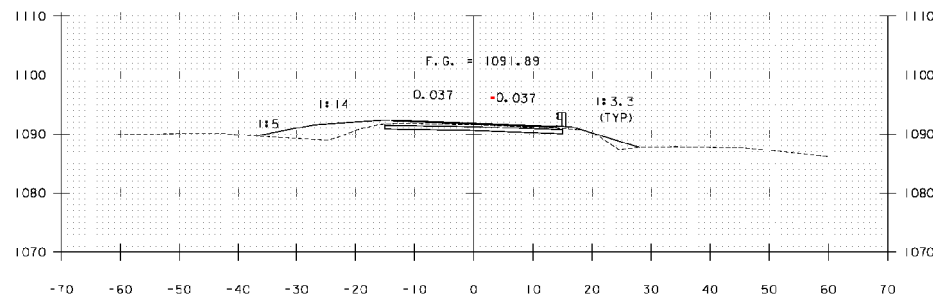

A 284+50

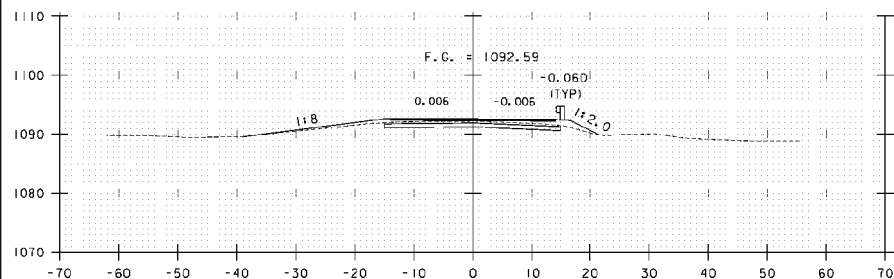

A 283+75

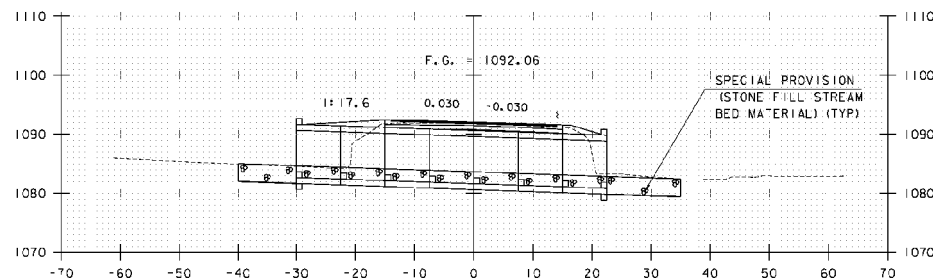

A 284+35

CL BRIDGE #73

PROJECT NAME: WARDBORO-JAMAICA
PROJECT NUMBER: ER STP 013-1(17)

FILE NAME: xs.C73.dgn
PROJECT LEADER: K. UPMAL
DESIGNED BY: E. KIPP
CROSS SECTIONS

PLOT DATE: 2/26/2014
DRAWN BY: B. K. PP
CHECKED BY: HSD
SHEET 283 OF 444

STA. A 283+75 TO STA. A 284+75