




A 290+50

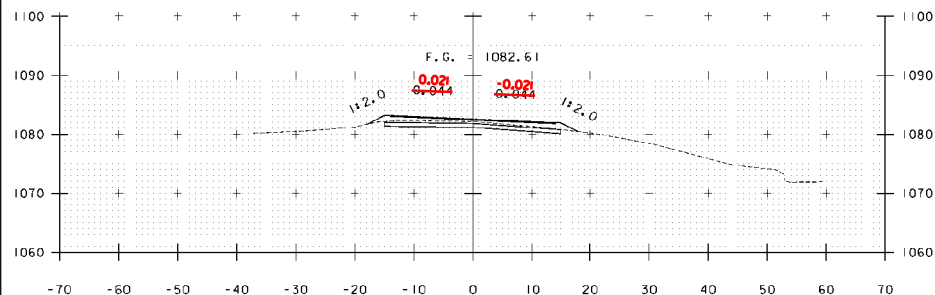


A 290+00

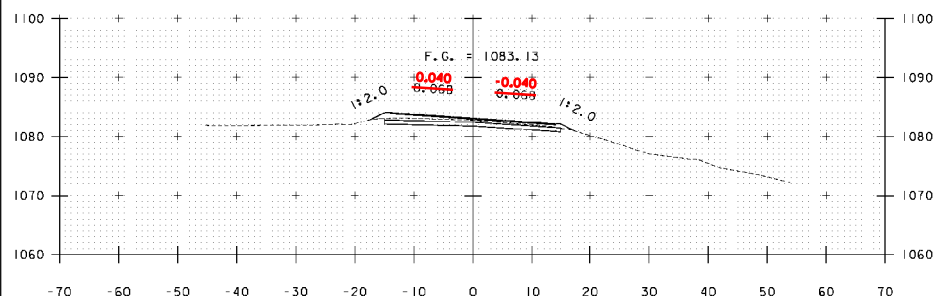

A 289+50

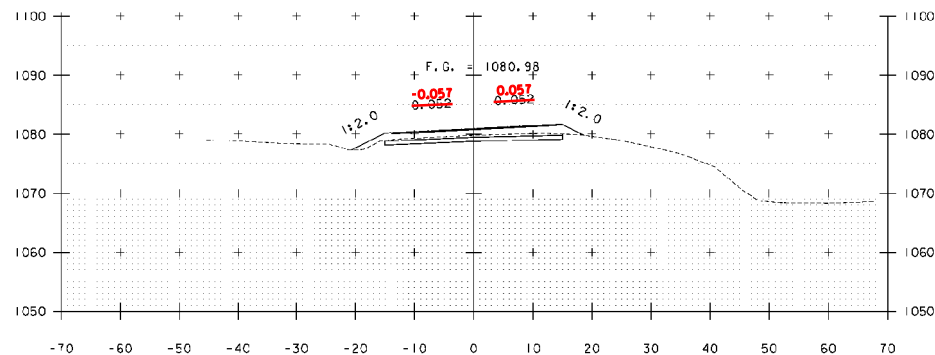

A 291+50

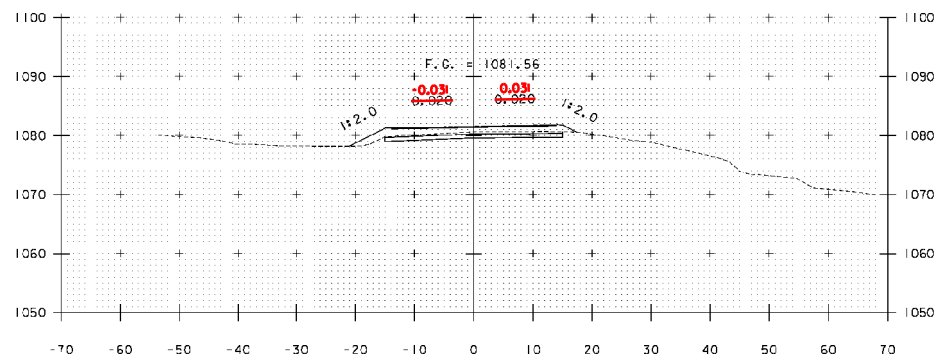

A 291+00

PROJECT NAME: WARDBORO-JAMAICA
PROJECT NUMBER: ER STP 013-1(17)

FILE NAME: xs.dgn
PROJECT LEADER: K. UPMAL
DESIGNED BY: E. KIPP
CROSS SECTIONS

PLOT DATE: 2/26/2014
DRAWN BY: B. KIPP
CHECKED BY: HSD
SHEET 291 OF 444

STA. A 289+50 TO STA. A 291+50