




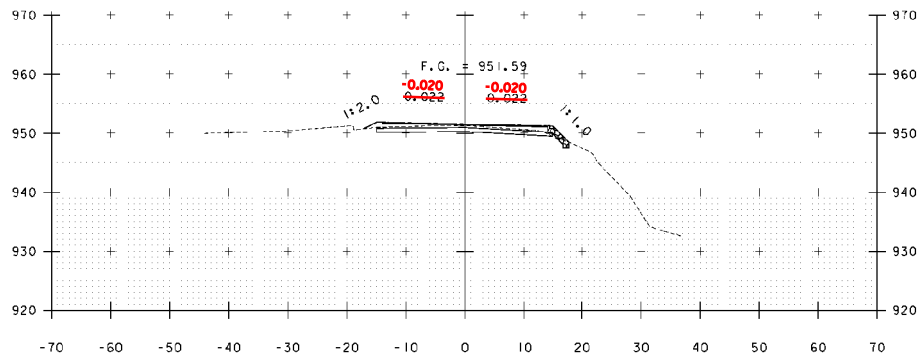


A 372+50

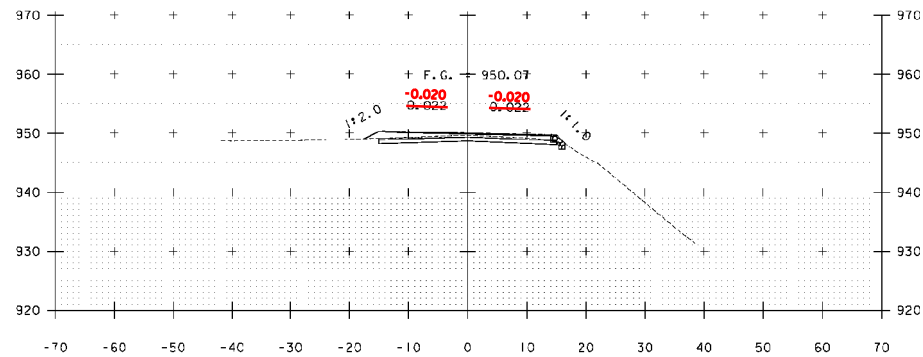

A 373+50

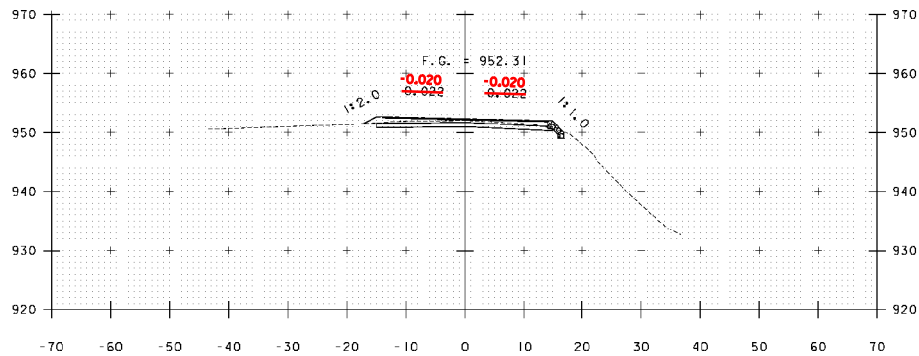

A 372+00

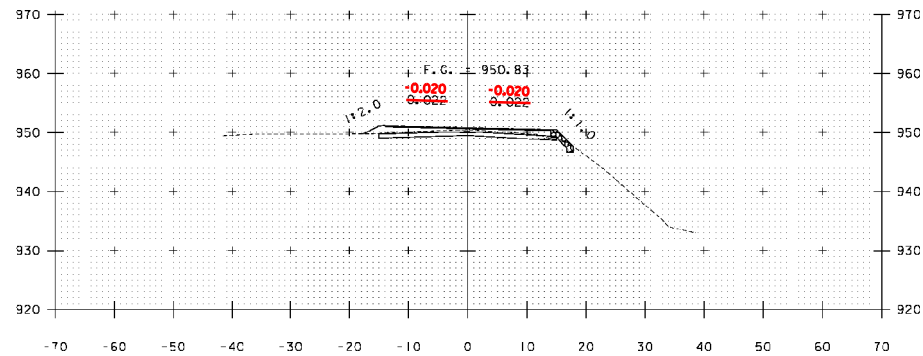

A 373+00

PROJECT NAME: WARDBORO-JAMAICA
 PROJECT NUMBER: ER STP 013-1(I)7

FILE NAME: xs.dgn
 PROJECT LEADER: K. UPMAL
 DESIGNED BY: E. KIPP
 CROSS SECTIONS

PLOT DATE: 2/26/2014
 DRAWN BY: B. KIPP
 CHECKED BY: HSD
 SHEET 317 OF 444

STA. A 372+00 TO STA. A 373+50