




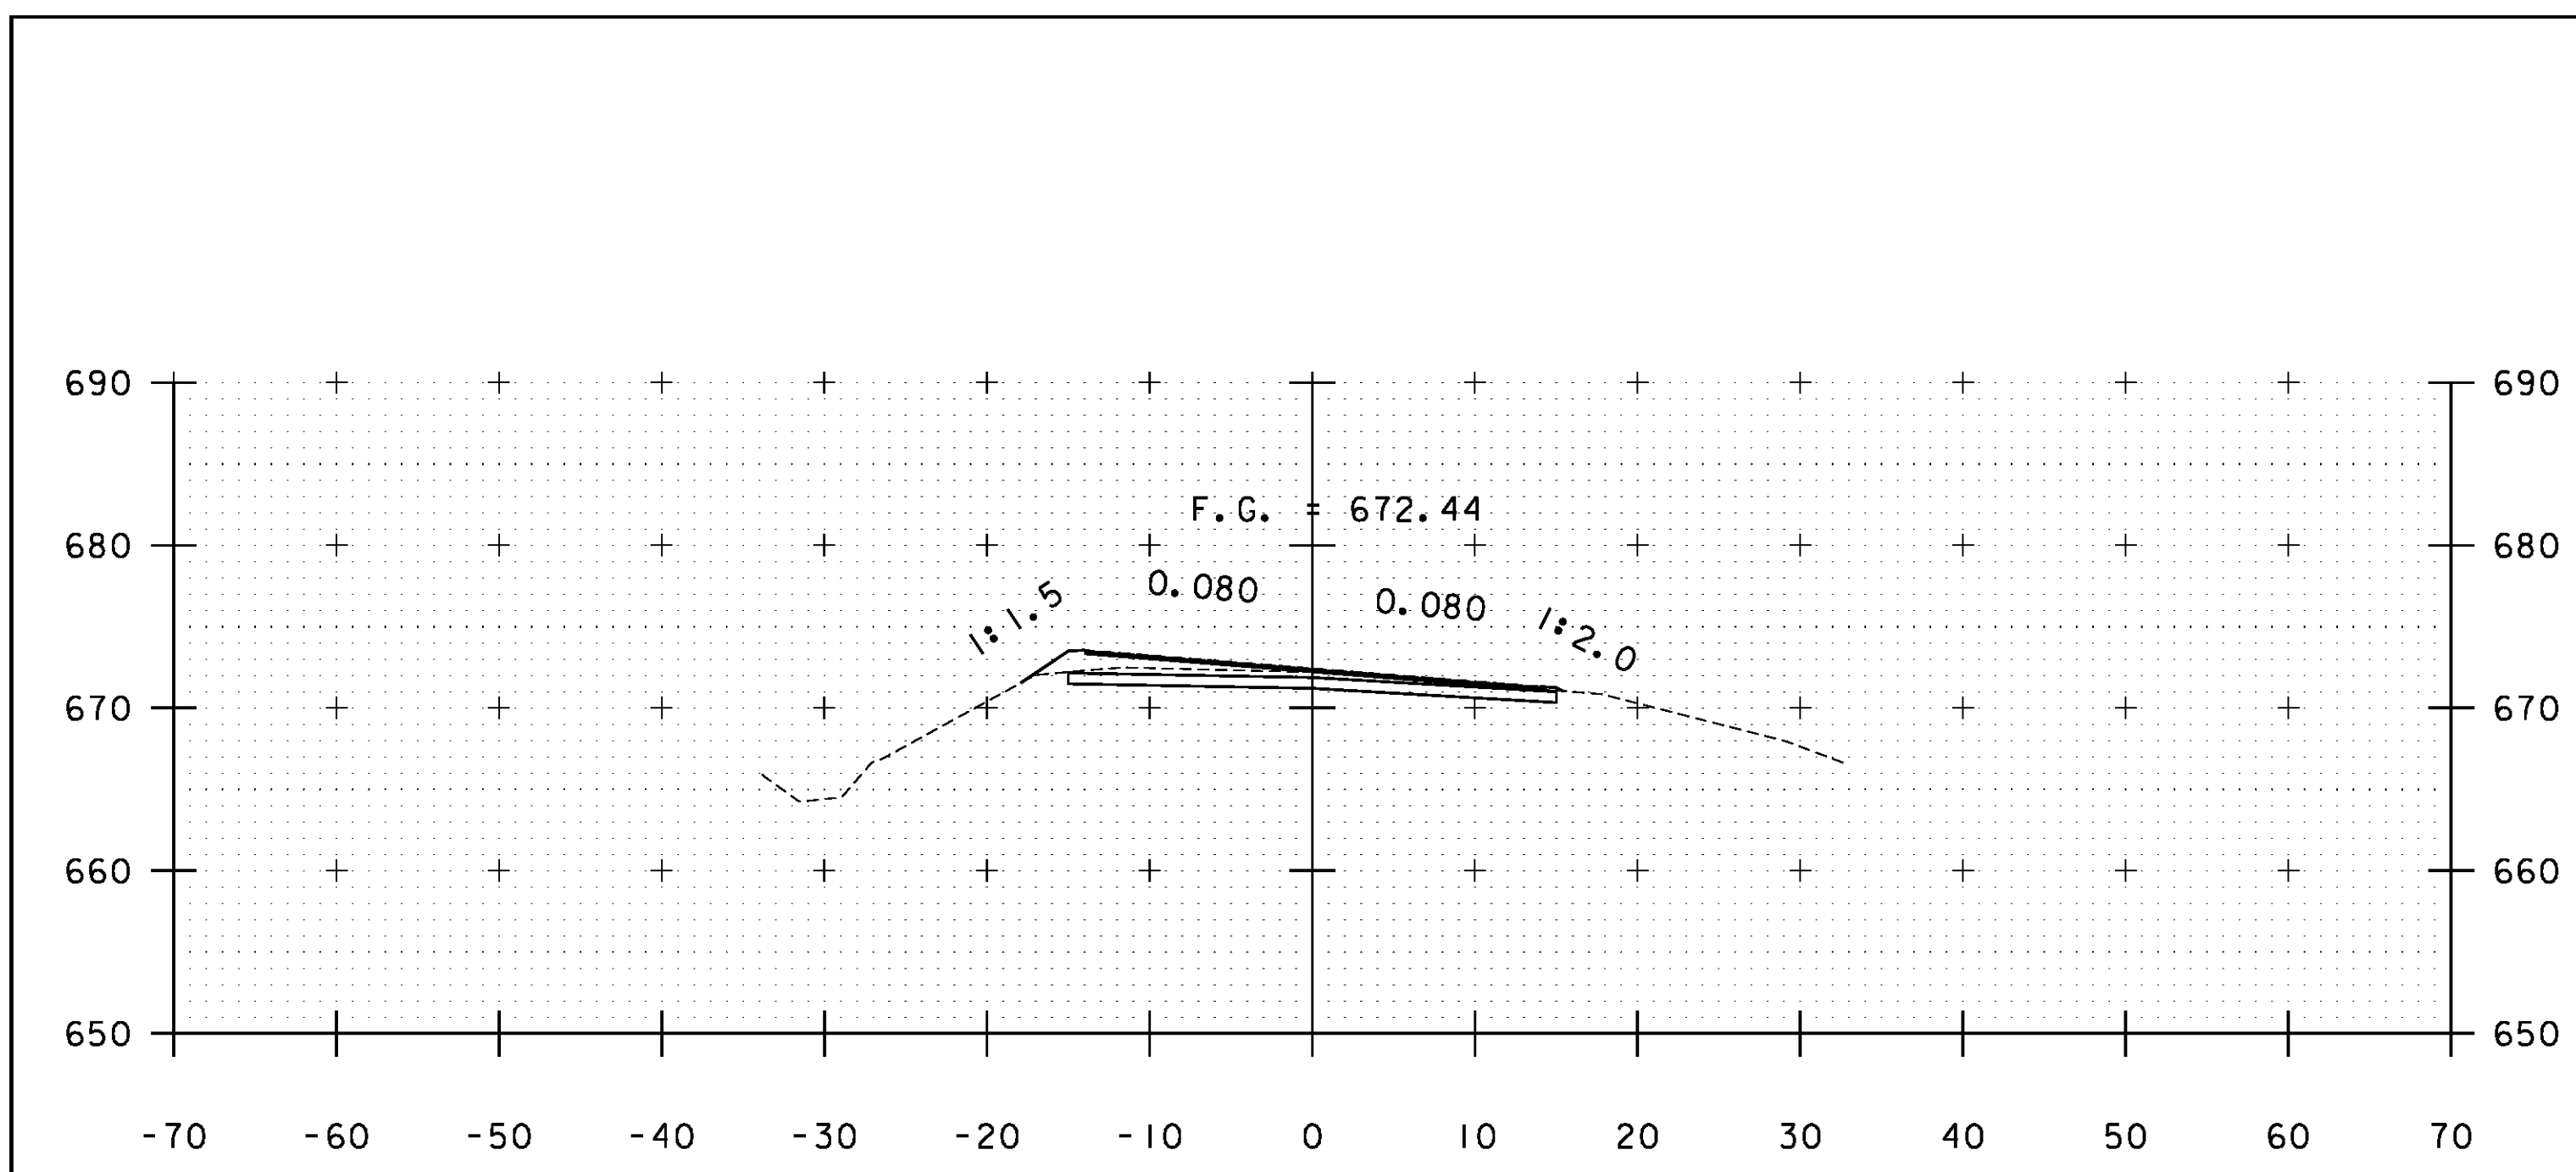


B 130+00

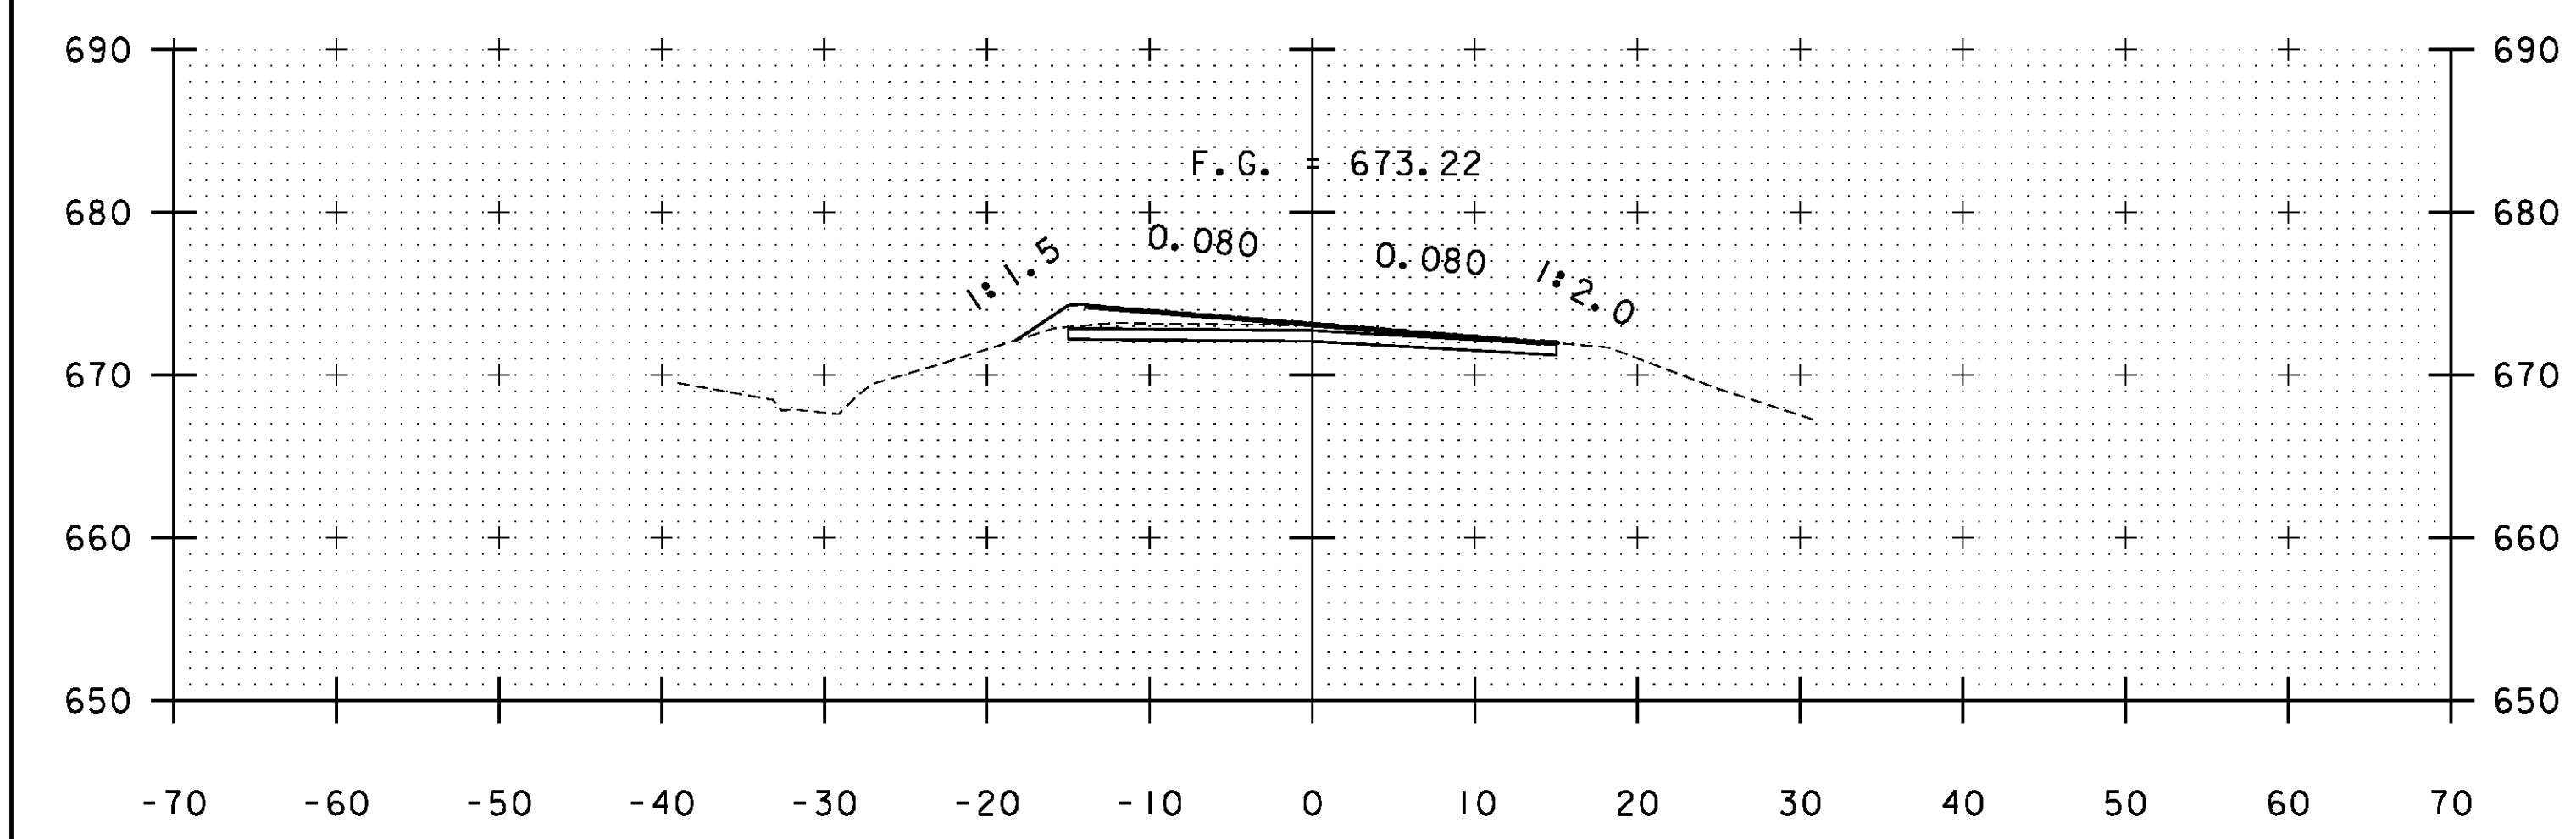


B 129+50

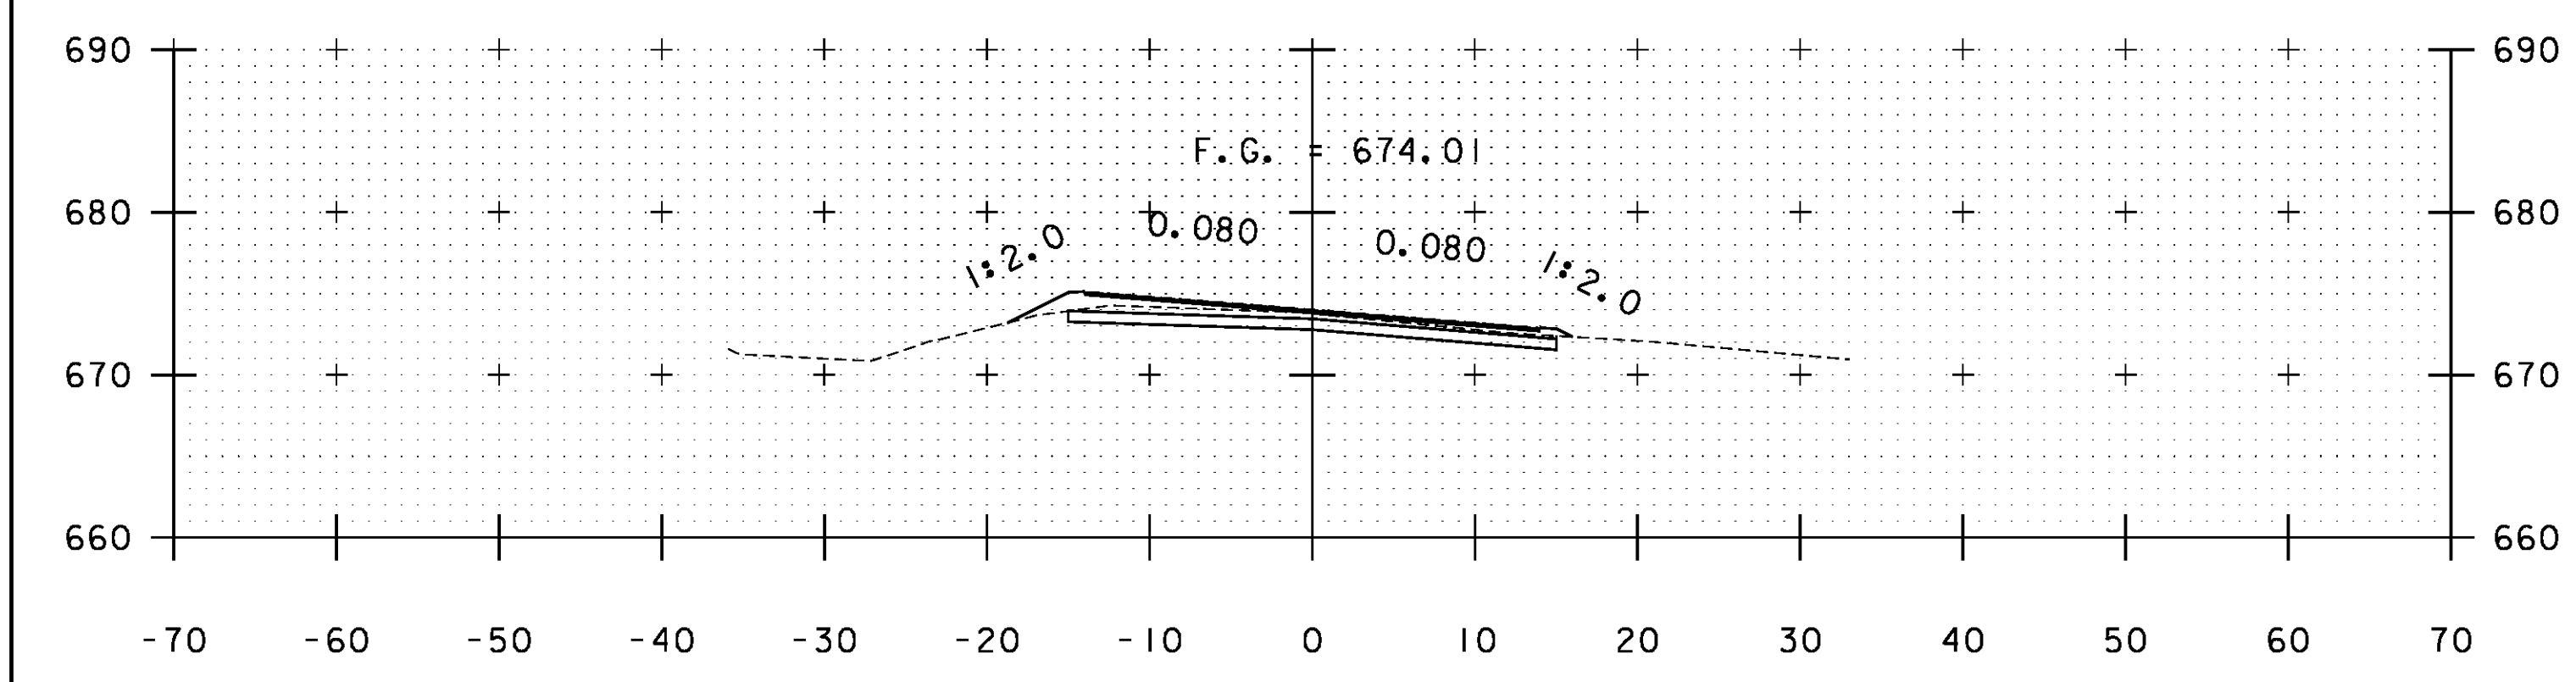


B 129+00

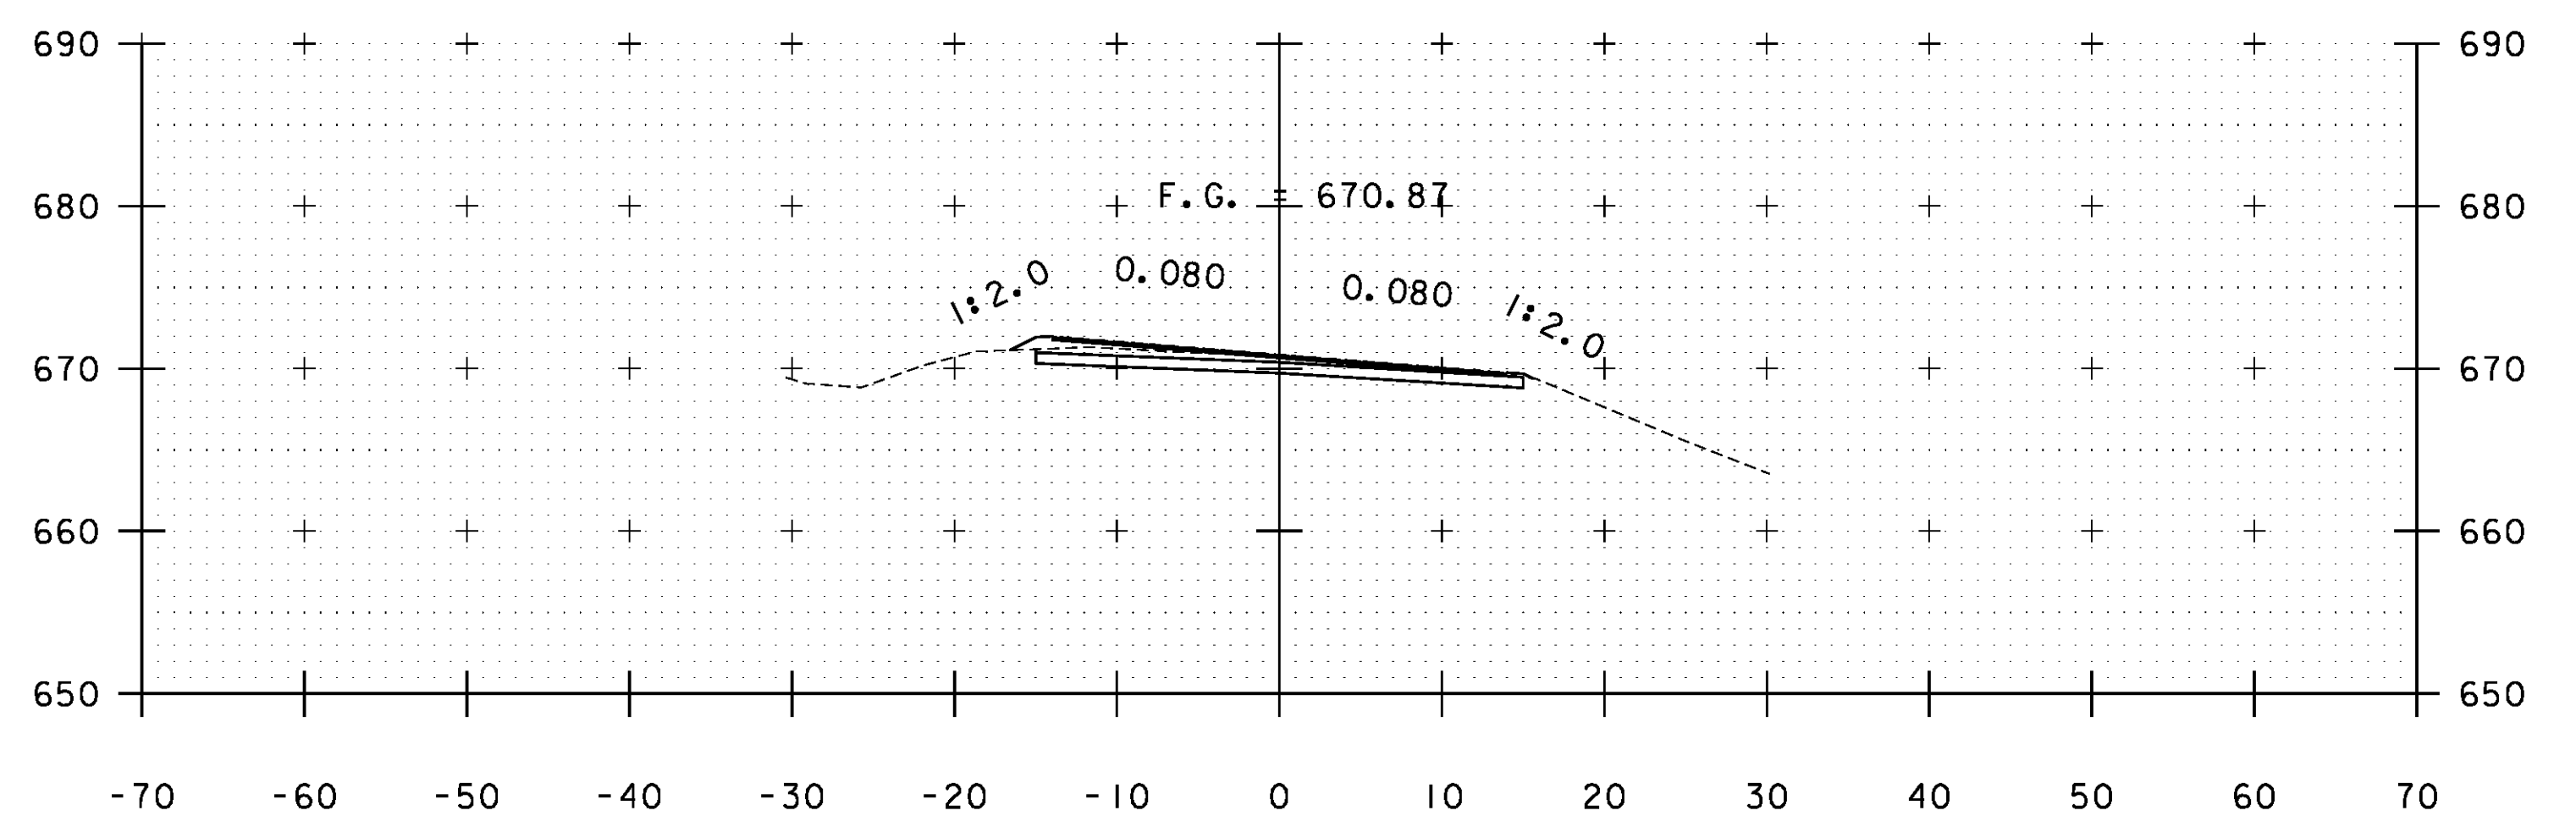

B 131+00

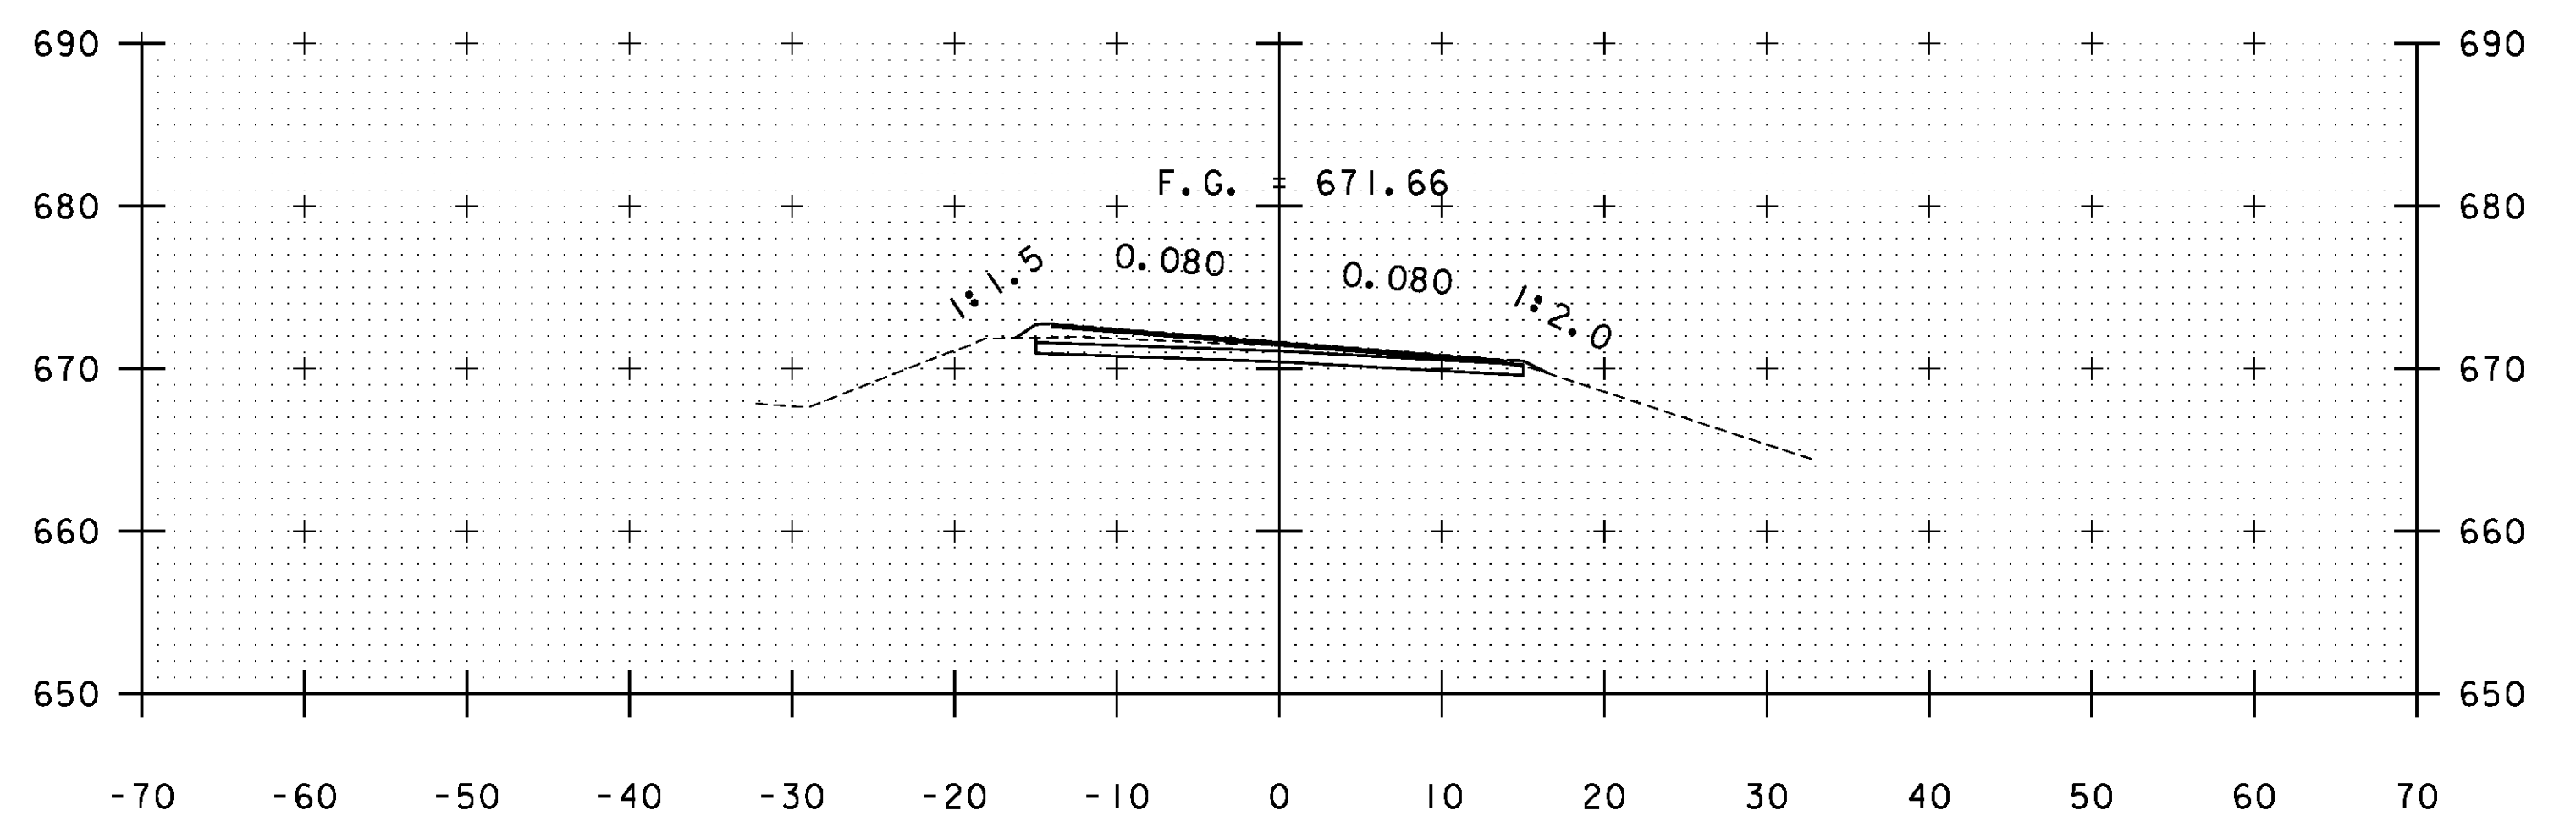

B 130+50

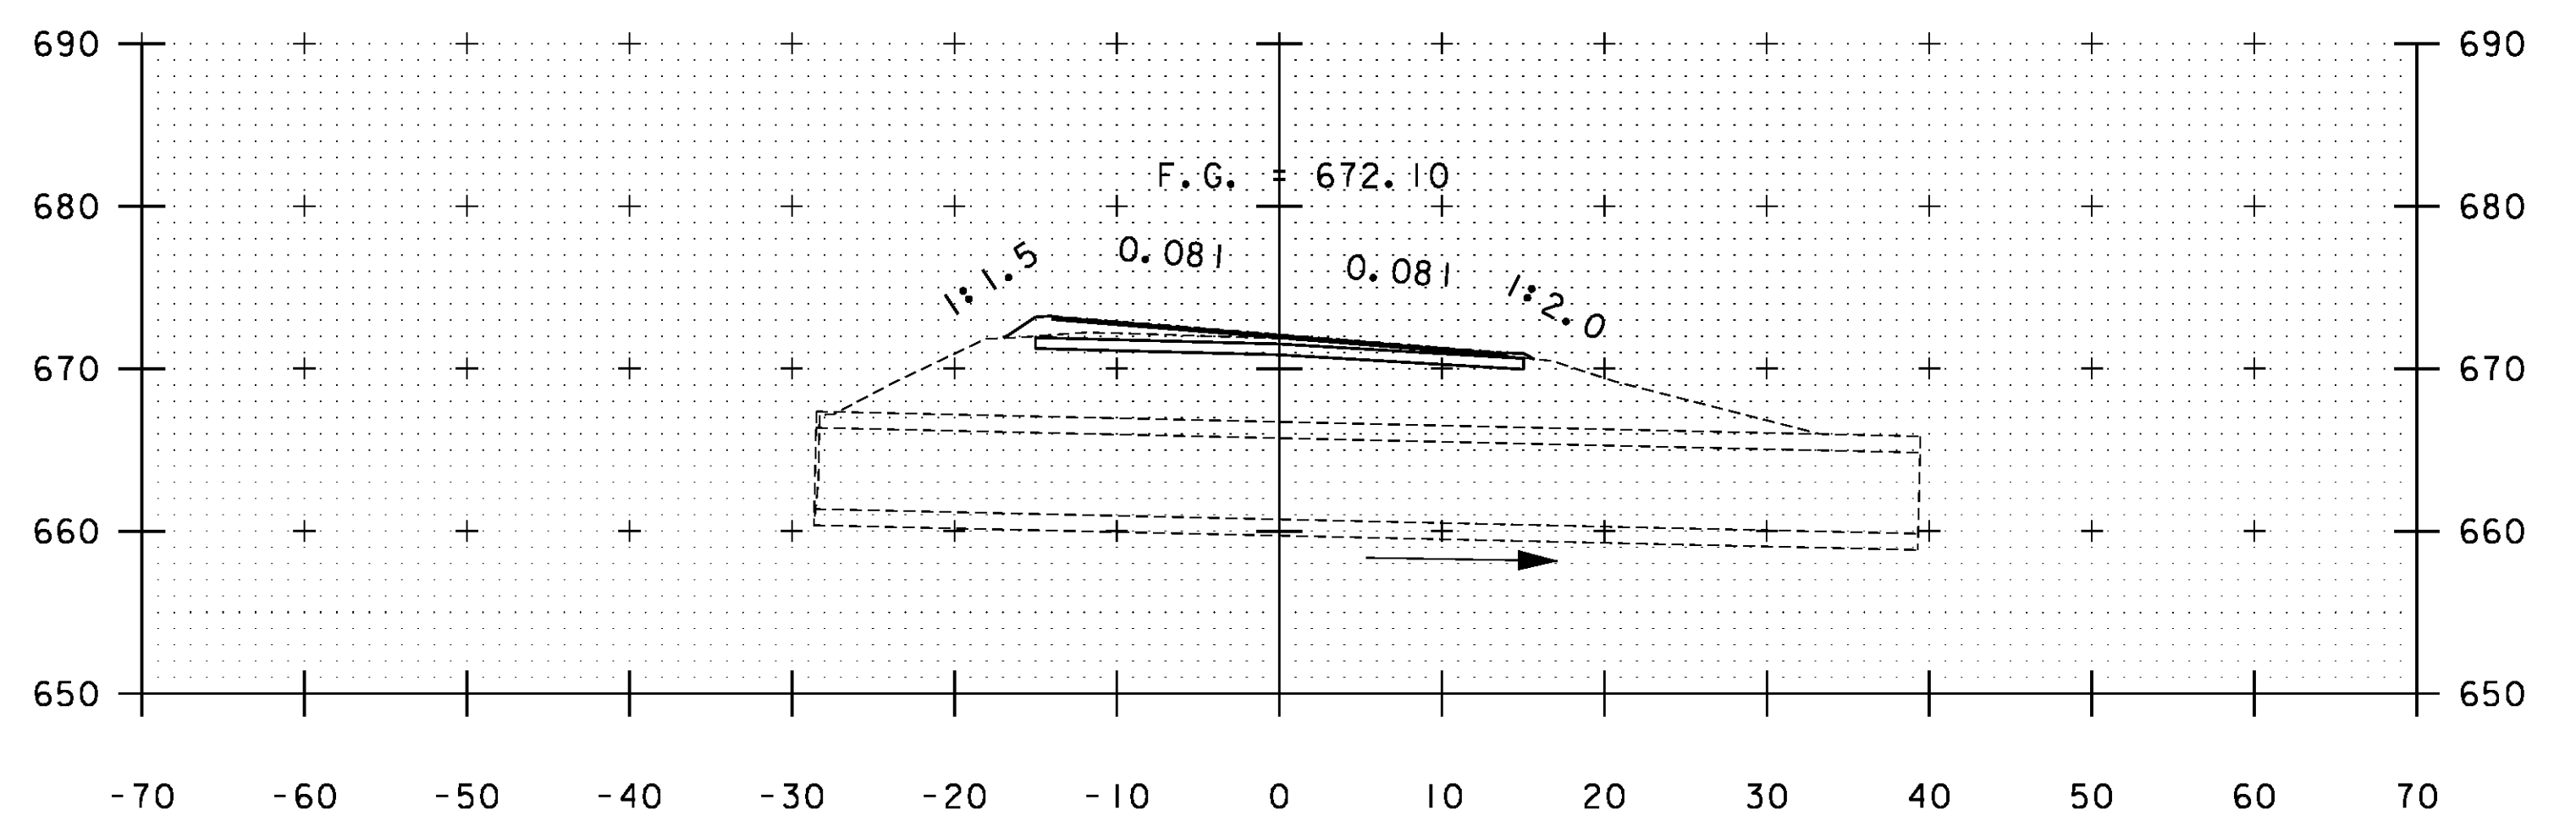

B 130+22

STA. B 129+00 TO STA. B 131+00

PROJECT NAME: WARDBORO-JAMAICA	
PROJECT NUMBER: ER STP 013-K(17)	
FILE NAME: xs.dgn	PLOT DATE: 2/26/2014
PROJECT LEADER: K. UPMAL	DRAWN BY: B. KIPP
DESIGNED BY: B. KIPP	CHECKED BY: HSD
CROSS SECTIONS	SHEET 378 OF 444