


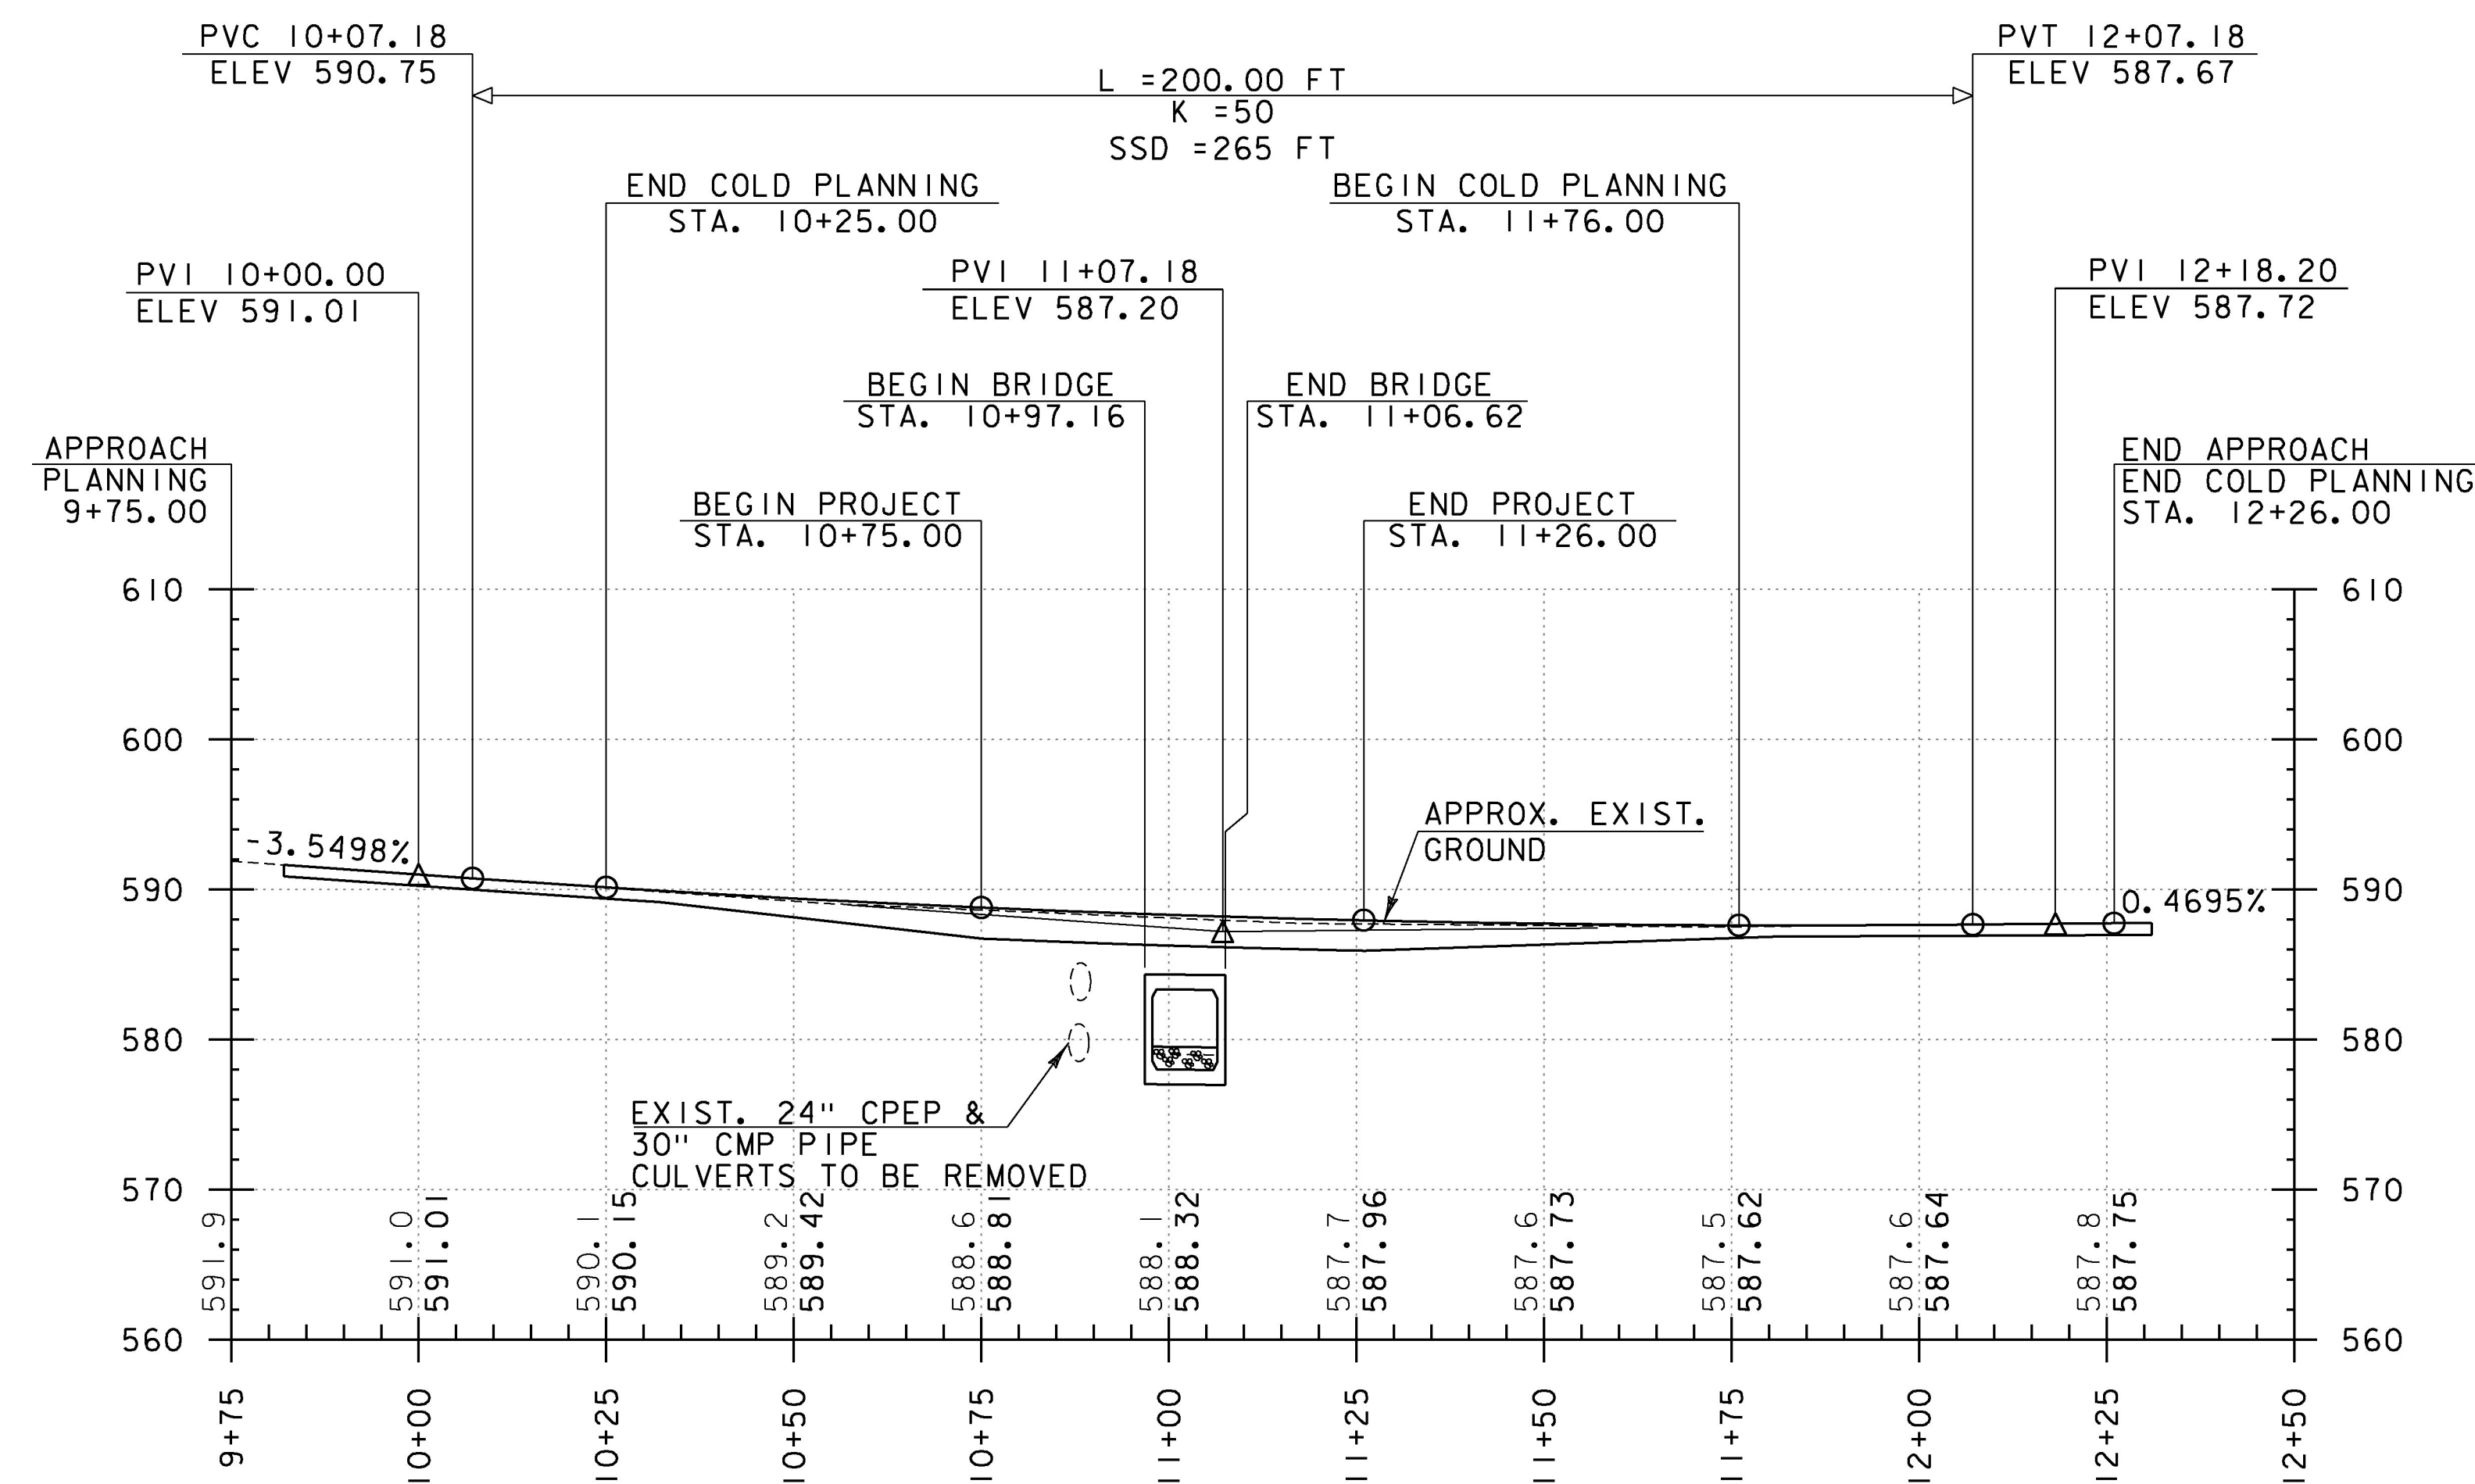

PROFILE ALONG VT ROUTE 7
 HORIZONTAL SCALE: 1' = 20' VERTICAL SCALE: 1" = 10'

NOTE:
 ELEVATIONS SHOWN TO THE NEAREST TENTH ARE EXISTING GROUND ALONG PROPOSED CENTERLINE.

ELEVATIONS SHOW TO THE NEAREST HUNDREDTH ARE FINISHED GRADE ALONG PROPOSED CENTERLINE.

PROJECT NAME: WALLINGFORD	
PROJECT NUMBER: ER CULV(39)	
FILE NAME: z12b380_PROFILES.dgn	PLOT DATE: 6/16/2016
PROJECT LEADER: G. BOGUE	DRAWN BY: L. BUXTON
DESIGNED BY: J. HUNGERFORD	CHECKED BY: T. KNIGHT
ROADWAY PROFILE	SHEET 11 OF 36

