

STATE OF VERMONT
AGENCY OF TRANSPORTATION




INDEX OF SHEETS AND STANDARDS
SEE SHEET 2

PROPOSED IMPROVEMENT
TOWNS OF READSBORO, SEARSBURG, JAMAICA,
WELLS, POULTNEY AND POWNAL
COUNTIES OF BENNINGTON, RUTLAND AND WINDHAM
VERMONT ROUTES 8, 30, 31 AND 346
(MAJOR COLLECTORS)

SOUTHWESTERN REGION SIGN REPLACEMENT - 25.492 MILES:
READSBORO (VT-8) MP 0.000-2.507, SEARSBURG (VT-8) MP 0.000-2.703,
JAMAICA (VT-30) MP 0.000-10.119, WELLS (VT-30) MP 0.000-1.756,
POULTNEY (VT-30) MP 0.000-3.779, POWNAL (VT-346) MP 0.000-4.628

LENGTH OF ROADWAY = 25.492
LENGTH OF PROJECT = 25.492

WORK TO BE PERFORMED INCLUDES THE REMOVAL OF EXISTING SIGNS AND POSTS
AND THE INSTALLATION OF NEW SIGNS AND POSTS AND OTHER RELATED HIGHWAY ITEMS

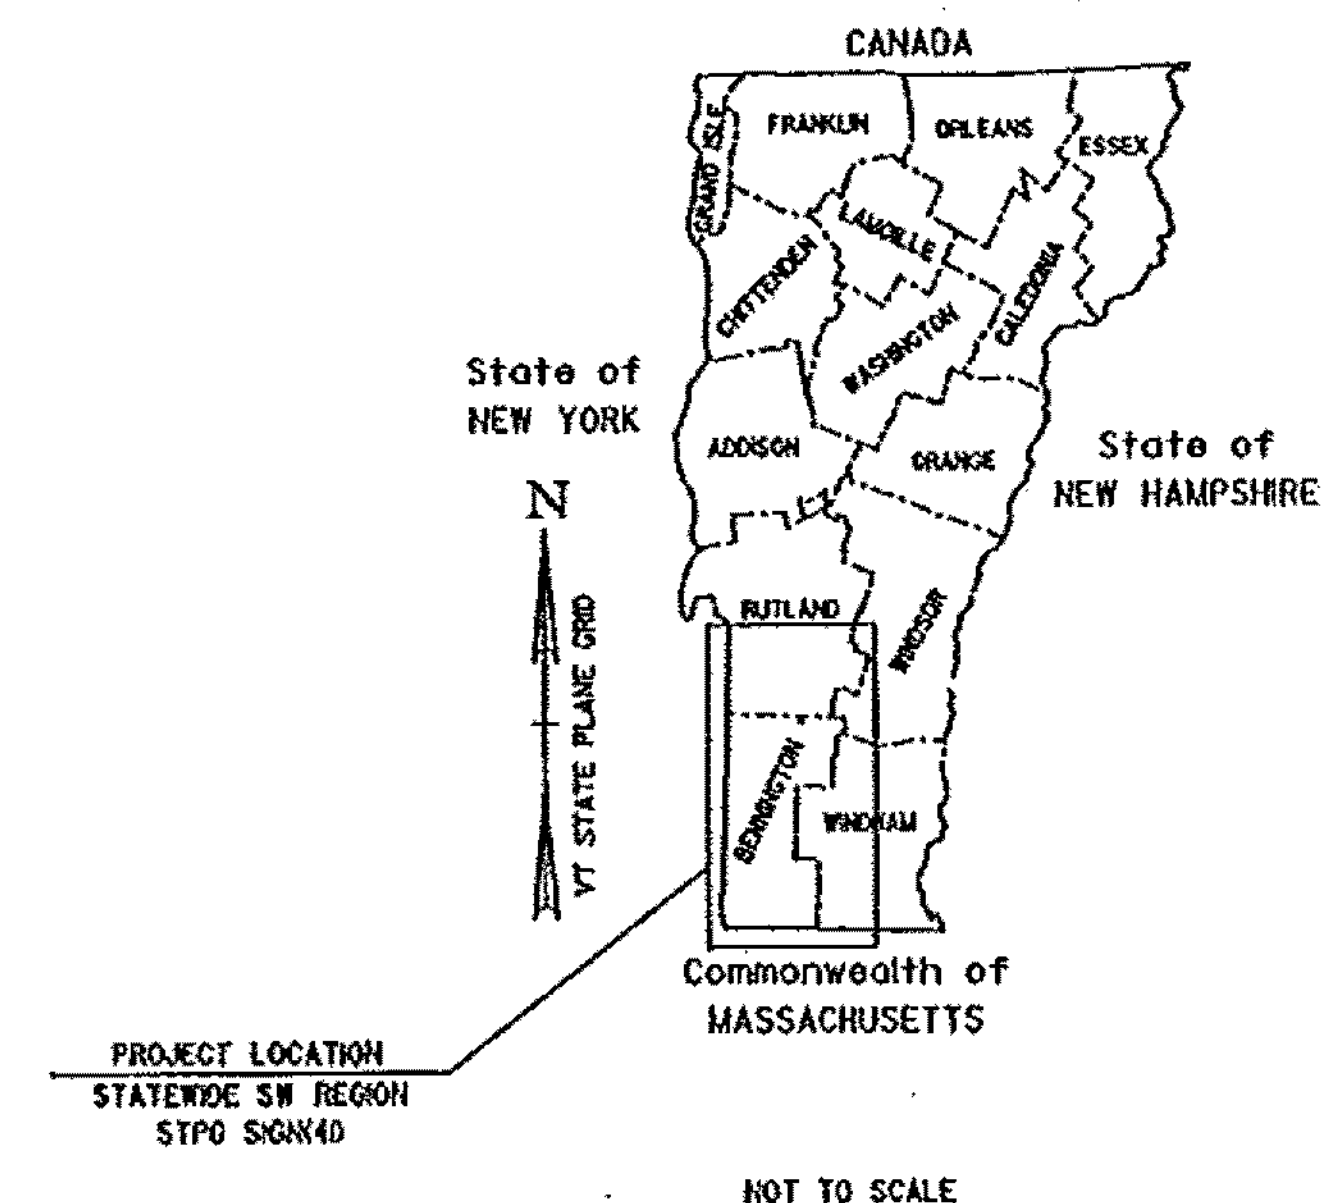

RECORD PLANS

CONTRACTOR: AMERICAN FLAGGING & TRAFFIC CONTROL.- SALEM, NH

RESIDENT ENGINEER: SARA LUICHINGER

CONSTRUCTION BEGAN: AUGUST 20, 2013

CONSTRUCTION COMPLETE: OCTOBER 3, 2013


RECORD PLANS BY: SARAH LUICHINGER & STEVE KENT

HEREBY CERTIFY THAT ALL THE CONSTRUCTION REQUIRED BY THIS SET
OF DRAWINGS HAS BEEN ACCOMPLISHED AS INDICATED HEREIN.

BY Sara Luichinger RESIDENT ENGINEER

DATE 8/11/14

NOTE: Any further information concerning final quantities, amounts or other details
relative to this project may be found at Central Files in the electronic archives.

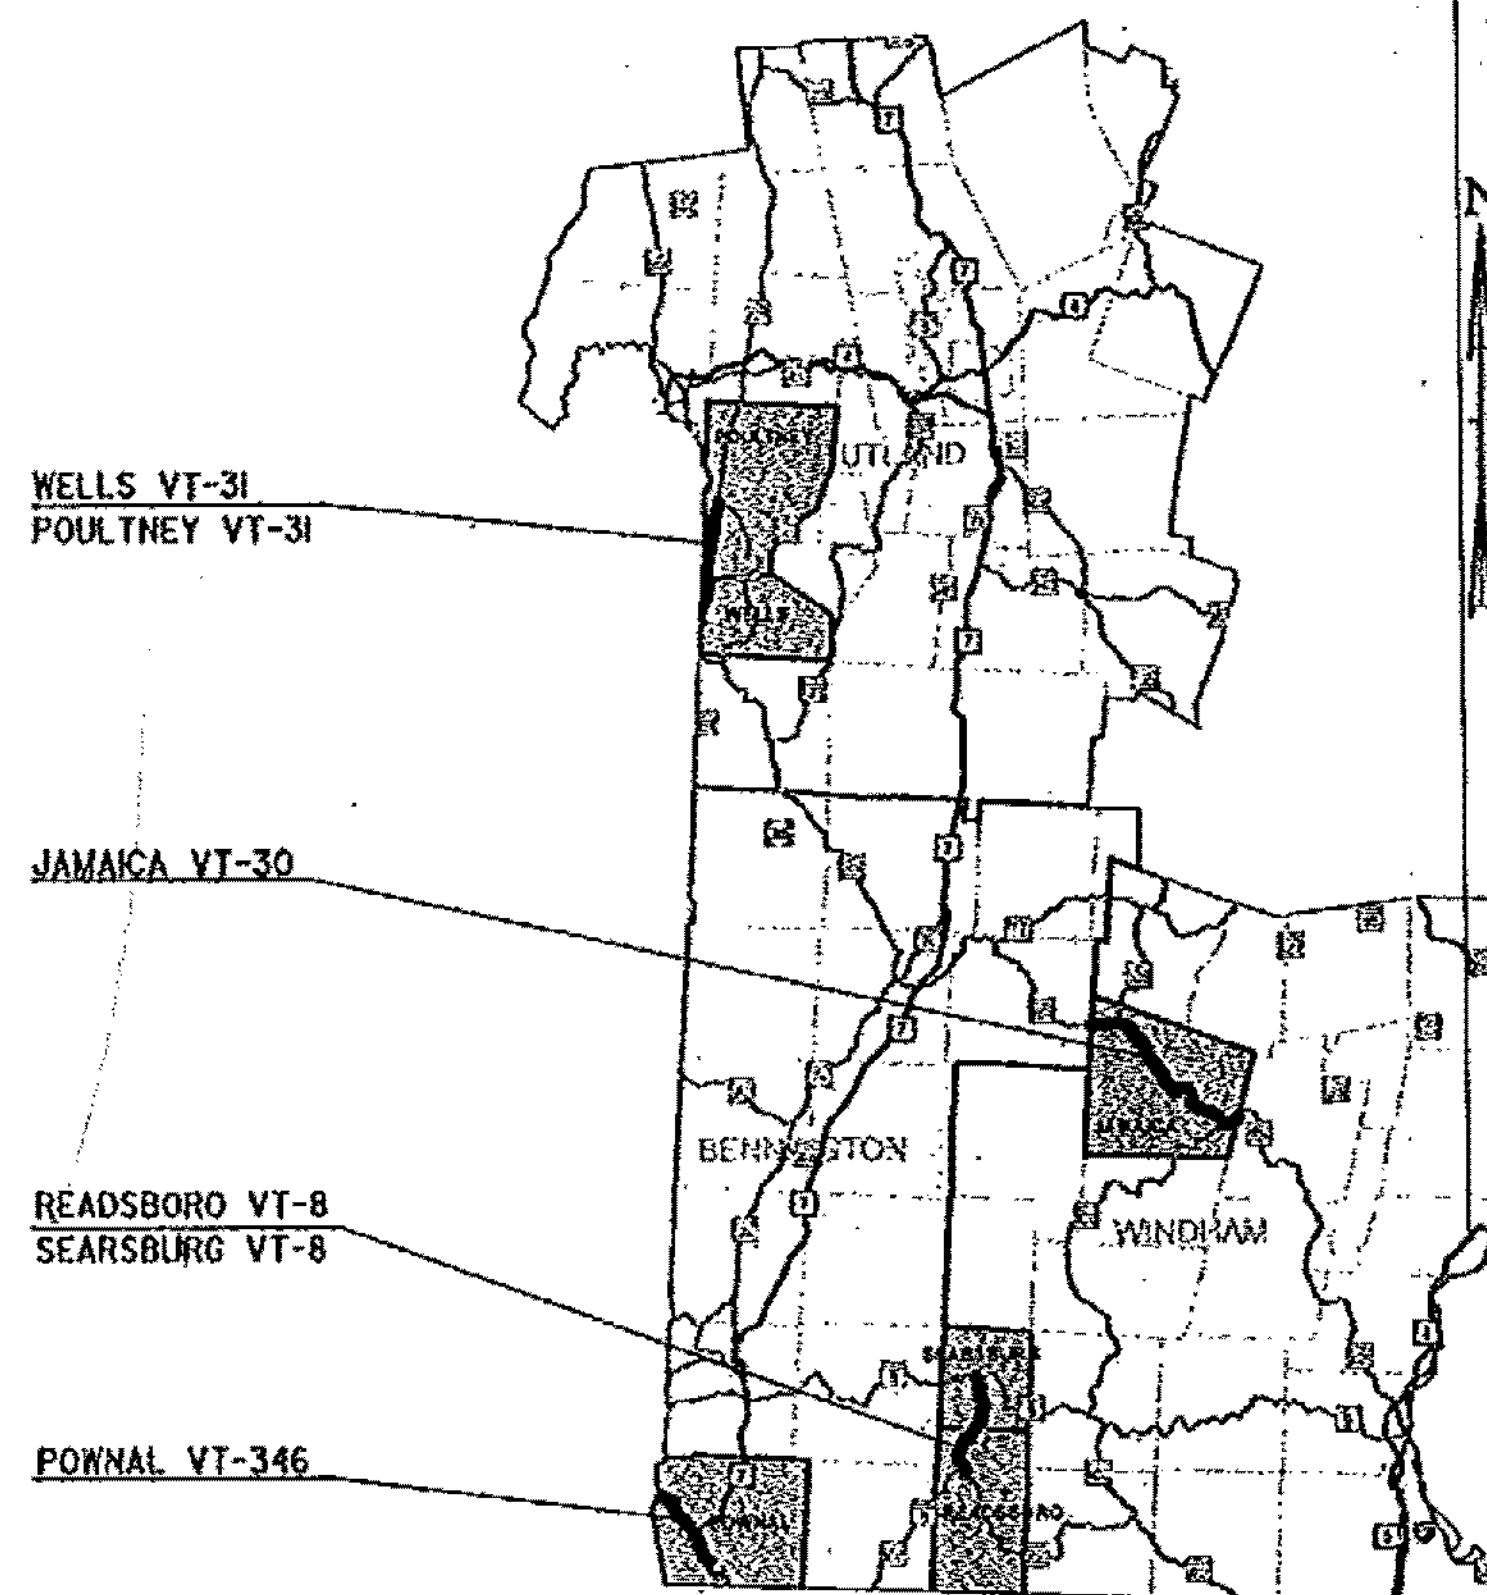

QUALITY ASSURANCE PROGRAM: LEVEL 3

CONVENTIONAL SYMBOLS

COUNTY LINE	— — — — —
TOWN LINE	— — — — —
LIMITS OF ACCESS	— — — — —
POINT OF ACCESS	X
FENCE LINE	X — X — X — X —
STONE WALL	— — — — —
TRAVELED WAY	— — — — —
GUARD RAIL	— — — — —
RAILROAD	— — — — —
SURVEY LINE	— — — — —
CULVERT	— — — — —
POWER POLE	⊕
TELEPHONE POLE	⊕
TREES	⊕
CONTROL OF ACCESS	///
PROPERTY LINE	— — — — —
R.O.W. TAKING LINE	— — — — —
SLOPE RIGHTS	— — — — —
TOP OF CUT	— — — — —
TOE OF SLOPE	— — — — —

SURVEYED BY : N/A
SURVEYED DATE : N/A

DATUM
VERTICAL : N/A
HORIZONTAL : N/A

THESE PLANS ARE SUBJECT TO SUCH ENGINEERING
CHANGES AS MAY BE REQUIRED BY THE FEDERAL HIGHWAY
ADMINISTRATION OR THE DIRECTOR OF PROGRAM
DEVELOPMENT.

CONSTRUCTION IS TO BE CARRIED ON IN ACCORDANCE
WITH THESE PLANS AND THE STANDARD SPECIFICATIONS
FOR CONSTRUCTION DATED 2014, AS APPROVED BY THE
FEDERAL HIGHWAY ADMINISTRATION ON JULY 20, 2014
FOR USE ON THIS PROJECT, INCLUDING ALL SUBSEQUENT
REVISIONS AND SUCH REVISED SPECIFICATIONS AND
SPECIAL PROVISIONS AS ARE INCORPORATED IN THESE
PLANS.

DIRECTOR OF PROGRAM DEVELOPMENT

APPROVED [Signature] DATE 2-19-13

PROJECT MANAGER : AMY GAUBLE

PROJECT NAME : STATEWIDE SW REGION

PROJECT NUMBER : STPG SIGN (41)

SHEET 1 OF 97 SHEETS

INDEX OF SHEETS:

1	TITLE SHEET
2	PROJECT NOTES
3	QUANTITY SHEET I
4-12	SIGN DETAILS
13-15	READSBORO VT-8 NORTHBOUND TRAFFIC SIGN SUMMARY SHEETS
16-19	READSBORO VT-8 SOUTHBOUND TRAFFIC SIGN SUMMARY SHEETS
20-24	SEARSBURG VT-8 NORTHBOUND TRAFFIC SIGN SUMMARY SHEETS
25-28	SEARSBURG VT-8 SOUTHBOUND TRAFFIC SIGN SUMMARY SHEETS
29-42	JAMAICA VT-30 NORTHBOUND TRAFFIC SIGN SUMMARY SHEETS
43-56	JAMAICA VT-30 SOUTHBOUND TRAFFIC SIGN SUMMARY SHEETS
57-60	WELLS VT-31NORTHBOUND TRAFFIC SIGN SUMMARY SHEETS
61-63	WELLS VT-31SOUTHBOUND TRAFFIC SIGN SUMMARY SHEETS
64-71	POULTNEY VT-31NORTHBOUND TRAFFIC SIGN SUMMARY SHEETS
72-77	POULTNEY VT-31SOUTHBOUND TRAFFIC SIGN SUMMARY SHEETS
78-85	POWNAI VT-346 NORTHBOUND TRAFFIC SIGN SUMMARY SHEETS
86-96	POWNAI VT-346 SOUTHBOUND TRAFFIC SIGN SUMMARY SHEETS
97	TOWN TOTAL SIGN SUMMARY SHEET

STANDARDS:

E-121	STANDARD SIGN PLACEMENT CONVENTIONAL ROAD	08/08/1995
E-136B	STATE ROUTE MARKER SIGN DETAILS	08/08/1995
E-138	MILE MARKER DETAILS STATE AND TOWN HIGHWAYS	05/30/2003
E-164	SQUARE STEEL SIGN POST	06/08/2009

2-1/2" SOIL BEARING SLIP BASE LOCATIONS
(ITEM 900.620 SPECIAL PROVISION):

TOWN:	DIRECTION:	MILE POINT:	NO. REQ:	SHEET:
READSBORO	SB	0.086	2	17
SEARSBURG	NB	2.630	2	23
JAMAICA	SB	8.866	2	45
WELLS	NB	0.025	2	57
POWNAI	SB	4.595	2	86

1.

THE LOCATIONS SHOWN IN THE TABLE ABOVE WILL REQUIRE THAT EACH 2-1/2" SQUARE STEEL SIGN POST, AS SPECIFIED ON THE APPLICABLE SIGN SUMMARY SHEET, BE INSTALLED USING A SOIL BEARING SLIP BASE WITH ANCHOR SLEEVE. AT THESE SPECIFIED LOCATIONS THE 2-1/2" POSTS ARE NOT PROTECTED BY GUARD RAIL OR CURBING, THUS REQUIRING THE USE OF SOIL BEARING SLIP BASES FOR THIS SIZE POST.
2.

PAYMENT FOR SOIL BEARING SLIP BASE (EACH) WILL BE MADE UNDER CONTRACT ITEM 900.620 SPECIAL PROVISION (SOIL BEARING SLIP BASE) (2-1/2").

TEMPORARY TRAFFIC CONTROL NOTES:

1.

THE CONTRACTOR SHALL SUBMIT A SITE-SPECIFIC TRAFFIC CONTROL PLAN CONFORMING TO THE MANUAL ON UNIFORM TRAFFIC CONTROL DEVICES (MUTCD), DATED 2009, AND ITS LATEST REVISIONS, TO THE ENGINEER AT THE PRE-CONSTRUCTION MEETING, FOR REVIEW AND APPROVAL BY THE ENGINEER.
2.

WHEN WORKING IN THE VICINITY OF EXISTING PEDESTRIAN FACILITIES, AMERICAN WITH DISABILITIES ACT (A.D.A.) ACCESSIBLE PEDESTRIAN ACCOMODATIONS SHALL BE MAINTAINED AT ALL TIMES. PAYMENT SHALL BE INCLUDED IN THE UNIT BID PRICE FOR CONTRACT ITEM 641.0 TRAFFIC CONTROL.
3.

THE CONTRACTOR SHALL PROVIDE ACCESS THROUGH THE WORK ZONE FOR EMERGENCY VEHICLES AT ALL TIMES.
4.

THE CONTRACTOR SHALL CONDUCT THE WORK AT ALL TIMES IN SUCH A MANNER AND IN SUCH SEQUENCE SO AS TO ENSURE THE LEAST INTERFERENCE WITH TRAFFIC OCCURS.
5.

TEMPORARY TRAFFIC CONTROL SIGNS SHALL ONLY BE VISIBLE TO MOTORISTS AT THE TIMES WHEN THE MESSAGE IS PERTINENT, I.E. A "FLAGGER AHEAD" SIGN SHALL ONLY BE VISIBLE TO MOTORISTS WHEN THE FLAGGER IS ACTUALLY PRESENT PERFORMING THEIR DUTIES.
6.

PAYMENT FOR CONSTRUCTION SIGNING WILL BE MADE UNDER CONTRACT ITEM 641.0 TRAFFIC CONTROL.
7.

TEMPORARY TRAFFIC CONTROL SIGNS SHALL BE MOVED AS WORK AREA MOVES. AT NO TIME SHALL THE FLAGGER SIGN BE GREATER THAN 1000 FEET IN ADVANCE OF THE FLAGGER STATION.

SIGN DESIGN AND FABRICATION:

1.

THE MANUAL ON UNIFORM TRAFFIC CONTROL DEVICES (MUTCD) SIGN CODES PROVIDED IN THESE PLANS REFER TO THE 2009 MUTCD. DESIGN DETAILS FOR SIGNS INDICATED ON THE PLANS, AS FOUND IN THE STANDARD HIGHWAY SIGNS AND MARKINGS BOOK (SHSM), SHALL BE PER THE 2004 SHSM AND THE 2012 SUPPLEMENT TO THE 2004 EDITION.
2.

SIGN SHEETING FOR FLUORESCENT YELLOW (FY) AND FLUORESCENT YELLOW-GREEN (FYG) SHALL BE ASTM D4956 TYPE VII, VIII OR IX. ALL OTHER SIGN SHEETING SHALL BE TYPE III OR IV.
3.

SHEETING TYPES AND SHEETING FABRICATED BY DIFFERENT MANUFACTURERS SHALL NOT BE MIXED ON A SINGLE SIGN ASSEMBLY. SHEETING COLOR/TYPE SHOULD BE BY THE SAME MANUFACTURER AND SHOULD BE CONSISTENT THROUGHOUT THE PROJECT.
4.

SIGN BASE MATERIAL FOR ALL STREET NAME SIGNS SHALL BE EITHER 0.125 INCH THICK FLAT SHEET ALUMINUM OR EXTRUDED ALUMINUM WITH A 0.250 INCH THICK FLANGE AND 0.090 INCH MINIMUM WEB THICKNESS.
5.

UNLESS OTHERWISE NOTED ON THE PLANS, ALL SIGNS SHALL BE FLAT SHEET ALUMINUM WITH THE FOLLOWING MINIMUM THICKNESSES:

SIGN SIZE	12" X 12"		
	18" X 18"		
	21" X 15"		
	24" X 8"		
	24" X 10"		48" X 18"
	24" X 12"	36" X 12"	48" X 24"
	24" X 18"	36" X 15"	48" X 30"
	24" X 24"	36" X 18"	48" X 42"
	24" X 30"	36" X 24"	48" X 48"
	30" X 15"	36" X 36"	48" X 60"
	30" X 18"	36" X 42"	72" X 10"
	30" X 30"	36" X 48"	72" X 12"
	30" X 42"	36" X 54"	72" X 20"
	THICKNESS	0.080"	0.100"

SIGN POSTS:

1.

ALL SQUARE STEEL SIGN POSTS SHALL BE INSTALLED IN A NEW ANCHOR. ALL SIGNS INSTALLED IN PAVED OR CONCRETE ISLANDS OR SIDEWALKS SHALL ALSO BE INSTALLED WITH AN 18" SLEEVE. PAYMENT FOR SLEEVE SHALL BE INCIDENTAL TO CONTRACT ITEM 675.341 SQUARE TUBE SIGN POST AND ANCHOR.
2.

THE 1.75" SQUARE STEEL POSTS SHALL BE 14 GAGE STEEL. THE 2.0" AND 2.5" SQUARE STEEL POSTS SHALL BE 12 GAGE STEEL.
3.

DIAMOND-SHAPED ADVANCE WARNING SIGNS 36" AND LARGER WILL REQUIRE TWO POSTS. ASSEMBLIES WITH TWO 30" DIAMOND-SHAPED SIGNS WILL REQUIRE TWO POSTS. POST SPACING SHALL BE AS FOLLOWS:

30" SIGN

15'-20"

36" SIGN

18'-24"

48" SIGN

24'-32"

SIGN INSTALLATION:

1.

THE CONTRACTOR SHALL BE RESPONSIBLE FOR REPAIRING ANY DAMAGE TO PRIVATE OR PUBLIC PROPERTY CAUSED BY THE CONTRACTOR, AT THE CONTRACTOR'S EXPENSE AND AT NO EXPENSE TO THE STATE.
2.

ALL SIGNS WITHIN THE PROJECT LIMITS ARE TO BE REPLACED, UNLESS OTHERWISE NOTED ON THE PLANS OR AS DIRECTED BY THE ENGINEER. SIGN LOCATIONS AS SHOWN ON THE PLANS ARE APPROXIMATE; EXACT LOCATIONS TO BE DETERMINED IN THE FIELD.
3.

ALL SIGN PLACEMENT SHALL BE IN CONFORMANCE WITH VAOT STANDARD E-121 STANDARD SIGN PLACEMENT CONVENTIONAL ROADS, UNLESS OTHERWISE NOTED.
4.

ALL SIGNS, FRAMES, MOUNTING HARDWARE, POSTS, AND ANCHORS FOR ANY SIGN ASSEMBLY SHALL BE REPLACED AT THE SAME TIME. MIXING OF OLD AND NEW SIGNS ON THE SAME ASSEMBLY WILL NOT BE ALLOWED.
5.

NEW SIGNS, WITH THEIR GREATER NIGHTTIME RETROREFLECTIVITY, CAN OBSCURE OLDER SIGNS MOUNTED IN CLOSE PROXIMITY TO THEM. TO AVOID CONFUSION OF ROAD USERS, WORK SHALL BE COORDINATED SUCH THAT ALL SIGNS ASSOCIATED WITH A CURVE, INTERSECTION OR SPEED LIMIT CHANGE SHALL BE REPLACED ON THE SAME DAY AND NOT LEFT INCOMPLETE OR WITH A MIXTURE OF OLD AND NEW SIGNS WITHIN A GROUP OF ASSOCIATED SIGNS.
6.

ALL NEW SIGN INSTALLATIONS, IF NEAR A UTILITY POLE, SHALL BE NO CLOSER THAN 10 FEET FROM THE UTILITY POLE.

STREET NAME SIGN INSTALLATION:

1.


SIDE ROAD STREET NAME SIGNS, COMMONLY INSTALLED PERPENDICULAR TO APPROACHING MAINLINE TRAFFIC, SHALL BE POSITIONED IN SUCH A WAY AS TO ENSURE THE BEST POSSIBLE VISIBILITY TO APPROACHING MAINLINE TRAFFIC FROM EACH DIRECTION. IN MOST CASES, STREET NAME SIGNS MAY BE INSTALLED ABOVE THE SIDE ROAD STOP SIGN. IN CASES WHERE THE SIDE ROAD STOP SIGN POSITION WOULD NOT BE SUITABLE FOR A TOP-MOUNTED STREET NAME SIGN, OR DUE TO OTHER SITE-SPECIFIC CONSTRAINTS, THE STREET NAME SIGN MAY BE INSTALLED INDEPENDENTLY ON EITHER CORNER OF THE INTERSECTION. THE STREET NAME SIGNS SHALL BE INSTALLED A MINIMUM OF SIX FEET FROM THE EDGE OF PAVEMENT ON THE MAINLINE ROUTE TO THE NEAREST EDGE OF THE SIGN.
2.

STREET NAME SIGNS WITH A LENGTH EXCEEDING 42-INCHES SHALL BE INSTALLED ON TWO POSTS. UNLESS PROTECTED BY BARRIER, THIS TWO POST ASSEMBLY SHALL BE LATERALLY OFFSET A MINIMUM OF TWO FEET (IN THE DIRECTION OF MAINLINE TRAFFIC) FROM ANY OTHER SIGN POST; NO MORE THAN TWO POSTS SHALL OCCUPY AN EIGHT FOOT TRAVEL PATH, UNLESS PROTECTED BY BARRIER.
3.

TOP-MOUNTED STREET NAME SIGNS SHALL REQUIRE 12-INCH MOUNTING BRACKETS. MOUNTING BRACKET AND ALL MOUNTING HARDWARE IS INCIDENTAL TO PAY ITEM 675.20 (TRAFFIC SIGN, TYPE A).
4.

IF EXISTING STREET SIGNS ARE SALVAGED THEY SHALL BE RE-INSTALLED PER THE ABOVE NOTES OR AS DIRECTED BY THE ENGINEER.
5.

STREET NAME SIGNS FOR PRIVATE ROADS SHALL BE RETAINED, UNLESS OTHERWISE NOTED OR AS DIRECTED BY THE ENGINEER.

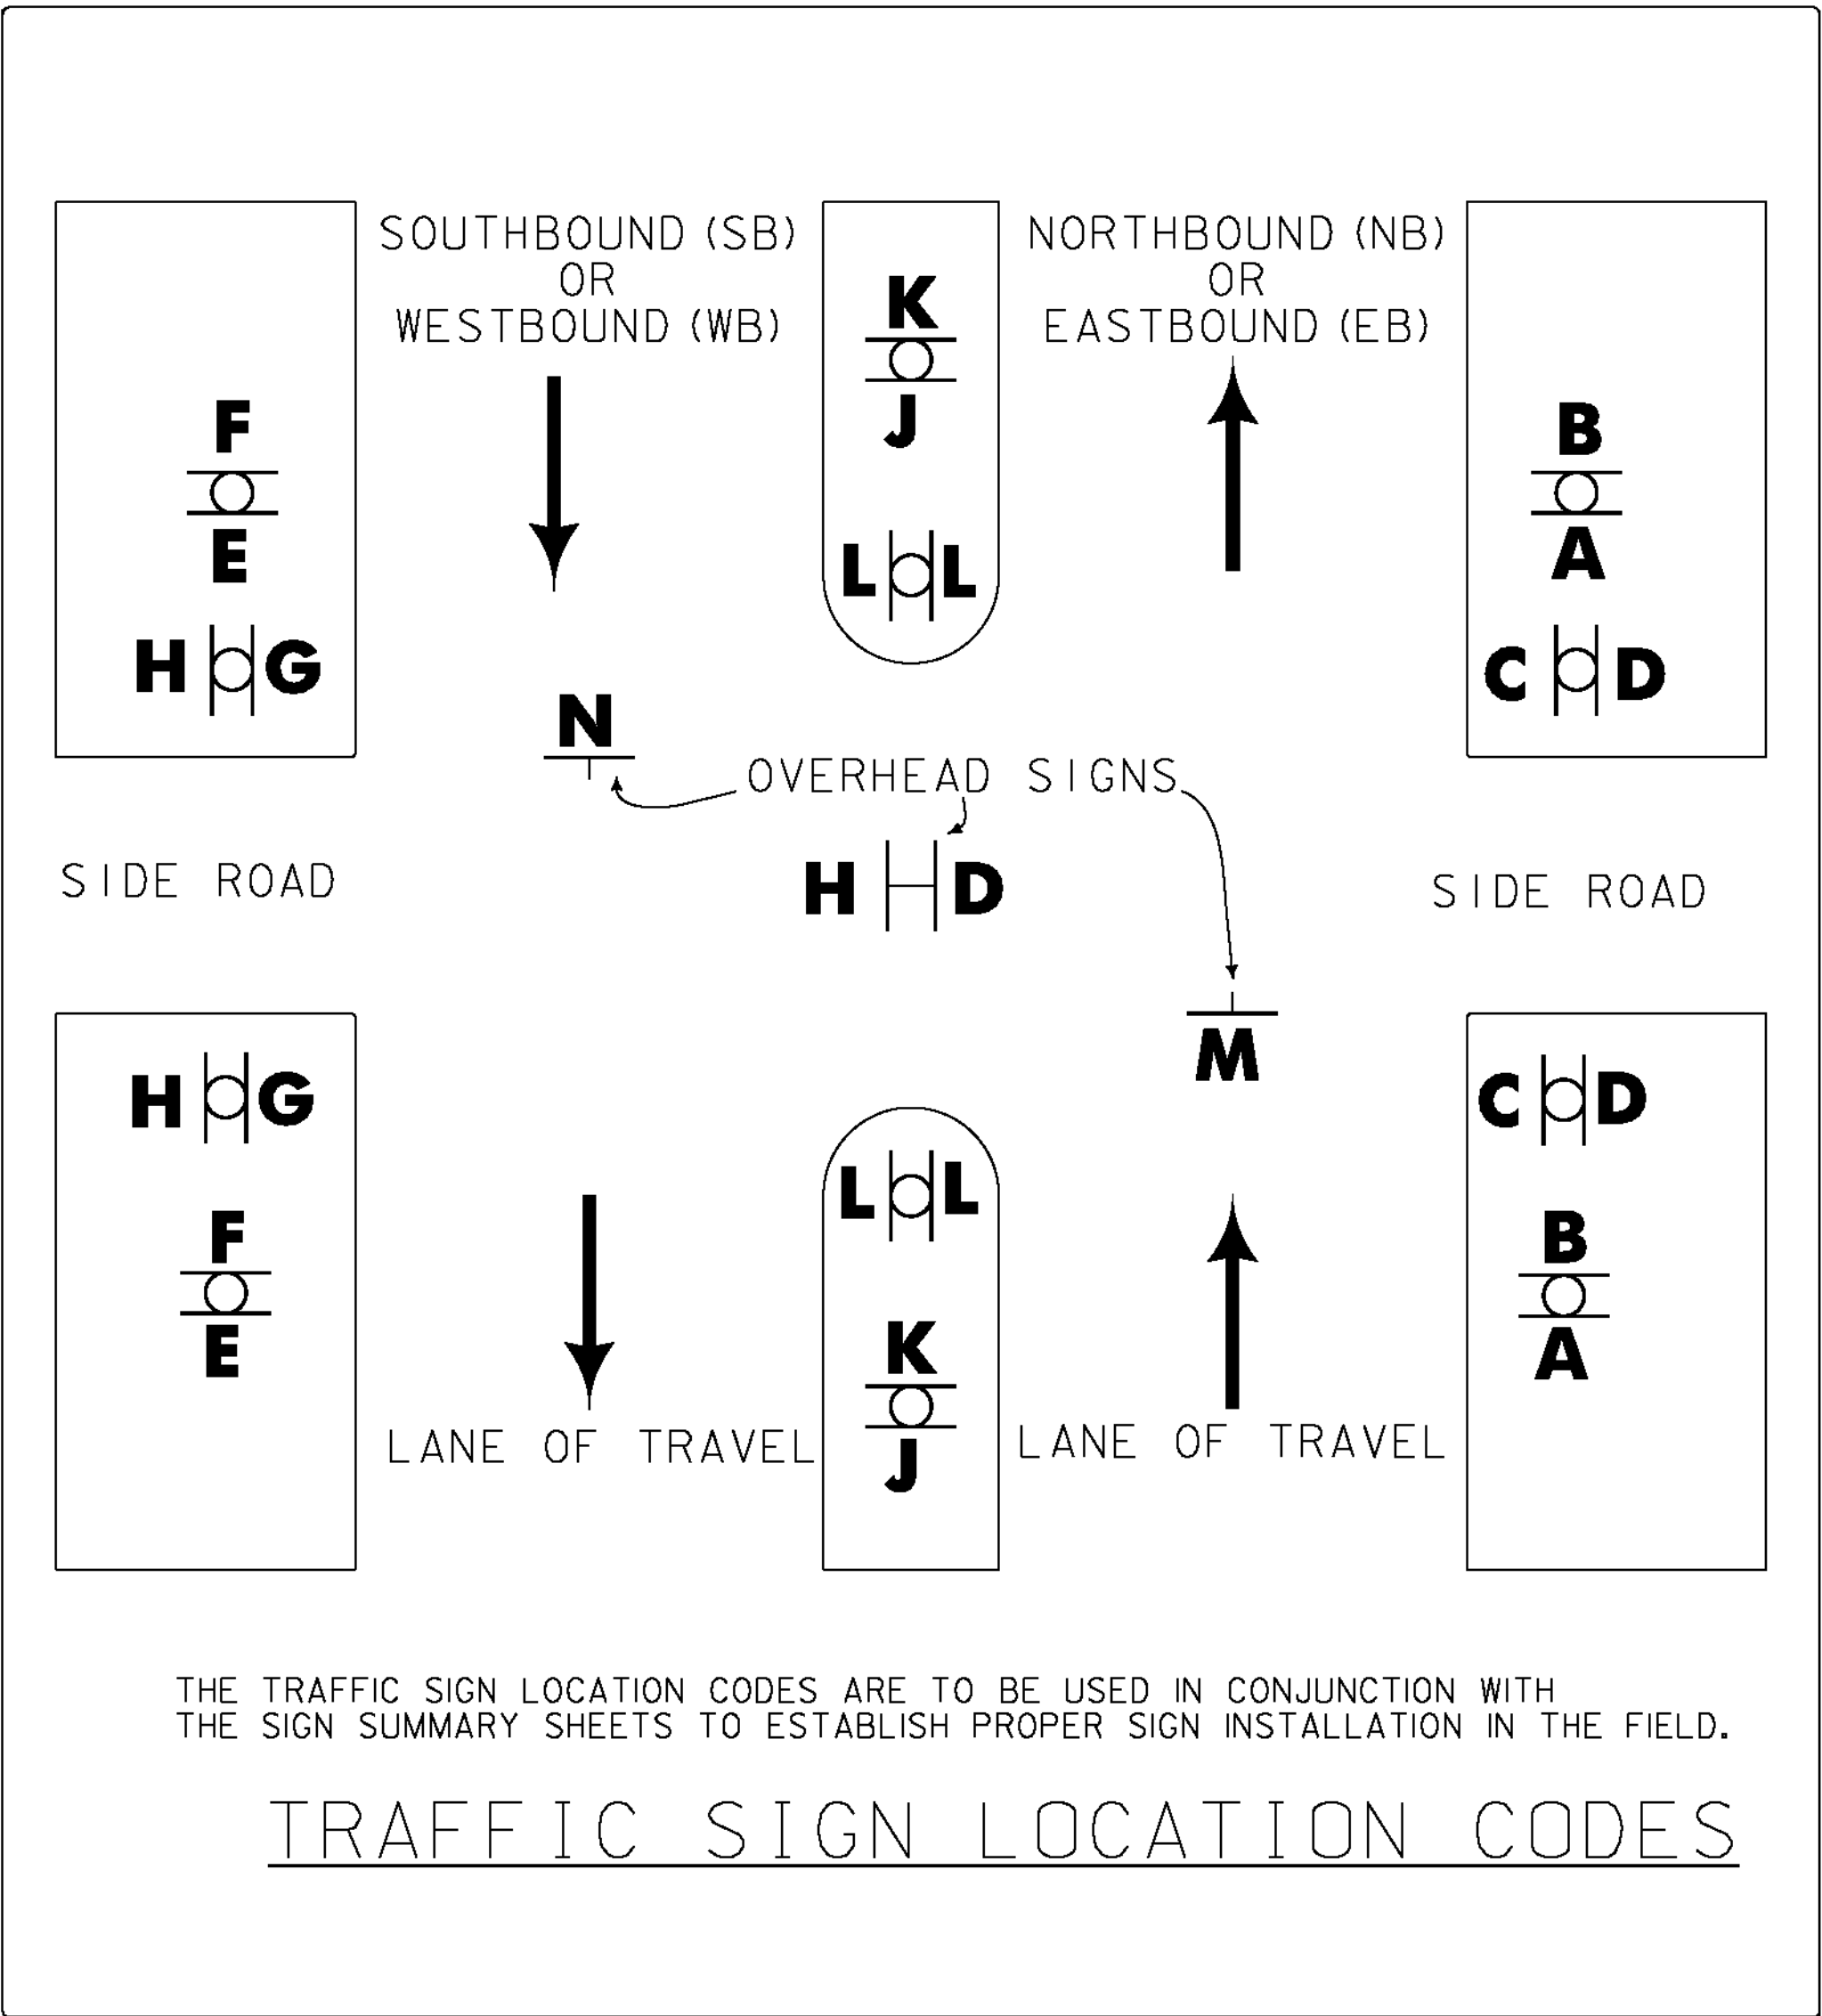

THE TRAFFIC SIGN LOCATION CODES ARE TO BE USED IN CONJUNCTION WITH THE SIGN SUMMARY SHEETS TO ESTABLISH PROPER SIGN INSTALLATION IN THE FIELD.

TRAFFIC SIGN LOCATION CODES

GENERAL NOTES:

1.

EXISTING STAND-ALONE MILE MARKER SIGNS, OR MILE MARKER SIGNS ATTACHED TO A RETAINED SIGN POST ASSEMBLY, SHALL BE RETAINED.
2.

EXISTING MILE MARKER SIGNS ON SIGN POSTS BEING REPLACED SHALL BE REMOVED AND SALVAGED ONTO THE NEW SIGN POST, UNLESS OTHERWISE NOTED ON THE APPLICABLE SIGN SUMMARY SHEET OR AS DIRECTED BY THE ENGINEER.
3.

EXISTING MILE MARKER SIGNS ATTACHED TO A SIGN ASSEMBLY THAT IS TO BE REMOVED OR RELOCATED SHALL BE REMOVED AND DISPOSED OF, UNLESS OTHERWISE NOTED ON THE APPLICABLE SIGN SUMMARY SHEET OR AS DIRECTED BY THE ENGINEER.
4.

ESTIMATED QUANTITIES OF CONTRACT ITEMS 675.50 REMOVING SIGNS AND 675.60 ERECTING SALVAGED SIGNS HAVE BEEN INCLUDED FOR MILE MARKER AND STREET NAME SIGNS.
5.

SELECTIVE CUTTING OF BRUSH OR TREE BRANCHES IN THE IMMEDIATE VICINITY OF A SIGN MAY BE NECESSARY TO PROVIDE FULL VISIBILITY FOR ANY EXISTING (RETAINED) OR NEW SIGN LOCATION. THIS WORK WILL BE PERFORMED AT THE DIRECTION OF THE ENGINEER AND PAID FOR UNDER CONTRACT ITEM 201.31 THINNING AND TRIMMING FOR SIGNS. THIS WORK SHALL BE DONE AT THE SAME TIME THE SIGN IS INSTALLED, OR AS DIRECTED BY THE ENGINEER. ALL SIGNS SHALL BE FULLY VISIBLE FROM THE APPROACHING TRAVEL LANE FOR A MINIMUM DISTANCE OF 250 FEET.

PROJECT NAME: STATEWIDE SW REGION

PROJECT NUMBER: STPG SIGN (41)

FILE NAME: I2CI18_TS.DGN
PROJECT LEADER: A. GAMBLE
DESIGNED BY: J. KELLY
PROJECT NOTES

PLOT DATE: 13-FEB-2013
DRAWN BY: J. KELLY
CHECKED BY: A. GAMBLE
SHEET 2 OF 97

**STATE OF VERMONT
AGENCY OF TRANSPORTATION**

QUANTITY SHEET 1


[illegible]

PROJECT NAME: STATEWIDE SW REGION


PROJECT NUMBER: STPG SIGN (41)

FILE NAME: I2C118_TS.DGN
PROJECT LEADER: A. GAMBLE
DESIGNED BY: J. KELLY
QUANTITY SHEET 1

PLOT DATE: 13-FEB-2013
DRAWN BY: J. KELLY
CHECKED BY: A. GAMBLE
SHEET 3 OF 97

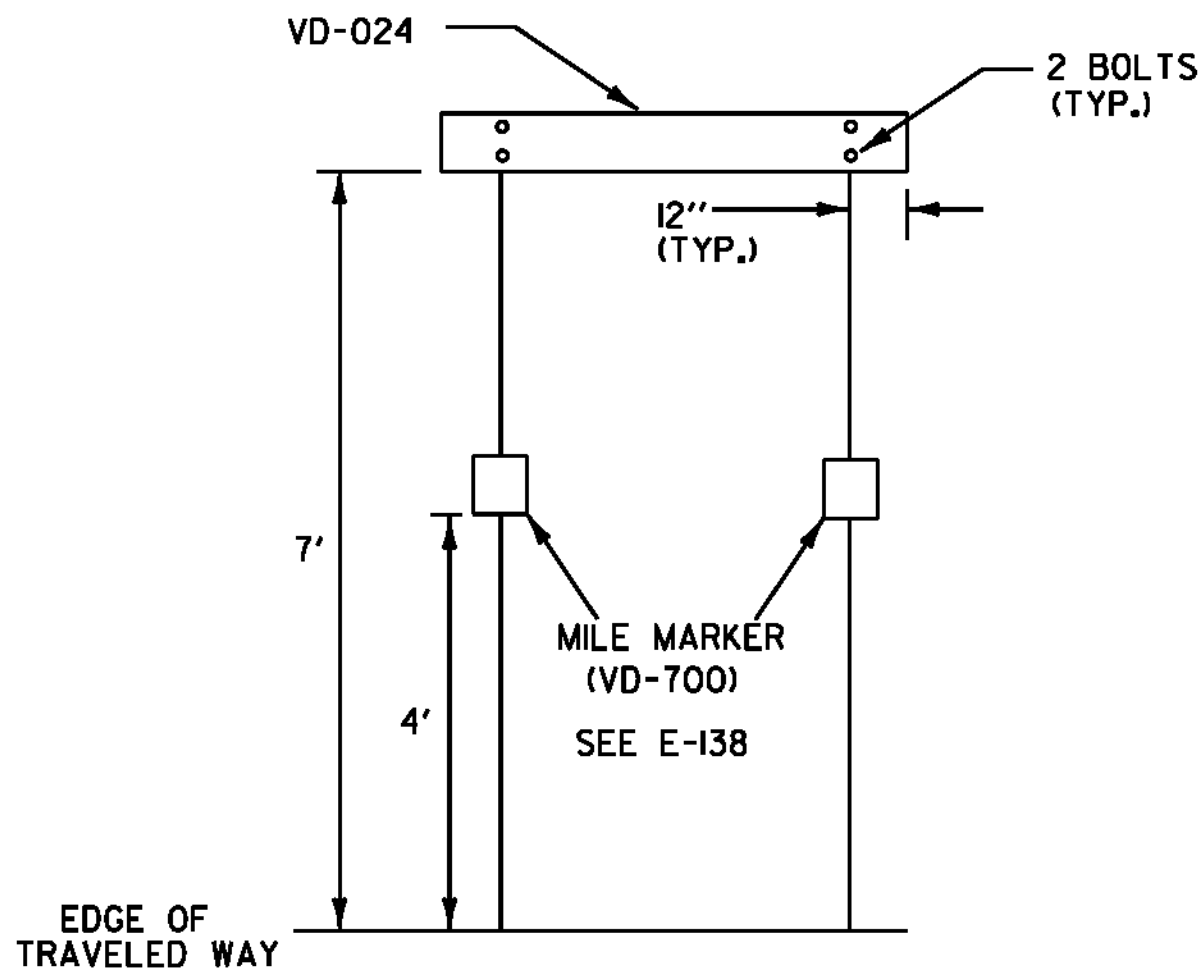


WHEN CROSSING COUNTY BOUNDARIES, AN ADDITIONAL COUNTY LINE SIGN (VD-025) SHALL BE MOUNTED BELOW THE TOWN LINE SIGN (VD-024), MAINTAINING A SEVEN FOOT CLEARANCE.

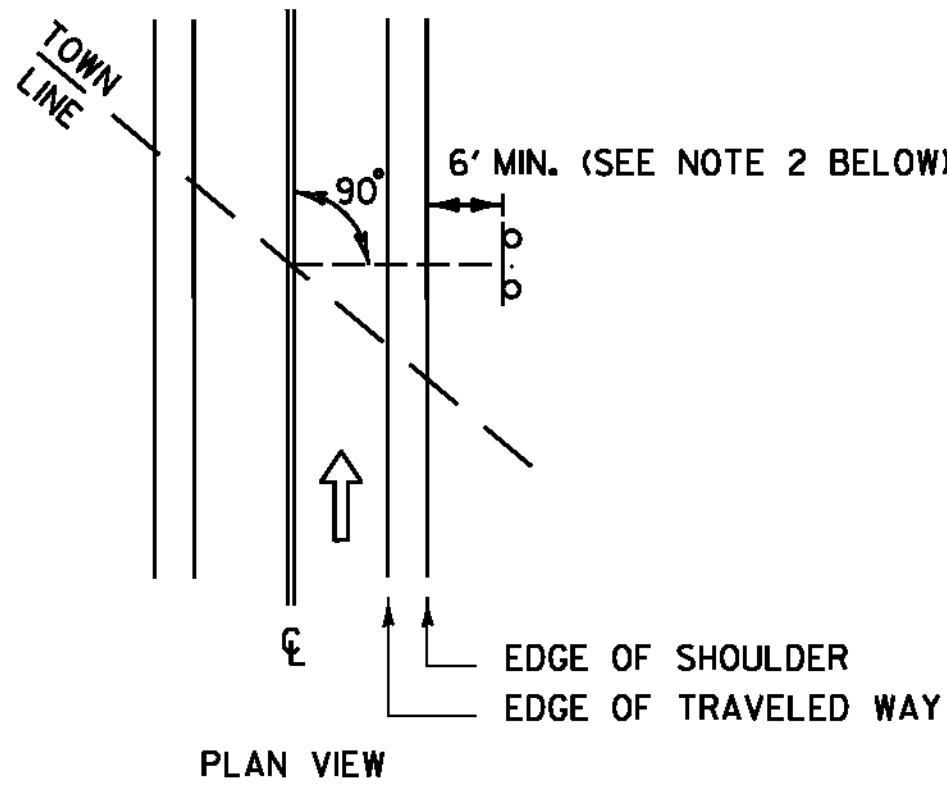


TOWN /COUNTY LINE (VD-024 /VD-025) INSTALLATION:

- THE SIGN SHALL BE MOUNTED PARALLEL WITH THE ROADWAY, NORMALLY ON THE RIGHT SIDE TRAVELING WEST TO EAST OR SOUTH TO NORTH.
- FOR POST-MOUNTED SIGNS, THE MINIMUM LATERAL OFFSET SHOULD BE TWELVE FEET FROM THE EDGE OF THE TRAVELED WAY. IF A SHOULDER WIDER THAN SIX FEET EXISTS, THE MINIMUM LATERAL OFFSET FOR POST-MOUNTED SIGNS SHOULD BE SIX FEET FROM THE EDGE OF SHOULDER.

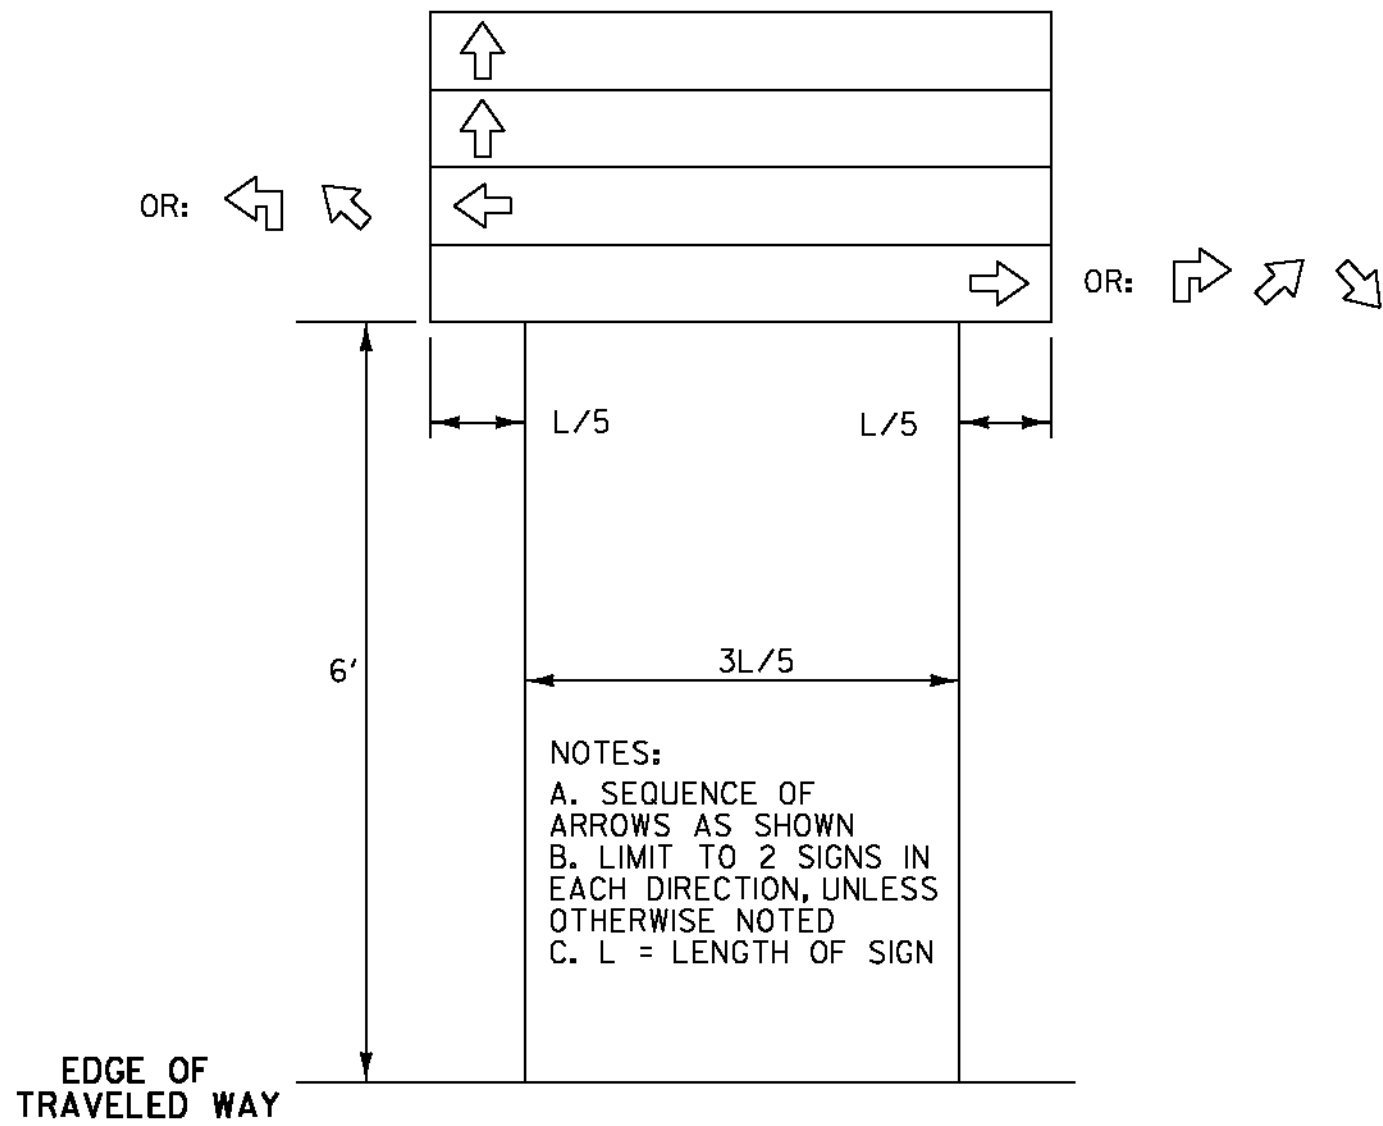


DESTINATION SIGNS (VD1-1, VD1-1A, VD1-2, VD2-1) ASSEMBLY:

- THE DESTINATION SIGN DETAILS SHOWN ON SHEETS 9 AND 10 SHALL HAVE WHITE RETROREFLECTIVE ASTM D 4956 TYPE III OR IV TEXT, ARROWS AND BORDERS ON A GREEN RETROREFLECTIVE ASTM D 4956 TYPE III OR IV BACKGROUND.
- FONT SPACING SHOWN ON AN INDIVIDUAL SIGN DETAIL MAY BE ADJUSTED SLIGHTLY TO MEET DIMENSION REQUIREMENT(S).
- DIMENSIONS SHOWN ON THE INDIVIDUAL SIGN DETAILS MAY BE ADJUSTED SLIGHTLY TO ACCOMMODATE VARIOUS MANUFACTURER'S LETTER WIDTHS.

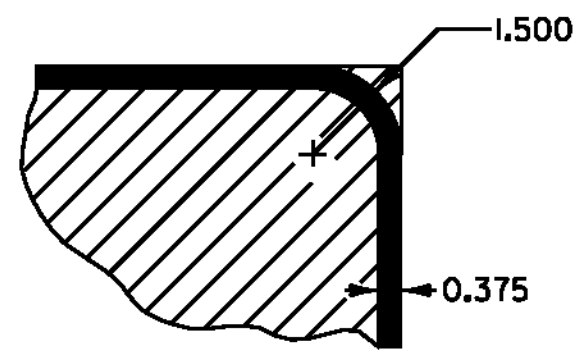


BORDER DETAIL


NOTE: TRIM CORNERS FOR ALUMINUM SIGNS

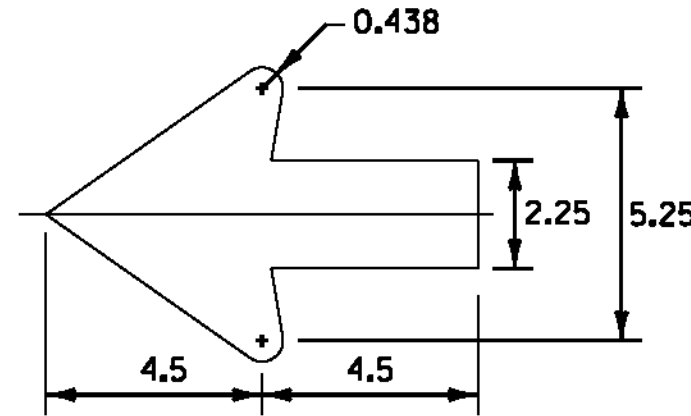

STANDARD SHSM 2.25" ARROW

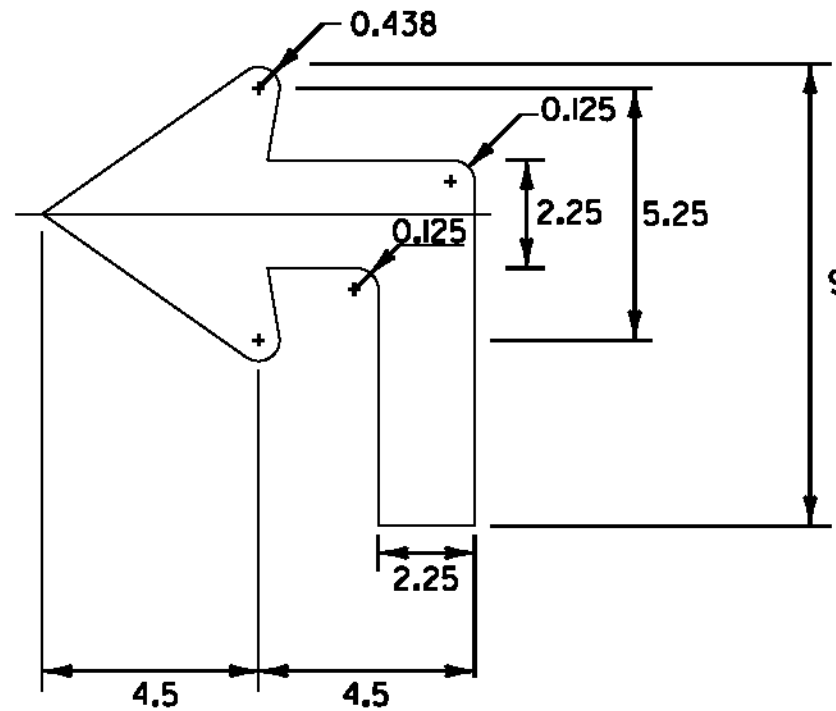


ADVANCE 2.25" ARROW

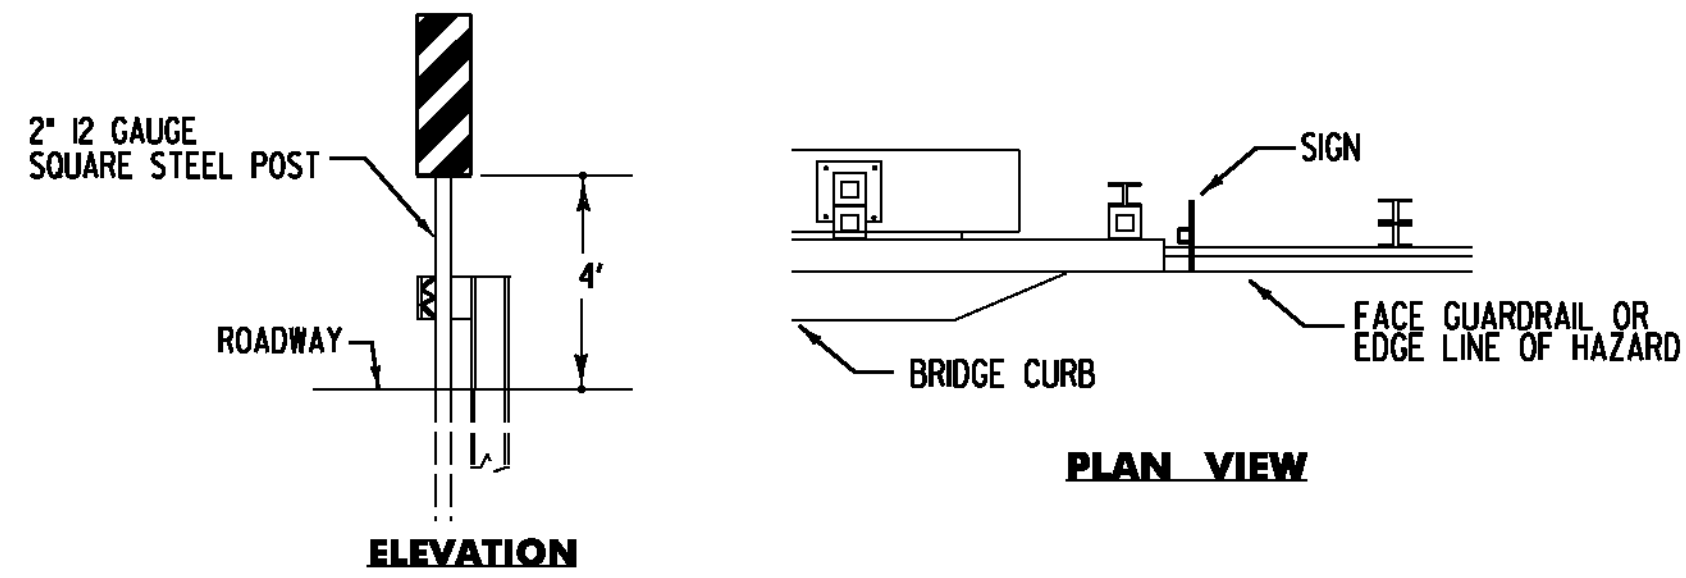


OBJECT MARKER (OM3-L or OM3-R) INSTALLATION:

- OBJECT MARKER SHOULD BE INSTALLED SO THAT THE INSIDE EDGE OF THE SIGN IS AS CLOSE AS POSSIBLE TO THE FACE OF GUARDRAIL OR INSIDE EDGE OF THE HAZARD.
- THE SIGN SHALL BE MOUNTED SO THE DIAGONAL STRIPES SLOPE DOWNWARDS TOWARD THE ROAD CENTERLINE.
- ASSEMBLY HARDWARE SHALL CONFORM TO SUBSECTION 750.12 (a). RIVETS SHALL NOT BE USED.
- SIGN BASE MATERIAL SHALL BE 0.100" FLAT SHEET ALUMINUM.
- MOUNTING HARDWARE FOR SIGNS ATTACHED TO ABUTMENTS OR HAZARDS SHALL BE APPROVED BY THE ENGINEER.
- PAYMENT FOR ALL MATERIALS AND LABOR NECESSARY TO ATTACH AN OBJECT MARKER SIGN TO ANYTHING OTHER THAN A SIGN POST WILL BE PAID FOR AS ONE 15 FT LONG 2.0" SQUARE STEEL SIGN POST.

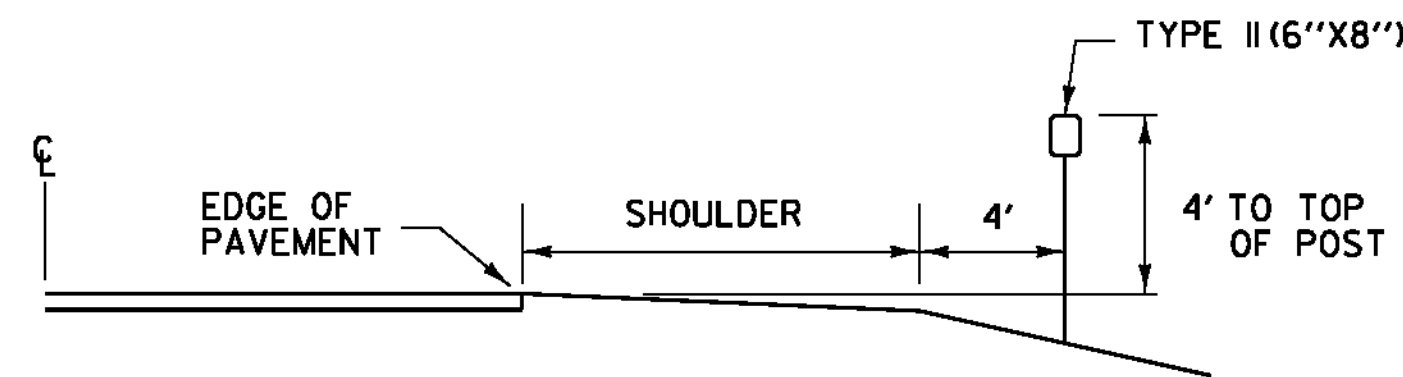

DELINEATOR PLACEMENT

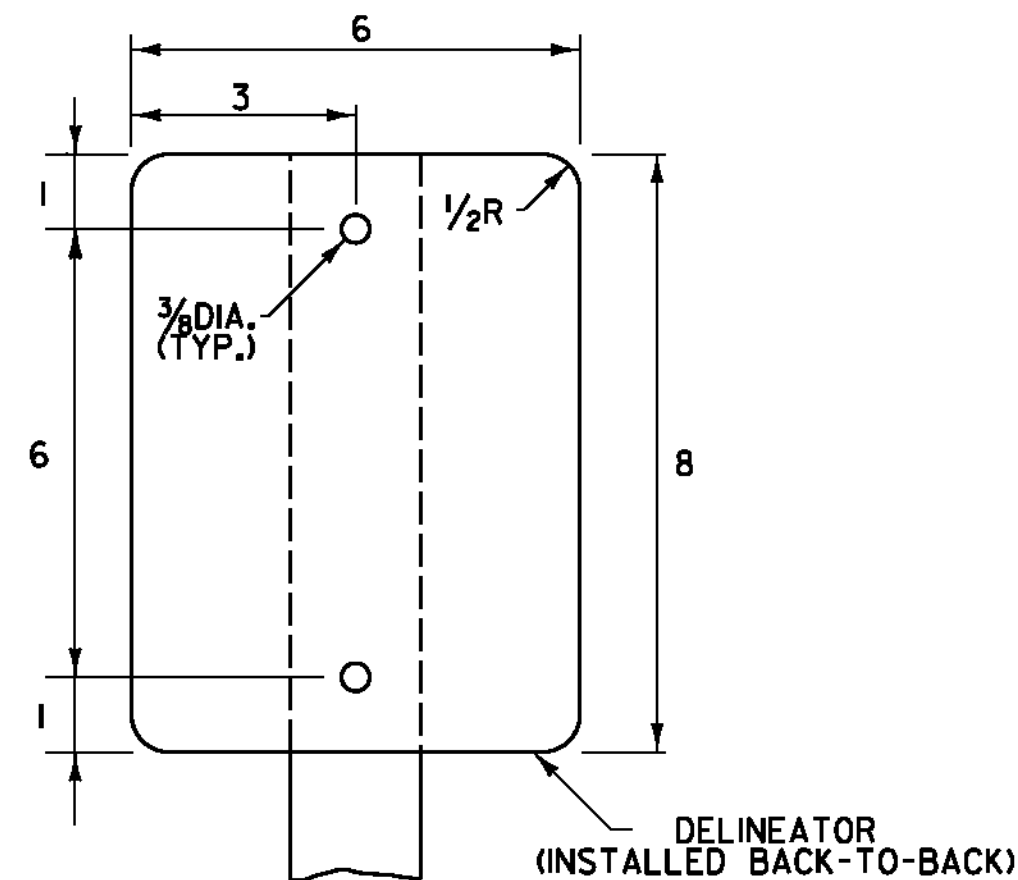

TYPE II (6"x8") DELINEATOR

ALL DIMENSIONS SHOWN IN INCHES, EXCEPT WHERE NOTED.

PROJECT NAME: STATEWIDE SW REGION

PROJECT NUMBER: STPG SIGN (41)

FILE NAME: I2CI18.SD.I

PROJECT LEADER: A. GAMBLE

DESIGNED BY: J. KELLY

SIGN DETAILS I

PLOT DATE: 13-FEB-2013


DRAWN BY: J. KELLY

CHECKED BY: A. GAMBLE

SHEET 4 OF 97

NOT TO SCALE


ROUTE MARKER ASSEMBLY FRAMES

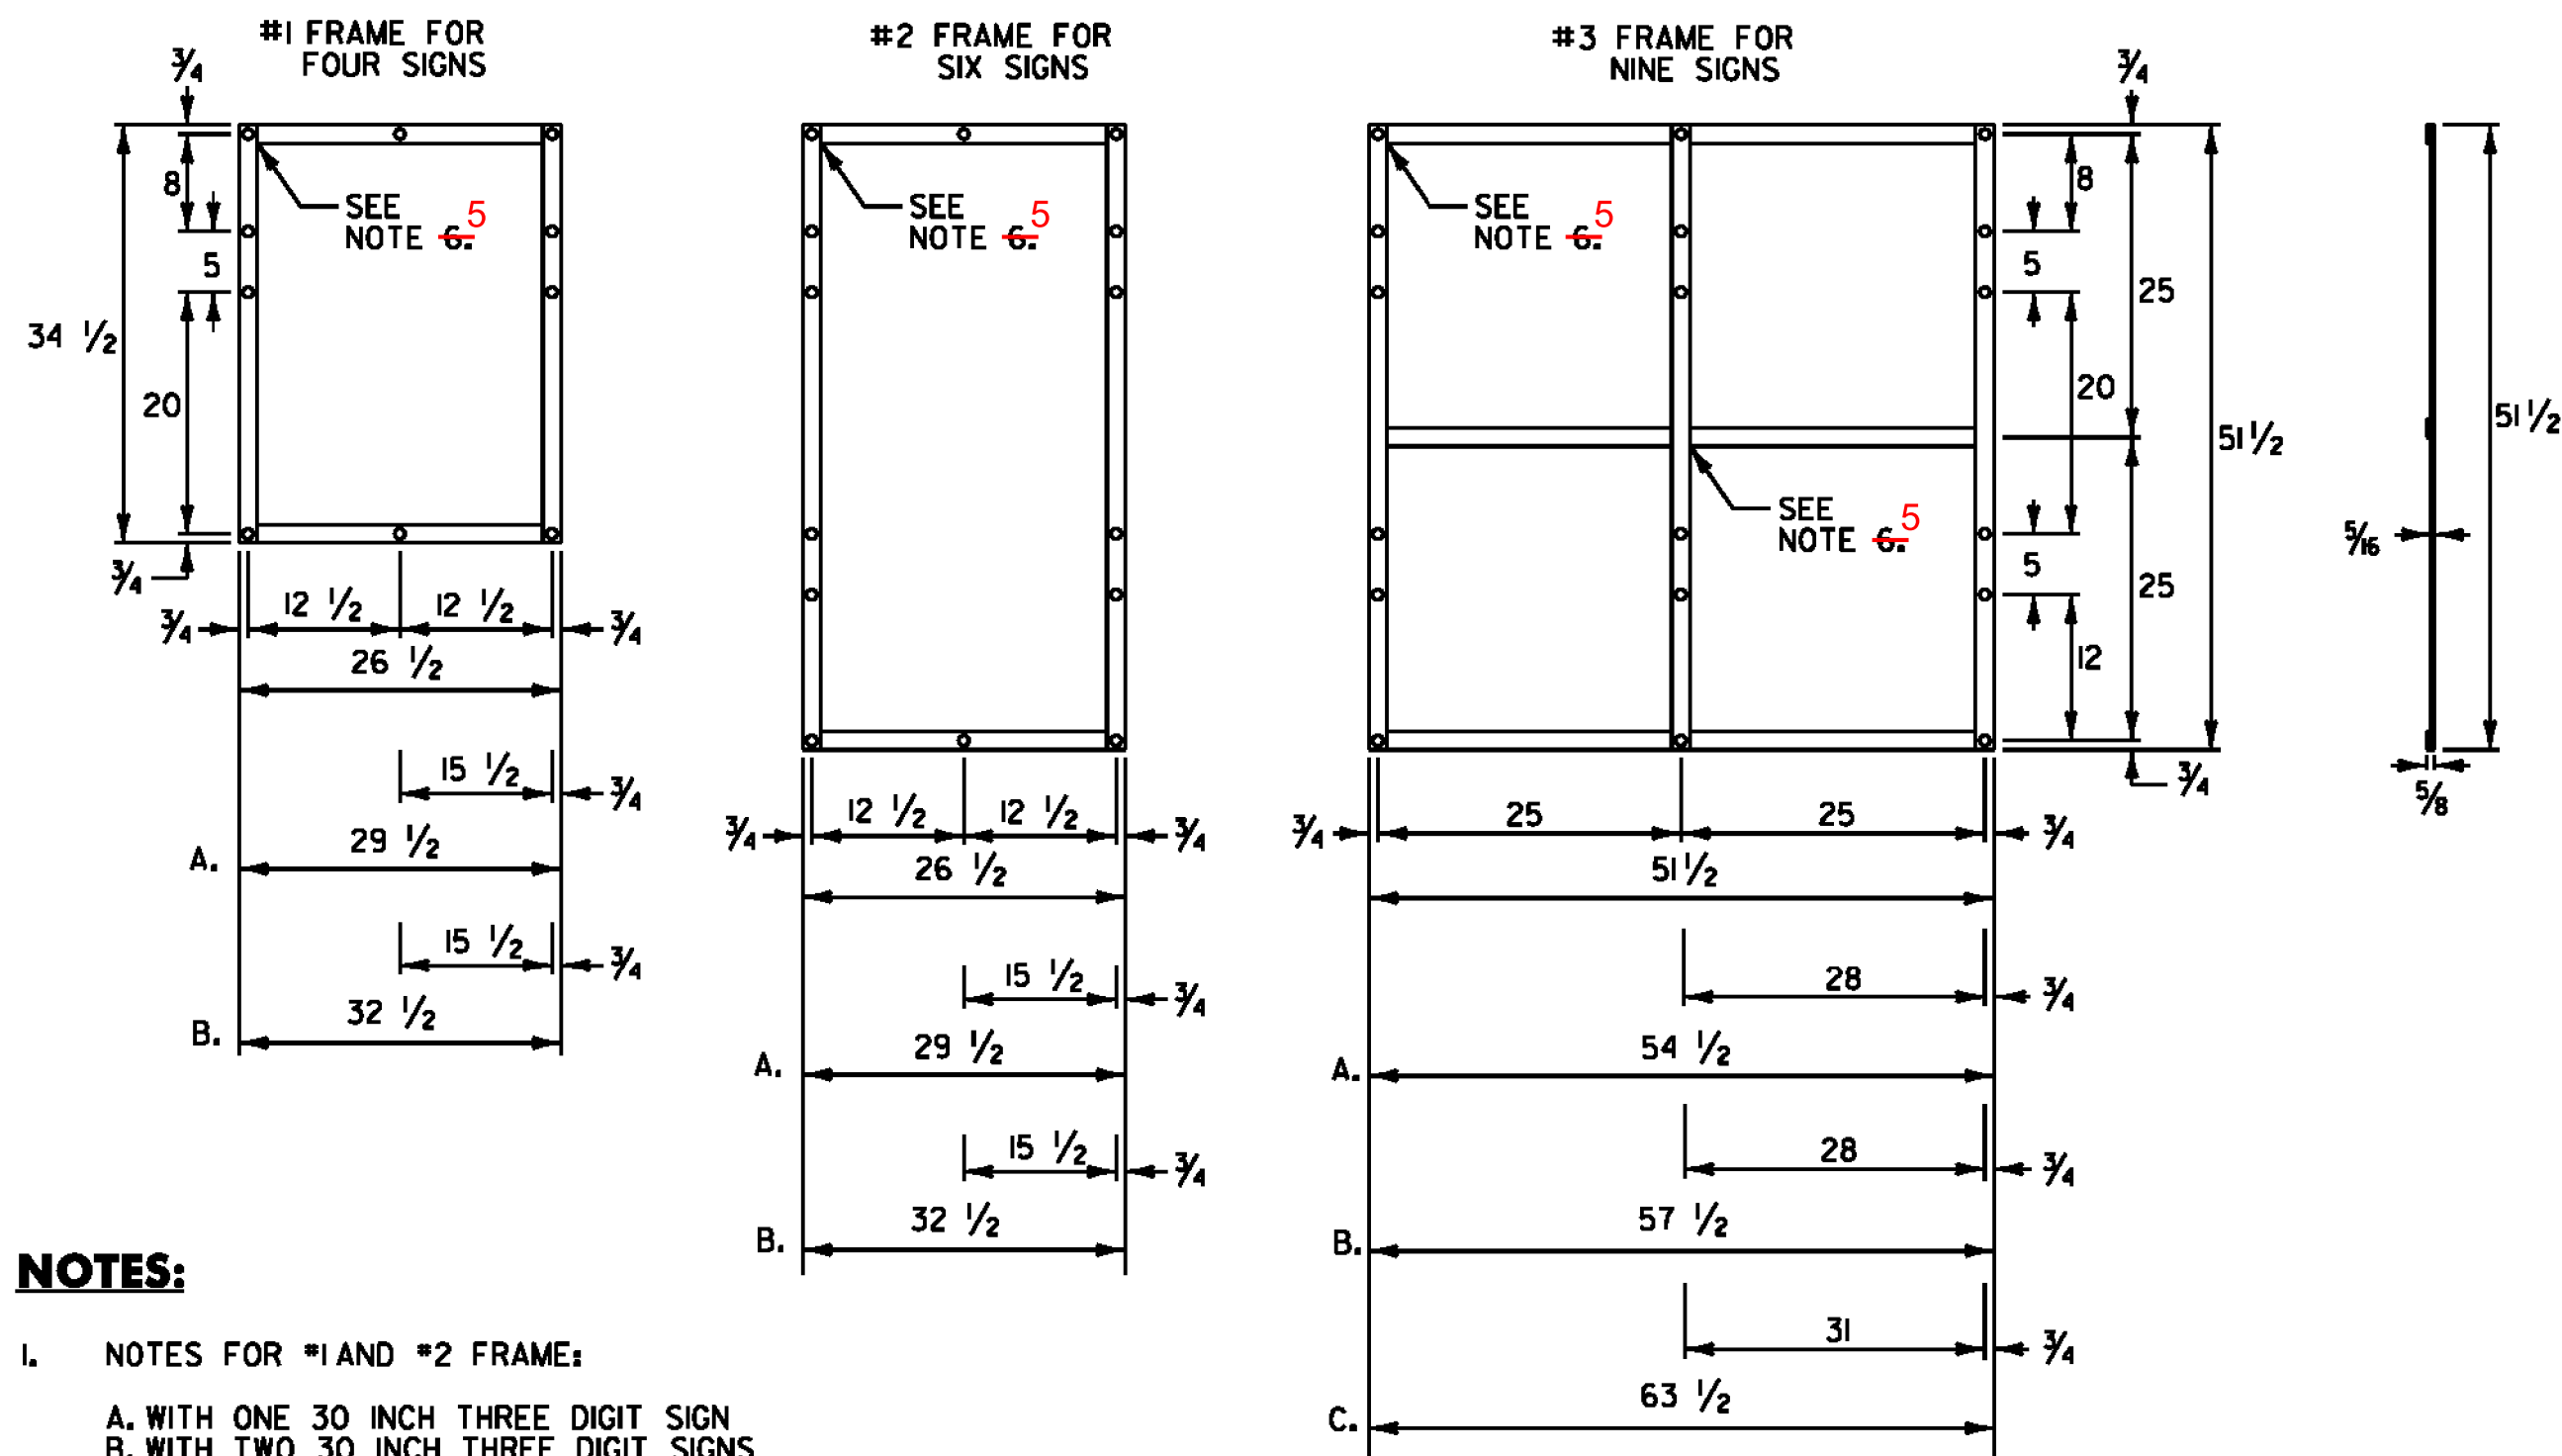

NOTES:

- NOTES FOR #1 AND #2 FRAME:
A. WITH ONE 30 INCH THREE DIGIT SIGN
B. WITH TWO 30 INCH THREE DIGIT SIGNS
- NOTES FOR #3 FRAME:
A. WITH ONE 30 INCH THREE DIGIT SIGN IN AN OUTSIDE POSITION.
B. WITH ONE 30 INCH THREE DIGIT SIGN IN THE CENTER POSITION OR TWO SUCH SIGNS IN THE OUTSIDE POSITIONS.
C. WITH THREE 30 INCH THREE DIGIT SIGNS.
- ALL HOLES SHALL BE 7/16 INCH DIAMETER. FOR OTHER SIGN COMBINATIONS THAN ABOVE, THE FRAME DIMENSIONS AND HOLE SPACING SHALL BE MODIFIED AS NECESSARY. THE FRAME SHALL BE PAINTED WITH ONE COAT OF PRIMER AND A SECOND COAT OF BLACK PAINT. THE PAINT SHALL BE OF THE TYPE USED ON EXTERIOR METAL SURFACES TO PREVENT METAL CORROSION.
- FRAMES SHALL BE CONSTRUCTED OF 5/16 INCH x 1 1/2 INCH A-36 STEEL.
- ALL OVERLAPPED CONNECTIONS SHALL BE WELDED WITH TWO 1/4 INCH WIDE FILLET WELDS, 1 1/2 INCHES LONG.

STANDARD MOUNTING OF ROUTE MARKER ASSEMBLIES

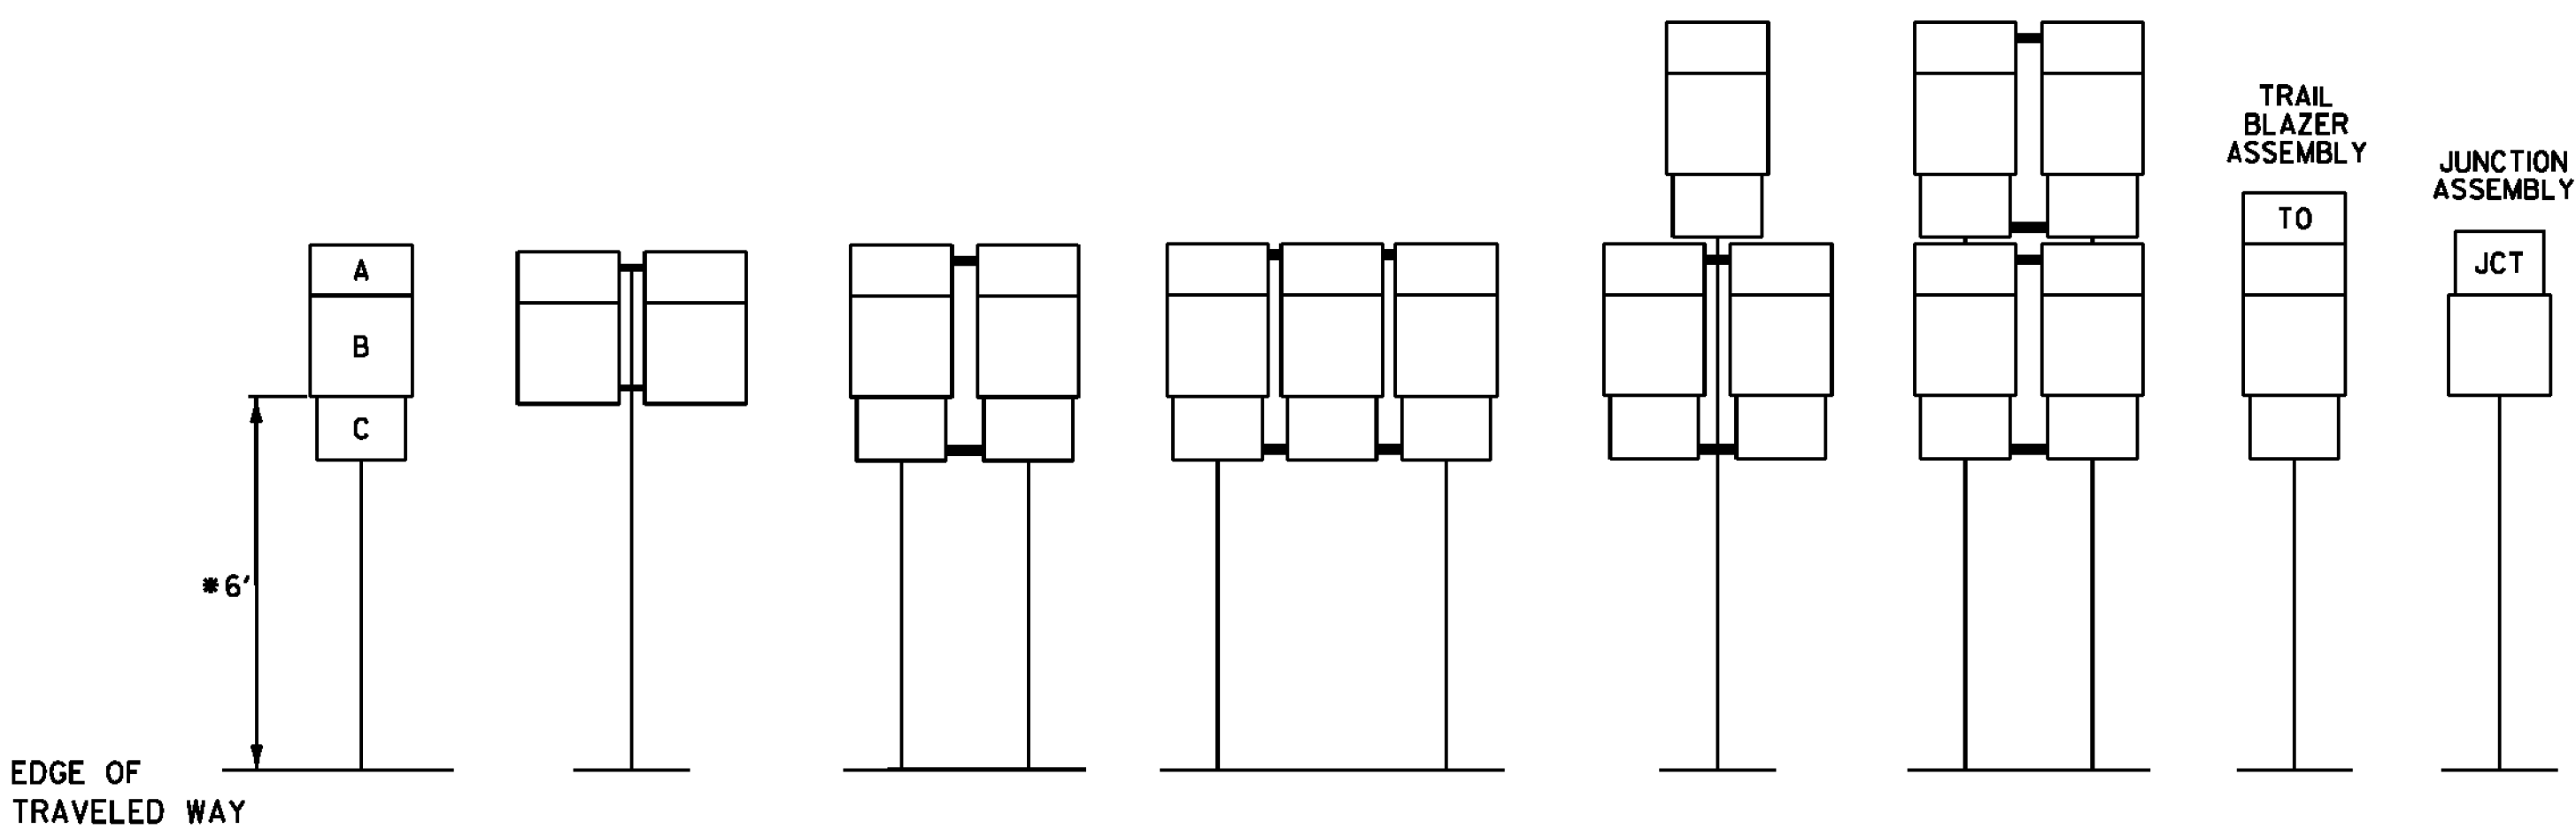

- A - CARDINAL DIRECTION MARKER
B - ROUTE NUMBER
C - ADVANCE TURN ARROW OR DIRECTIONAL ARROW







* WHERE PARKING OR PEDESTRIAN TRAFFIC WILL OCCUR IN THE IMMEDIATE VICINITY OF THESE SIGNS, MINIMUM VERTICAL CLEARANCE SHALL BE INCREASED TO SEVEN FEET.

INSTALLATION SEQUENCE:


IN MULTIPLE HORIZONTAL MOUNTINGS, PLACE A ROUTE MARKER ASSEMBLY INDICATING A LEFT TURN ON THE LEFT SIDE OF THE ASSEMBLY; RIGHT TURN ON THE RIGHT SIDE. FOR VERTICALLY STACKED MOUNTINGS, PLACE THE STRAIGHT THROUGH MOVE INDICATION ON TOP, THE LEFT OR RIGHT TURNS AS APPROPRIATE BENEATH.

NOTE:

VERTICAL FRAME MEMBERS SHALL LINE UP WITH SIGN POST ON WHICH THEY ARE MOUNTED.

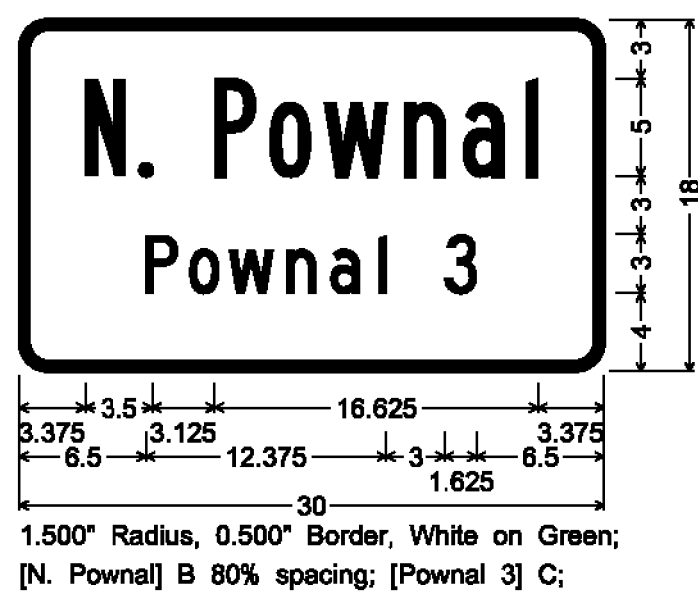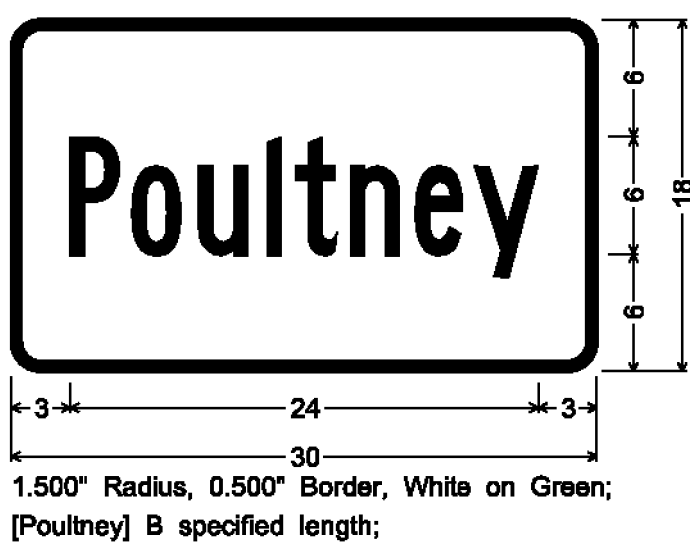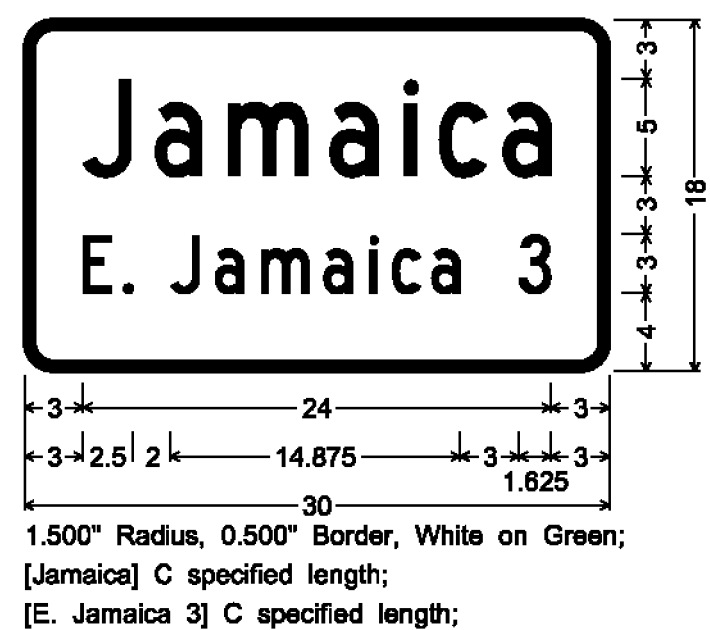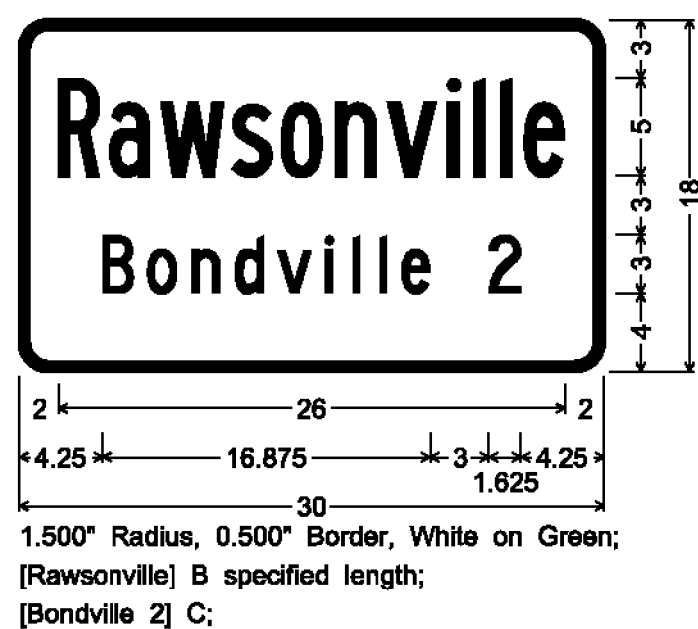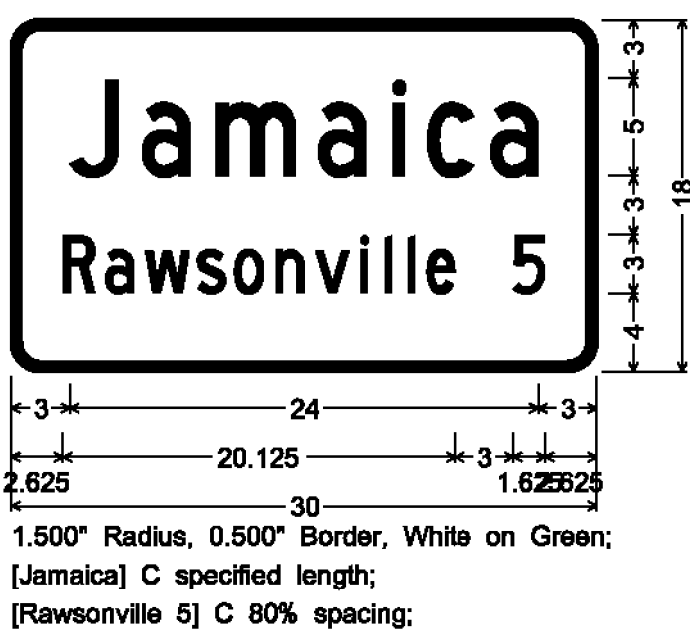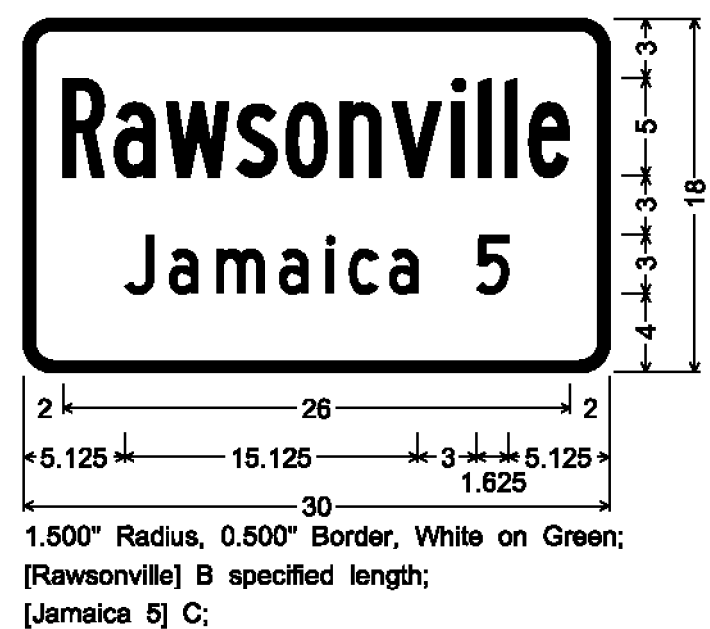

ALL SIGNS IN THIS SECTION ARE SIGN CODE VD-018

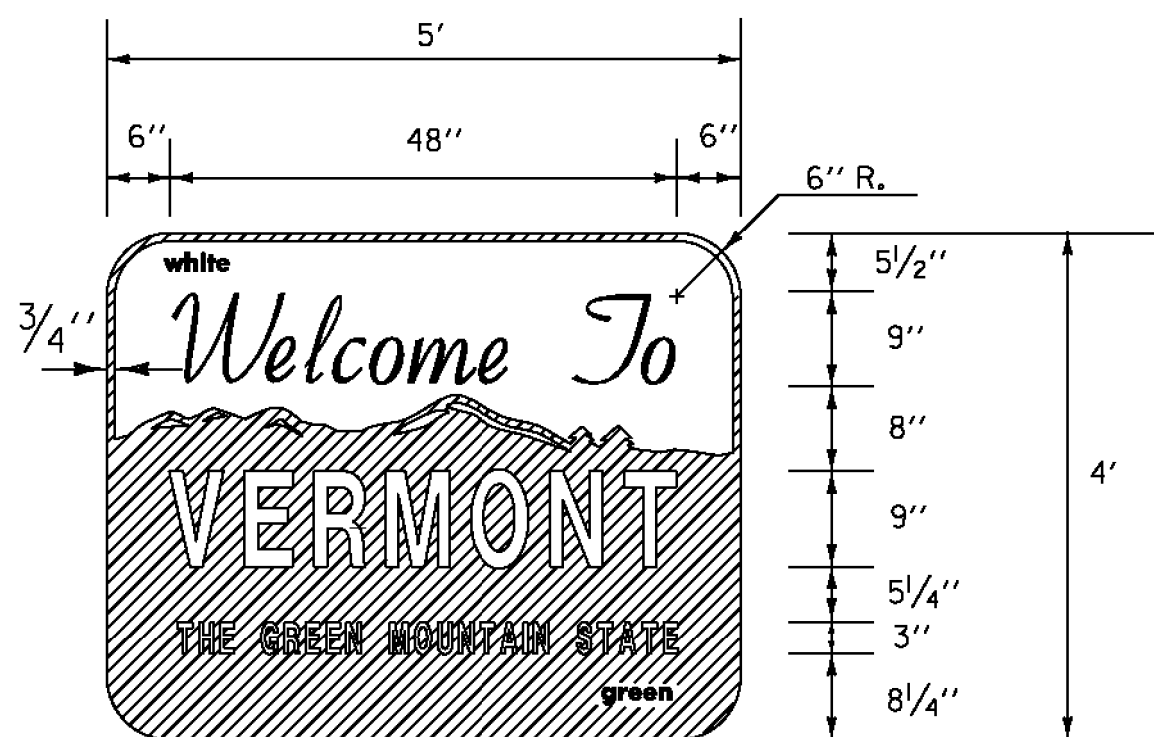

VD-421

NOTE:
FOR THE WORDS "WELCOME TO" USE GERBER FONT MURRAY HILL BOLD OR EQUIVALENT. TEXT COLOR IS GREEN.
ALL OTHER TEXT USE GERBER FONT SOUVENIR DEMIBOLD OR EQUIVALENT. TEXT COLOR IS WHITE.
ALL SHEETING SHALL BE MIN. ASTM D 4956 TYPE III RETROREFLECTIVE.

MATERIALS:
THE SIGN BASE MATERIAL USED FOR THIS SIGN SHALL BE FLAT SHEET ALUMINUM 0.125" MIN.



ALL DIMENSIONS SHOWN IN INCHES, UNLESS OTHERWISE NOTED.


PROJECT NAME: STATEWIDE SW REGION

PROJECT NUMBER: STPG SIGN (41)


FILE NAME: I2C118.SD_2
PROJECT LEADER: A. GAMBLE
DESIGNED BY: J. KELLY
SIGN DETAILS 2

PLOT DATE: 13-FEB-2013
DRAWN BY: J. KELLY
CHECKED BY: A. GAMBLE
SHEET 5 OF 97


NOT TO SCALE

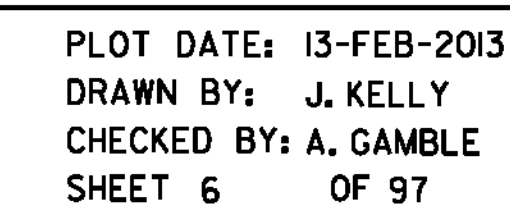


NOT TO SCALE

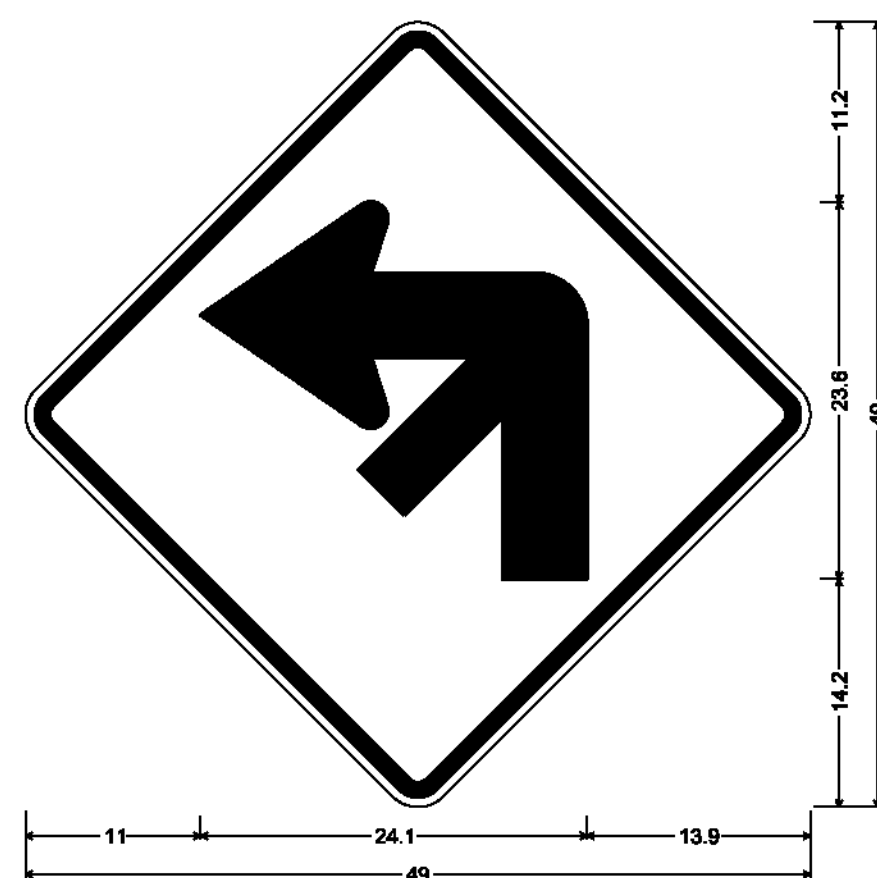


VW-11LML Left Turn, 4" Left Road, 36x36;
36.0" across sides 2.3" Radius, 0.9" Border, 0.6" Indent, Black on Yellow;

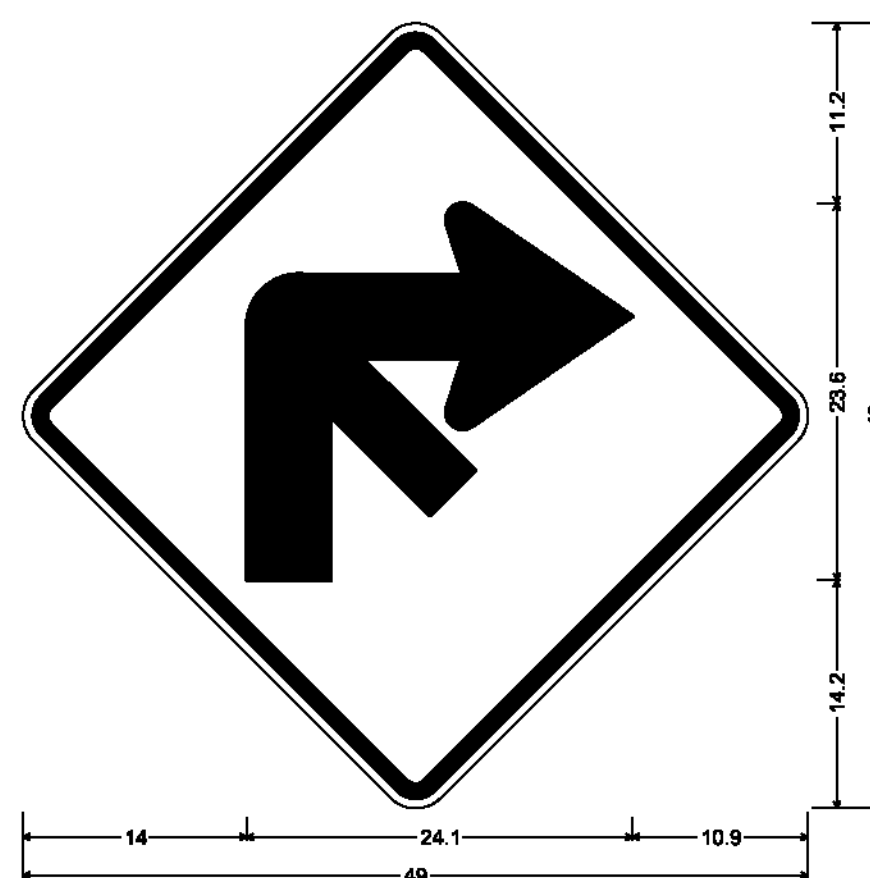


VW-11RMR Right Turn, 4" Right Road, 36x36;
36.0" across sides 2.3" Radius, 0.9" Border, 0.6" Indent, Black on Yellow;

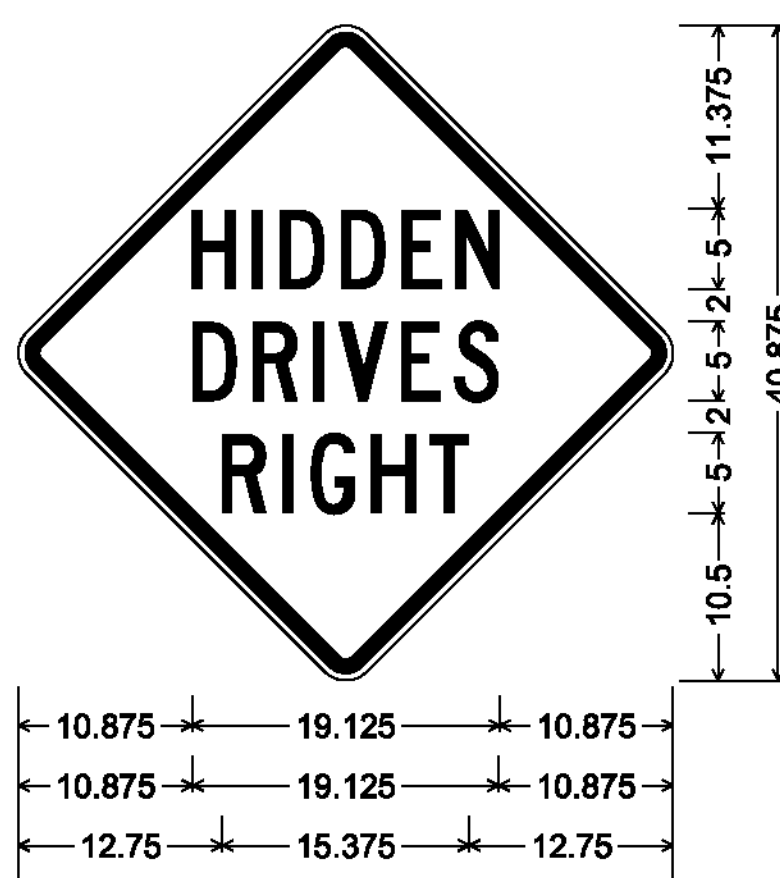


30.000" across sides 1.875" Radius, 0.750" Border, 0.500" Indent, Black on Yellow;
[HIDDEN] C; [DRIVES] C; [RIGHT] C;
VW-133R

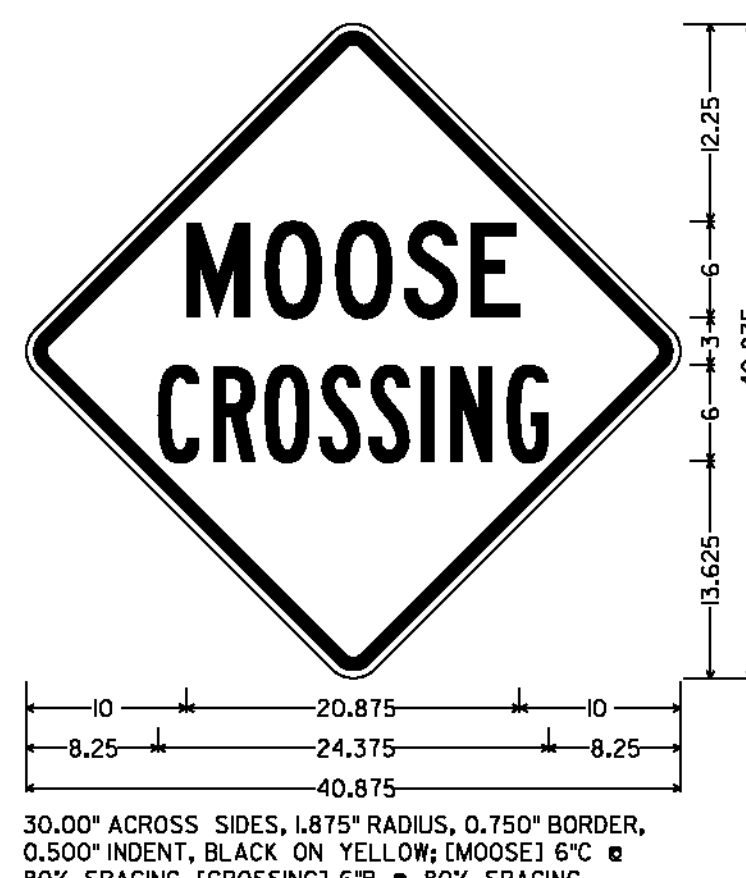


30.00" ACROSS SIDES, 1.875" RADIUS, 0.750" BORDER, 0.500" INDENT, BLACK ON YELLOW; [MOOSE] 6" 80% SPACING, [CROSSING] 6" 80% SPACING
VW-000

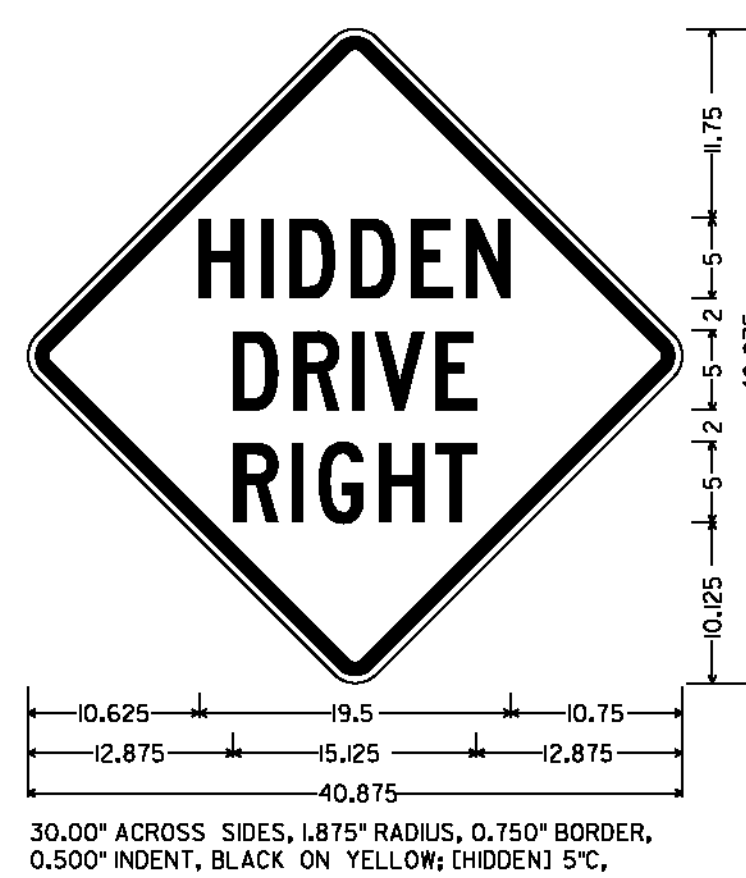


30.00" ACROSS SIDES, 1.875" RADIUS, 0.750" BORDER, 0.500" INDENT, BLACK ON YELLOW; [HIDDEN] 5", [DRIVE] 5", [RIGHT] 5"
VW-054R

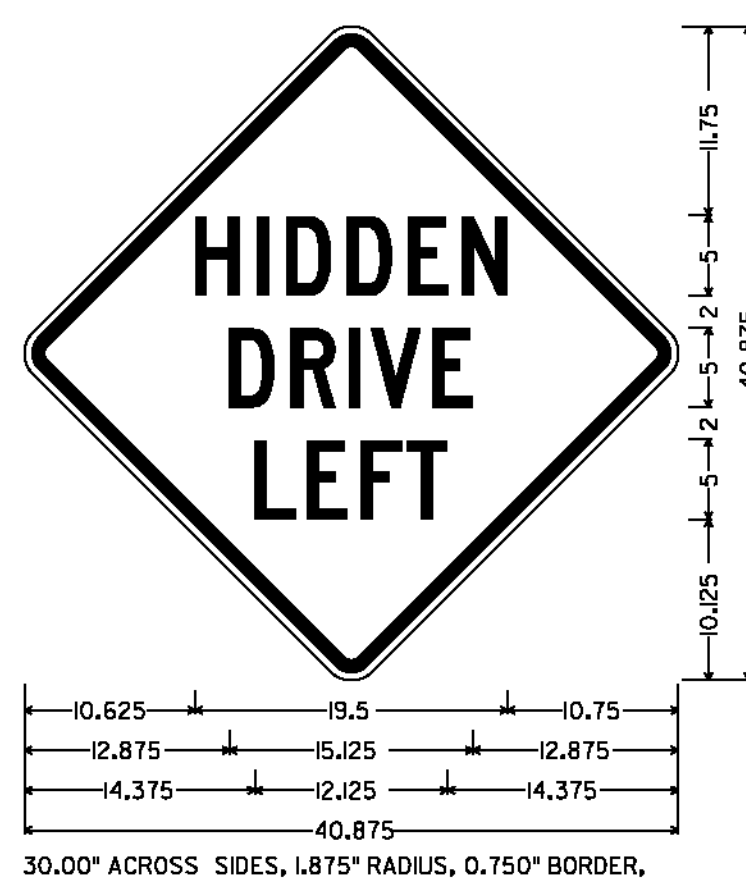


30.00" ACROSS SIDES, 1.875" RADIUS, 0.750" BORDER, 0.500" INDENT, BLACK ON YELLOW; [HIDDEN] 5", [DRIVE] 5", [LEFT] 5"
VW-054L

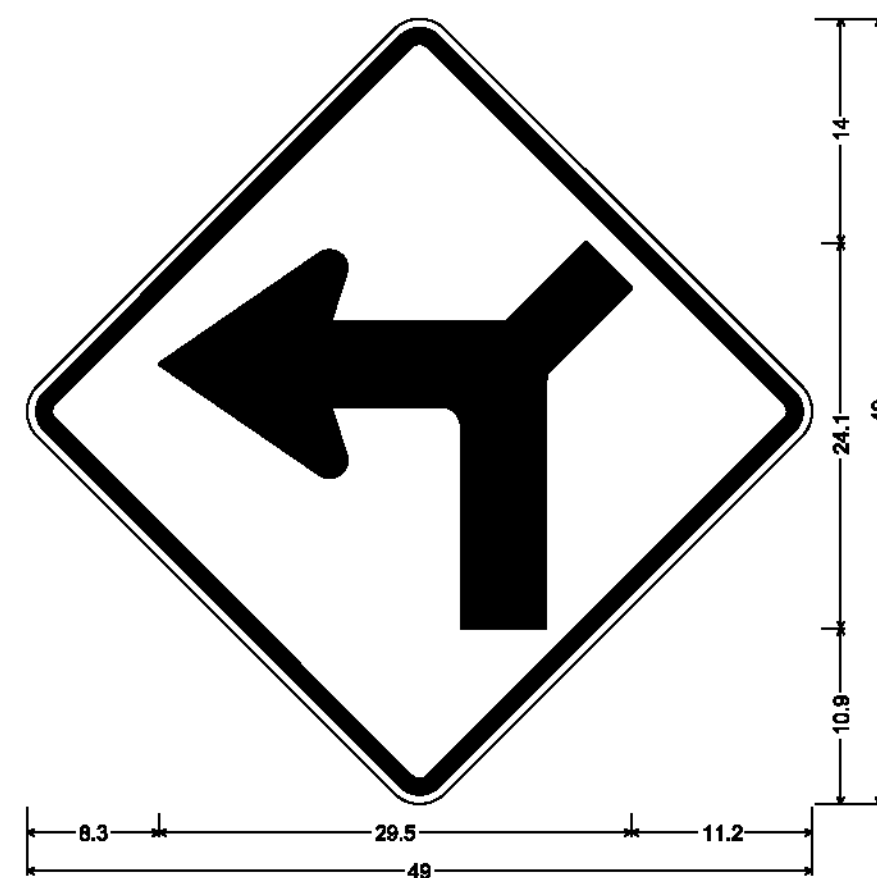


VW-11LML Left Turn, 4" Right Road, 36x36;
36.0" across sides 2.3" Radius, 0.9" Border, 0.6" Indent, Black on Yellow;

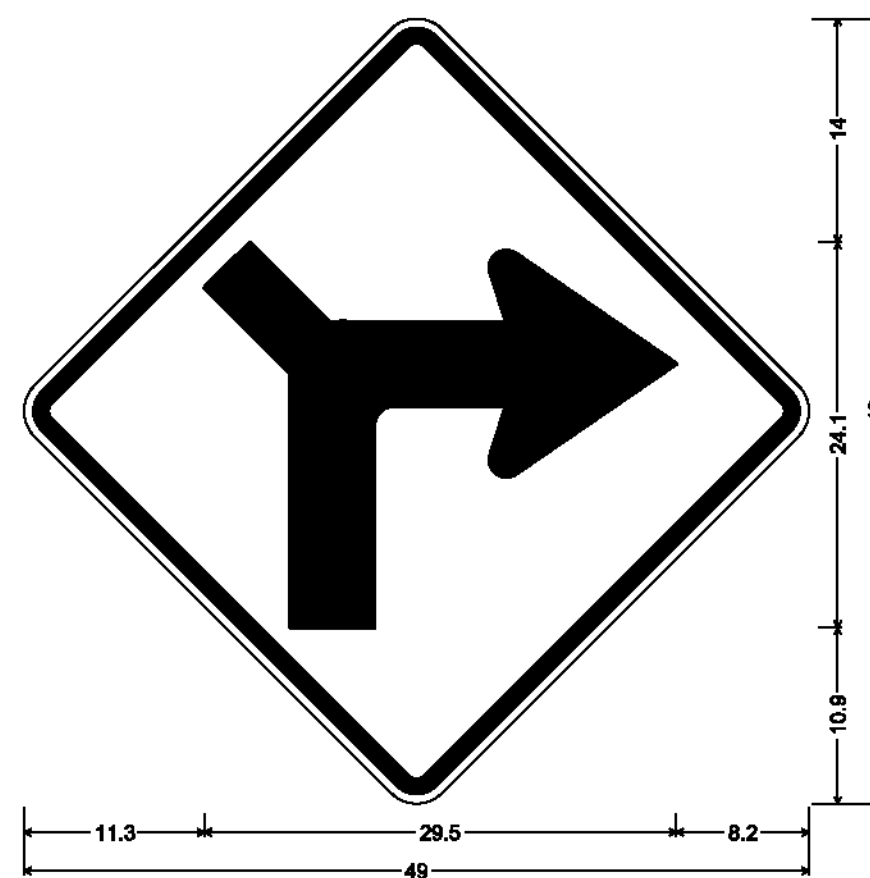


VW-11RML Right Turn, 4" Left Road, 36x36;
36.0" across sides 2.3" Radius, 0.9" Border, 0.6" Indent, Black on Yellow;

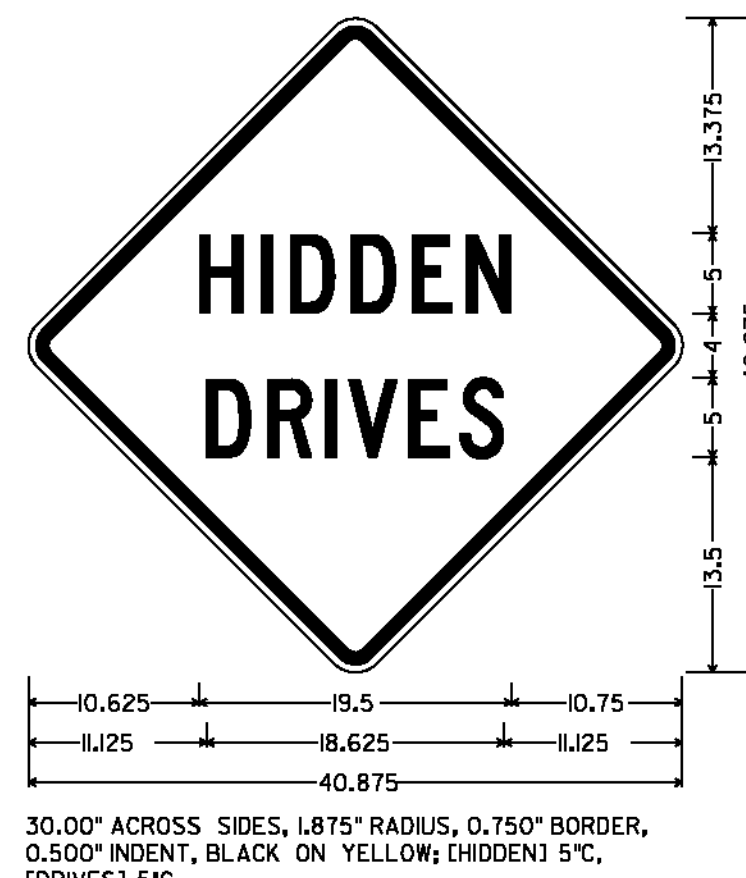


30.00" ACROSS SIDES, 1.875" RADIUS, 0.750" BORDER, 0.500" INDENT, BLACK ON YELLOW; [HIDDEN] 5", [DRIVES] 5"
VW-060

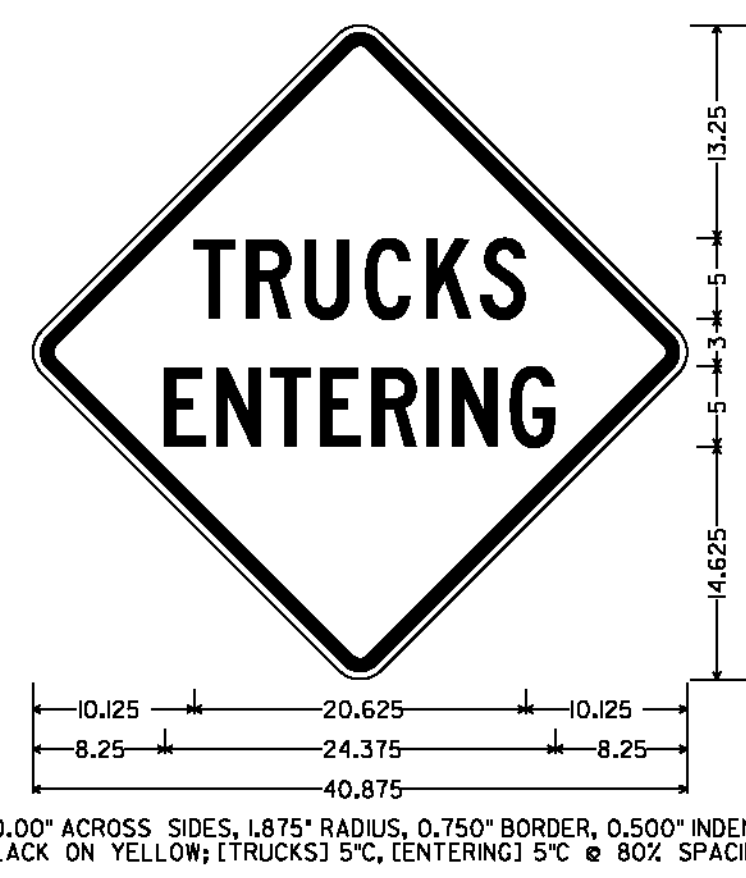

30.00" ACROSS SIDES, 1.875" RADIUS, 0.750" BORDER, 0.500" INDENT, BLACK ON YELLOW; [TRUCKS] 5", [ENTERING] 5" 80% SPACING
VW-202

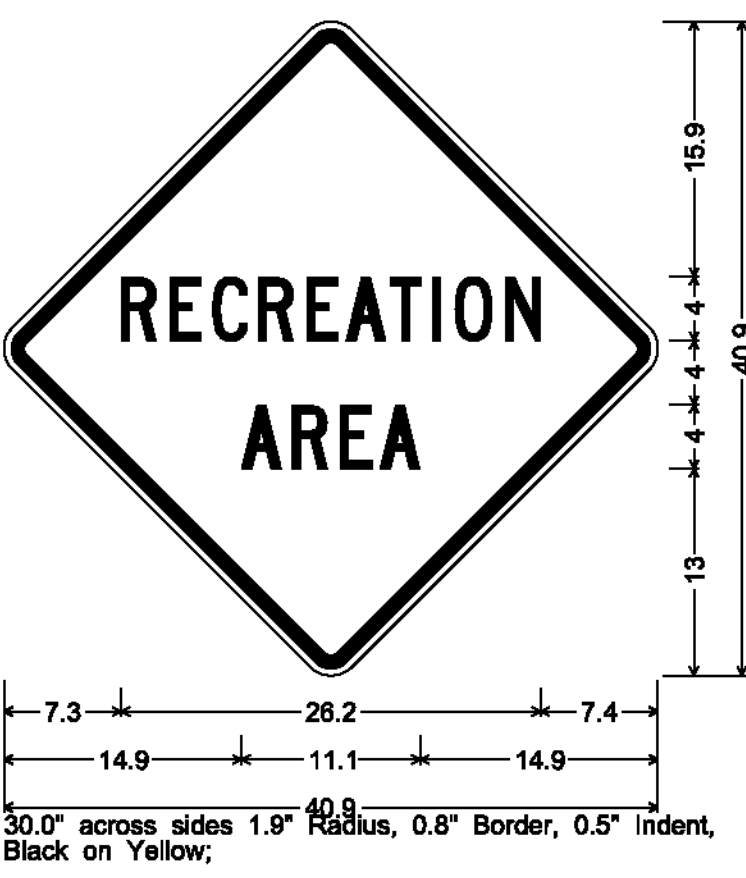



30.0" across sides 1.9" Radius, 0.8" Border, 0.5" Indent, Black on Yellow;
[RECREATION] C; [AREA] C;
VW-622

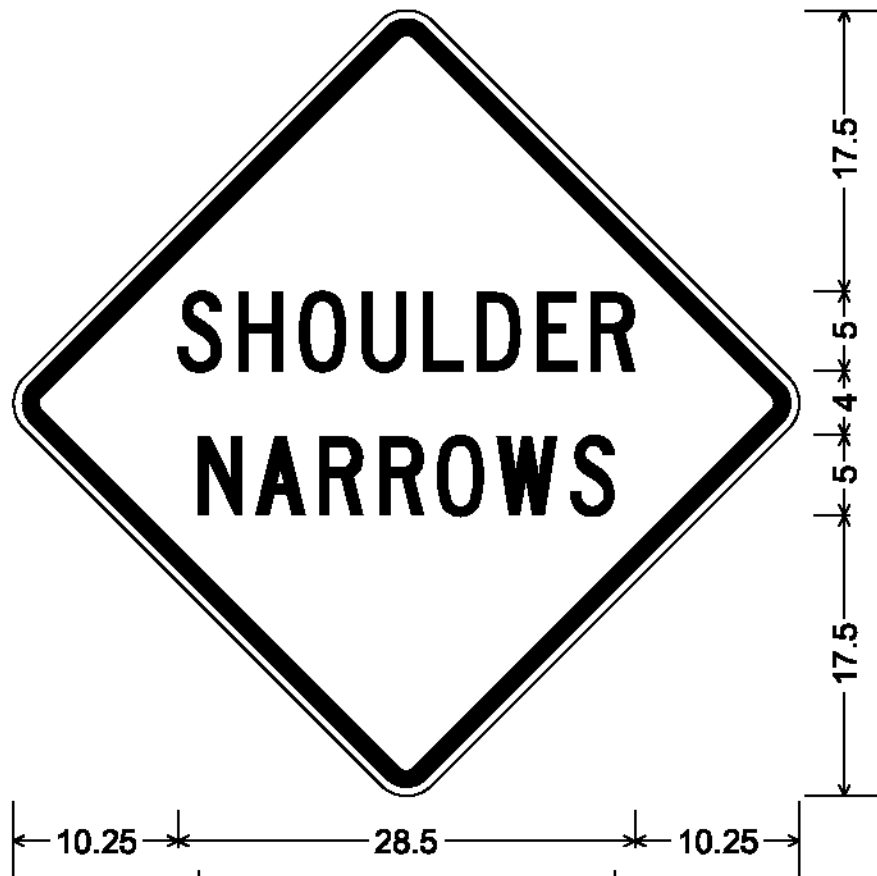


36.000" across sides 2.250" Radius, 0.875" Border, 0.625" Indent, Black on Yellow;
[SHOULDER] C; [NARROWS] C;
VW-619



36.000" across sides 2.250" Radius, 0.875" Border, 0.625" Indent, Black on Yellow;
[UNSAFE] C; [TO PASS] C;
VW-092

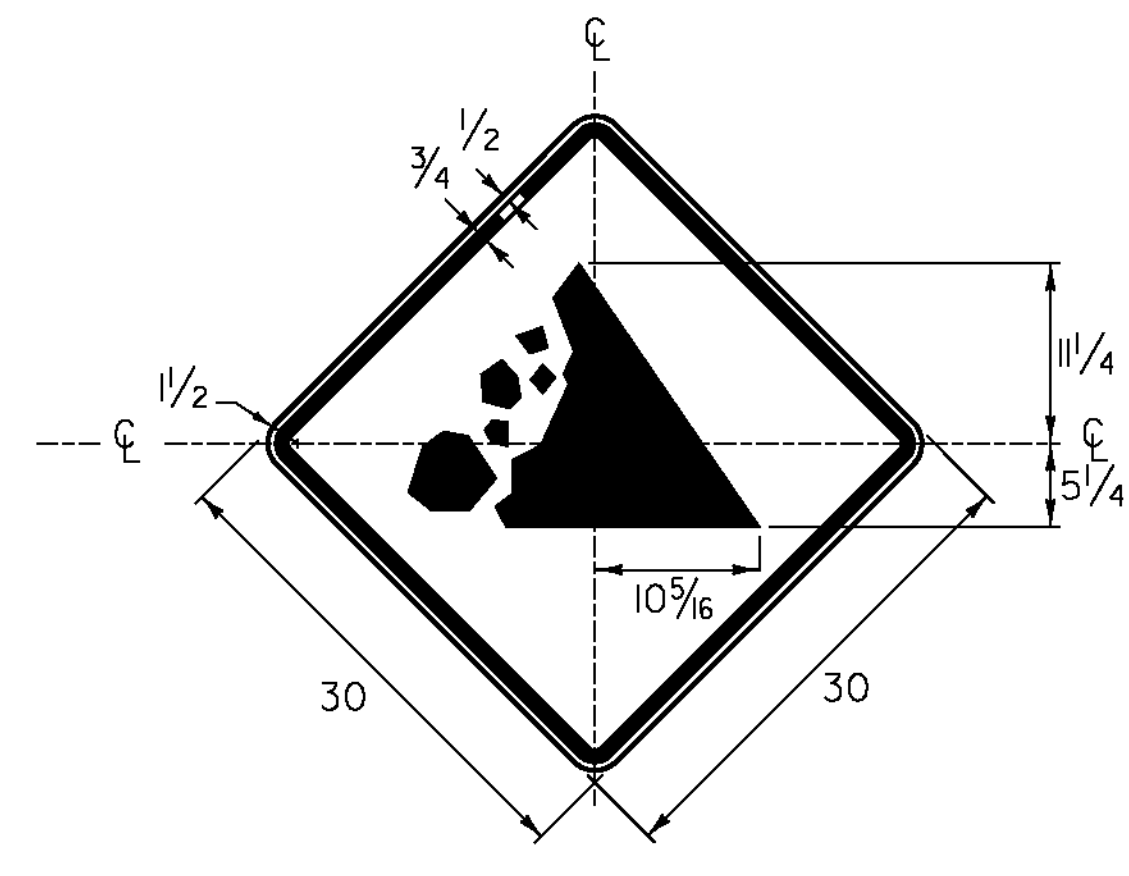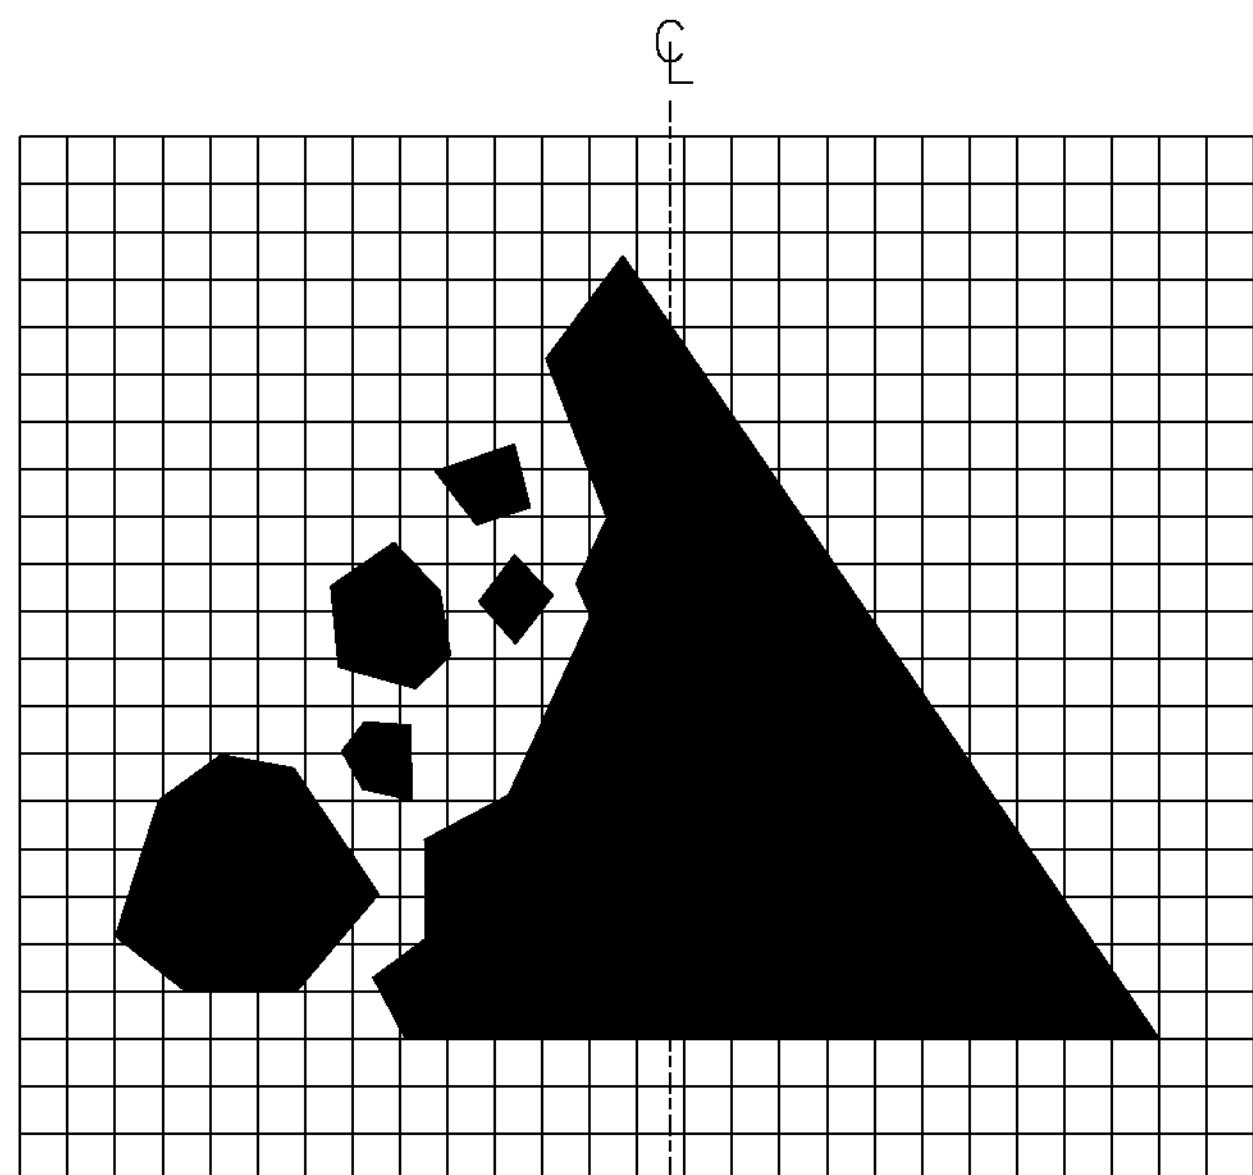

VW-285
SYMBOL AND BORDER - BLACK (NON-REFL.)
BACKGROUND - YELLOW (REFL.)









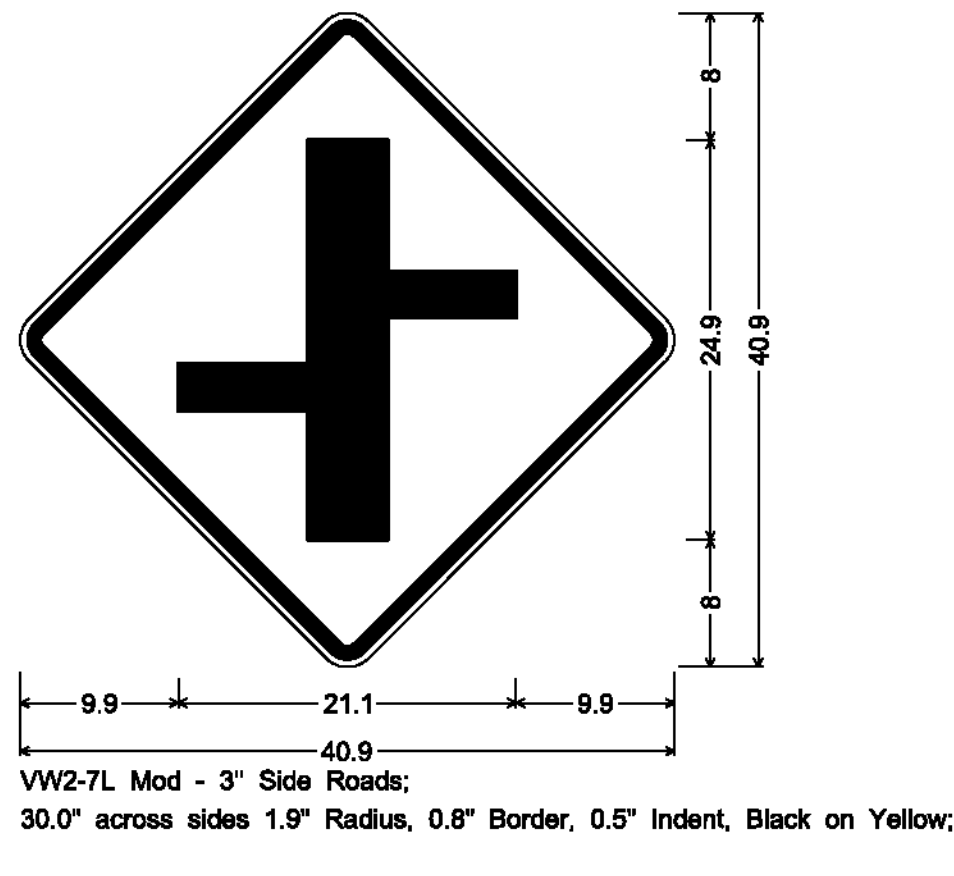


VW2-7L Mod - 3" Side Roads;
30.0" across sides 1.9" Radius, 0.8" Border, 0.5" Indent, Black on Yellow;



ALL DIMENSIONS SHOWN IN INCHES, EXCEPT WHERE NOTED.

NOT TO SCALE



PROJECT NAME:	STATEWIDE SW REGION
PROJECT NUMBER:	STPG SIGN (41)
FILE NAME:	I2CI18.SD_4
PROJECT LEADER:	A. GAMBLE
DESIGNED BY:	J. KELLY
SIGN DETAILS 4	
PLOT DATE:	I3-FEB-2013
DRAWN BY:	J. KELLY
CHECKED BY:	A. GAMBLE
SHEET 7	OF 97

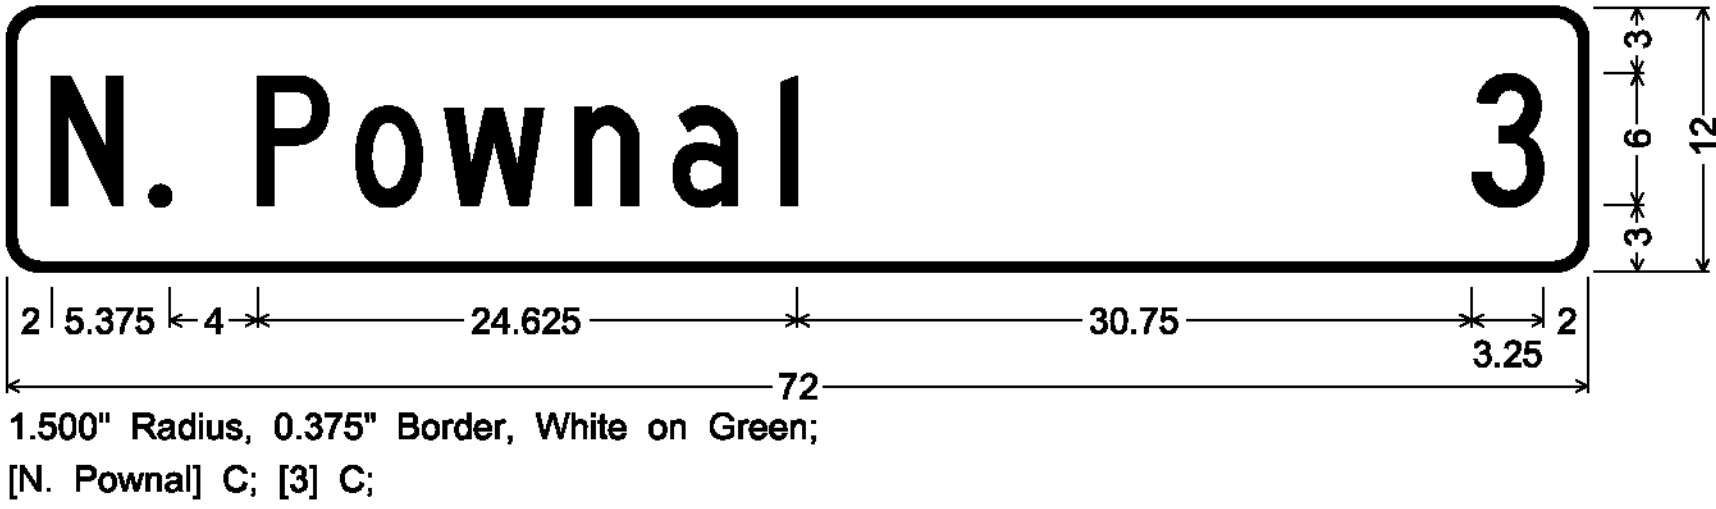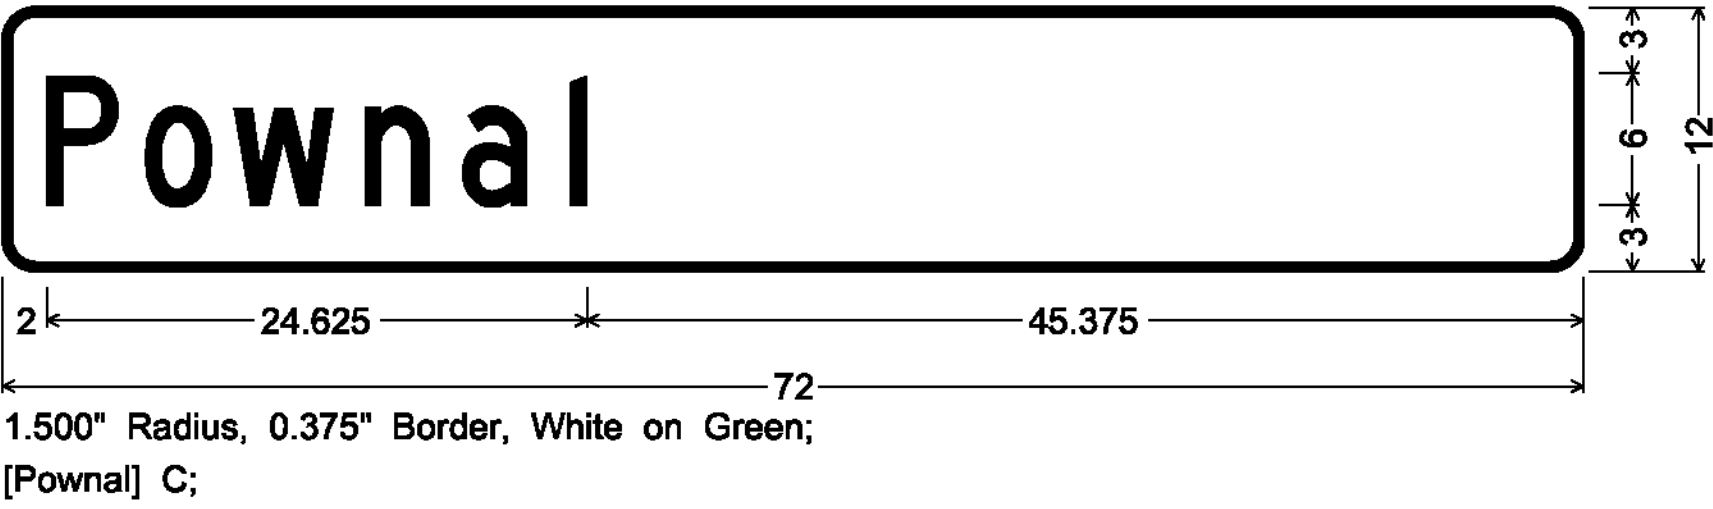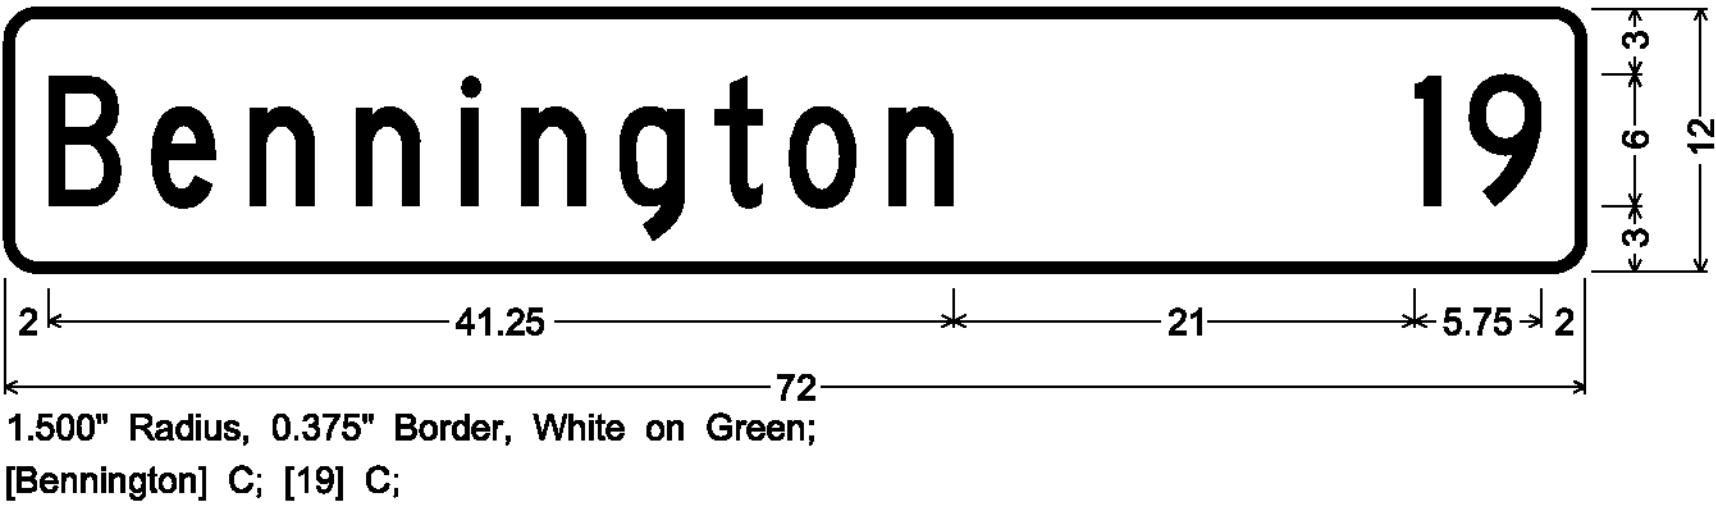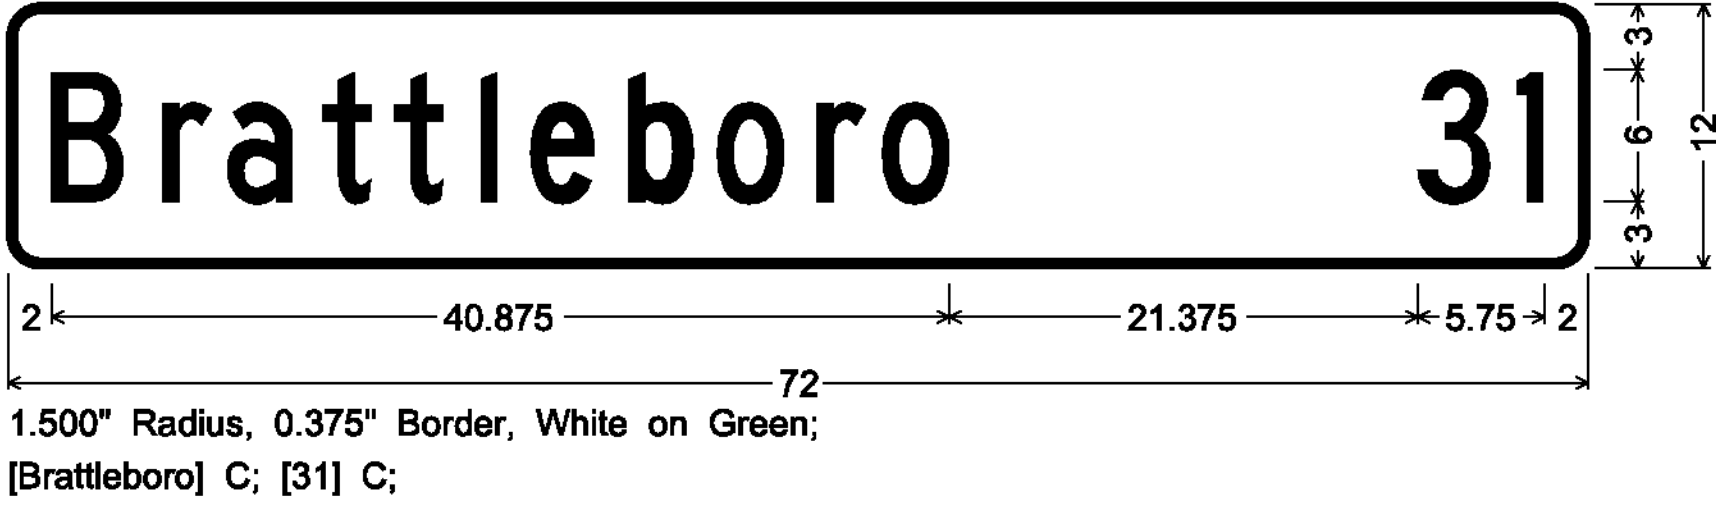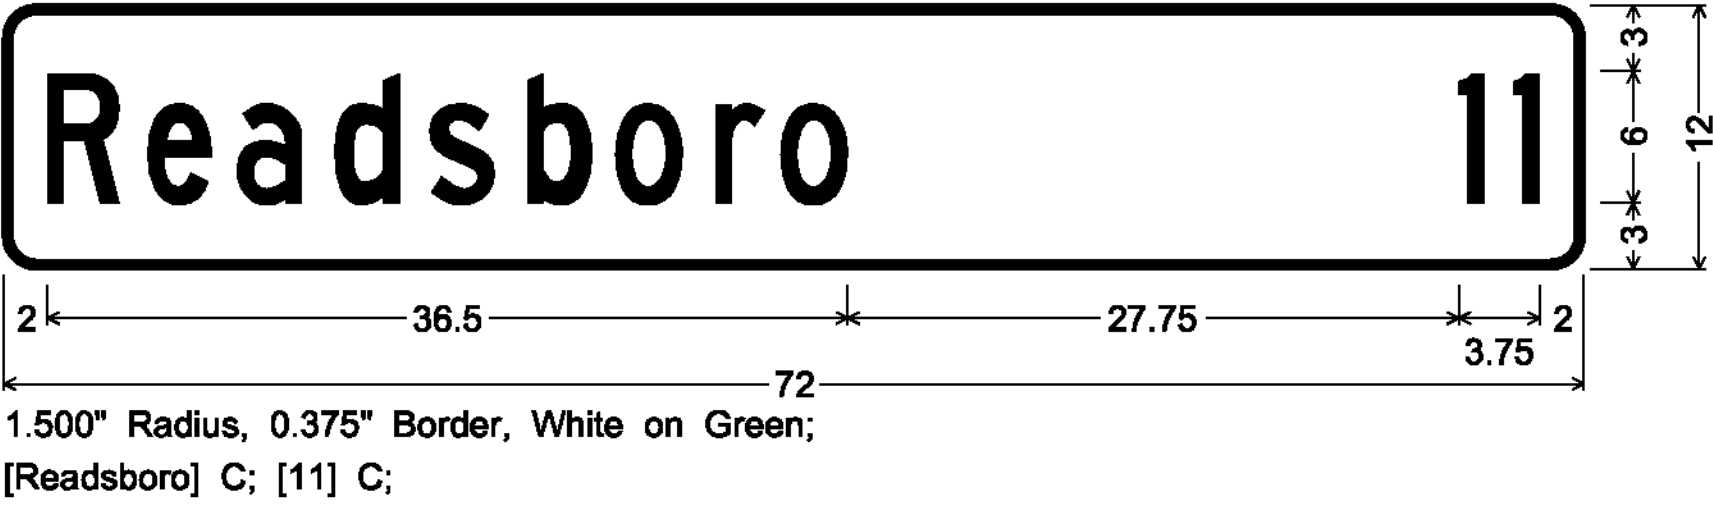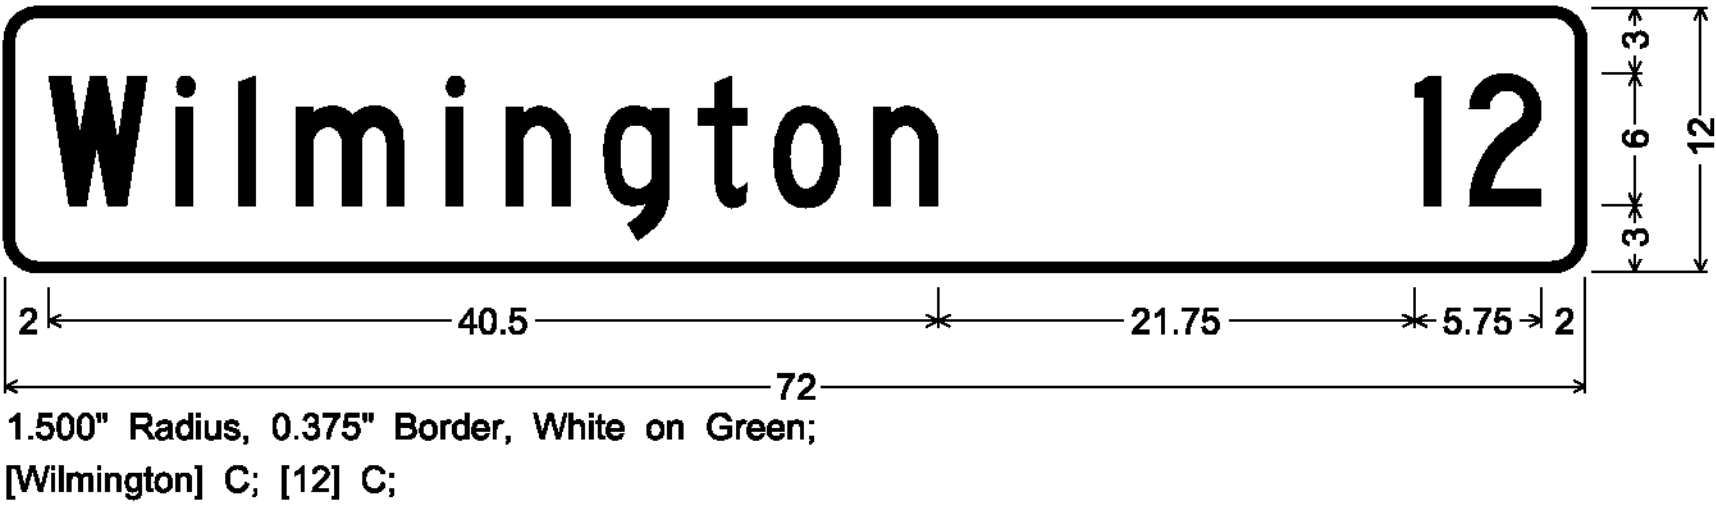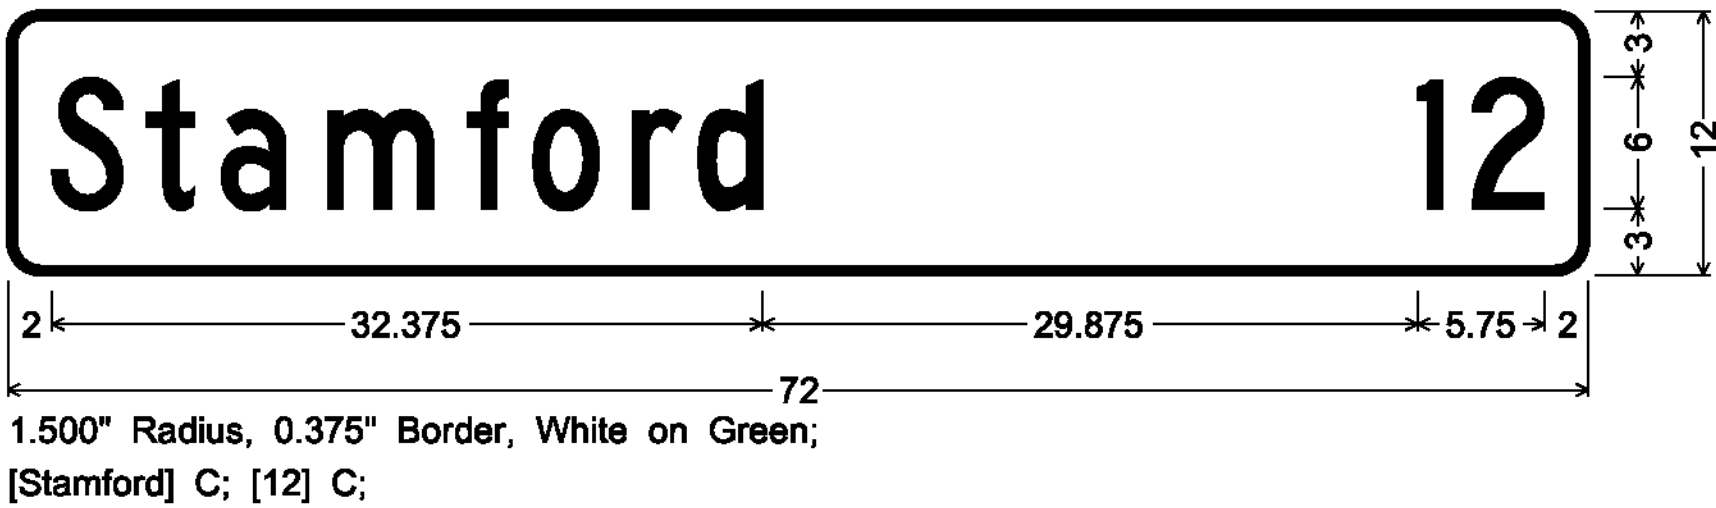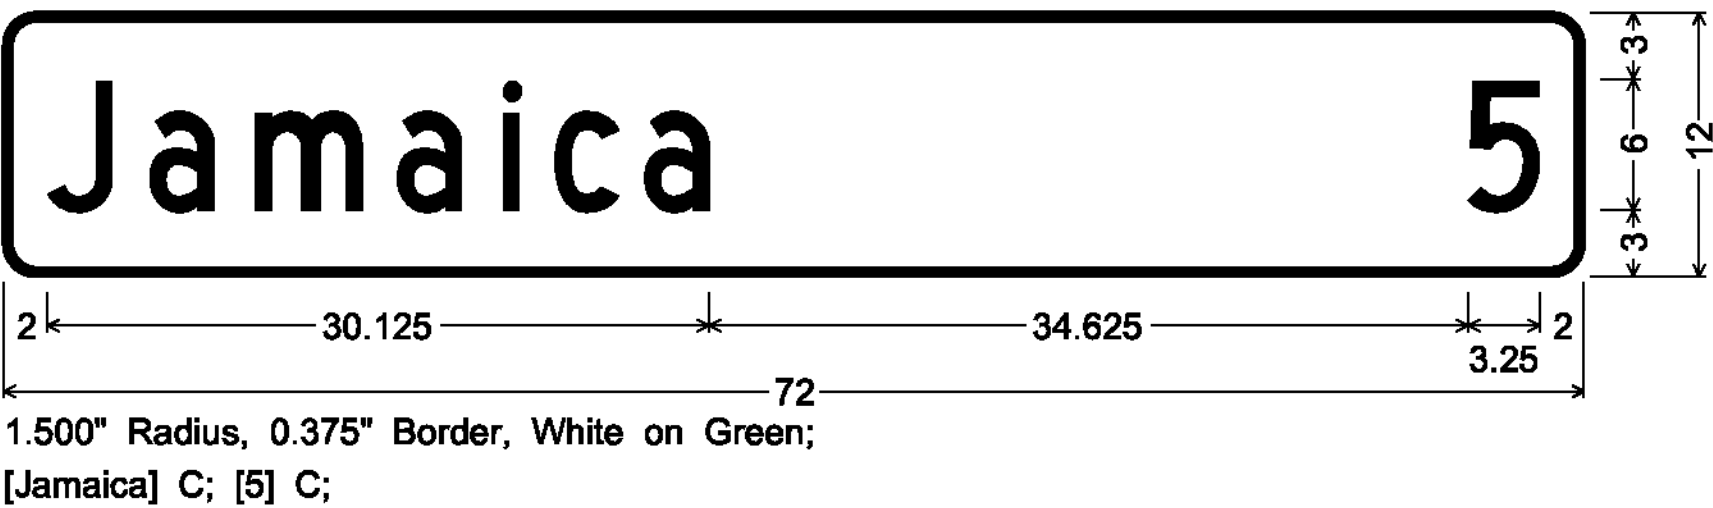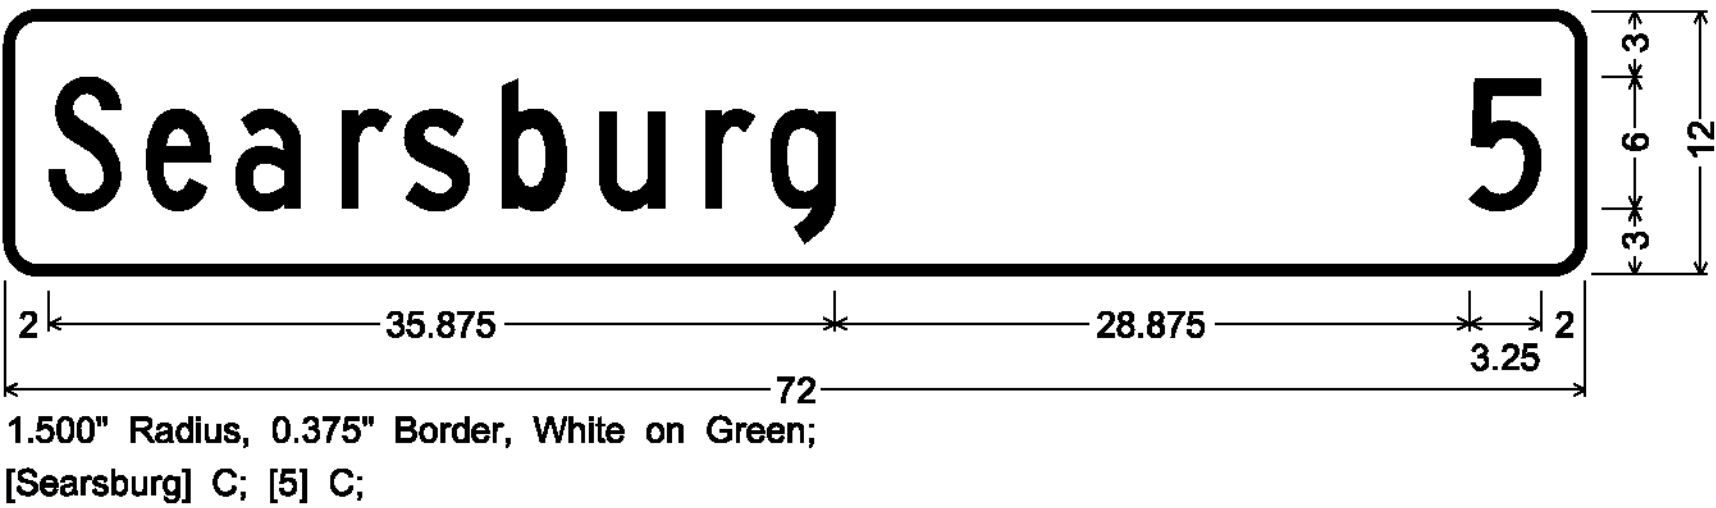

ALL SIGNS IN THIS SECTION ARE SIGN CODE VD2-I

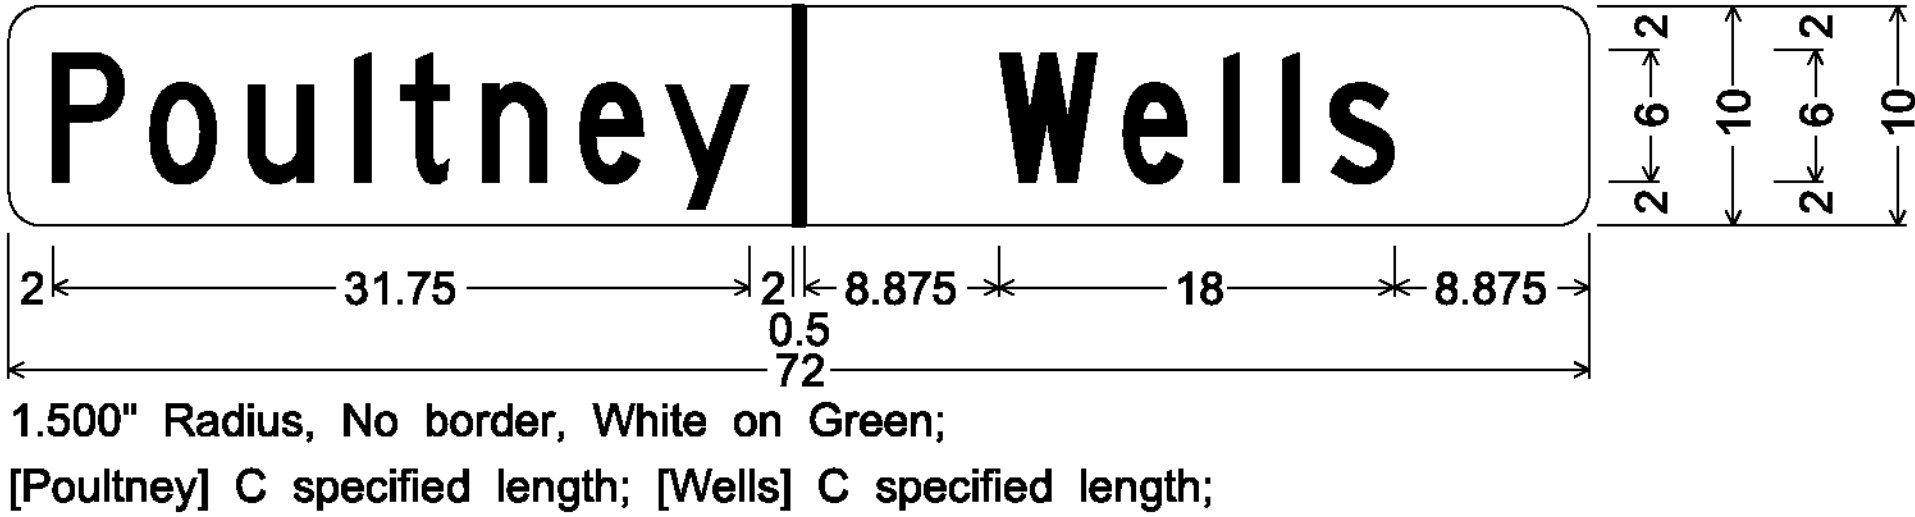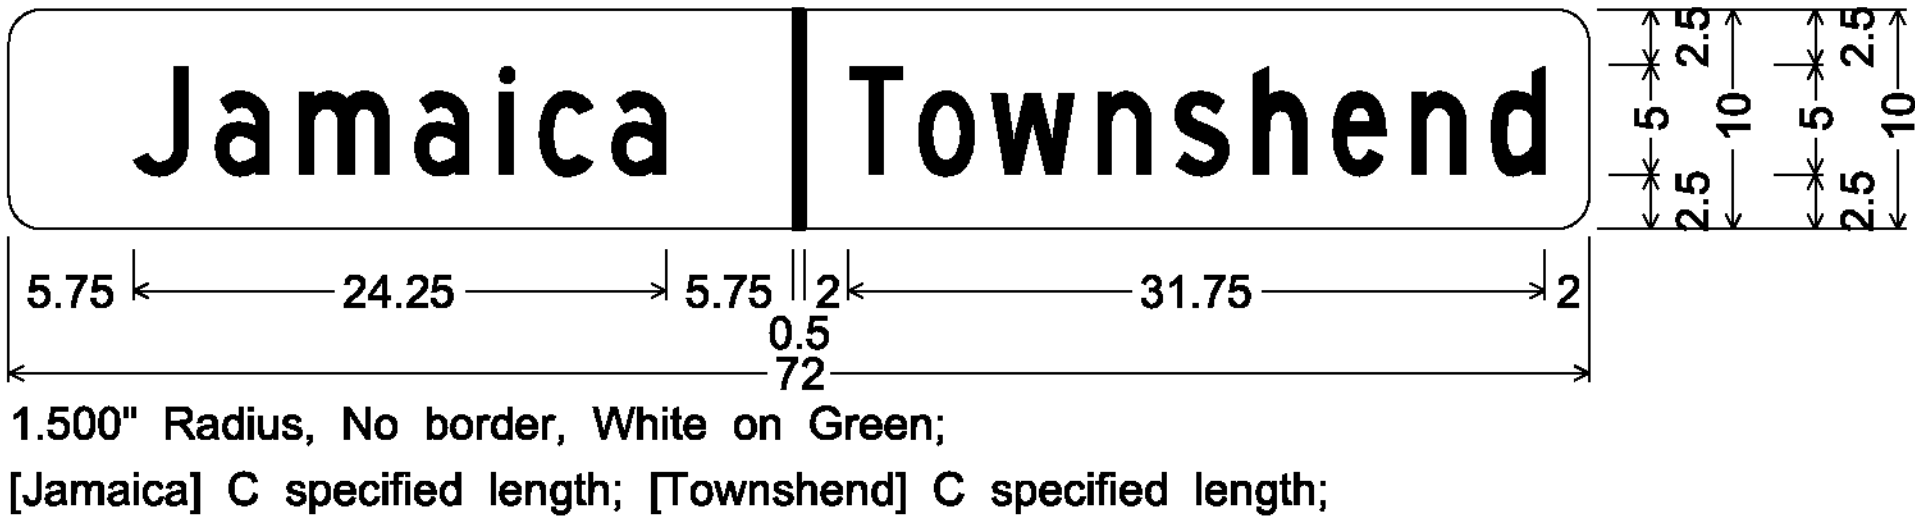

















ALL SIGNS IN THIS SECTION ARE SIGN CODE VD-024

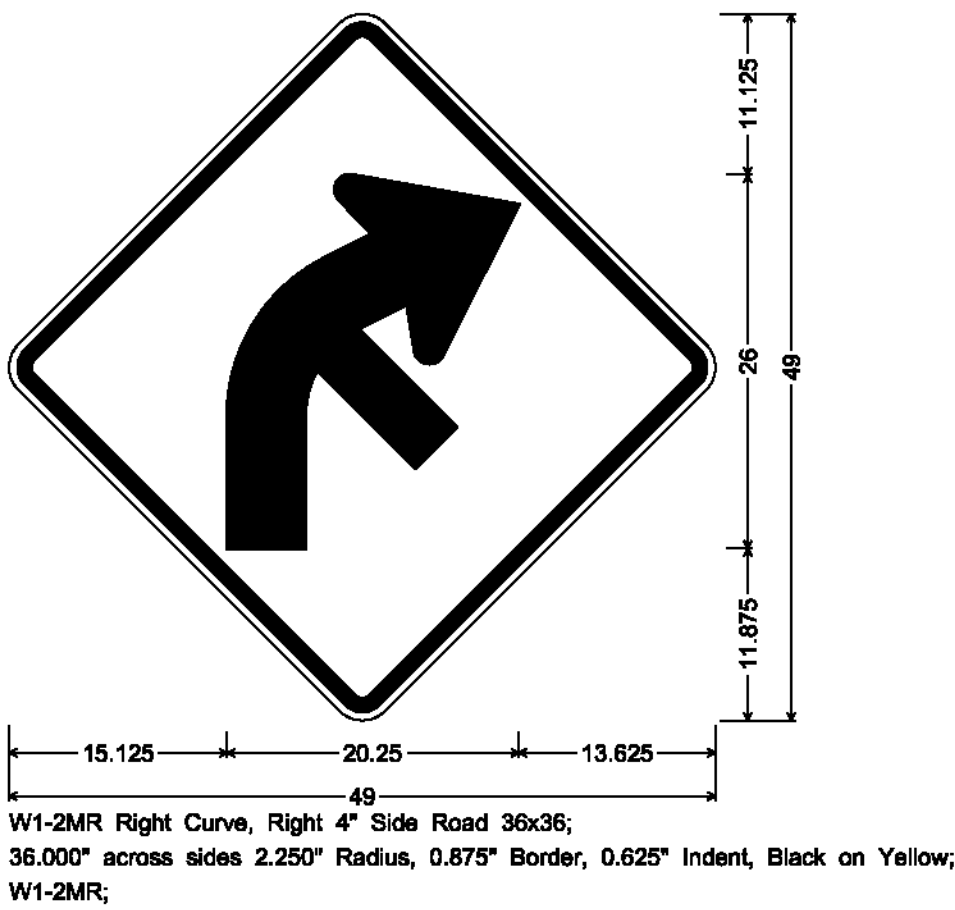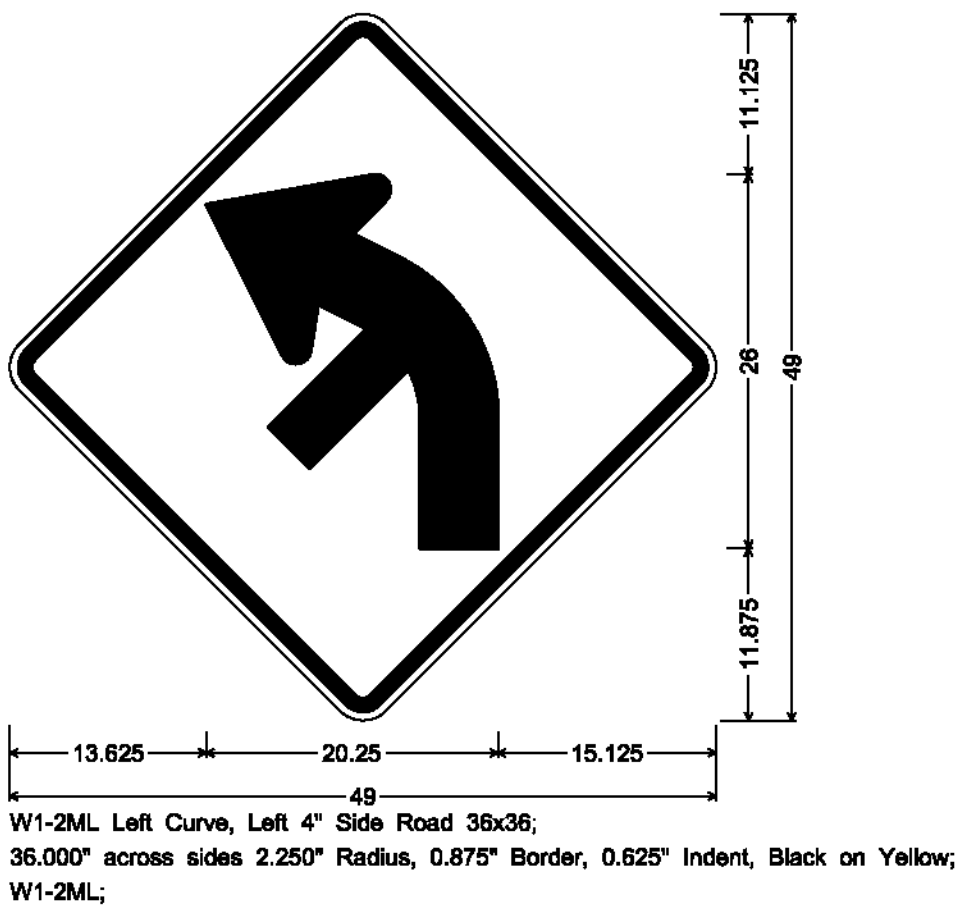

ALL DIMENSIONS SHOWN IN INCHES, EXCEPT WHERE NOTED.

NOT TO SCALE

PROJECT NAME: STATEWIDE SW REGION	
PROJECT NUMBER: STPG SIGN (4I)	
FILE NAME: I2CI18.SD_5	PLOT DATE: I3-FEB-20I3
PROJECT LEADER: A. GAMBLE	DRAWN BY: J. KELLY
DESIGNED BY: J. KELLY	CHECKED BY: A. GAMBLE
SIGN DETAILS 5	SHEET 8 OF 97

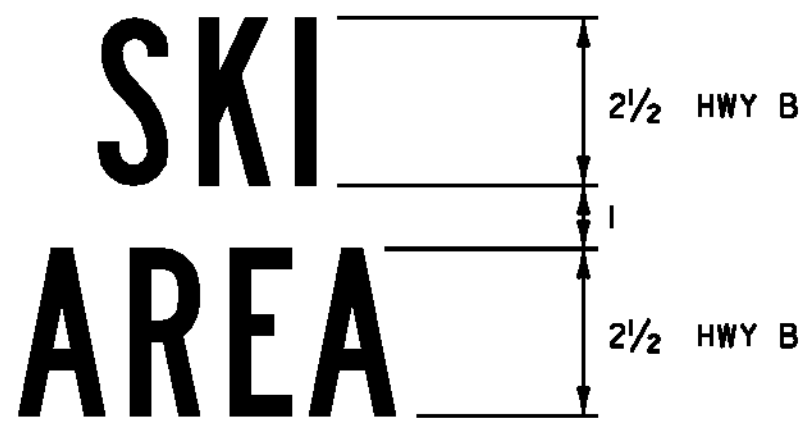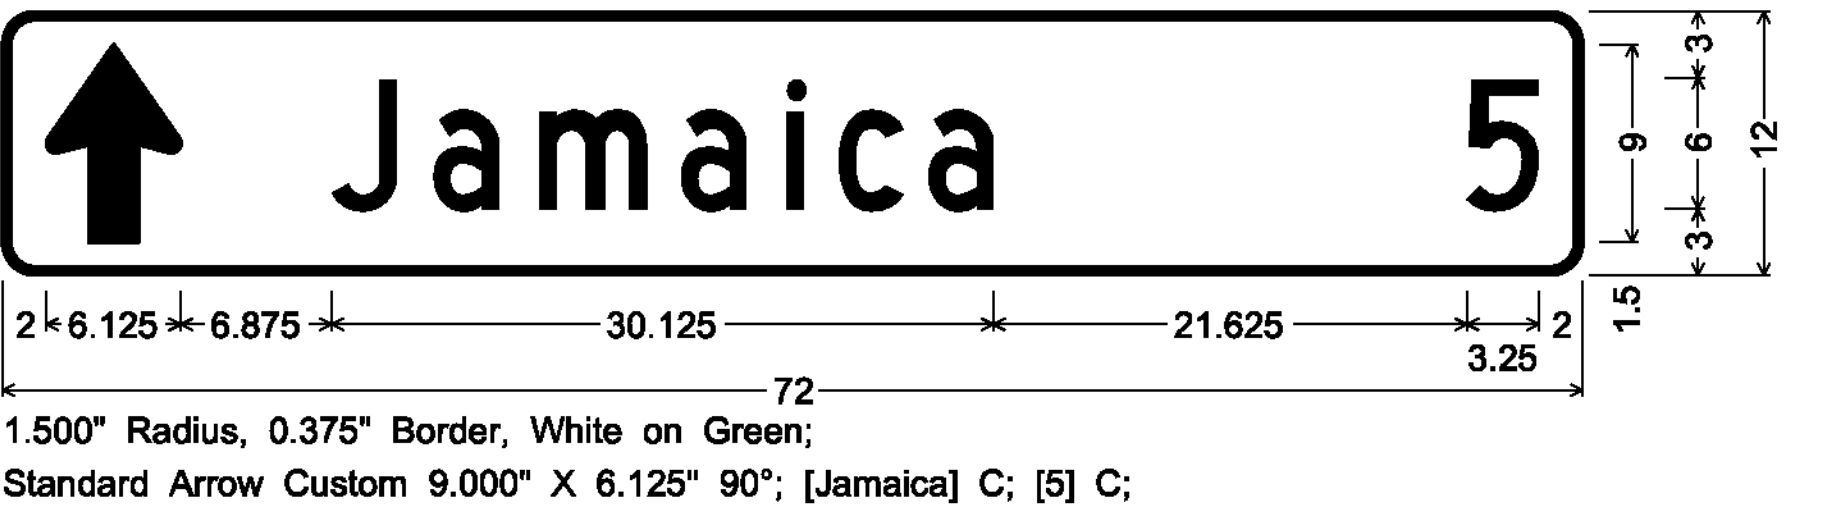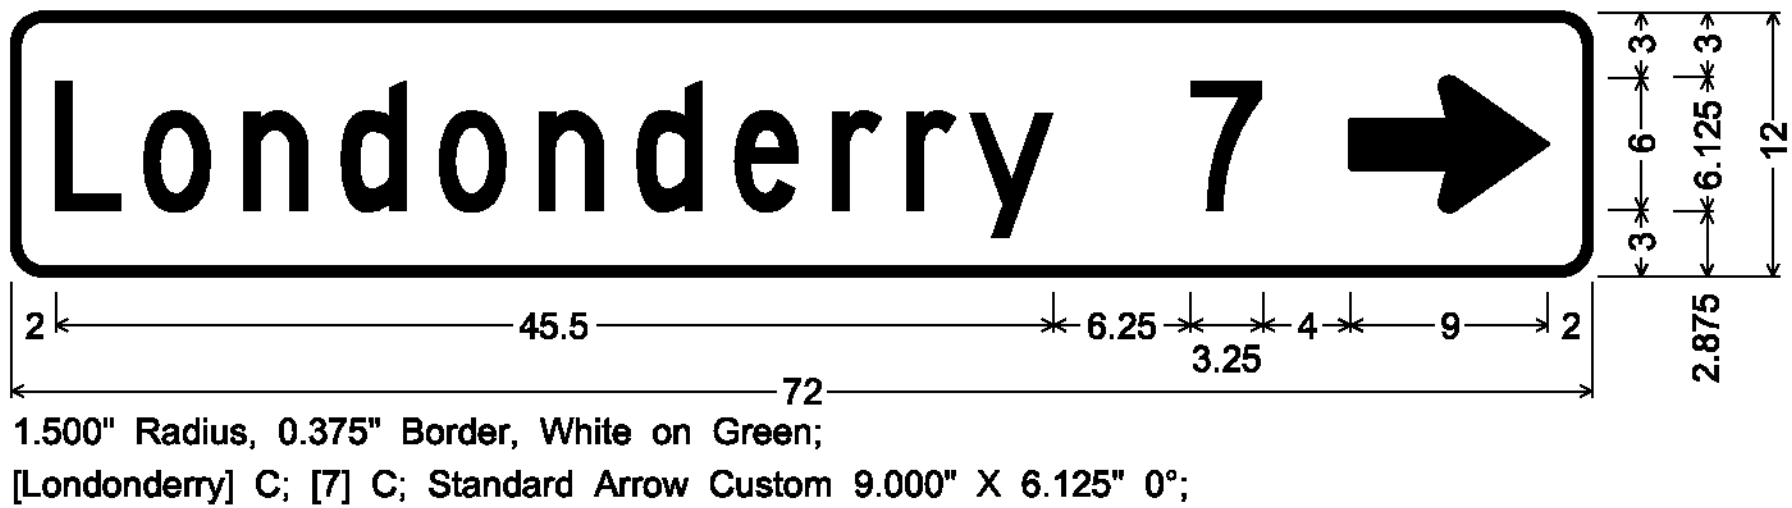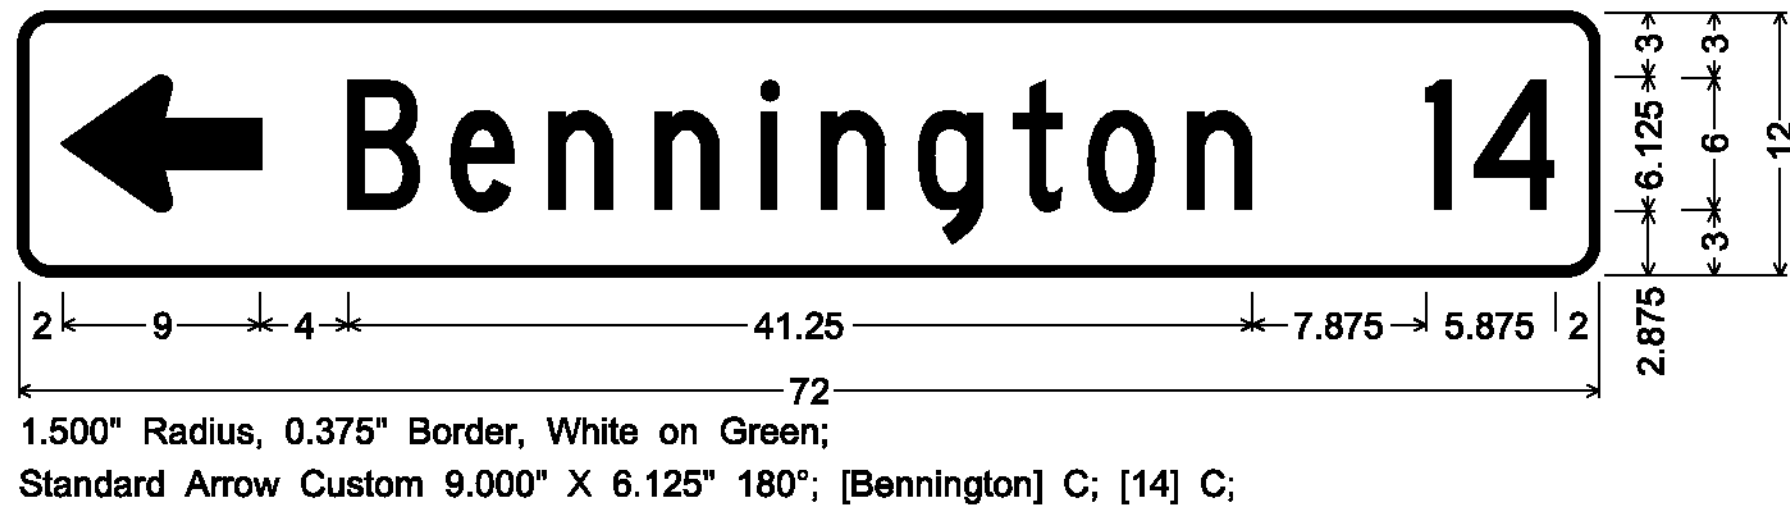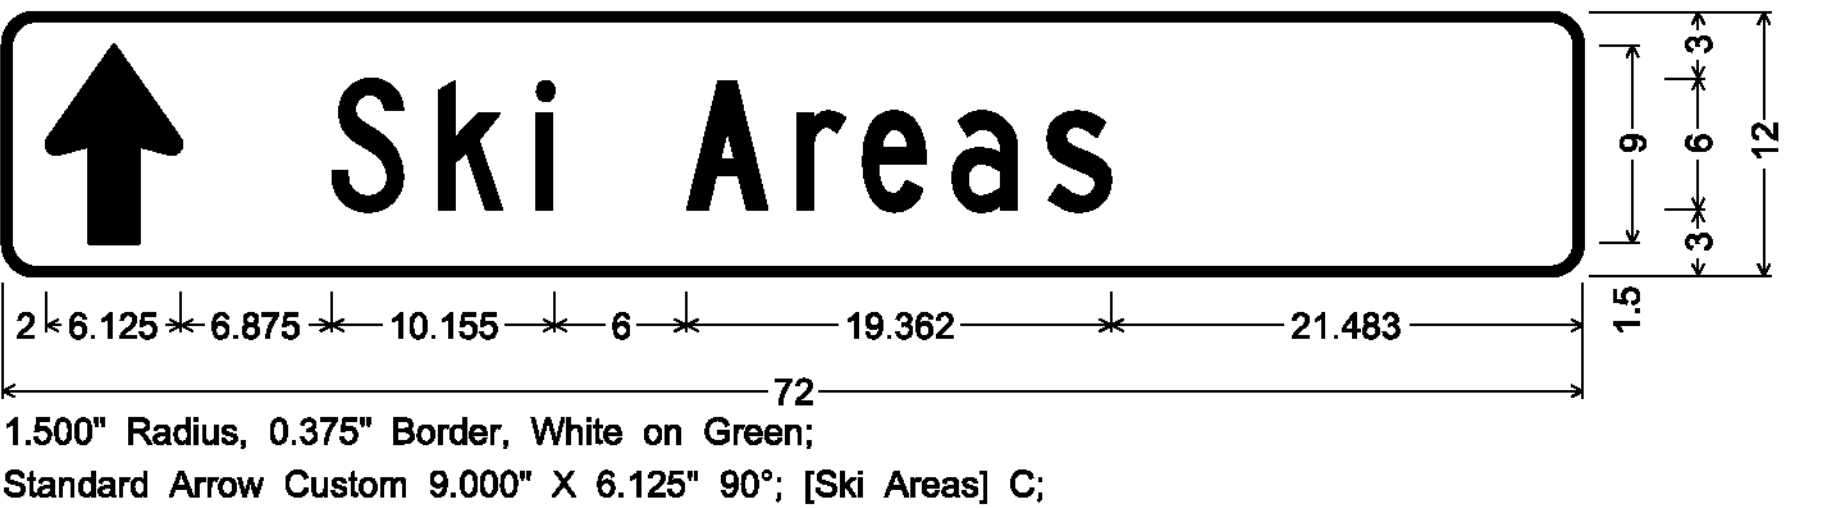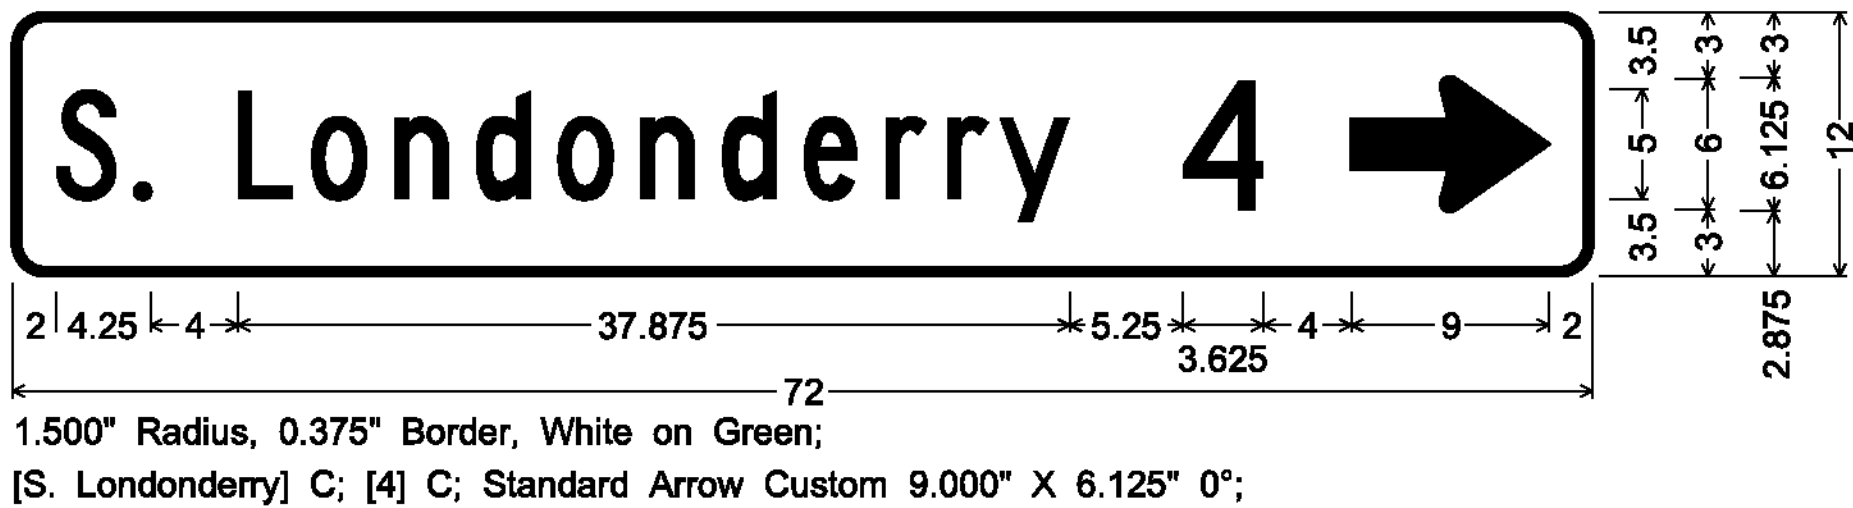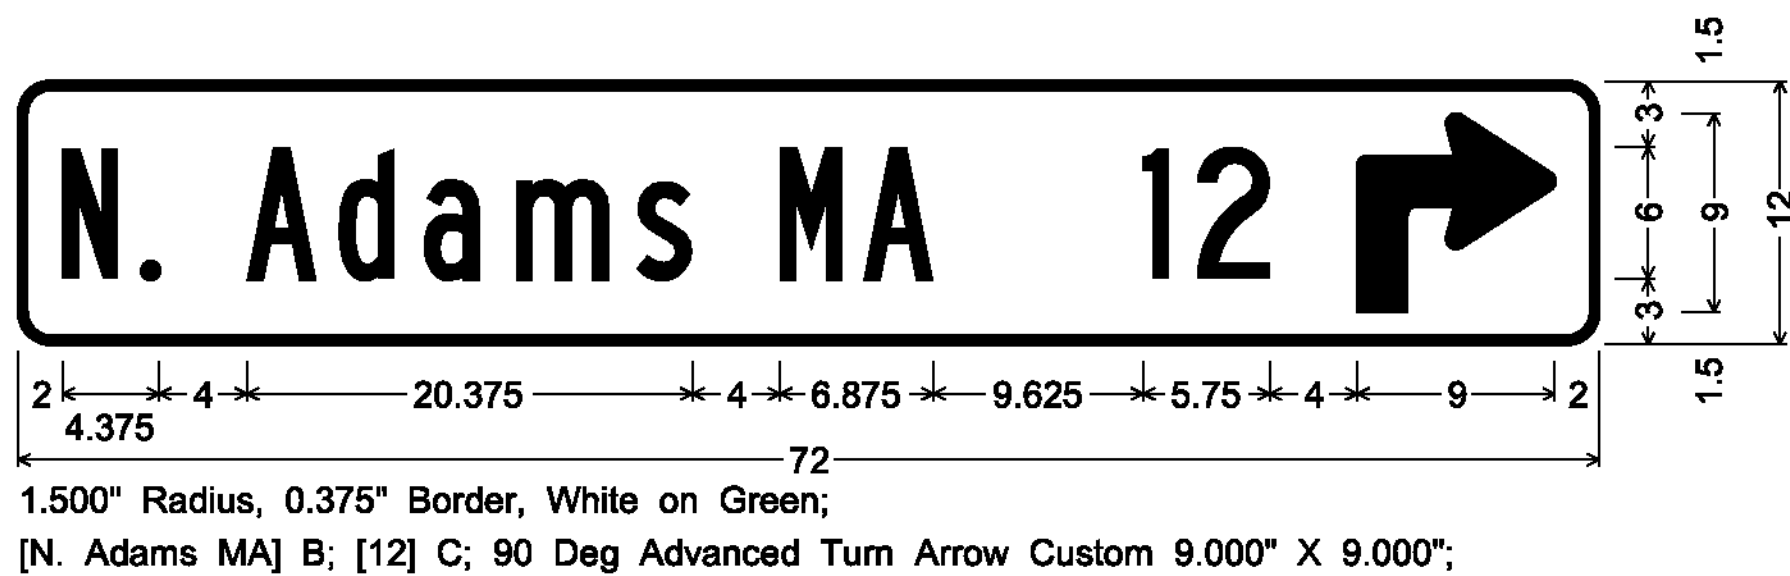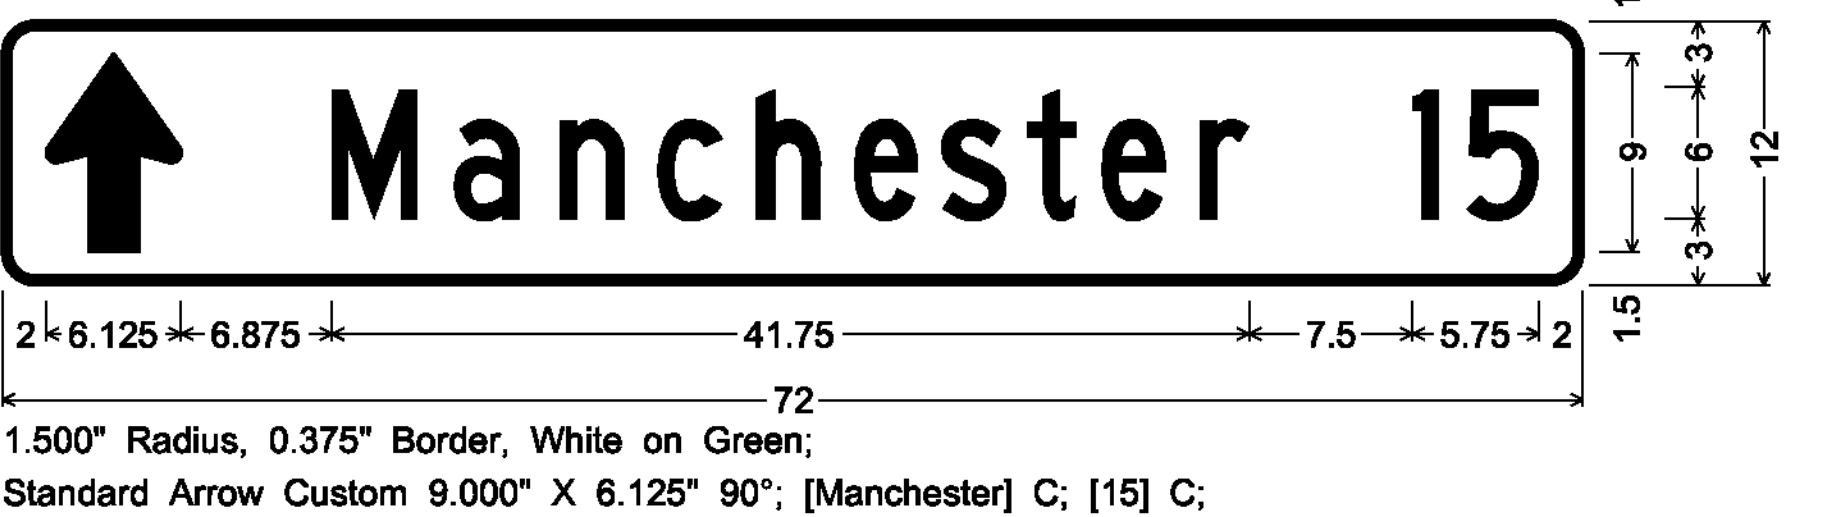
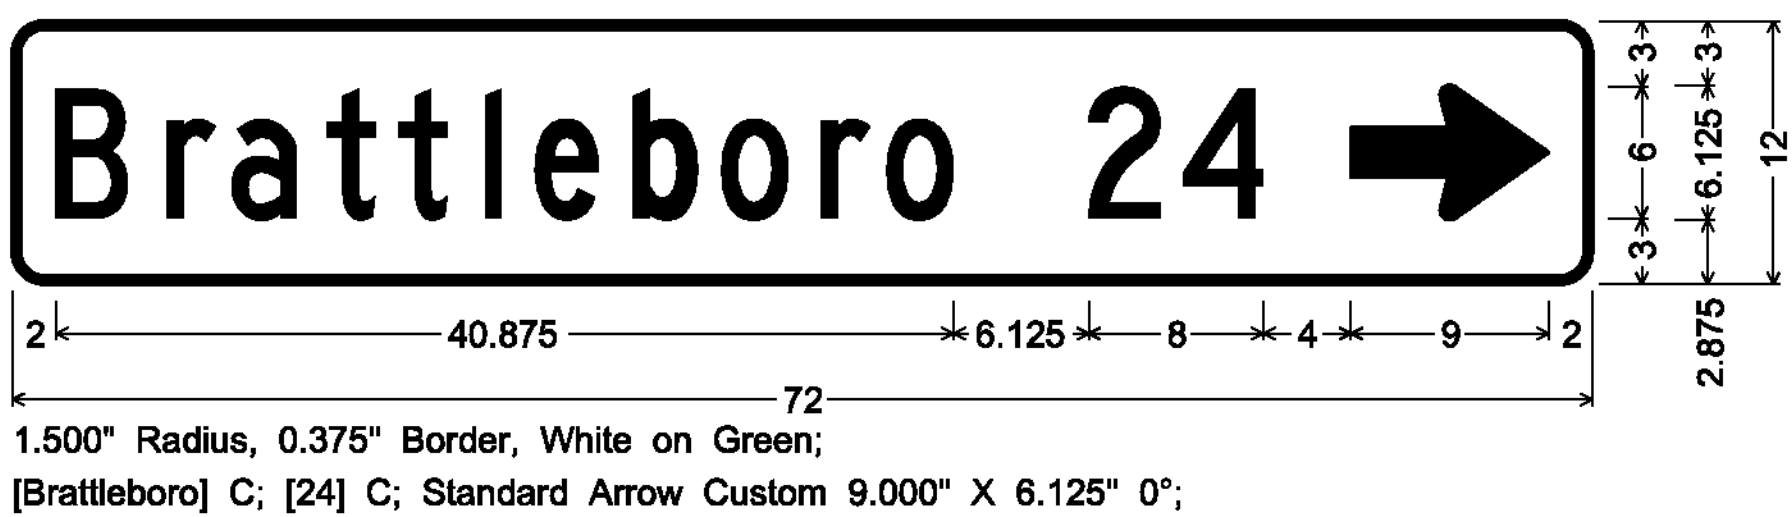
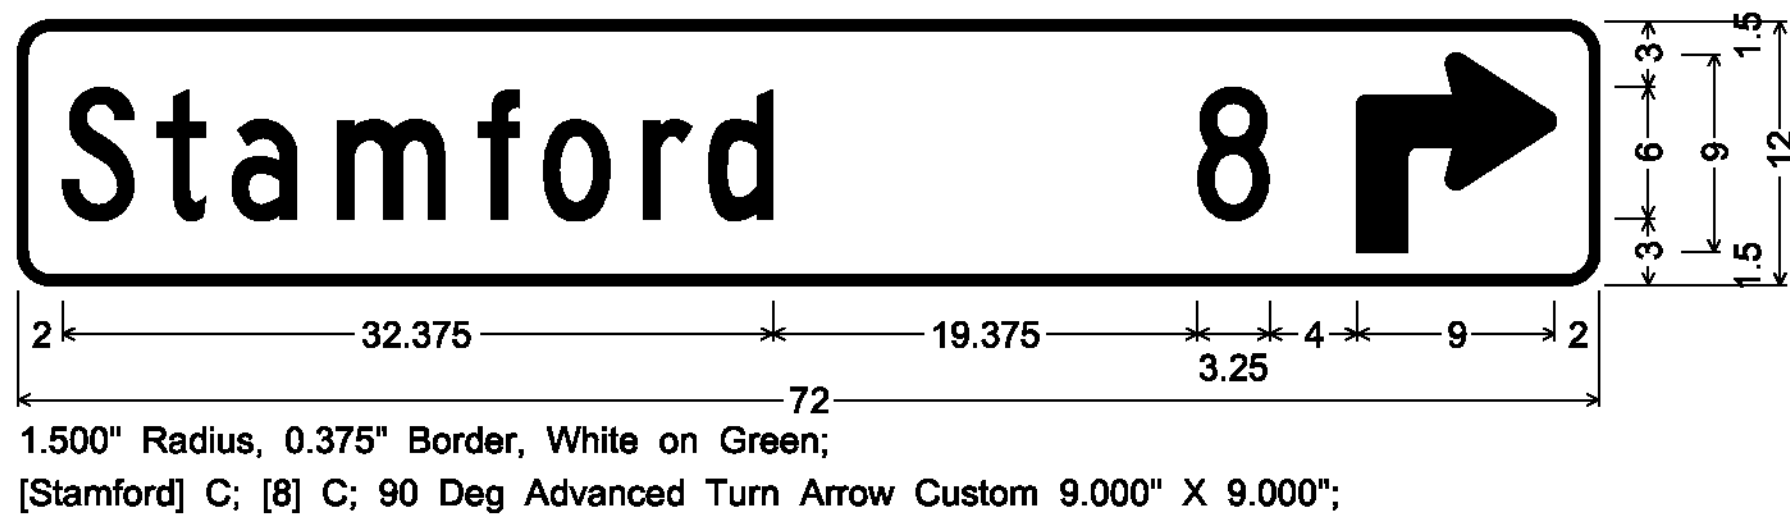
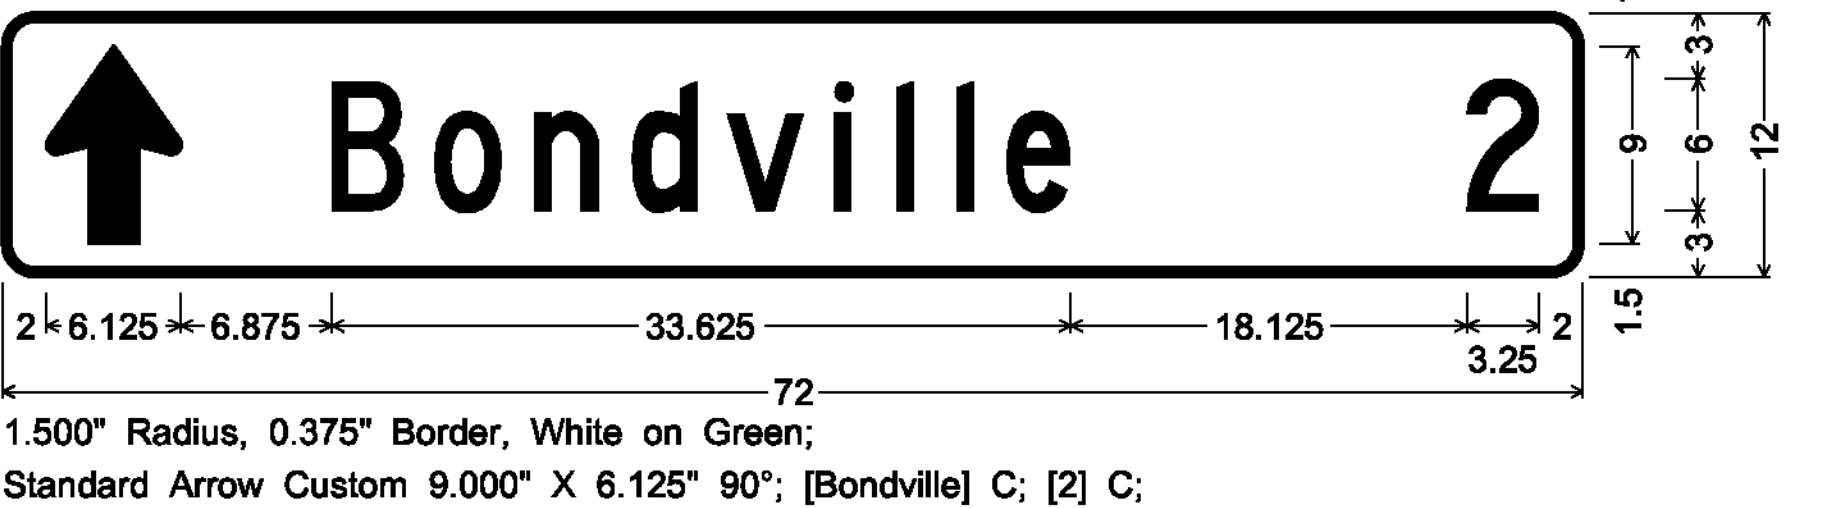
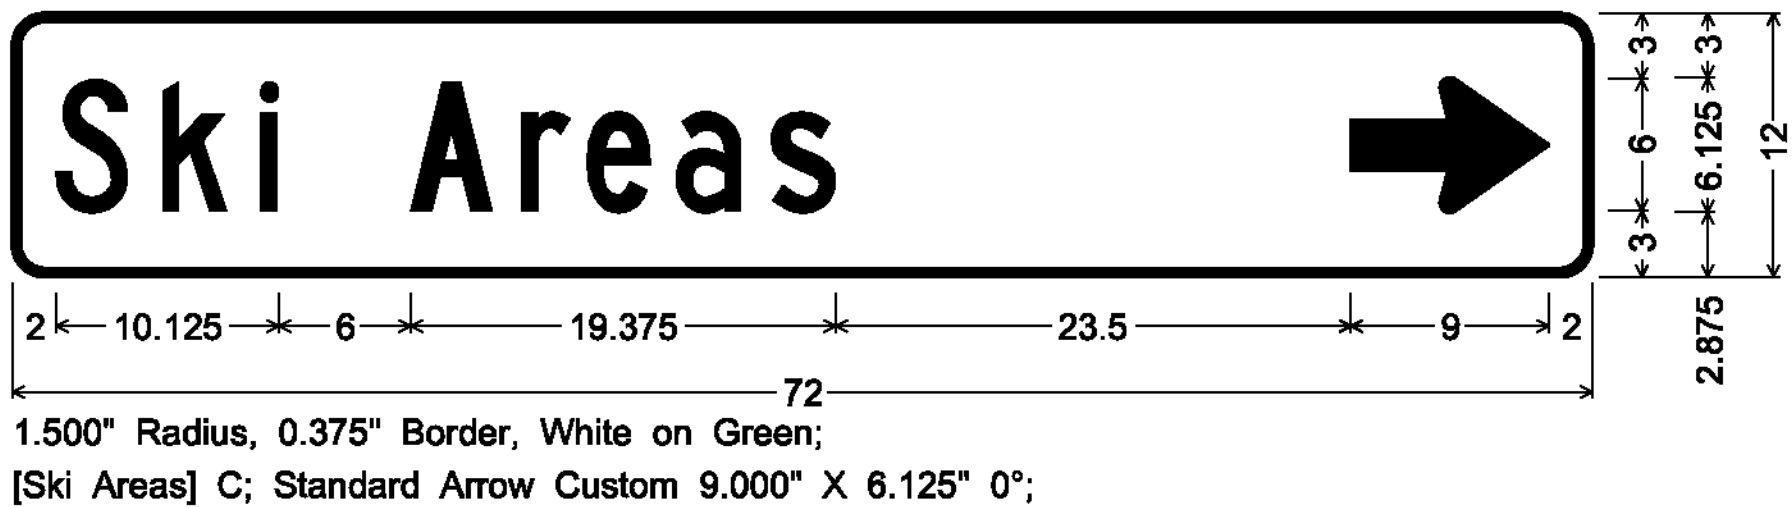
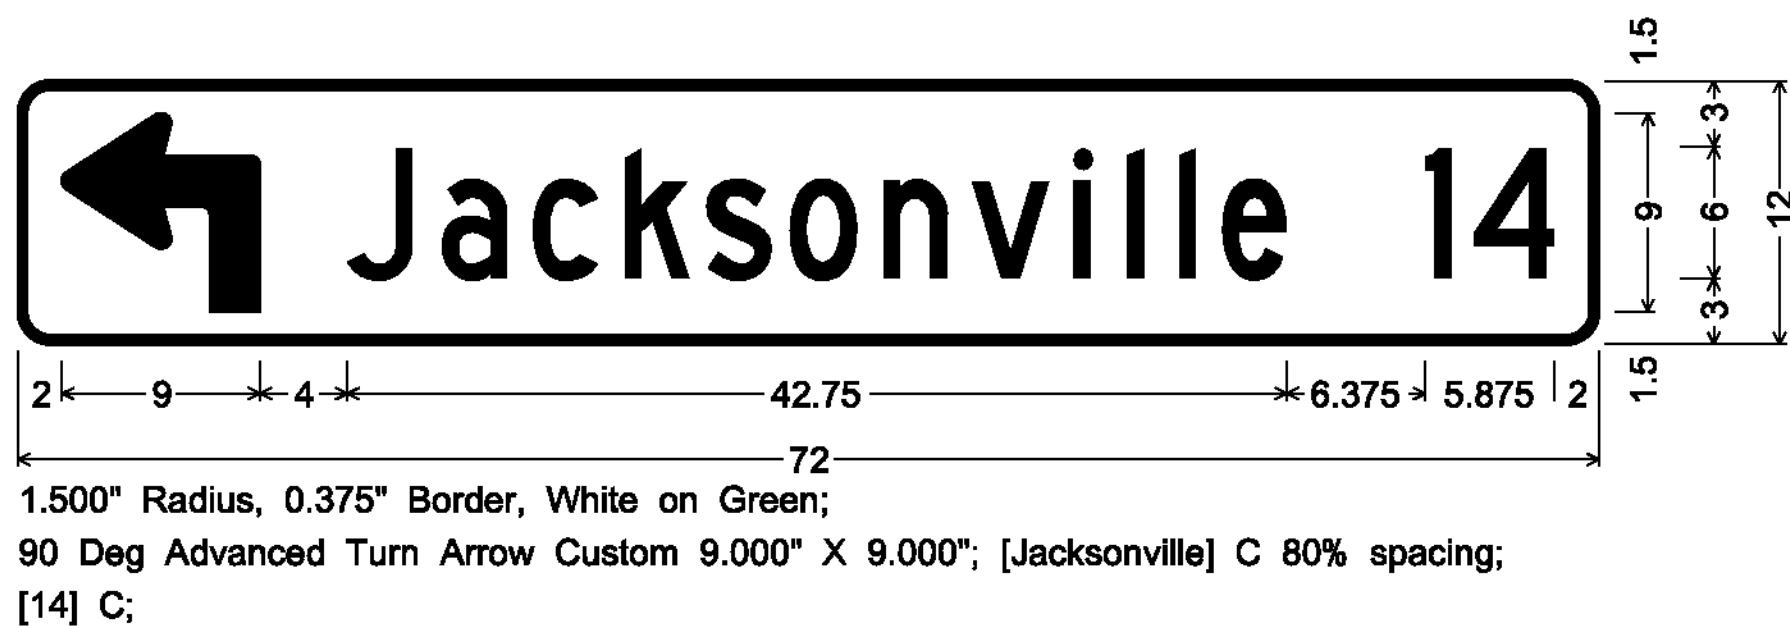
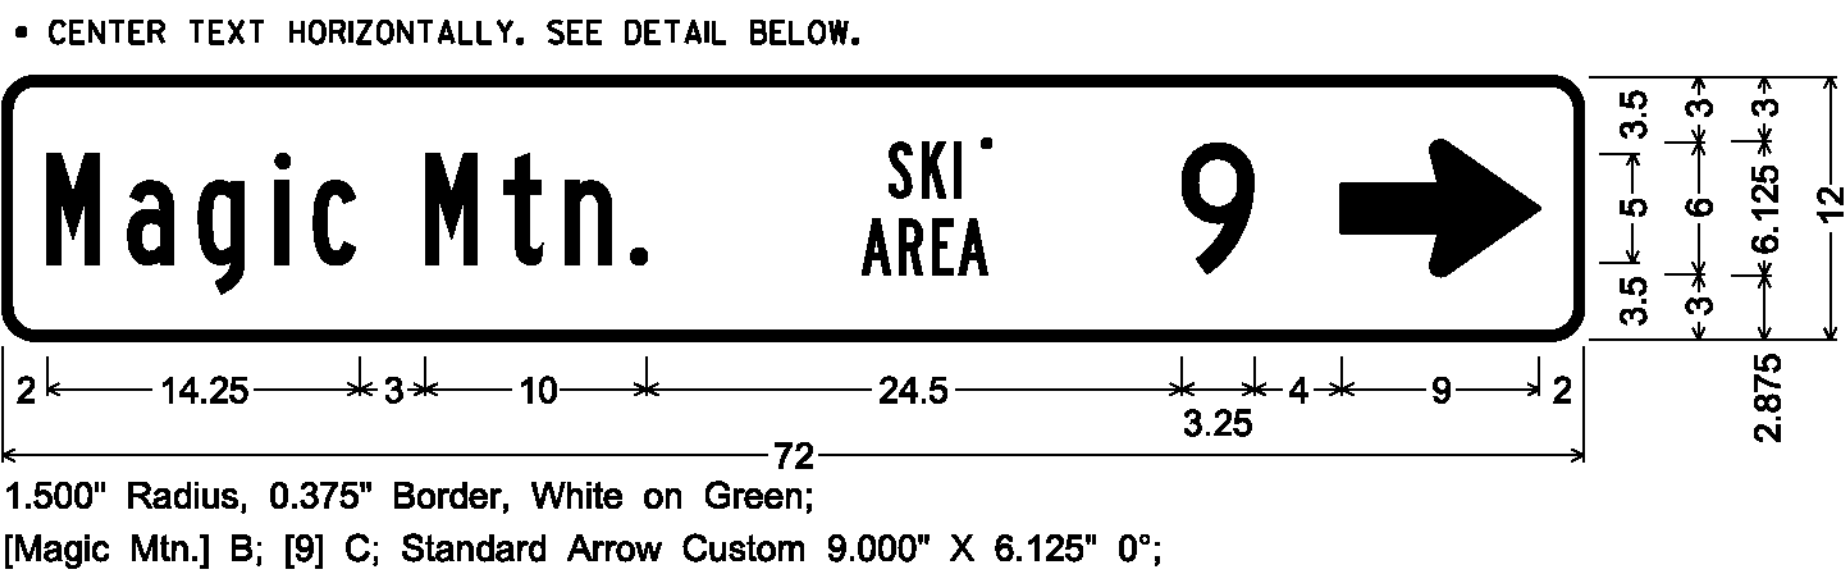
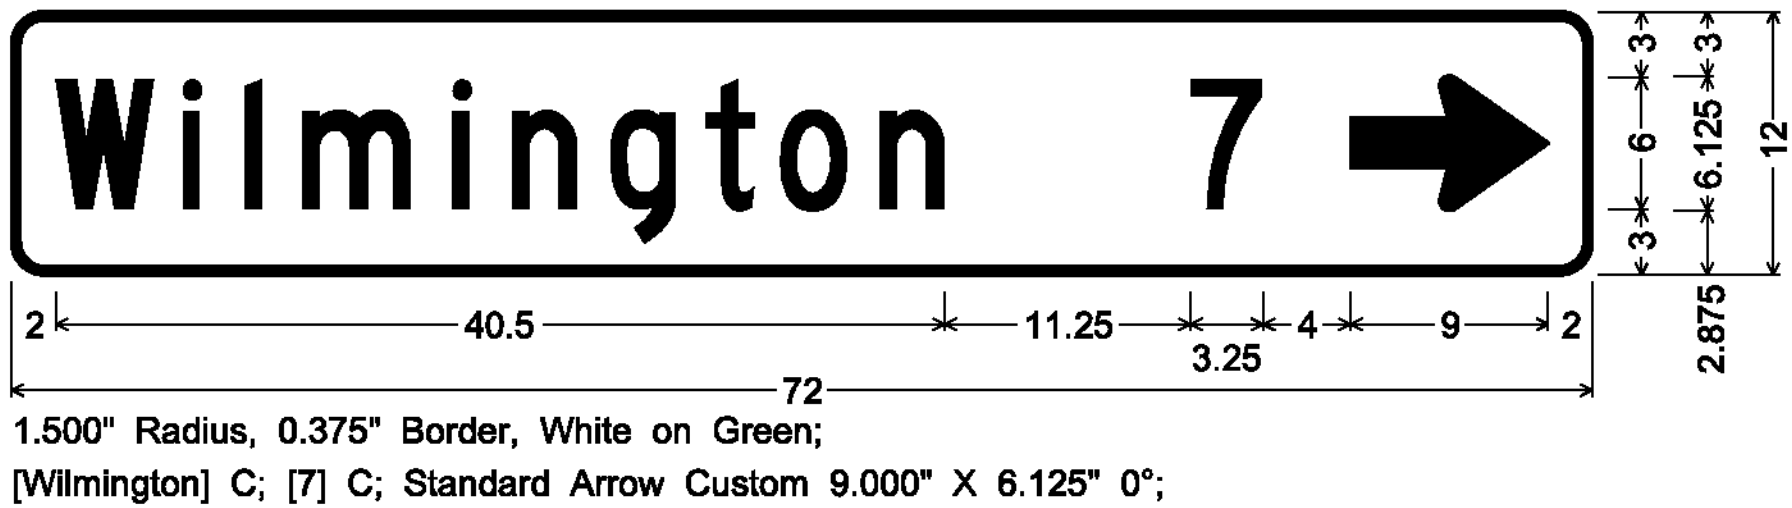
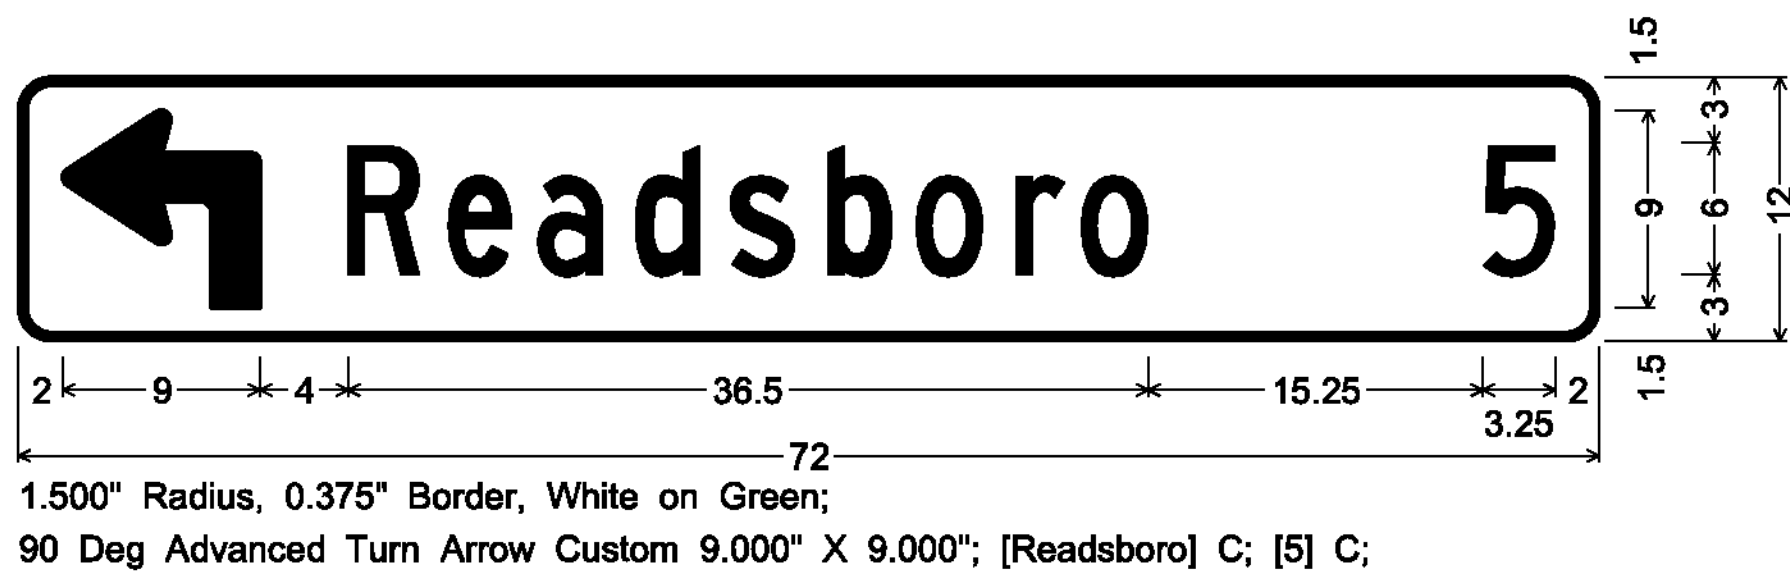


- NOTES
- 1. ALL DIMENSIONS SHOWN IN INCHES, EXCEPT WHERE NOTED.
 - 2. SEE SHEET 4 FOR ADDITIONAL DESTINATION SIGN DETAILS.

PROJECT NAME: STATEWIDE SW REGION	
PROJECT NUMBER: STPG SIGN (4I)	
FILE NAME: I2CIIB.SD_6	PLOT DATE: I3-FEB-20I3
PROJECT LEADER: A. GAMBLE	DRAWN BY: J. KELLY
DESIGNED BY: J. KELLY	CHECKED BY: A. GAMBLE
SIGN DETAILS 6	SHEET 9 OF 97

ALL SIGNS ON THIS PAGE ARE SIGN CODE VDI-IA

NOT TO SCALE

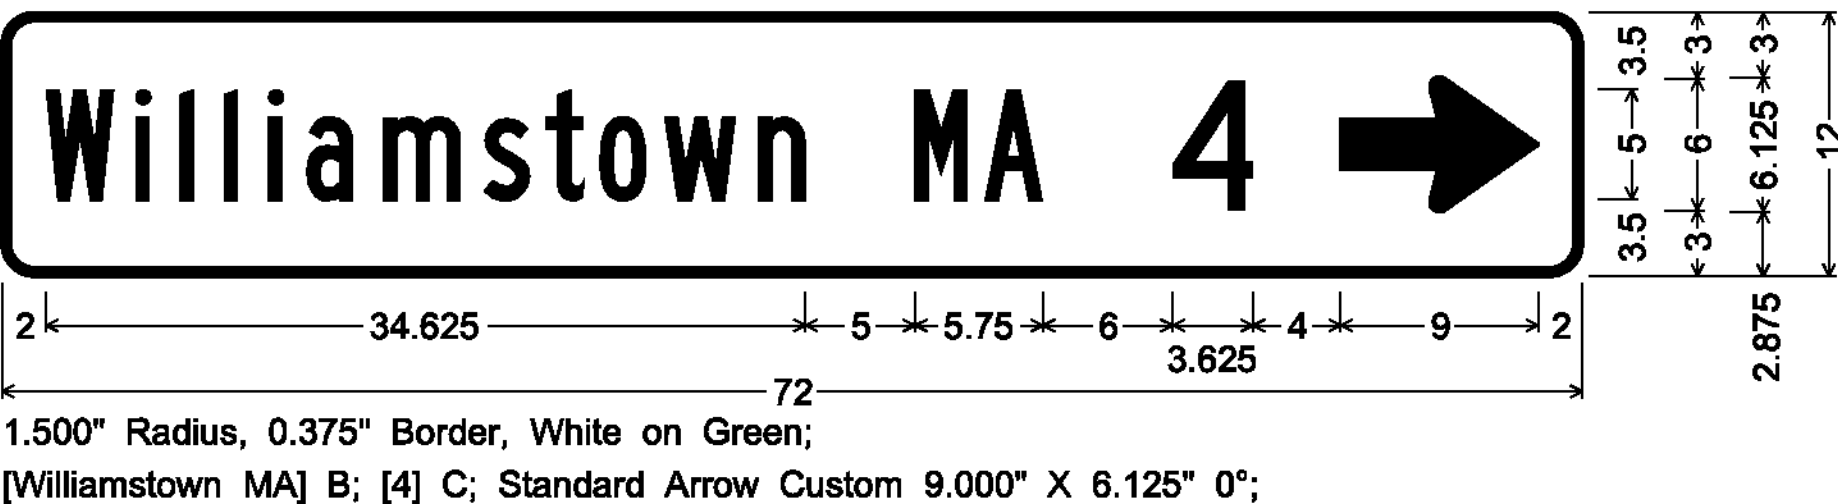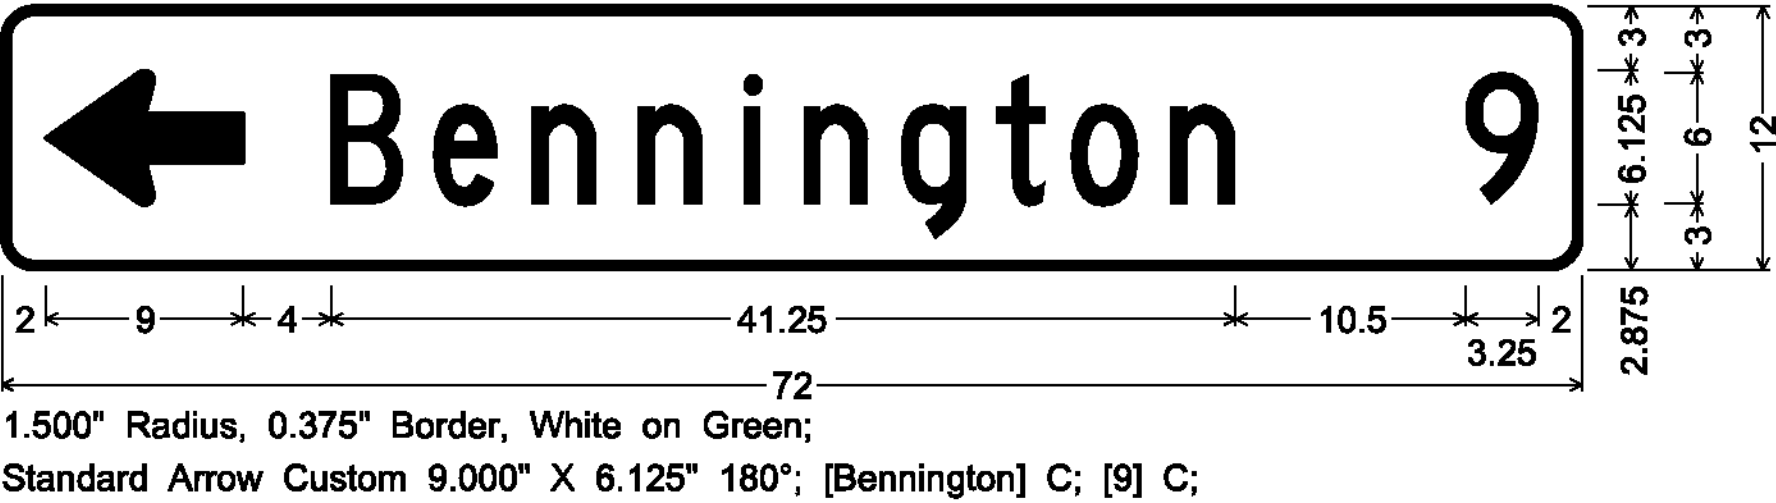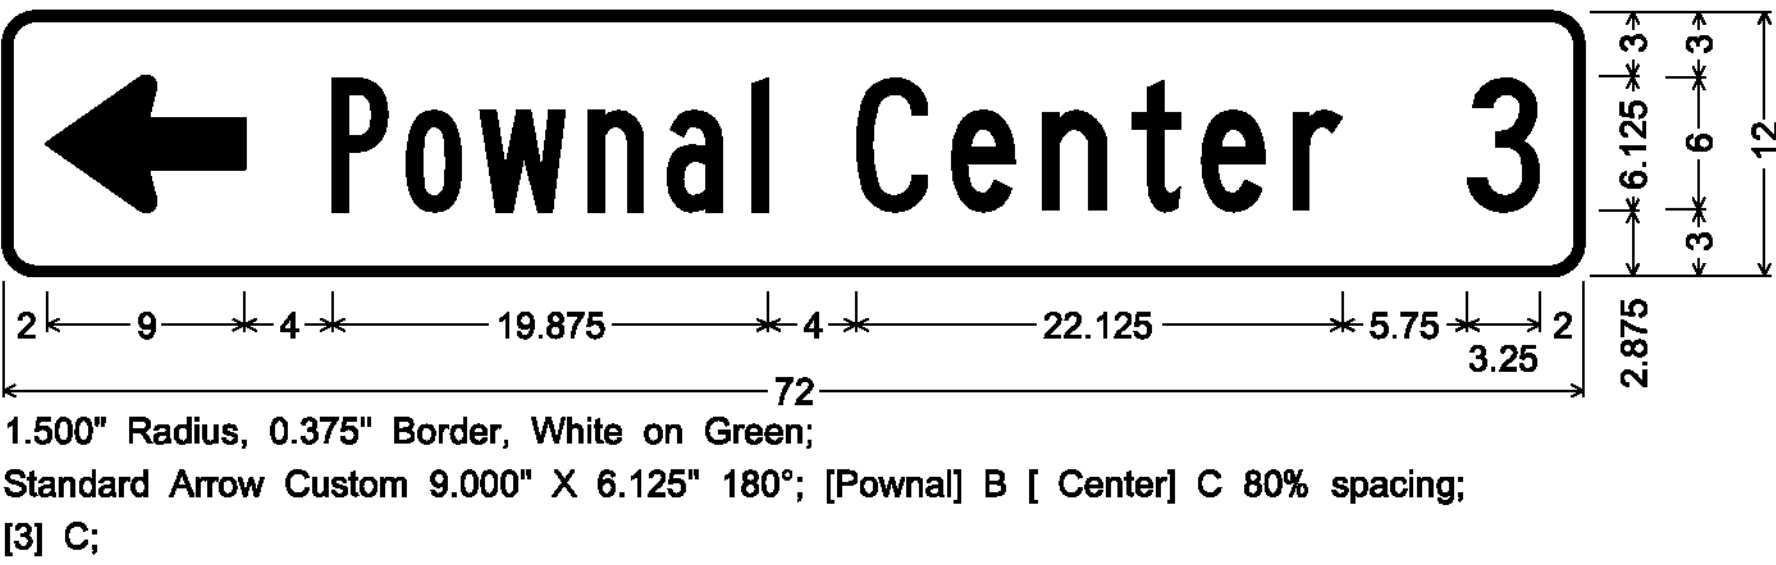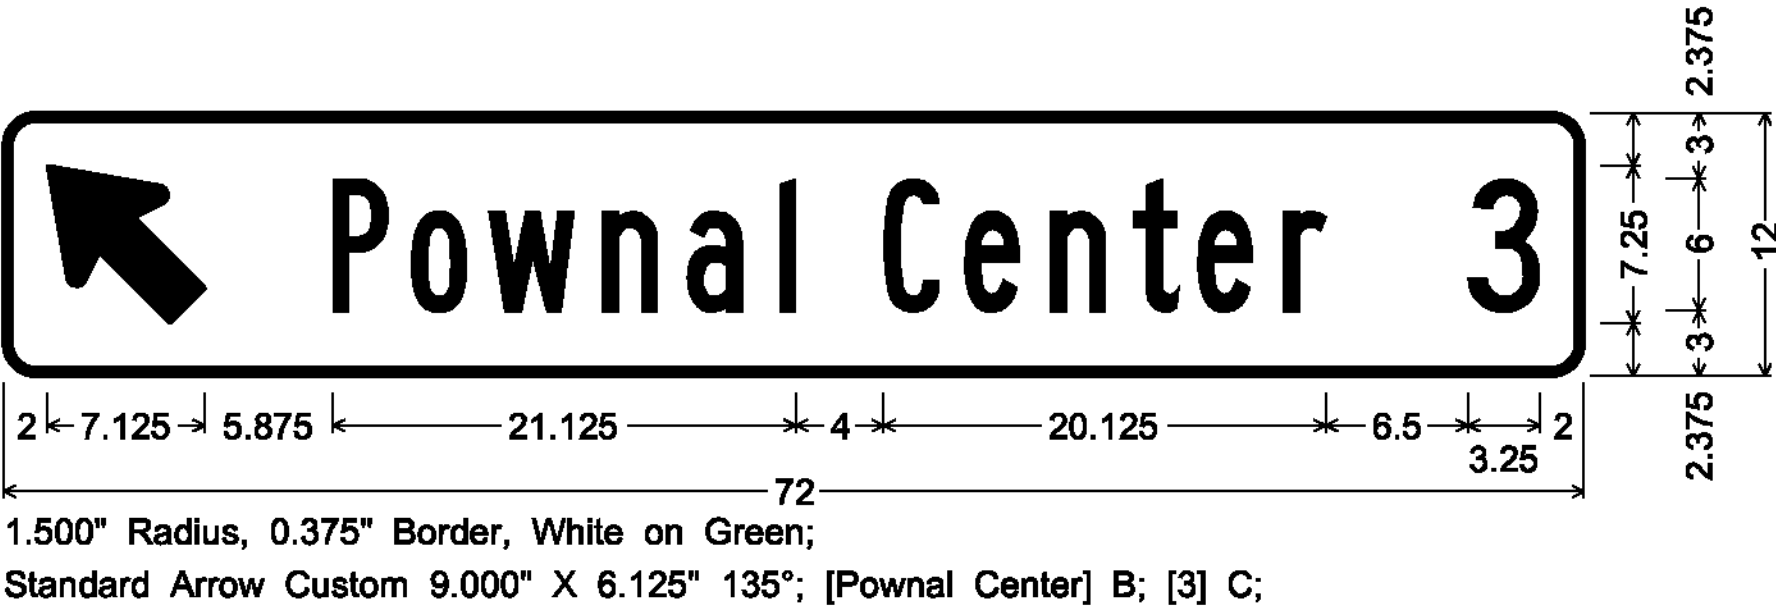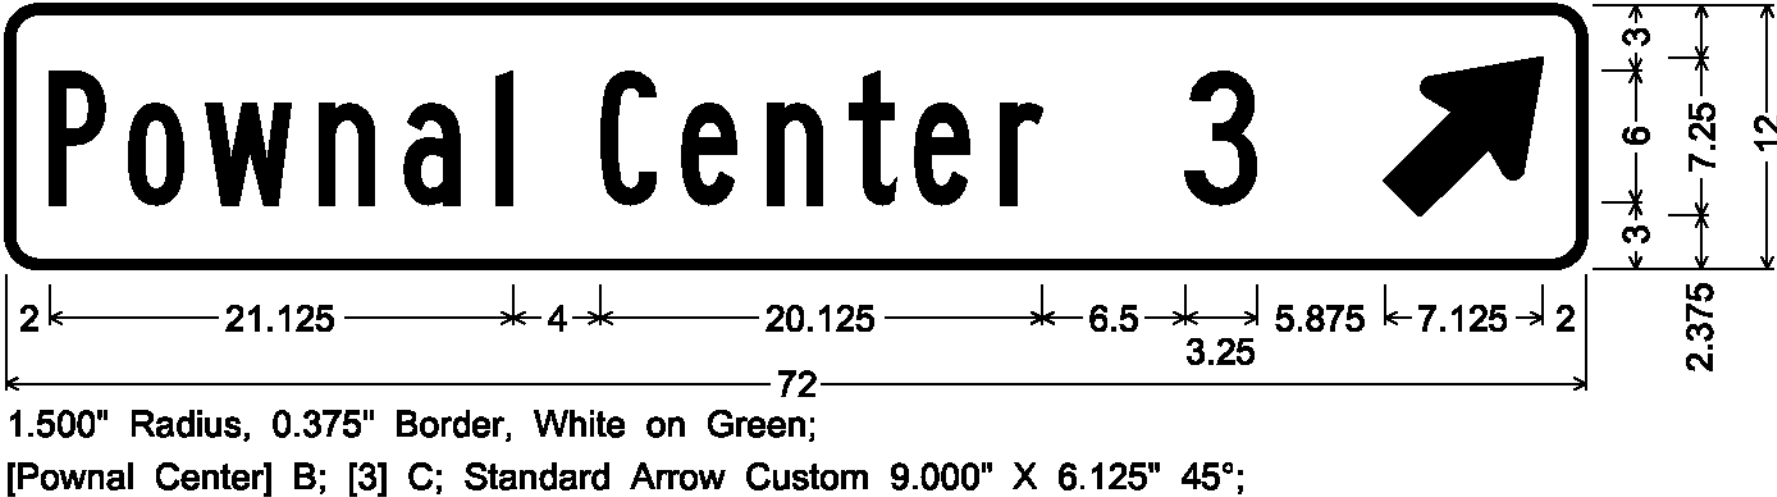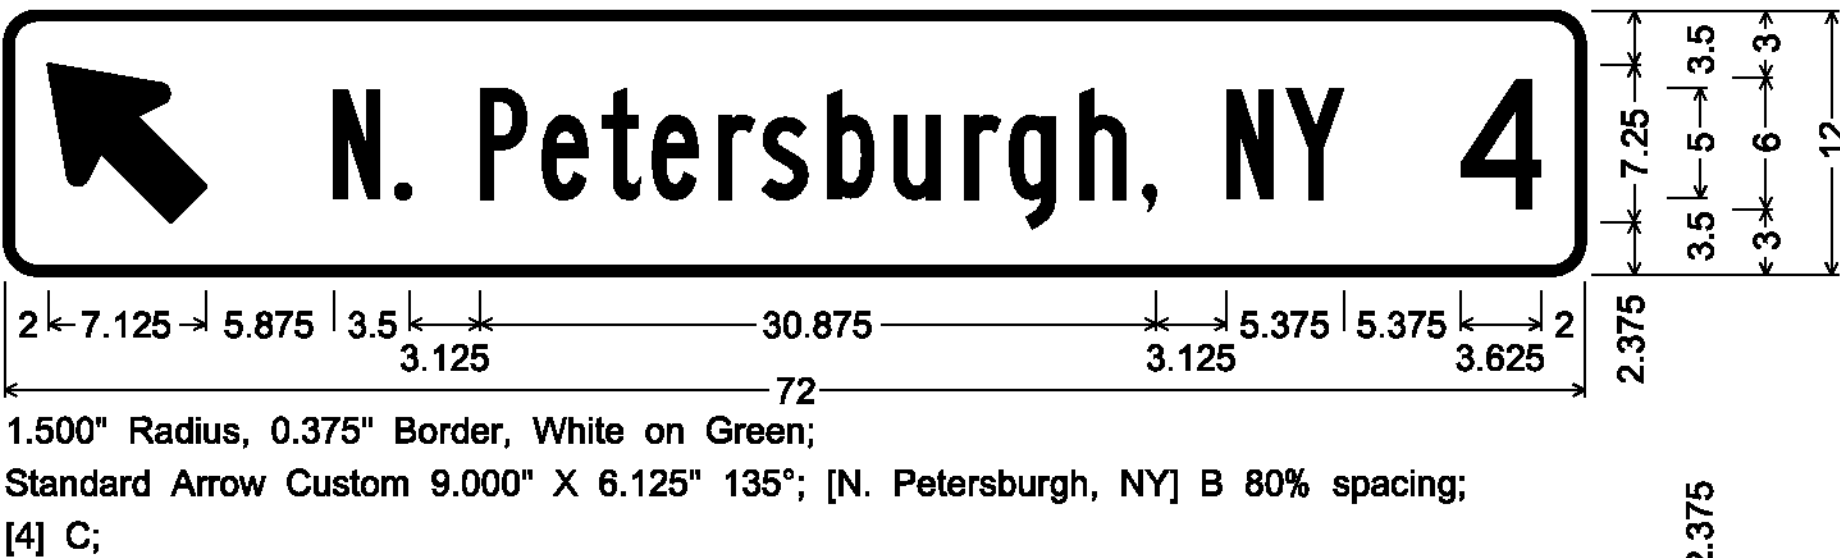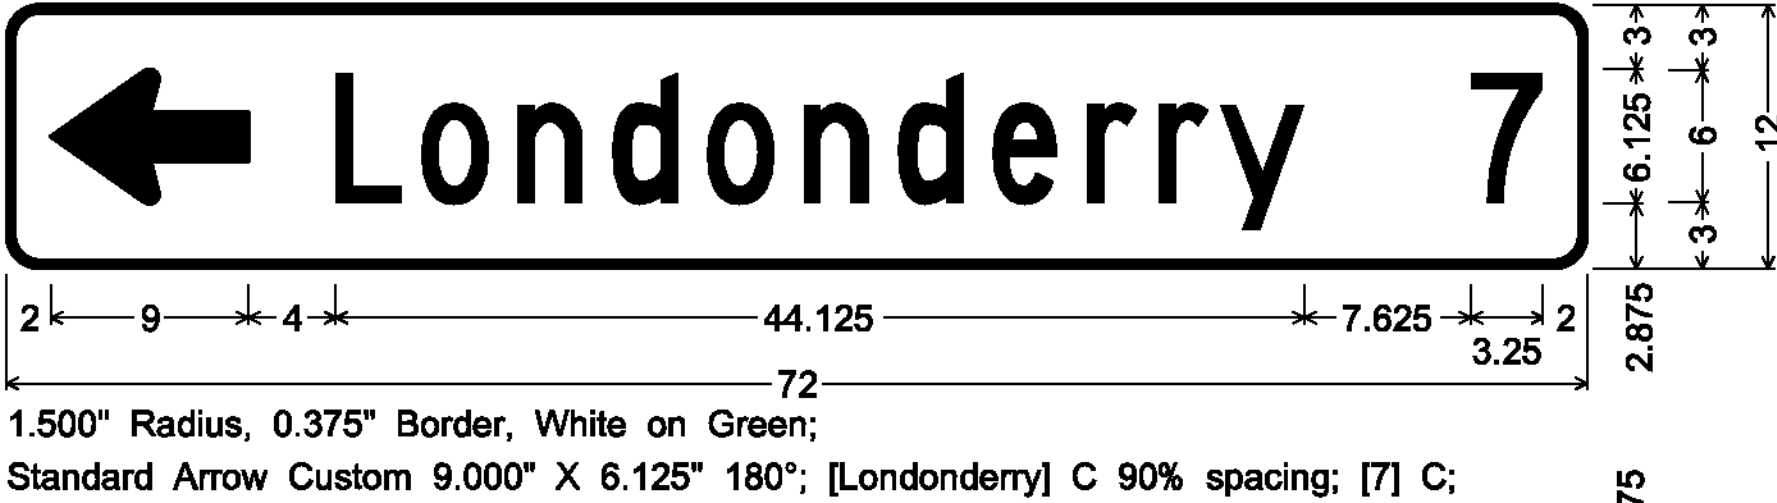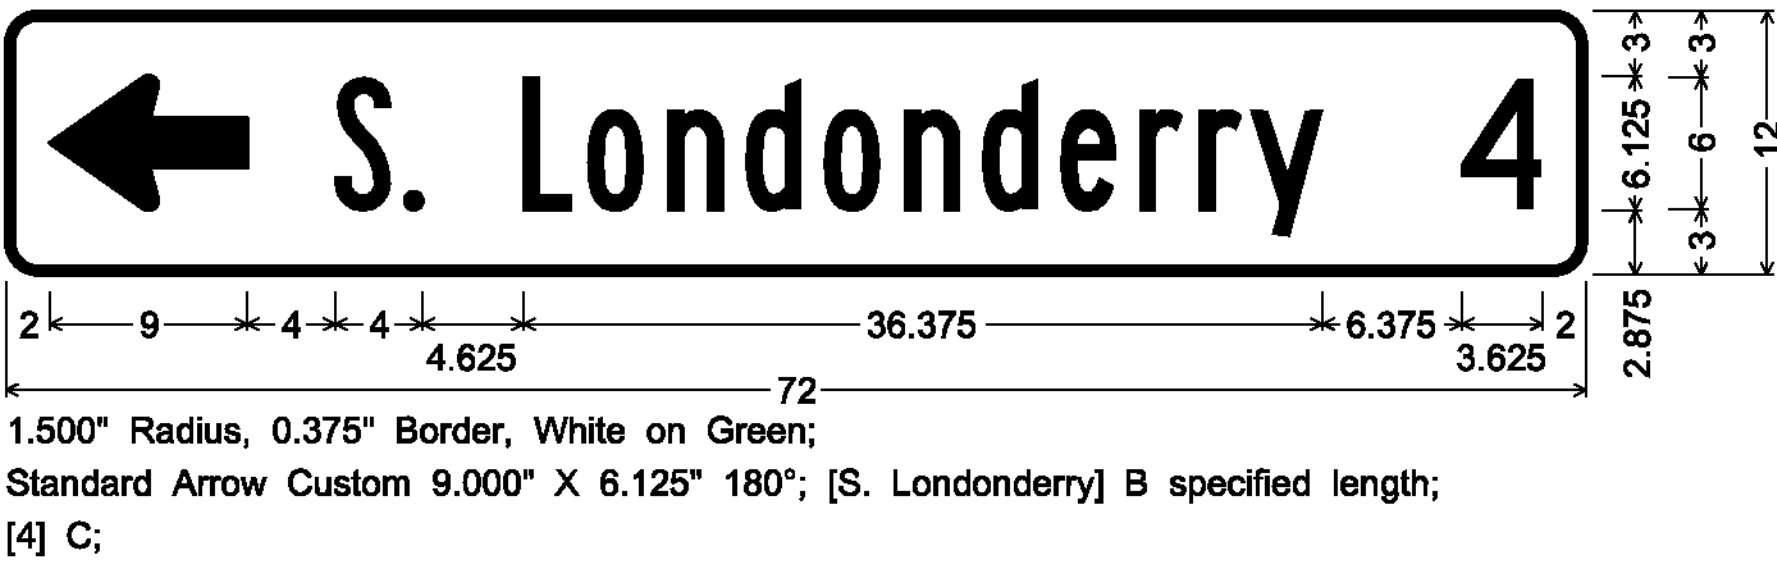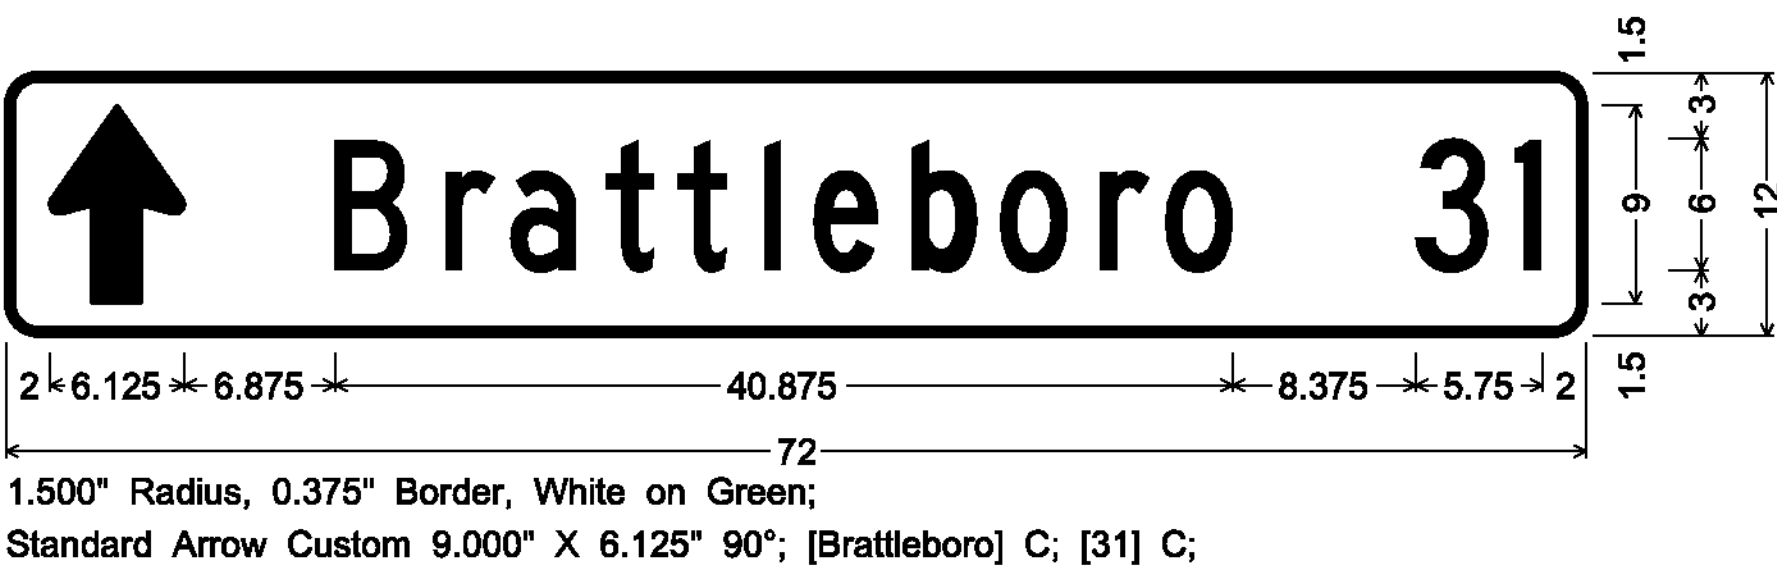

NOTES

1. ALL DIMENSIONS SHOWN IN INCHES, EXCEPT WHERE NOTED.
2. SEE SHEET 4 FOR ADDITIONAL DESTINATION SIGN DETAILS.

PROJECT NAME: STATEWIDE SW REGION


PROJECT NUMBER: STPG SIGN (4I)

FILE NAME: I2CI18.SD_7
PROJECT LEADER: A. GAMBLE
DESIGNED BY: J. KELLY
SIGN DETAILS 7


PLOT DATE: I3-FEB-20I3
DRAWN BY: J. KELLY
CHECKED BY: A. GAMBLE
SHEET IO OF 97

ALL SIGNS ON THIS PAGE ARE SIGN CODE VDI-IA


NOT TO SCALE

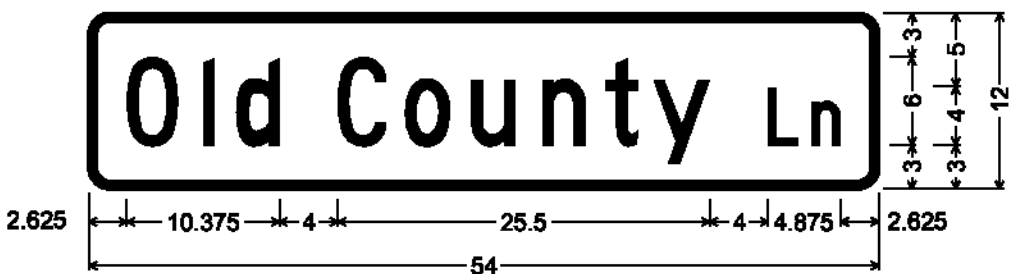

DOUBLE-SIDED STREET SIGN (READSBORO);
1.500" Radius, 0.500" Border, White on Green;
[Old County] C; [Ln] C;

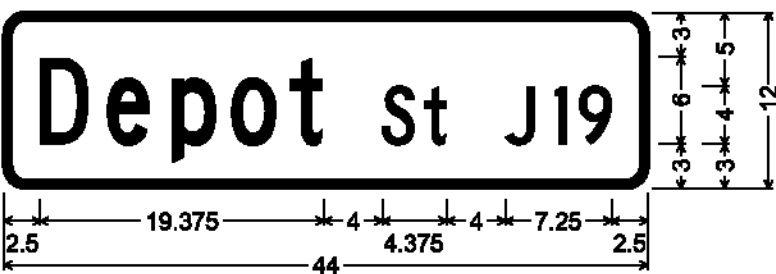

DOUBLE-SIDED STREET SIGN (JAMAICA);
1.500" Radius, 0.500" Border, White on Green;
[Depot] C; [St] C; [J19] C;

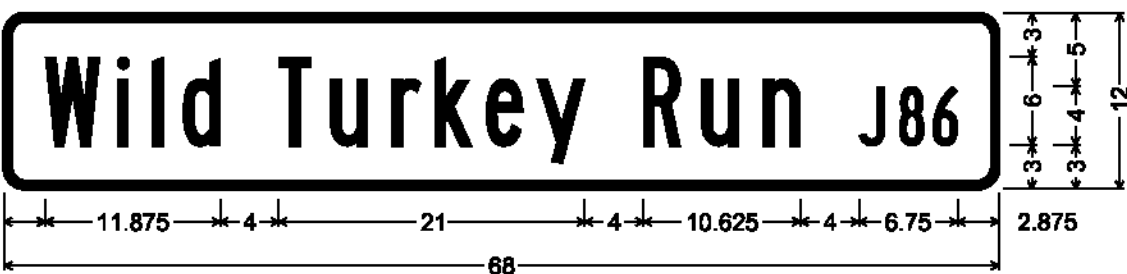

DOUBLE-SIDED STREET SIGN (JAMAICA);
1.500" Radius, 0.500" Border, White on Green;
[Wild Turkey Run] B [J] C; [J86] B;




DOUBLE-SIDED STREET SIGN (SEARSBURG);
1.500" Radius, 0.500" Border, White on Green;
[Hager] C; [Ln] C;




DOUBLE-SIDED STREET SIGN (JAMAICA);
1.500" Radius, 0.500" Border, White on Green;
[Factory] C; [St] C; [J50] C;



DOUBLE-SIDED STREET SIGN (JAMAICA);
1.500" Radius, 0.500" Border, White on Green;
[Bourbon Run] C; [Rd] C; [J65] C;

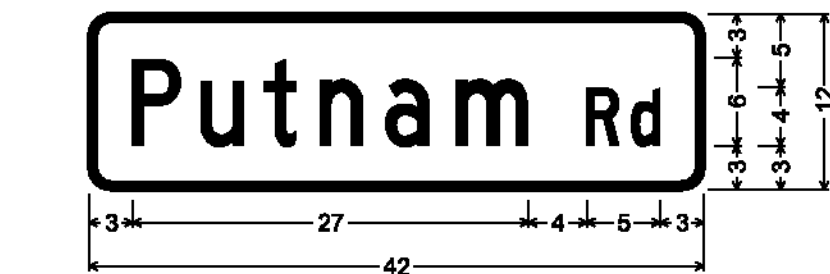


DOUBLE-SIDED STREET SIGN (SEARSBURG);
1.500" Radius, 0.500" Border, White on Green;
[Putnam] C; [Rd] C;

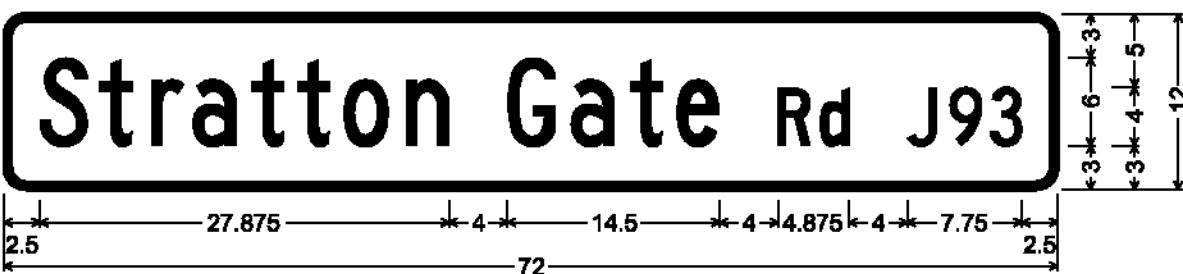


DOUBLE-SIDED STREET SIGN (JAMAICA);
1.500" Radius, 0.500" Border, White on Green;
[Stratton Gate] C 80% spacing; [Rd] C 80% spacing; [J93] C 80% spacing;




DOUBLE-SIDED STREET SIGN (JAMAICA);
1.500" Radius, 0.500" Border, White on Green;
[Mtn Acres] C; [Rd] C; [J11] C;

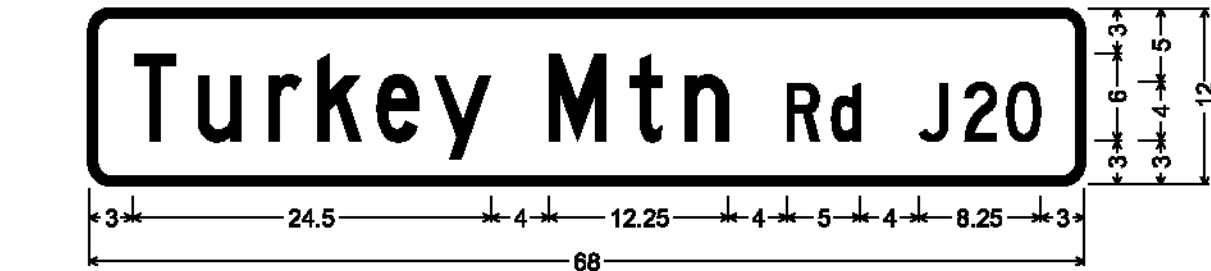


DOUBLE-SIDED STREET SIGN (JAMAICA);
1.500" Radius, 0.500" Border, White on Green;
[Turkey Mtn] C; [Rd] C; [J20] C;

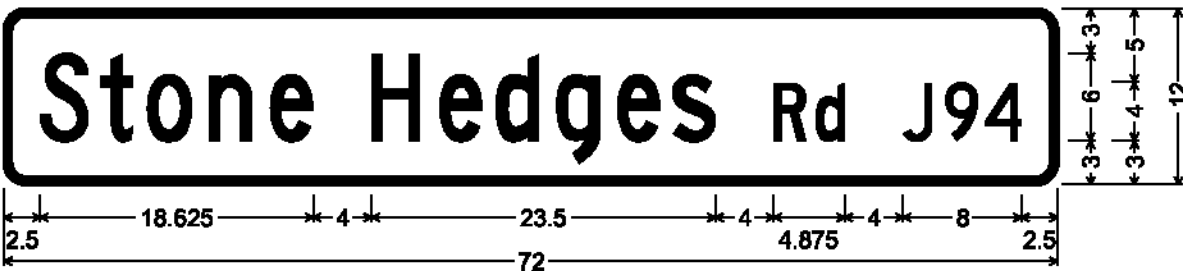


DOUBLE-SIDED STREET SIGN (JAMAICA);
1.500" Radius, 0.500" Border, White on Green;
[Stone Hedges] C 80% spacing; [Rd] C 80% spacing; [J94] C 80% spacing;

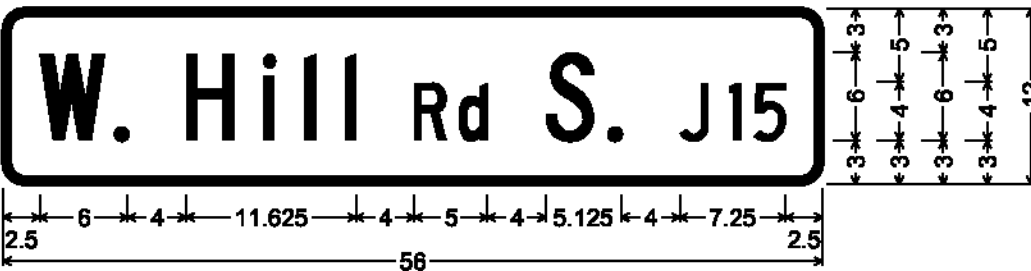


DOUBLE-SIDED STREET SIGN (JAMAICA);
1.500" Radius, 0.500" Border, White on Green;
[W. Hill] C; [Rd] C; [S.] C; [J15] C;

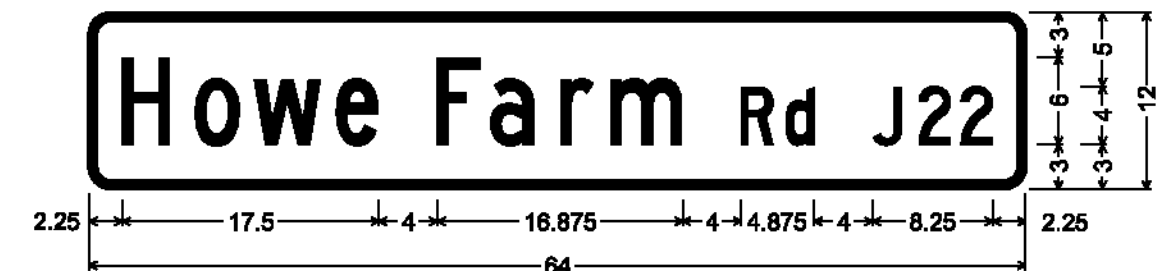

DOUBLE-SIDED STREET SIGN (JAMAICA);
1.500" Radius, 0.500" Border, White on Green;
[Howe Farm] C; [Rd] C; [J22] C;

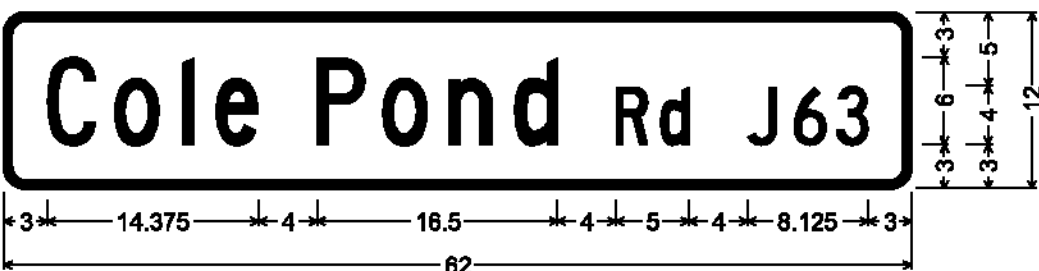


DOUBLE-SIDED STREET SIGN (JAMAICA);
1.500" Radius, 0.500" Border, White on Green;
[Cole Pond] C; [Rd] C; [J63] C;

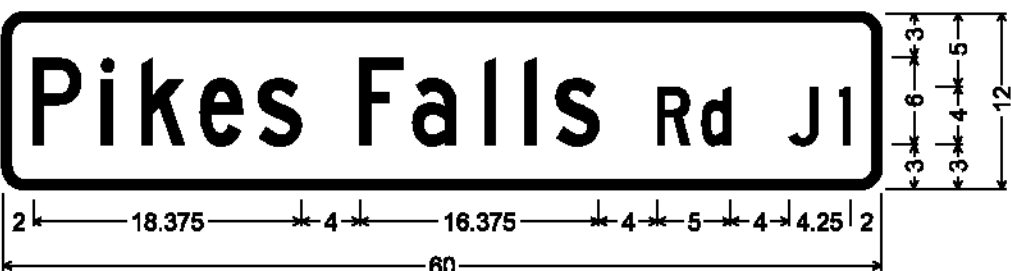

DOUBLE-SIDED STREET SIGN (JAMAICA);
1.500" Radius, 0.500" Border, White on Green;
[Pikes Falls] C; [Rd] C; [J1] C;




DOUBLE-SIDED STREET SIGN (JAMAICA);
1.500" Radius, 0.500" Border, White on Green;
[Gilfeather] C; [Ln] C; [J21] C;

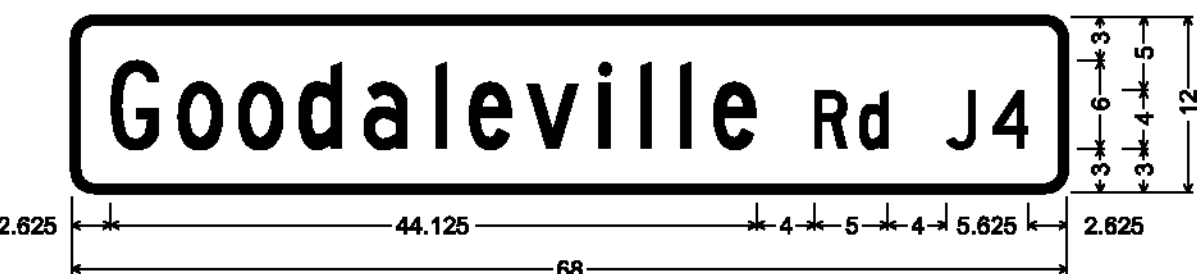

DOUBLE-SIDED STREET SIGN (JAMAICA);
1.500" Radius, 0.500" Border, White on Green;
[Goodaleville] C; [Rd] C; [J4] C;



DOUBLE-SIDED STREET SIGN (JAMAICA);
1.500" Radius, 0.500" Border, White on Green;
[River] C; [Rd] C; [J41] C;

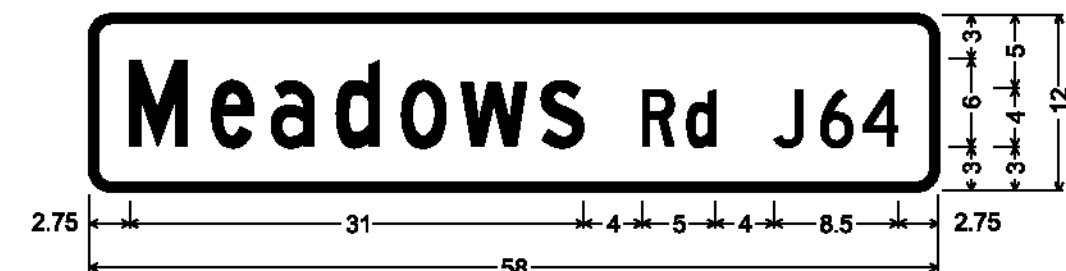

DOUBLE-SIDED STREET SIGN (JAMAICA);
1.500" Radius, 0.500" Border, White on Green;
[Meadows] C; [Rd] C; [J64] C;



DOUBLE-SIDED STREET SIGN (JAMAICA);
1.500" Radius, 0.500" Border, White on Green;
[Diers] C; [Rd] C; [J9] C;

ALL SIGNS ON THIS PAGE ARE SIGN CODE D3-I
(ALL SIGNS ARE DOUBLE-SIDED)

NOT TO SCALE

ALL DIMENSIONS SHOWN IN INCHES, EXCEPT WHERE NOTED.

PROJECT NAME: STATEWIDE SW REGION

PROJECT NUMBER: STPG SIGN (41)

FILE NAME: I2CI18.SD_8

PROJECT LEADER: A. GAMBLE

DESIGNED BY: J. KELLY


SIGN DETAILS 8

PLOT DATE: I3-FEB-2013


DRAWN BY: J. KELLY

CHECKED BY: A. GAMBLE

SHEET II OF 97

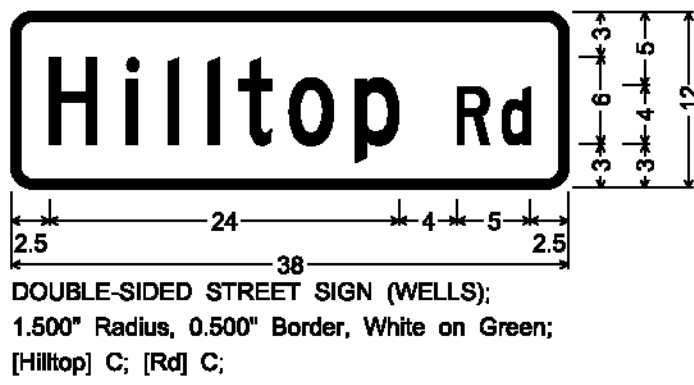


DOUBLE-SIDED STREET SIGN (WELLS);
1,500" Radius, 0.500" Border, White on Green;
[Hilltop] C; [Rd] C;

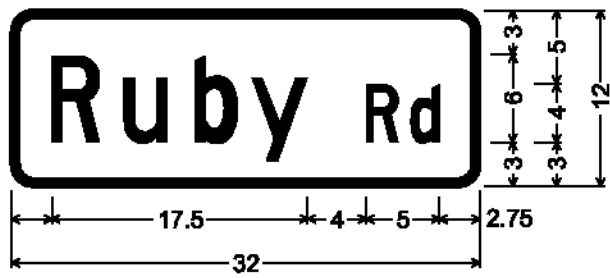


DOUBLE-SIDED STREET SIGN (POULTNEY);
1,500" Radius, 0.500" Border, White on Green;
[Ruby] C; [Rd] C;




DOUBLE-SIDED STREET SIGN (POULTNEY);
1,500" Radius, 0.500" Border, White on Green;
[Upper] C; [Rd] C;

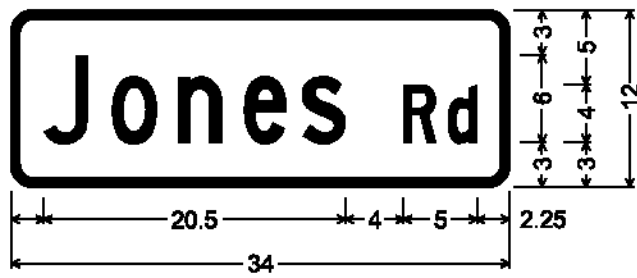

DOUBLE-SIDED STREET SIGN (POULTNEY);
1,500" Radius, 0.500" Border, White on Green;
[Jones] C; [Rd] C;

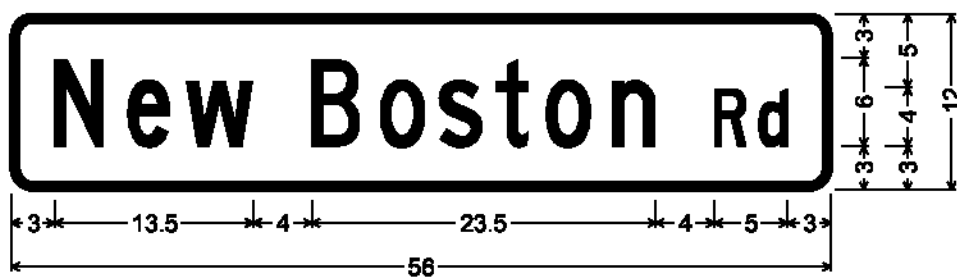


DOUBLE-SIDED STREET SIGN (POULTNEY);
1,500" Radius, 0.500" Border, White on Green;
[New Boston] C; [Rd] C;

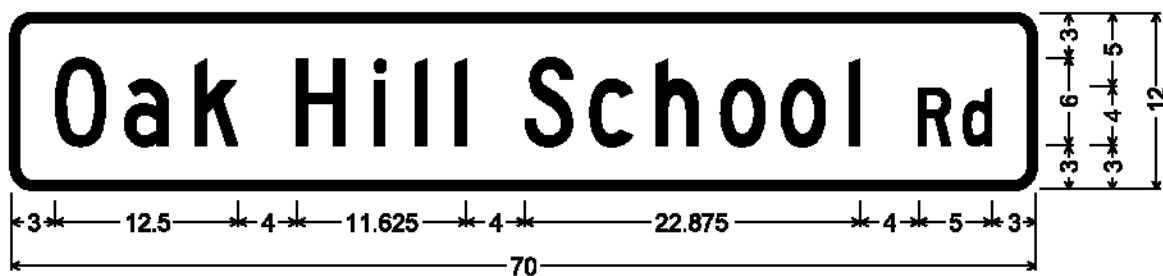


DOUBLE-SIDED STREET SIGN (POWNA);
1,500" Radius, 0.500" Border, White on Green;
[Oak Hill School] C; [Rd] C;




DOUBLE-SIDED STREET SIGN (POWNA);
1,500" Radius, 0.500" Border, White on Green;
[Cedar Hill] C; [Rd] C;

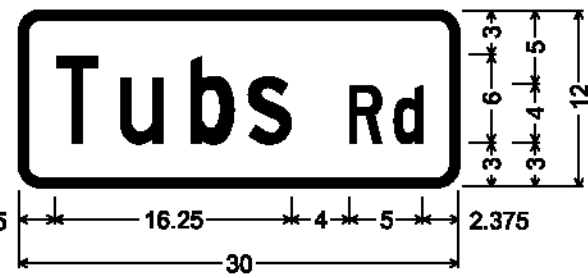


DOUBLE-SIDED STREET SIGN (POWNA);
1,500" Radius, 0.500" Border, White on Green;
[Tubs] C; [Rd] C;

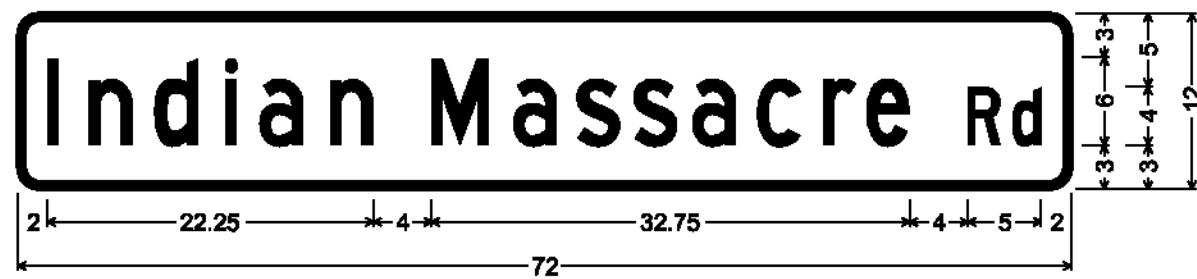

DOUBLE-SIDED STREET SIGN (POWNA);
1,500" Radius, 0.500" Border, White on Green;
[Indian Massacre] C; [Rd] C;

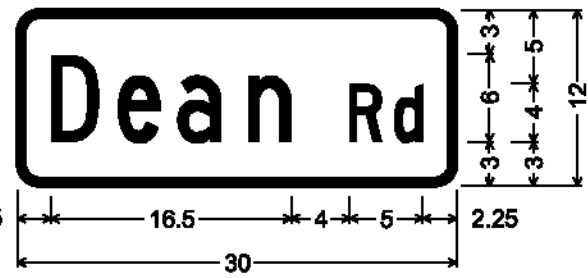


DOUBLE-SIDED STREET SIGN (POWNA);
1,500" Radius, 0.500" Border, White on Green;
[Dean] C; [Rd] C;

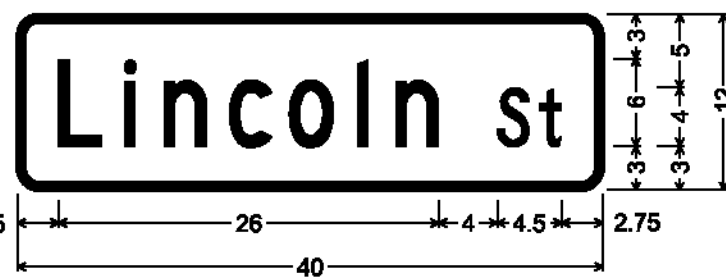

DOUBLE-SIDED STREET SIGN (POWNA);
1,500" Radius, 0.500" Border, White on Green;
[Lincoln] C; [St] C;



DOUBLE-SIDED STREET SIGN (POWNA);
1,500" Radius, 0.500" Border, White on Green;
[Main] C; [St] C;

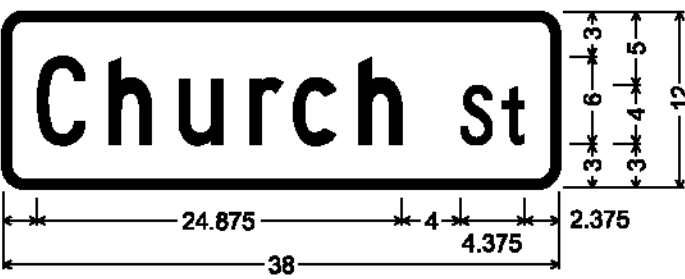


DOUBLE-SIDED STREET SIGN (POWNA);
1,500" Radius, 0.500" Border, White on Green;
[Church] C; [St] C;

ALL SIGNS ON THIS PAGE ARE SIGN CODE D3-1
(ALL SIGNS ARE DOUBLE-SIDED)




NOT TO SCALE



ALL DIMENSIONS SHOWN IN INCHES, EXCEPT WHERE NOTED.




PROJECT NAME: STATEWIDE SW REGION	
PROJECT NUMBER: STPG SIGN (41)	
FILE NAME: I2CI18.SD.9	PLOT DATE: I3-FEB-2013
PROJECT LEADER: A. GAMBLE	DRAWN BY: J. KELLY
DESIGNED BY: J. KELLY	CHECKED BY: A. GAMBLE
SIGN DETAILS 9	SHEET I2 OF 97

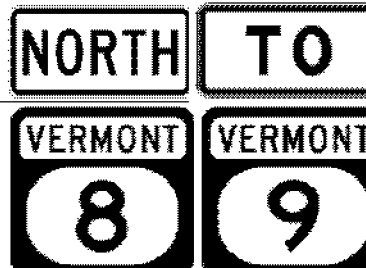
DIRECTION	MILEPOINT	LOCATION CODE (SHEET 2)	SIGN CODE	WIDTH (IN)	HEIGHT (IN)	SHEETING REMARKS	SIGN LEGEND	NEW SIGNS		EXISTING SIGNS				EXIST POST		NUMBER OF NEW POSTS	SQUARE STEEL (IN)			TUBULAR STEEL Ø (IN)					SIGN FRAME REQUIRED	REMARKS	SIGN DETAIL LOCATION			
								"A"	"B"	RETAIN	SALVAGE FROM	SALVAGE TO	REMOVE	RETAIN	REMOVE		1.75	2.00	2.50	FOUNDATION	3.00	3.50	4.00	5.00			SHSM	PROJECT SHEET #	STANDARD SHEET #	
																	(LB / FT)				(LB / FT)									
																	1.88	2.42	3.35		7.60	9.00	10.80	14.60						
READSBORO VT-8 NB							FY-FLUORESCENT YELLOW FYG-FLUORESCENT YELLOW GREEN															"SHSM"-STANDARD HIGHWAY SIGNS AND MARKINGS								
NB	0.009	A	VD-700	6	10							1		X																
		B	R1-1	30	30							1																		
		A	VD-700	6	10			0.42																		INSTALL NEW SIGN ON EXISTING FLANGED CHANNEL SIGN POST.	X			
		B	R1-1	30	30			6.25																						
NB	0.027	A	M3-1	24	12		ROUTE MARKER ASSEMBLY.						1		X															
		A	M1-5	24	24								1																	
		A	M4-5	24	12								1																	
		A	M1-5	24	24								1													SIGN NOT FOUND IN THE FIELD				
		A	M3-1	24	12			2.00								2		14'-11" X 15'-3"						#1			5	E-136B		
		A	M1-5	24	24			4.00																				E-136B		
		A	M4-5	24	12			2.00																				E-136B		
		A	M1-5	24	24			4.00																				E-136B		
NB	0.050	A	W1-1L	30	30		LEFT TURN						1		X															
		A	W13-1	18	18		30 MPH ADVISORY						1																	
		A	VD2-1	72	12			6.00								2		15'-0" X 13'-4"									8			
		A	VD2-1	72	12			6.00																			8			
		A	VD2-1	72	12			6.00																			8			
SIGN SUMMARY SHEET							SHEET TOTALS	36.67 36.25	0.00	0	0	0	7	0	0	4	60.0			0	0.0	0.0	0.0	0.0	PROJECT NAME: STATEWIDE SOUTHWEST REGION					
								SF	SF	EA	EA	EA	EA	EA	EA	EA		FT		EA	LB	LB	LB	LB	PROJECT NUMBER: STPG SIGN(41)					
																								FILE NAME: 12C118						
VERMONT AGENCY OF TRANSPORTATION																								PROJECT MANAGER: A. GAMBLE						
																								DESIGNED BY: J. KELLY						
																								DRAWN BY: J. KELLY						
																								CHECKED: A. GAMBLE						
																								SHEET 13 OF 97						
																								READSBORO NB SHEET 1						

DIRECTION	MILEPOINT	LOCATION CODE (SHEET 2)	SIGN CODE	WIDTH (IN)	HEIGHT (IN)	SHEETING REMARKS	SIGN LEGEND	NEW SIGNS		EXISTING SIGNS				EXIST POST		NUMBER OF NEW POSTS	SQUARE STEEL (IN)			TUBULAR STEEL Ø (IN)					SIGN FRAME REQUIRED	REMARKS	SIGN DETAIL LOCATION		
								"A"	"B"	RETAIN	SALVAGE FROM	SALVAGE TO	REMOVE	RETAIN	REMOVE		1.75	2.00	2.50	FOUNDATION	3.00	3.50	4.00	5.00			SHSM	PROJECT SHEET #	STANDARD SHEET #
																	(LB / FT)				(LB / FT)								
																	1.88	2.42	3.35		7.60	9.00	10.80	14.60					
READSBORO VT-8 NB							FY-FLUORESCENT YELLOW FYG-FLUORESCENT YELLOW GREEN															"SHSM"-STANDARD HIGHWAY SIGNS AND MARKINGS							
NB	0.057	A	D3-1	UNK	UNK		Old County Ln						1		X									OLD COUNTY LN (TH-31)					
		A	D3-1	54	12			4.50								2		13'-11" X 13'-11"						FIELD LOCATE AS TO NOT BLOCK ANY OTHER SIGNAGE.		11			
NB	0.065	C	VR-017	24	30		LEGAL LOAD LIMIT 24,000 POUNDS						1		X									OLD COUNTY LN (TH-31)					
		C	VR-017	24	30			5.00								1		14'-4" X								6			
NB	0.071	C D	VD-700 R1-1	6 30	10 30		STOP 0080 0209 0007						1		X									OLD COUNTY LN (TH-31)					
		C D	VD-700 R1-1	6 30	10 30			0.42 6.25								1		13'-2" X								X			
NB	0.105	A	D2-1	72	10		DESTINATION SIGN ASSEMBLY						1		X														
		A	D2-1	72	10								1																
		A	D2-1	72	10								1																
NB	0.268	A	W1-5L	48	48		LEFT WINDING CURVES						+		X									SIGN ASSEMBLY NOT FOUND					
		A	W7-3A	24	18		NEXT 2 MILES						+																
		A	W13-1	18	18		35 MPH ADVISORY						+																
NB	0.279	A	W1-5L	30	30		WINDING ROAD	6.25								2		14'-10" X 13'-3"						INSTALL 60 FEET NORTH OF EXISTING WINDING ROAD SIGN ASSEMBLY.	X				
		A	W7-3A	24	18			3.00																		X			
		A	W13-1P	18	18			NEXT 2 MILES 35 MPH	2.25																		X		
SIGN SUMMARY SHEET							SHEET TOTALS	27.67 27.25	0.00	0	0	0	7 9-	0	0	6	90.0			0	0.0	0.0	0.0	0.0	PROJECT NAME: STATEWIDE SOUTHWEST REGION				
								SF	SF	EA	EA	EA	EA	EA	EA	EA		FT		EA	LB	LB	LB	LB	PROJECT NUMBER: STPG SIGN(41)				
																								FILE NAME: 12C118					
VERMONT AGENCY OF TRANSPORTATION																								PROJECT MANAGER: A. GAMBLE					
							TOWN DIRECTIONAL TOTALS	90.59 89.8-	0.0	1	0	0	18	0	0	13	195.0			0	0.0				PLOT DATE: 2/21/2013				
																								DRAWN BY: J. KELLY					
																								CHECKED: A. GAMBLE					
																								DESIGNED BY: J. KELLY					
																								READSBORO NB SHEET 2					
																								SHEET 14 OF 97					


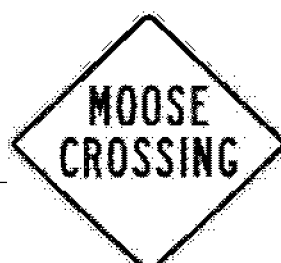
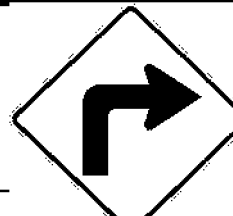
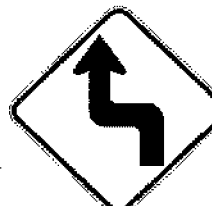
DIRECTION	MILEPOINT	LOCATION CODE (SHEET 2)	SIGN CODE	WIDTH (IN)	HEIGHT (IN)	SHEETING REMARKS	SIGN LEGEND	NEW SIGNS		EXISTING SIGNS				EXIST POST		NUMBER OF NEW POSTS	SQUARE STEEL (IN)			TUBULAR STEEL Ø (IN)				SIGN FRAME REQUIRED	REMARKS	SIGN DETAIL LOCATION			
								"A"	"B"	RETAIN	SALVAGE FROM	SALVAGE TO	REMOVE	RETAIN	REMOVE		1.75	2.00	2.50	FOUNDATION	3.00	3.50	4.00			5.00	SHSM	PROJECT SHEET #	STANDARD SHEET #
																	(LB / FT)				(LB / FT)								
																	1.88	2.42	3.35		7.60	9.00	10.80			14.60			
READSBORO VT-8 NB							FY-FLUORESCENT YELLOW FYG-FLUORESCENT YELLOW GREEN															"SHSM"-STANDARD HIGHWAY SIGNS AND MARKINGS							
NB	0.380	A	VW-000	30	30			6.25							1	14'-6" X							INSTALL 525 FEET NORTH OF NEW WINDING ROAD SIGN ASSEMBLY (& SOUTH OF BRIDGE).		7				
		A	W7-3A	24	18			3.00																X					
NB	0.860	A	W1-1R	30	30			6.25							1	16'-4" X							INSTALL 325 FEET SOUTH OF EXISTING LEFT REVERSE TURN SIGN ASSEMBLY.	X					
		A	W13-1P	18	18			2.25																X					
NB	0.920	A	W1-3L	30	30		LEFT REVERSE TURN						1		X														
		A	W13-1	18	18		30 MPH ADVISORY						1																
NB	0.960	A	W1-3L	30	30			6.25							1	15'-0" X							INSTALL 200 FEET NORTH OF EXISTING LEFT REVERSE TURN SIGN ASSEMBLY.	X					
		A	W13-1P	18	18			2.25																X					
NB	1.275	A	VD11-6H	30	30		FOLDING SNOWMOBILE			1				X															
NB	0.800	A	W1-1R	30	30		RIGHT TURN						1		1														
		A	W13-1	18	18		30 MPH ADVISORY						1																
SIGN SUMMARY SHEET							SHEET TOTALS	26.25	0.00	1	0	0	4 2-	0	0	3	45.0			0	0.0	0.0	0.0	0.0	PROJECT NAME: STATEWIDE SOUTHWEST REGION				
								SF	SF		EA	EA	EA	EA	EA	EA		FT		EA	LB	LB	LB	LB	PROJECT NUMBER: STPG SIGN(41)				
																								FILE NAME: 12C118					
VERMONT AGENCY OF TRANSPORTATION																								PROJECT MANAGER: A. GAMBLE			PLOT DATE: 2/21/2013		
																											DESIGNED BY: J. KELLY		
																							CHECKED: A. GAMBLE			SHEET 16 OF 97			
							TOWN DIRECTIONAL TOTALS	90.59 -89.8-	0.0	1	0	0	18	0	0	13	195.0			0	0.0				READSBORO NB SHEET 3				

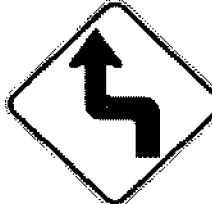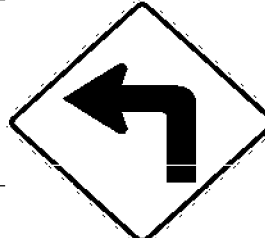DIRECTION	MILEPOINT	LOCATION CODE (SHEET 2)	SIGN CODE	WIDTH (IN)	HEIGHT (IN)	SHEETING REMARKS	SIGN LEGEND	NEW SIGNS		EXISTING SIGNS				EXIST POST		NUMBER OF NEW POSTS	SQUARE STEEL (IN)			TUBULAR STEEL Ø (IN)					SIGN FRAME REQUIRED	REMARKS	SIGN DETAIL LOCATION		
								"A"	"B"	RETAIN	SALVAGE FROM	SALVAGE TO	REMOVE	RETAIN	REMOVE		1.75	2.00	2.50	FOUNDATION	3.00	3.50	4.00	5.00			SHSM	PROJECT SHEET #	STANDARD SHEET #
																	(LB / FT)				(LB / FT)								
																	1.88	2.42	3.35		7.60	9.00	10.80	14.60					
READSBORO VT-8 SB							FY-FLUORESCENT YELLOW FYG-FLUORESCENT YELLOW GREEN															"SHSM"-STANDARD HIGHWAY SIGNS AND MARKINGS							
SB	2.060	F	W1-5R	30	30			6.25							2	14'-3" 14'-2" X							INSTALL 425 FEET SOUTH OF SMALL GRAVEL PULL-OFF (AT MP 2.14).	X					
		F	W7-3A	24	18			3.00																X					
		F	W13-1P	18	18			2.25																	X				
SB	1.435	F	VW11-6H	30	30		FOLDING SNOWMOBILE			1				X															
SB	1.163	F	W1-3L	30	30			6.25							1	13'-9" X								INSTALL 150 FEET NORTH OF EXISTING LEFT REVERSE TURN SIGN ASSEMBLY.	X				
		F	W13-1P	18	18			2.25																	X				
SB	1.135	F	W1-3L	30	30		LEFT REVERSE TURN						1		X														
		F	W13-1P	18	18		30 MPH ADVISORY						1																
SB	0.948	F	W1-1L	30	30		LEFT TURN						1		X														
		F	W13-1P	18	18		30 MPH ADVISORY						1																
SB	0.908	F	W1-1L	30	30			6.25								1	15'-0" X							INSTALL 200 FEET SOUTH OF EXISTING LEFT CURVE SIGN ASSEMBLY.	X				
		F	W13-1	18	18			2.25																	X				
SB	0.200	F	W1-1MR	30	30		MODIFIED RIGHT TURN WITH SIDE ROADS						1		X														
		F	W13-1	18	18								1																
		F	VD-700	6	10								1																
SIGN SUMMARY SHEET							SHEET TOTALS	28.50	0.00	1	0	0	7	0	0	4	60.0			0	0.0	0.0	0.0	0.0	PROJECT NAME: STATEWIDE SOUTHWEST REGION				
								SF	SF	EA	EA	EA	EA	EA	EA	EA		FT		EA	LB	LB	LB	LB	PROJECT NUMBER: STPG SIGN(41)				
																									FILE NAME: 12C118			PLOT DATE: 2/13/2013	
							VERMONT AGENCY OF TRANSPORTATION																	PROJECT MANAGER: A. GAMBLE			DRAWN BY: J. KELLY		
							TOWN DIRECTIONAL TOTALS	124.27 123.4	0.0	1	0	0	27	0	0	12	180.0			0	0.0				DESIGNED BY: J. KELLY			CHECKED: A. GAMBLE	
																								READSBORO SB SHEET 1			SHEET 16 OF 97		




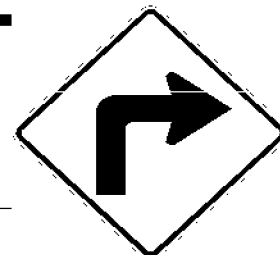
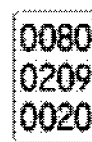
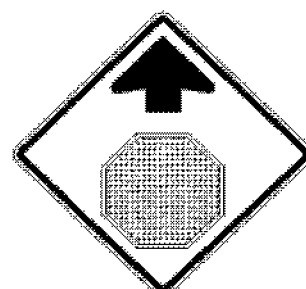
DIRECTION	MILEPOINT	LOCATION CODE (SHEET 2)	SIGN CODE	WIDTH (IN)	HEIGHT (IN)	SHEETING REMARKS	SIGN LEGEND	NEW SIGNS		EXISTING SIGNS				EXIST POST		NUMBER OF NEW POSTS	SQUARE STEEL (IN)			TUBULAR STEEL Ø (IN)					SIGN FRAME REQUIRED	REMARKS	SIGN DETAIL LOCATION		
								"A"	"B"	RETAIN	SALVAGE FROM	SALVAGE TO	REMOVE	RETAIN	REMOVE		1.75	2.00	2.50	FOUNDATION	3.00	3.50	4.00	5.00			SHSM	PROJECT SHEET #	STANDARD SHEET #
																	(LB / FT)				(LB / FT)								
																	1.88	2.42	3.35		7.60	9.00	10.80	14.60					
READSBORO VT-8 SB							FY-FLUORESCENT YELLOW FYG-FLUORESCENT YELLOW GREEN															"SHSM"-STANDARD HIGHWAY SIGNS AND MARKINGS							
		F	W1-1R	30	30			6.25							1	18'-3" X								X					
		F	W13-1P	18	18			2.25																X					
		F	VD-700	6	10			0.42																		E-138			
SB	0.161	F	W3-1	30	30							1		X															
		F	W3-1	30	30			6.25							1	14'-4" X								X					
SB	0.123	F	M2-1	21	15							1		X															
		F	M1-5	30	24							1																	
		F	M2-1	21	15			2.19							1	15'-0" X										E-136B			
		F	M1-5	30	24			5.00																		E-136B			
SB	0.086	F	D1-1A	72	10		DESTINATION SIGN ASSEMBLY					1		X															
		F	D1-1A	72	10							1																	
		F	D1-1A	72	10							1																	
		F	D1-1M	72	10							1																	
		F	VD1-1A	72	12			6.00							2	14'-8" 15'-2" X									9				
		F	VD1-1A	72	12			6.00																	9				
SIGN SUMMARY SHEET							SHEET TOTALS	34.36	0.00	0	0	0	7	0	0	5	75.0		0	0.0	0.0	0.0	0.0	PROJECT NAME: STATEWIDE SOUTHWEST REGION					
								SF	SF	EA	EA	EA	EA	EA	EA	EA		FT		EA	LB	LB	LB	LB	PROJECT NUMBER: STPG SIGN(41)				
							TOWN DIRECTIONAL TOTALS	124.27 123.4	0.0	1	0	0	27	0	0	12	180.0		0	0.0				FILE NAME: 12C118					
VERMONT AGENCY OF TRANSPORTATION																							PROJECT MANAGER: A. GAMBLE			PLOT DATE: 2/13/2013			
																										DRAWN BY: J. KELLY			
																										CHECKED: A. GAMBLE			
																					DESIGNED BY: J. KELLY			SHEET 17 OF 97					
																						READSBORO SB SHEET 2							

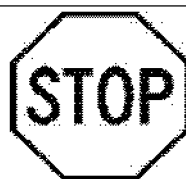DIRECTION	MILEPOINT	LOCATION CODE (SHEET 2)	SIGN CODE	WIDTH (IN)	HEIGHT (IN)	SHEETING REMARKS	SIGN LEGEND	NEW SIGNS		EXISTING SIGNS				EXIST POST		NUMBER OF NEW POSTS	SQUARE STEEL (IN)			TUBULAR STEEL Ø (IN)				SIGN FRAME REQUIRED	REMARKS	SIGN DETAIL LOCATION			
								"A"	"B"	RETAIN	SALVAGE FROM	SALVAGE TO	REMOVE	RETAIN	REMOVE		1.75	2.00	2.50	FOUNDATION	3.00	3.50	4.00			5.00	SHSM	PROJECT SHEET #	STANDARD SHEET #
																	(LB / FT)				(LB / FT)								
																	1.88	2.42	3.35		7.60	9.00	10.80			14.60			
READSBORO VT-8 SB							FY-FLUORESCENT YELLOW FYG-FLUORESCENT YELLOW GREEN															"SHSM"-STANDARD HIGHWAY SIGNS AND MARKINGS							
		F	VD1-1A	72	12		Stamford 8 	6.00																	9				
		F	VD1-1A	72	12		N. Adams MA 12 	6.00																	9				
SB	0.073	G	VR-017	24	30								1	X										OLD COUNTY LN (TH-31)					
		C	VR-017	24	30			5.00																	6				
SB	0.067	A	D3-1	UNK	UNK								~~4~~		X									SIGN NOT FOUND IN FIELD OLD COUNTY LN (TH-31)					
		A	D3-1	54	12		Old County Ln	4.50								2	13'-11" X 14'-9"							FIELD LOCATE AS TO NOT BLOCK ANY OTHER SIGNAGE.		11			
SB	0.067	G	VD-700	6	10								1											OLD COUNTY LN (TH-31)					
		G	VD-700	6	10		 0080 0209 0007	0.42 6.25																	INSTALL ON EXISTING FLANGED CHANNEL SIGN POST.	X			
SB	0.048	F	M3-1	24	12		ROUTE MARKER ASSEMBLY						1	X										RETAIN POSTS, FRAME AND FOUNDATIONS.					
		F	M1-5	30	24								1																
		F	M6-1	21	15								~~4~~											SIGN NOT FOUND IN FIELD					
		F	M3-3	24	12								1																
		F	M1-5	24	24								1																
		F	M6-1	21	15								1																
		F	M3-3	24	12								1																
SIGN SUMMARY SHEET							SHEET TOTALS	28.17 27.75	0.00	0	0	0	9 ~~10~~	0	0	2	30.0			0	0.0	0.0	0.0	0.0	PROJECT NAME: STATEWIDE SOUTHWEST REGION PROJECT NUMBER: STPG SIGN(41)				
							SF	SF	EA	EA	EA	EA	EA	EA	EA	EA	FT		EA	LB	LB	LB	LB	FILE NAME: 12C118 PROJECT MANAGER: A. GAMBLE DESIGNED BY: J. KELLY READSBORO SB SHEET 3			PLOT DATE: 2/13/2013 DRAWN BY: J. KELLY CHECKED: A. GAMBLE SHEET 18 OF 97		
VERMONT AGENCY OF TRANSPORTATION							TOWN DIRECTIONAL TOTALS	124.27 123.4	0.0	1	0	0	27	0	0	12	180.0			0	0.0								

DIRECTION	MILEPOINT	LOCATION CODE (SHEET 2)	SIGN CODE	WIDTH (IN)	HEIGHT (IN)	SHEETING REMARKS	SIGN LEGEND	NEW SIGNS		EXISTING SIGNS				EXIST POST		NUMBER OF NEW POSTS	SQUARE STEEL (IN)			TUBULAR STEEL Ø (IN)					SIGN FRAME REQUIRED	REMARKS	SIGN DETAIL LOCATION		
								"A"	"B"	RETAIN	SALVAGE FROM	SALVAGE TO	REMOVE	RETAIN	REMOVE		1.75	2.00	2.50	FOUNDATION	3.00	3.50	4.00	5.00			SHSM	PROJECT SHEET #	STANDARD SHEET #
																	(LB / FT)				(LB / FT)								
																	1.88	2.42	3.35		7.60	9.00	10.80	14.60					
READSBORO VT-8 SB							FY-FLUORESCENT YELLOW FYG-FLUORESCENT YELLOW GREEN															"SHSM"-STANDARD HIGHWAY SIGNS AND MARKINGS							
		F	M1-5	30	24								1																
		F	M6-1	21	15								1																
		F	M3-1	24	12			2.00																				E-136B	
		F	M1-5	30	24			5.00																				E-136B	
		F	M6-1L	21	15			2.19																				E-136B	
		F	M3-3	24	12			2.00																				E-136B	
		F	M1-5	24	24			4.00																				E-136B	
		F	M6-1R	21	15			2.19																				E-136B	
		F	M3-3	24	12		NORTH SOUTH SOUTH	2.00																					E-136B
		F	M1-5	30	24		VERMONT 100 VERMONT 8 VERMONT 100	5.00																					E-136B
		F	M6-1R	21	15		← → →	2.19																				E-136B	
SB	0.009	E	VD-700	6	10								1																
		F	R1-1	30	30								1		X														
		E	VD-700	6	10		STOP 1000 0209 0219	0.42 6.25										14'-2" X									X		
SIGN SUMMARY SHEET							SHEET TOTALS	33.24 32.82	0.00	0	0	0	4 3	0	0	1	15.0		0	0.0	0.0	0.0	0.0	PROJECT NAME: STATEWIDE SOUTHWEST REGION PROJECT NUMBER: STPG SIGN(41)					
								SF	SF	EA	EA	EA	EA	EA	EA	EA	FT		EA	LB	LB	LB	LB	FILE NAME: 12C118 PROJECT MANAGER: A. GAMBLE DESIGNED BY: J. KELLY READSBORO SB SHEET 4			PLOT DATE: 2/13/2013 DRAWN BY: J. KELLY CHECKED: A. GAMBLE SHEET 19 OF 97		
VERMONT AGENCY OF TRANSPORTATION							TOWN DIRECTIONAL TOTALS	124.27 123.4	0.0	1	0	0	27	0	0	12	180.0		0	0.0									

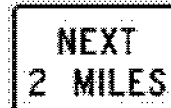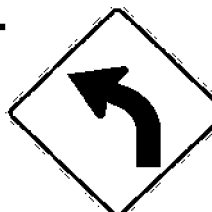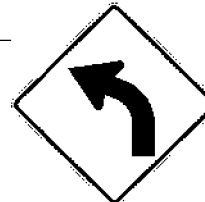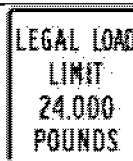
DIRECTION	MILEPOINT	LOCATION CODE (SHEET 2)	SIGN CODE	WIDTH (IN)	HEIGHT (IN)	SHEETING REMARKS	SIGN LEGEND	NEW SIGNS		EXISTING SIGNS				EXIST POST		NUMBER OF NEW POSTS	SQUARE STEEL (IN)			TUBULAR STEEL Ø (IN)				SIGN FRAME REQUIRED	REMARKS	SIGN DETAIL LOCATION			
								"A"	"B"	RETAIN	SALVAGE FROM	SALVAGE TO	REMOVE	RETAIN	REMOVE		1.75	2.00	2.50	FOUNDATION	3.00	3.50	4.00			5.00	SHSM	PROJECT SHEET #	STANDARD SHEET #
																	(LB / FT)				(LB / FT)								
																	1.88	2.42	3.35		7.60	9.00	10.80			14.60			
SEARSBURG VT-8 NB							FY-FLUORESCENT YELLOW FYG-FLUORESCENT YELLOW GREEN															"SHSM"-STANDARD HIGHWAY SIGNS AND MARKINGS							
NB	0.000	C	VD-700 VD-024	6 72	10 10		MILEMARKERS (2) TOWN LINE SIGN ASSEMBLY			2 1				X															
NB	0.200	A	W1-5L	30	30		LEFT WINDING ROAD							1		X													
		A	W7-3A	24	18		NEXT 2 MILES							1															
NB	0.510	A	W1-2L	30	30		LEFT CURVE							1		X													
		A	W13-1	18	18		40 MPH ADVISORY							1															
		A	W1-5L	30	30			6.25									1	15'-0" X							X				
		A	W7-3A	24	18			3.00																	X				
NB	0.560	A	W1-2L	30	30			6.25									1	15'-0" X						INSTALL 265 FEET NORTH OF EXISTING LEFT CURVE SIGN ASSEMBLY.	X				
NB	0.825	A	VW-054R	30	30		HIDDEN DRIVE RIGHT							1		X													
NB	1.140	A	W1-2L	30	30			6.25									1	18'-9" X						INSTALL 50 FEET NORTH OF RIGHT- HAND FIELD ACCESS.	X				
		A	W13-1P	18	18			2.25																	X				
NB	1.645	A	W7-1	30	30		HILL SYMBOL							1		X													
		A	W1-2L	30	30			6.25									1	16'-1" X							X				
NB	1.670	C	VR-017	24	30									4		X								SIGN ASSEMBLY NOT FOUND IN THE FIELD HAGER LN (TH-5)					
		C	VR-017	24	30			5.00									1	14'-0" X								6			
SIGN SUMMARY SHEET							SHEET TOTALS	35.25	0.00	~~3~~ 1	0	0	~~6~~ 7	0	0	5	75.0			0	0.0	0.0	0.0	0.0	PROJECT NAME: STATEWIDE SOUTHWEST REGION				
								SF	SF	EA	EA	EA	EA	EA	EA	EA		FT		EA	LB	LB	LB	LB	PROJECT NUMBER: STPG SIGN(41)				
																												FILE NAME: 12C118	
VERMONT AGENCY OF TRANSPORTATION							TOWN DIRECTIONAL TOTALS	158.57 151.9	0.0	~~3~~ 1	0	0	~~37~~ 32	0	0	~~23~~ 22	345.0 330.0			0	0.0				PROJECT MANAGER: A. GAMBLE				
																											PLOT DATE: 2/13/2013		
																											DRAWN BY: J. KELLY		
																							DESIGNED BY: J. KELLY						
																							CHECKED A. GAMBLE						
																							SHEET 20 OF 97						




DIRECTION	MILEPOINT	LOCATION CODE (SHEET 2)	SIGN CODE	WIDTH (IN)	HEIGHT (IN)	SHEETING REMARKS	SIGN LEGEND	NEW SIGNS		EXISTING SIGNS				EXIST POST		NUMBER OF NEW POSTS	SQUARE STEEL (IN)			TUBULAR STEEL Ø (IN)					SIGN FRAME REQUIRED	REMARKS	SIGN DETAIL LOCATION		
								"A"	"B"	RETAIN	SALVAGE FROM	SALVAGE TO	REMOVE	RETAIN	REMOVE		1.75	2.00	2.50	FOUNDATION	3.00	3.50	4.00	5.00			SHSM	PROJECT SHEET #	STANDARD SHEET #
																	(LB / FT)				(LB / FT)								
																	1.88	2.42	3.35		7.60	9.00	10.80	14.60					
SEARSBURG VT-8 NB							FY-FLUORESCENT YELLOW FYG-FLUORESCENT YELLOW GREEN															"SHSM"-STANDARD HIGHWAY SIGNS AND MARKINGS							
NB	1.675	A	D3-1	UNK	UNK		Hager Ln						1		X									HAGER LN (TH-5)					
		A	D3-1	34	12			2.83																INSTALL ABOVE STOP SIGN WITH BRACKET.		11			
		C D	VD-700 R1-1	6 30	10 30								1 1											HAGER LN (TH-5)					
		C D	VD-700 R1-1	6 30	10 30			STOP 0080 0012 0168	0.42 6.25								1	14'-0" X								X			
NB	1.692	A	VW-054L	30	30		HIDDEN DRIVE LEFT	6.25								1	14'-3" X							INSTALL 90 FEET NORTH OF STOP SIGN FOR HAGER LANE AND SOUTH OF UTILITY POLE.		7			
NB	2.000	A	R8-3A	24	24		BEGIN R						1		X														
		A A	R7-201a VR-644P	12 24	6 12								1 1																
		A	R3-9cP	30	12			2.50									1	15'-0" X							X				
		A	R8-3	24	24			4.00																	X				
NB	2.038	A	W1-5L	30	30		LEFT WINDING ROAD						1		X														
		A	W13-1	18	18		35 MPH ADVISORY						1																
NB	2.080	A A	R7-201a R8-3A	12 24	6 30		R						1 1		X														
		A	R8-3	24	30			4.00									1	14'-7" X							X				
NB	2.120	A	W1-2L	30	30		↶	6.25								1	15'-0" X							INSTALL AT NORTHERLY END OF GRAVEL PULL OFF AND 10 FEET SOUTH OF UTILITY POLE WITH GUY WIRES.	X				
NB	2.156	A A	R7-201a R8-3A	12 24	6 24								1 1		X														
SIGN SUMMARY SHEET							SHEET TOTALS	32.50 32.08	0.00	0	0	0	12 8	0	0	5	75.0		0	0.0	0.0	0.0	0.0	PROJECT NAME: STATEWIDE SOUTHWEST REGION					
								SF	SF	EA	EA	EA	EA	EA	EA	EA	FT		EA	LB	LB	LB	LB	PROJECT NUMBER: STPG SIGN(41)					
VERMONT AGENCY OF TRANSPORTATION																								FILE NAME: 12C118					
							TOWN DIRECTIONAL TOTALS	158.57 151.9	0.0	3 1	0	0	37 32	0	0	23 22	345.0 330.0		0	0.0				PROJECT MANAGER: A. GAMBLE					
																								PLOT DATE: 2/13/2013					
																								DRAWN BY: J. KELLY					
																								CHECKED: A. GAMBLE					
																								SEARSBURG NB SHEET 2					
																								SHEET 21 OF 97					

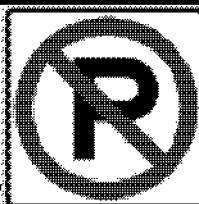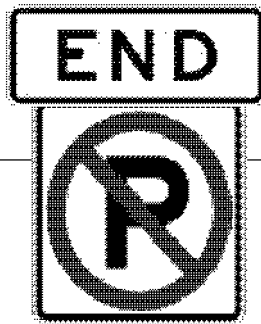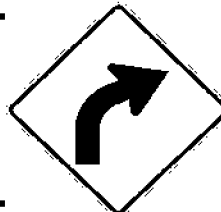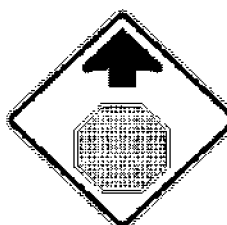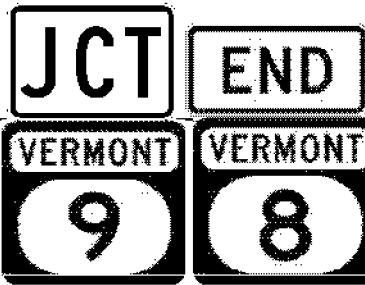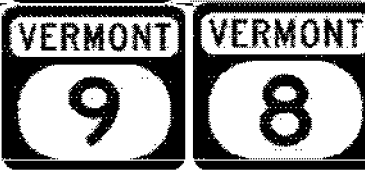
DIRECTION	MILEPOINT	LOCATION CODE (SHEET 2)	SIGN CODE	WIDTH (IN)	HEIGHT (IN)	SHEETING REMARKS	SIGN LEGEND	NEW SIGNS		EXISTING SIGNS				EXIST POST		NUMBER OF NEW POSTS	SQUARE STEEL (IN)			TUBULAR STEEL Ø (IN)					SIGN FRAME REQUIRED	REMARKS	SIGN DETAIL LOCATION		
								"A"	"B"	RETAIN	SALVAGE FROM	SALVAGE TO	REMOVE	RETAIN	REMOVE		1.75	2.00	2.50	FOUNDATION	3.00	3.50	4.00	5.00			SHSM	PROJECT SHEET #	STANDARD SHEET #
																	(LB / FT)				(LB / FT)								
																	1.88	2.42	3.35		7.60	9.00	10.80	14.60					
SEARSBURG VT-8 NB							FY-FLUORESCENT YELLOW FYG-FLUORESCENT YELLOW GREEN															"SHSM"-STANDARD HIGHWAY SIGNS AND MARKINGS							
		A	R8-3	24	24			4.00							1		15'-0" X								X				
NB	2.236	A	R8-3A	24	24								1		X														
		A	R7-201a	12	6								1																
		A	M4-6P	24	12								1																
		A	R3-9dP	30	12			2.50							1		14'-7" X								X				
		A	R8-3	24	24			4.00																	X				
NB	2.270	A	W1-2R	30	30			6.25							1		15'-0" X								INSTALL 180 FEET NORTH OF "END NO PARKING" ASSEMBLY.	X			
NB	2.540	A	W3-1	30	30								1		X														
		A	W3-1	30	30			6.25							1		14'-6" X								X				
NB	2.595	A	M2-1	21	15		ROUTE MARKER SIGN ASSEMBLY.						1		X														
		A	M1-5	24	24								1																
		A	M4-6	24	12								1																
		A	M1-5	24	24								1																
		A	M2-1	21	15			2.19							2		14'-3" X 14'-2"							#1		5	E-136B		
		A	M1-5	24	24			4.00																			E-136B		
		A	M4-6	24	12			2.00																			E-136B		
SIGN SUMMARY SHEET							SHEET TOTALS	31.19	0.00	0	0	0	87	0	0	6	90.0			0	0.0	0.0	0.0	0.0	PROJECT NAME: STATEWIDE SOUTHWEST REGION				
								SF	SF	EA	EA	EA	EA	EA	EA	EA		FT		EA	LB	LB	LB	LB	PROJECT NUMBER: STPG SIGN(41)				
																								FILE NAME: 12C118					
VERMONT AGENCY OF TRANSPORTATION																								PROJECT MANAGER: A. GAMBLE					
							TOWN DIRECTIONAL TOTALS	158.57 151.9	0.0	34	0	0	3732	0	0	2322	345.0 330.0			0	0.0				PLOT DATE: 2/13/2013				
																								DRAWN BY: J. KELLY					
																								CHECKED: A. GAMBLE					
																								DESIGNED BY: J. KELLY					
																								SEARSBURG NB SHEET 3					
																								SHEET 22 OF 97					

DIRECTION	MILEPOINT	LOCATION CODE (SHEET 2)	SIGN CODE	WIDTH (IN)	HEIGHT (IN)	SHEETING REMARKS	SIGN LEGEND	NEW SIGNS		EXISTING SIGNS				EXIST POST		NUMBER OF NEW POSTS	SQUARE STEEL (IN)			TUBULAR STEEL Ø (IN)				SIGN FRAME REQUIRED	REMARKS	SIGN DETAIL LOCATION			
								"A"	"B"	RETAIN	SALVAGE FROM	SALVAGE TO	REMOVE	RETAIN	REMOVE		1.75	2.00	2.50	FOUNDATION	3.00	3.50	4.00			5.00	SHSM	PROJECT SHEET #	STANDARD SHEET #
																	(LB / FT)				(LB / FT)								
																	1.88	2.42	3.35		7.60	9.00	10.80			14.60			
SEARSBURG VT-8 NB							FY-FLUORESCENT YELLOW FYG-FLUORESCENT YELLOW GREEN															"SHSM"-STANDARD HIGHWAY SIGNS AND MARKINGS							
		A	M1-5	24	24			4.00																		E-136B			
NB	2.630	A	D1-1A	72	10		DESTINATION SIGN ASSEMBLY						1		X														
		A	D1-1A	72	10								1																
		A	D1-1A	72	10								1																
		A	VD1-1A	72	12		← Bennington 14	6.00							2			12'-1" X 12'-9"							9				
		A	VD1-1A	72	12		Wilmington 7 →	6.00																	9				
		A	VD1-1A	72	12		Ski Areas →	6.00																	9				
		A	VD1-1A	72	12		Brattleboro 24 →	6.00																	9				
NB	2.655	A	M3-4	24	12		ROUTE MARKER SIGN ASSEMBLY.						1		X														
		A	M1-5	24	24								1																
		A	M6-1	21	15								1																
		A	M3-2	24	12								1																
		A	M1-5	24	24								1																
		A	M6-1	21	15								1																
		A	M3-4	24	12			2.00							2			16'-3" X 16'-9"						#2	SIGNS DETAILED ON SHEET 24	5	E-136B		
SIGN SUMMARY SHEET							SHEET TOTALS		30.00	0.00	0	0	0	9	0	0	4	60.0		0	0.0	0.0	0.0	0.0	PROJECT NAME: STATEWIDE SOUTHWEST REGION				
									SF	SF			EA	EA	EA	EA	EA	EA		FT		EA	LB	LB	LB	LB	PROJECT NUMBER: STPG SIGN(41)		
																											FILE NAME: 12C118		
																											PROJECT MANAGER: A. GAMBLE		
VERMONT AGENCY OF TRANSPORTATION							TOWN DIRECTIONAL TOTALS		158.57 151.9	0.0	3 1	0	0	37 32	0	0	23 22	345.0 330.0		0	0.0				DESIGNED BY: J. KELLY				
																							SEARSBURG NB SHEET 4						
																							PLOT DATE: 2/13/2013						
																							DRAWN BY: J. KELLY						
																							CHECKED A. GAMBLE						
																							SHEET 23 OF 97						

DIRECTION	MILEPOINT	LOCATION CODE (SHEET 2)	SIGN CODE	WIDTH (IN)	HEIGHT (IN)	SHEETING REMARKS	SIGN LEGEND	NEW SIGNS		EXISTING SIGNS				EXIST POST		NUMBER OF NEW POSTS	SQUARE STEEL (IN)			TUBULAR STEEL Ø (IN)				SIGN FRAME REQUIRED	REMARKS	SIGN DETAIL LOCATION			
								"A"	"B"	RETAIN	SALVAGE FROM	SALVAGE TO	REMOVE	RETAIN	REMOVE		1.75	2.00	2.50	FOUNDATION	3.00	3.50	4.00			5.00	SHSM	PROJECT SHEET #	STANDARD SHEET #
																	(LB / FT)				(LB / FT)								
																	1.88	2.42	3.35		7.60	9.00	10.80			14.60			
SEARSBURG VT-8 NB							FY-FLUORESCENT YELLOW FYG-FLUORESCENT YELLOW GREEN															"SHSM"-STANDARD HIGHWAY SIGNS AND MARKINGS							
		A	M1-5	24	24		WEST EAST VERMONT VERMONT 9 9 ← →	4.00																			E-136B		
		A	M6-1L	21	15			2.19																			E-136B		
		A	M3-2	24	12			2.00																			E-136B		
		A	M1-5	24	24			4.00																			E-136B		
		A	M6-1R	21	15			2.19																	POSTS DETAILED ON SHEET 23			E-136B	
NB	2.695	A	R1-1	30	30							1		X															
		A	R1-1	36	36		STOP	9.00							2		12"-10" 12'-11" X								ANCHORS IN LEDGE	X			
NB	2.400	A	W7-1	30	30		HILL SYMBOL					1		X															
		A	W7-1a	30	30			6.25							1		16'-7" X												
SIGN SUMMARY SHEET							SHEET TOTALS	29.63 23.38	0.00	0	0	0	2 1	0	0	3 2		45.0 30.0		0	0.0	0.0	0.0	0.0	PROJECT NAME: STATEWIDE SOUTHWEST REGION PROJECT NUMBER: STPG SIGN(41)				
							SF	SF		EA	EA	EA	EA	EA	EA	EA		FT		EA	LB	LB	LB	LB	FILE NAME: 12C118 PROJECT MANAGER: A. GAMBLE				PLOT DATE: 2/13/2013 DRAWN BY: J. KELLY
VERMONT AGENCY OF TRANSPORTATION																								DESIGNED BY: J. KELLY SEARSBURG NB SHEET 5				CHECKED: A. GAMBLE SHEET 24 OF 97	
TOWN DIRECTIONAL TOTALS							158.57 151.9	0.0		3 1	0	0	37 32	0	0	23 22		345.0 330.0		0	0.0								

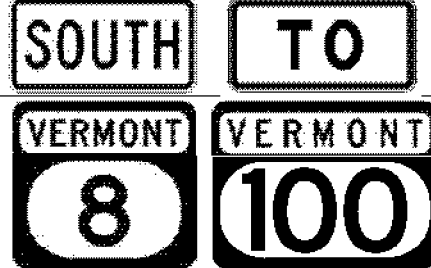DIRECTION	MILEPOINT	LOCATION CODE (SHEET 2)	SIGN CODE	WIDTH (IN)	HEIGHT (IN)	SHEETING REMARKS	SIGN LEGEND	NEW SIGNS		EXISTING SIGNS				EXIST POST		NUMBER OF NEW POSTS	SQUARE STEEL (IN)			TUBULAR STEEL Ø (IN)					SIGN FRAME REQUIRED	REMARKS	SIGN DETAIL LOCATION		
								"A"	"B"	RETAIN	SALVAGE FROM	SALVAGE TO	REMOVE	RETAIN	REMOVE		1.75	2.00	2.50	FOUNDATION	3.00	3.50	4.00	5.00			SHSM	PROJECT SHEET #	STANDARD SHEET #
																	(LB / FT)				(LB / FT)								
																	1.88	2.42	3.35		7.60	9.00	10.80	14.60					
SEARSBURG VT-8 SB							FY-FLUORESCENT YELLOW FYG-FLUORESCENT YELLOW GREEN															"SHSM"-STANDARD HIGHWAY SIGNS AND MARKINGS							
SB	2.695	E	R1-1	36	36			9.00								2	13'-5" 13'-11" X							ANCHORS IN LEDGE INSTALL DIRECTLY ACROSS FROM EXISTING STOP SIGN.	X				
SB	2.685	F	M3-3	24	12			2.00								2	14'-2" 14'-4" X					#1A	INSTALL 10 FEET NORTH OF UTILITY POLE.		5	E-136B			
		F	M1-5	24	24			4.00																		E-136B			
		F	M4-5	24	12			2.00																		E-136B			
		F	M1-5	30	24			5.00																		E-136B			
SB	2.670	F	VR-041	24	24		THROUGH WAY BEGINS HERE						1		X														
		E	VR-040	24	24		THROUGH WAY ENDS HERE						1																
SB	2.635	F	M3-3	24	12		SOUTH						1		X														
		F	M1-5	24	24		VERMONT 8						1																
		F	M4-5	24	12		TO						1																
		F	M1-5	30	24		VERMONT 100						1																
		F	VD2-1	72	12			6.00								2	13'-3" 13'-6" X									8			
		F	VD2-1	72	12			6.00																		8			
SB	2.595	F	VD-700 D2-1	6 72	10 10		MILEMARKER HEARTWELLVILLE 6 						1 1		X														
		F	D2-1	72	10		STAMFORD 12						1																
SIGN SUMMARY SHEET							SHEET TOTALS		34.00	0.00	0	0	0	9 8	0	0	6	90.0			0	0.0	0.0	0.0	0.0	PROJECT NAME: STATEWIDE SOUTHWEST REGION			
									SF	SF	EA	EA	EA	EA	EA	EA	EA	FT		EA	LB	LB	LB	LB	PROJECT NUMBER: STPG SIGN(41)				
																									FILE NAME: 12C118				
VERMONT AGENCY OF TRANSPORTATION																									PROJECT MANAGER: A. GAMBLE				
							TOWN DIRECTIONAL TOTALS		121.5	0.0	0	0	0	29 30	0	0	19	285.0			0	0.0				PLOT DATE: 2/13/2013			
																									DRAWN BY: J. KELLY				
																									CHECKED: A. GAMBLE				
																									DESIGNED BY: J. KELLY				
																									SEARSBURG SB SHEET 1				
																									SHEET 26 OF 97				

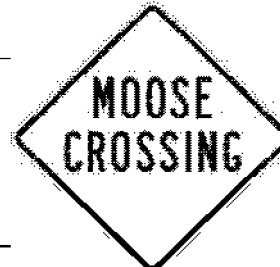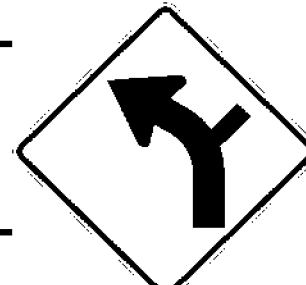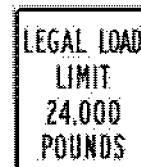DIRECTION	MILEPOINT	LOCATION CODE (SHEET 2)	SIGN CODE	WIDTH (IN)	HEIGHT (IN)	SHEETING REMARKS	SIGN LEGEND	NEW SIGNS		EXISTING SIGNS				EXIST POST		NUMBER OF NEW POSTS	SQUARE STEEL (IN)			TUBULAR STEEL Ø (IN)					SIGN FRAME REQUIRED	REMARKS	SIGN DETAIL LOCATION		
								"A"	"B"	RETAIN	SALVAGE FROM	SALVAGE TO	REMOVE	RETAIN	REMOVE		1.75	2.00	2.50	FOUNDATION	3.00	3.50	4.00	5.00			SHSM	PROJECT SHEET #	STANDARD SHEET #
																	(LB / FT)				(LB / FT)								
																	1.88	2.42	3.35		7.60	9.00	10.80	14.60					
SEARSBURG VT-8 SB							FY-FLUORESCENT YELLOW FYG-FLUORESCENT YELLOW GREEN															"SHSM"-STANDARD HIGHWAY SIGNS AND MARKINGS							
		F	D2-1	72	10		READSBORO 11						1										ANCHORS IN LEDGE						
SB	2.542	F	W1-5L	30	30		WINDING ROAD LEFT						1		X														
		F	W13-1	18	18		35 MPH ADVISORY						1																
SB	2.510	F	W11-21	30	30		MOOSE SYMBOL						1	X															
		F	W7-3A	24	18								1																
		F	VW-000	30	30			6.25															INSTALL NEW SIGNS ON EXISTING FLANGED CHANNEL SIGN POST.		7				
		F	W7-3aP	24	18			3.00																X					
SB	2.335	F	W1-10L	36	36			9.00								2	15'-1" 15'-0" X						INSTALL ON NORTH SIDE OF FIELD DRIVE, APPROX. 235 FT NORTH OF PUTNAM RD.	X					
SB	2.291	G	VR-017	24	30								1		X								PUTNAM RD (TH-2)						
		G	VR-017	24	30			5.00								1	14'-5" X								6				
		F	D3-1	UNK	UNK		PUTNAM RD STREET SIGN						1																
SB	2.282	H	R1-1	30	30								1		X								PUTNAM RD (TH-2)						
		F	D3-1	42	12			3.50															INSTALL STREET SIGN ON TOP OF STOP SIGN USING BRACKET.		11				
		H	R1-1	30	30			6.25								1	13'-0" X							X					
SB	1.800	F	S3-1T	30	30		SCHOOL BUS STOP AHEAD						1		X														
SIGN SUMMARY SHEET							SHEET TOTALS		33.00	0.00	0	0	0	9	0	0	4	60.0			0	0.0	0.0	0.0	0.0	PROJECT NAME: STATEWIDE SOUTHWEST REGION			
									SF	SF	EA	EA	EA	EA	EA	EA	EA		FT		EA	LB	LB	LB	LB	LB	PROJECT NUMBER: STPG SIGN(41)		
																											FILE NAME: 12C118	PLOT DATE: 2/13/2013	
							VERMONT AGENCY OF TRANSPORTATION																					DRAWN BY: J. KELLY	
							TOWN DIRECTIONAL TOTALS		121.5	0.0	0	0	0	29 -30	0	0	19	285.0			0	0.0				DESIGNED BY: J. KELLY		CHECKED: A. GAMBLE	
																							SEARSBURG SB SHEET 2		SHEET 26 OF 97				

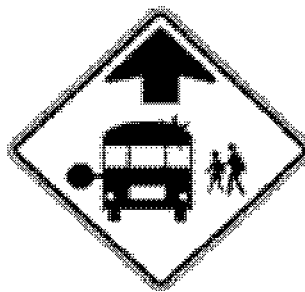DIRECTION	MILEPOINT	LOCATION CODE (SHEET 2)	SIGN CODE	WIDTH (IN)	HEIGHT (IN)	SHEETING REMARKS	SIGN LEGEND	NEW SIGNS		EXISTING SIGNS				EXIST POST		NUMBER OF NEW POSTS	SQUARE STEEL (IN)			TUBULAR STEEL Ø (IN)					SIGN FRAME REQUIRED	REMARKS	SIGN DETAIL LOCATION		
								"A"	"B"	RETAIN	SALVAGE FROM	SALVAGE TO	REMOVE	RETAIN	REMOVE		1.75	2.00	2.50	FOUNDATION	3.00	3.50	4.00	5.00			SHSM	PROJECT SHEET #	STANDARD SHEET #
																	(LB / FT)				(LB / FT)								
																	1.88	2.42	3.35		7.60	9.00	10.80	14.60					
SEARSBURG VT-8 SB							FY-FLUORESCENT YELLOW FYG-FLUORESCENT YELLOW GREEN															"SHSM"-STANDARD HIGHWAY SIGNS AND MARKINGS							
		F	S3-1	36	36	FYG		9.00							2	14'-2" 15'-2" X							ANCHORS IN LEDGE	X					
SB	1.763	F	W1-2MR	30	30		MODIFIED RIGHT CURVE 						1		X								REMOVE ENTIRE SIGN ASSEMBLY.						
SB	1.730	F	W1-10R	36	36			9.00							2	17'-7" 16'-7" X							INSTALL 175 FEET SOUTH OF EXISTING RIGHT CURVE SIGN ASSEMBLY.	X					
SB	1.315	F	W1-2R	30	30		RIGHT CURVE						1		X														
		F	W13-1	18	18		35 MPH ADVISORY						1																
SB	1.253	F	W1-2R	30	30			6.25							1	13'-0" X							INSTALL 325 FEET SOUTH OF EXISTING RIGHT CURVE SIGN ASSEMBLY.	X					
		F	W13-1P	18	18			2.25																X					
SB	1.070	F	VW-054L	30	30		HIDDEN DRIVE LEFT						1		X														
SB	1.005	F	W1-2L	30	30		LEFT CURVE						4		X								SIGN ASSEMBLY NOT FOUND IN THE FIELD						
		F	W13-1	18	18		40 MPH ADVISORY						4																
SB	0.338	F	W1-4R	30	30		RIGHT REVERSE CURVE						1		X														
		F	W13-1	18	18		35 MPH ADVISORY						1																
SB	0.300	F	W2-2L	30	30		SIDE ROAD LEFT						1		X														
		F	W13-1	18	18		35 MPH ADVISORY						1																
SB	0.270	F	VW-133L	30	30			6.25							1	14'-10" X							INSTALL 160 FEET SOUTH OF EXISTING SIDE ROAD LEFT ASSEMBLY.		7				
SIGN SUMMARY SHEET							SHEET TOTALS	32.75	0.00	0	0	0	8 10	0	0	6	90.0			0	0.0	0.0	0.0	0.0	PROJECT NAME: STATEWIDE SOUTHWEST REGION				
								SF	SF	EA	EA	EA	EA	EA	EA	EA		FT		EA	LB	LB	LB	LB	PROJECT NUMBER: STPG SIGN(41)				
																									FILE NAME: 12C118				
							VERMONT AGENCY OF TRANSPORTATION																			PROJECT MANAGER: A. GAMBLE			
TOWN DIRECTIONAL TOTALS																							DESIGNED BY: J. KELLY						
							121.5	0.0	0	0	0	29 30	0	0	19	285.0			0	0.0				PLOT DATE: 2/13/2013					
																							DRAWN BY: J. KELLY						
																							CHECKED: A. GAMBLE						
																							SHEET 27 OF 97						
																							SEARSBURG SB SHEET 3						





DIRECTION	MILEPOINT	LOCATION CODE (SHEET 2)	SIGN CODE	WIDTH (IN)	HEIGHT (IN)	SHEETING REMARKS	SIGN LEGEND	NEW SIGNS		EXISTING SIGNS				EXIST POST		NUMBER OF NEW POSTS	SQUARE STEEL (IN)			TUBULAR STEEL Ø (IN)				SIGN FRAME REQUIRED	REMARKS	SIGN DETAIL LOCATION						
								"A"	"B"	RETAIN	SALVAGE FROM	SALVAGE TO	REMOVE	RETAIN	REMOVE		1.75	2.00	2.50	FOUNDATION	3.00	3.50	4.00			5.00	SHSM	PROJECT SHEET #	STANDARD SHEET #			
																	(LB / FT)				(LB / FT)											
																	1.88	2.42	3.35		7.60	9.00	10.80			14.60						
SEARSBURG VT-8 SB							FY-FLUORESCENT YELLOW FYG-FLUORESCENT YELLOW GREEN															"SHSM"-STANDARD HIGHWAY SIGNS AND MARKINGS										
SB	0.232	F	W1-4R	30	30			6.25							1	14'-4" X							INSTALL 660 FEET SOUTH OF EXISTING RIGHT REVERSE CURVE SIGN ASSEMBLY.	X								
SB	0.200	F	W7-1	30	30		HILL SYMBOL					1		X																		
SB	0.095	F	W1-4R	30	30		RIGHT REVERSE CURVE					1		X																		
		F	W13-1	18	18		35 MPH ADVISORY					1																				
		F	W7-1a	30	30			6.25							1	18'-3" X								X								
		F	W7-3aP	24	18		 	3.00																X								
SB	0.010	F	W1-4R	30	30		 	6.25							1	15'-0" X							INSTALL 50 FEET NORTH OF AND ACROSS FROM TOWN LINE SIGN.	X								
SIGN SUMMARY SHEET							SHEET TOTALS		21.75	0.00	0	0	0	3	0	0	3	45.0			0	0.0	0.0	0.0	0.0	PROJECT NAME: STATEWIDE SOUTHWEST REGION PROJECT NUMBER: STPG SIGN(41)						
									SF	SF	EA	EA	EA	EA	EA	EA	EA		FT		EA	LB	LB	LB	LB	FILE NAME: 12C118 PROJECT MANAGER: A. GAMBLE DESIGNED BY: J. KELLY SEARSBURG SB SHEET 4			PLOT DATE: 2/13/2013 DRAWN BY: J. KELLY CHECKED: A. GAMBLE SHEET 28 OF 97			
							TOWN DIRECTIONAL TOTALS		121.5	0.0	0	0	0	29 30	0	0	19	285.0			0	0.0										


DIRECTION	MILEPOINT	LOCATION CODE (SHEET 2)	SIGN CODE	WIDTH (IN)	HEIGHT (IN)	SHEETING REMARKS	SIGN LEGEND	NEW SIGNS		EXISTING SIGNS				EXIST POST		NUMBER OF NEW POSTS	SQUARE STEEL (IN)			TUBULAR STEEL Ø (IN)					SIGN FRAME REQUIRED	REMARKS	SIGN DETAIL LOCATION		
								"A"	"B"	RETAIN	SALVAGE FROM	SALVAGE TO	REMOVE	RETAIN	REMOVE		1.75	2.00	2.50	FOUNDATION	3.00	3.50	4.00	5.00			SHSM	PROJECT SHEET #	STANDARD SHEET #
																	(LB / FT)				(LB / FT)								
																	1.88	2.42	3.35		7.60	9.00	10.80	14.60					
JAMAICA VT-30 NB							FY-FLUORESCENT YELLOW FYG-FLUORESCENT YELLOW GREEN																"SHSM"-STANDARD HIGHWAY SIGNS AND MARKINGS						
NB	0.000	C	VD-700 VD-024	60	10 7.5		MILEMARKERS (2) Jamaica Townshend 0300 1309 0000 0300 1317 0736						2		X														
		C	VD-024	72	10			5.00									12'-6" 13'-1" X										4, 8		
		C	VD-700	6	10			0.42																INSTALL BELOW JAMAICA ON LH POST.				E-138	
		C	VD-700	6	10			0.42																INSTALL BELOW TOWNSHEND ON RH POST.				E-138	
NB	0.175	A	VW-202	30	30								1	X															
		A	VW-202	30	30		TRUCKS ENTERING	6.25																	INSTALL ON EXISTING FLANGED CHANNEL SIGN POST.			7	
NB	0.600	A	M2-1	21	15		JCT			1				X															
		A	M1-5	30	24		VERMONT ROUTE 100			1																			
NB	0.622	A	D1-1A	72	10		DESTINATION SIGN ASSEMBLY			1				X															
		A	D1-1S	72	10					1																			
		A	D1-1A	72	10					1																			
		A	D1-1A	72	10					1																			
NB	0.662	A	M3-3	24	12		ROUTE MARKER ASSEMBLY			1				X															
		A	M1-5	30	24					1																			
		A	M6-1	21	15					1																			
SIGN SUMMARY SHEET							SHEET TOTALS		12.09	0.00	9	0	0	~~4~~ ~~-2~~	0	0	2	30.0			0	0.0	0.0	0.0	0.0	PROJECT NAME: STATEWIDE SOUTHWEST REGION			
									SF	SF		EA	EA	EA	EA	EA	EA		FT		EA	LB	LB	LB	LB	PROJECT NUMBER: STPG SIGN(41)			
																											FILE NAME: 12C118		
																											PROJECT MANAGER: A. GAMBLE		
VERMONT AGENCY OF TRANSPORTATION							TOWN DIRECTIONAL TOTALS		~~438.5~~ 443.5	0.0	~~32~~ 29	~~2~~ -1	~~2~~ -1	~~88~~ -78	0	0	~~63~~ 62	~~945.0~~ 930.0			0	0.0				PLOT DATE: 2/13/2013			
																										DRAWN BY: J. KELLY			
																							DESIGNED BY: J. KELLY						
																							CHECKED A. GAMBLE						
																							JAMAICA NB SHEET 1						
																							SHEET 29 OF 97						



DIRECTION	MILEPOINT	LOCATION CODE (SHEET 2)	SIGN CODE	WIDTH (IN)	HEIGHT (IN)	SHEETING REMARKS	SIGN LEGEND	NEW SIGNS		EXISTING SIGNS				EXIST POST		NUMBER OF NEW POSTS	SQUARE STEEL (IN)			TUBULAR STEEL Ø (IN)				SIGN FRAME REQUIRED	REMARKS	SIGN DETAIL LOCATION			
								"A"	"B"	RETAIN	SALVAGE FROM	SALVAGE TO	REMOVE	RETAIN	REMOVE		1.75	2.00	2.50	FOUNDATION	3.00	3.50	4.00			5.00	SHSM	PROJECT SHEET #	STANDARD SHEET #
																	(LB / FT)				(LB / FT)								
																	1.88	2.42	3.35		7.60	9.00	10.80			14.60			
JAMAICA VT-30 NB							FY-FLUORESCENT YELLOW FYG-FLUORESCENT YELLOW GREEN															"SHSM"-STANDARD HIGHWAY SIGNS AND MARKINGS							
		A	M3-1	24	12					1																			
		A	M1-5	24	24					1																			
		A	M6-3	21	15					1																			
		A	M3-1	24	12					1																			
		A	M1-5	30	24					1																			
		A	M6-3	21	15					1																			
NB	0.675	C	W1-7	48	24		DOUBLE ARROW			1				X															
NB	0.700	A	M3-1	24	12		ROUTE MARKER ASSEMBLY			1				X															
		A	M1-5	24	24					1																			
		A	M3-1	24	12					1																			
		A	M1-5	30	24					1																			
NB	0.740	A	D2-1	72	10		DESTINATION SIGN ASSEMBLY			1				X															
		A	D1-1S	72	10					1																			
NB	0.773	A	R2-1	24	30								1	X															
		A	R2-1	24	30			~~5.00~~ ~~6.25~~																INSTALL ON EXISTING FLANGED CHANNEL SIGN POST.	X				
SIGN SUMMARY SHEET							SHEET TOTALS	~~5.00~~ ~~6.25~~	0.00	13	0	0	1	0	0	0	0.0			0	0.0	0.0	0.0	0.0	PROJECT NAME: STATEWIDE SOUTHWEST REGION				
								SF	SF	EA	EA	EA	EA	EA	EA	EA		FT		EA	LB	LB	LB	LB	PROJECT NUMBER: STPG SIGN(41)				
							VERMONT AGENCY OF TRANSPORTATION																			FILE NAME: 12C118			PLOT DATE: 2/13/2013
TOWN DIRECTIONAL TOTALS							~~438.5~~ ~~443.5~~	0.0	~~32~~ ~~29~~	~~2~~ ~~1~~	~~2~~ ~~1~~	~~88~~ ~~78~~	0	0	~~63~~ ~~62~~	~~945.0~~ ~~930.0~~			0	0.0				PROJECT MANAGER: A. GAMBLE			DRAWN BY: J. KELLY		
																									DESIGNED BY: J. KELLY			CHECKED A. GAMBLE	
																						JAMAICA NB SHEET 2			SHEET 30 OF 97				




DIRECTION	MILEPOINT	LOCATION CODE (SHEET 2)	SIGN CODE	WIDTH (IN)	HEIGHT (IN)	SHEETING REMARKS	SIGN LEGEND	NEW SIGNS		EXISTING SIGNS				EXIST POST		NUMBER OF NEW POSTS	SQUARE STEEL (IN)			TUBULAR STEEL Ø (IN)					SIGN FRAME REQUIRED	REMARKS	SIGN DETAIL LOCATION		
								"A"	"B"	RETAIN	SALVAGE FROM	SALVAGE TO	REMOVE	RETAIN	REMOVE		1.75	2.00	2.50	FOUNDATION	3.00	3.50	4.00	5.00			SHSM	PROJECT SHEET #	STANDARD SHEET #
																	(LB / FT)				(LB / FT)								
																	1.88	2.42	3.35		7.60	9.00	10.80	14.60					
JAMAICA VT-30 NB							FY-FLUORESCENT YELLOW FYG-FLUORESCENT YELLOW GREEN																"SHSM"-STANDARD HIGHWAY SIGNS AND MARKINGS						
NB	0.982	A	D3-1	68	12		Turkey Mtn Rd J20	5.67							2		12'-1" 11'-8" X							INSTALL BEHIND GUARDRAIL AT SOUTH SIDE OF INTERSECTION.		11			
NB	0.984	C	VR-017	24	30								1	X	X									TURKEY MTN RD (TH-20)					
		C	VR-017	24	30		LEGAL LOAD LIMIT 24,000 POUNDS	5.00							1		13'-4" X							INSTALL ON EXISTING FLANGED CHANNEL SIGN POST.		6			
NB	0.990	A	D3-1	UNK	UNK		TURKEY MTN RD STREET SIGN						1											TURKEY MTN RD (TH-20)					
		C	VD-700	6	10		MILEMARKER SALVAGED FROM				1																		
		D	R1-1	30	30							1	X	X															
		C	VD-700	6	10		STOP 0300 1309 0099 MILE MARER SALVAGED FROM	6.25				1			1		13'-6" X							INSTALL ON EXISTING FLANGED CHANNEL SIGN POST.	X				
NB	1.380	A	S3-1T	30	30		SCHOOL BUS STOP AHEAD						1		X														
		A	S3-1	36	36	FYG		9.00							2		13'-4" 13'-5" X								X				
NB	1.562	C	VR-017	24	30								1	X										HOWE FARM RD (TH-22)					
		C	VR-017	24	30		LEGAL LOAD LIMIT 24,000 POUNDS	5.00																INSTALL ON EXISTING FLANGED CHANNEL SIGN POST.		6			
NB	1.568	C	VD-700	6	10		0300 1306 0157				1													HOWE FARM RD (TH-22)					
		D	R1-1	30	30		STOP	6.25					1	X										INSTALL ON EXISTING FLANGED CHANNEL SIGN POST.	X				
NB	1.571	A	D3-1	UNK	UNK								1		X									HOWE FARM RD (TH-22)					
		A	D3-1	64	12		Howe Farm Rd J22	5.33							2		13'-9" 13'-0" X							INSTALL ON TWO POSTS AT EXISTING LOCATION.		11			
NB	1.894	C	VR-017	24	30								1	X										GILFEATHER LA (TH-21)					
SIGN SUMMARY SHEET							SHEET TOTALS		42.50	0.00	10	10	10	8	0	0	86	120.0 90.0	0	0.0	0.0	0.0	0.0	PROJECT NAME: STATEWIDE SOUTHWEST REGION					
									SF	SF	EA	EA	EA	EA	EA	EA	EA	FT	EA	LB	LB	LB	LB	PROJECT NUMBER: STPG SIGN(41)					
																								FILE NAME: 12C118					
																									PROJECT MANAGER: A. GAMBLE				
VERMONT AGENCY OF TRANSPORTATION							TOWN DIRECTIONAL TOTALS		438.5 443.5	0.0	3229	21	21	8878	0	0	6362	945.0 930.0	0	0.0				PLOT DATE: 2/13/2013					
																								DRAWN BY: J. KELLY					
																							CHECKED: A. GAMBLE						
																							JAMAICA NB SHEET 3						
																							SHEET 31 OF 97						



DIRECTION	MILEPOINT	LOCATION CODE (SHEET 2)	SIGN CODE	WIDTH (IN)	HEIGHT (IN)	SHEETING REMARKS	SIGN LEGEND	NEW SIGNS		EXISTING SIGNS				EXIST POST		NUMBER OF NEW POSTS	SQUARE STEEL (IN)			TUBULAR STEEL Ø (IN)				SIGN FRAME REQUIRED	REMARKS	SIGN DETAIL LOCATION			
								"A"	"B"	RETAIN	SALVAGE FROM	SALVAGE TO	REMOVE	RETAIN	REMOVE		1.75	2.00	2.50	FOUNDATION	3.00	3.50	4.00			5.00	SHSM	PROJECT SHEET #	STANDARD SHEET #
																	(LB / FT)				(LB / FT)								
																	1.88	2.42	3.35		7.60	9.00	10.80			14.60			
JAMAICA VT-30 NB							FY-FLUORESCENT YELLOW FYG-FLUORESCENT YELLOW GREEN																"SHSM"-STANDARD HIGHWAY SIGNS AND MARKINGS						
		C	VR-017	24	30			5.00																INSTALL ON EXISTING FLANGED CHANNEL SIGN POST.		6			
NB	1.904	C D	VD-700 R1-1	6 30	10 30					1			1	X										GILFEATHER LA (TH-21)					
		D	R1-1	30	30			6.25																INSTALL ON EXISTING FLANGED CHANNEL SIGN POST.	X				
NB	1.905	A	D3-1	UNK	UNK								1											GILFEATHER LA (TH-21)					
		A	D3-1	62	12			5.17							2	14'-0" 13'-4" X								INSTALL ON TWO POSTS AT EXISTING LOCATION.		11			
NB	1.949	A	VW-619	30	30		SHOULDER NARROWS						1		X														
NB	2.039	A	VW-619	36	36			9.00								2	13'-9" 13'-11" X							INSTALL 475 FEET NORTH OF EXISTING, AT SOUTH SIDE OF POLE AND BEFORE END OF RAIL. ANCHORS IN LEDGE		7			
NB	2.646	A	VW-054R	30	30		HIDDEN DRIVE RIGHT			1				X										RELOCATE SIGN 240 FT NORTH TO MP 2.691					
NB	2.691	A	VW-054R	30	30		HIDDEN DRIVE RIGHT				1				4	X								RELOCATE SIGN FROM MP 2.646 AND INSTALL AT NORTH END OF SMALL PULL OFF. POST SALVAGED					
NB	3.139	A	W3-5	36	36		SPEED REDUCTION (40)						1		X														
NB	3.243	A	VD-018	30	18		JAMAICA RAWSONVILLE 5 VILLAGE SIGN.						1		X														
		A	W3-5	36	36			9.00								2	13'-7" 13'-4" X									X			
NB	3.310	A	R2-1	24	30								1		X														
		A	R2-1	30	36			7.50								1	14'-4" X									X			
NB	3.364	A	D3-1	UNK	UNK								1											MEADOWS RD (TH-64)					
SIGN SUMMARY SHEET							SHEET TOTALS		41.92	0.00	1 0	1	1 6	7	0	0	8	120.0			0	0.0	0.0	0.0	0.0	PROJECT NAME: STATEWIDE SOUTHWEST REGION			
									SF	SF	EA	EA	EA	EA	EA	EA		FT		EA	LB	LB	LB	LB	PROJECT NUMBER: STPG SIGN(41)				
																									FILE NAME: 12C118			PLOT DATE: 2/13/2013	
VERMONT AGENCY OF TRANSPORTATION																								PROJECT MANAGER: A. GAMBLE			DRAWN BY: J. KELLY		
							TOWN DIRECTIONAL TOTALS		438.5 443.5	0.0	32 29	2 1	2 1	88 78	0	0	63 62	945.0 930.0			0	0.0				DESIGNED BY: J. KELLY			CHECKED: A. GAMBLE
																							JAMAICA NB SHEET 4			SHEET 32 OF 97			

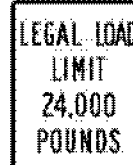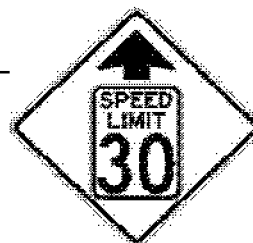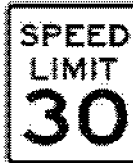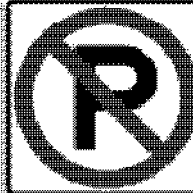DIRECTION	MILEPOINT	LOCATION CODE (SHEET 2)	SIGN CODE	WIDTH (IN)	HEIGHT (IN)	SHEETING REMARKS	SIGN LEGEND	NEW SIGNS		EXISTING SIGNS				EXIST POST		NUMBER OF NEW POSTS	SQUARE STEEL (IN)			TUBULAR STEEL Ø (IN)					SIGN FRAME REQUIRED	REMARKS	SIGN DETAIL LOCATION		
								"A"	"B"	RETAIN	SALVAGE FROM	SALVAGE TO	REMOVE	RETAIN	REMOVE		1.75	2.00	2.50	FOUNDATION	3.00	3.50	4.00	5.00			SHSM	PROJECT SHEET #	STANDARD SHEET #
																	(LB / FT)				(LB / FT)								
																	1.88	2.42	3.35		7.60	9.00	10.80	14.60					
JAMAICA VT-30 NB							FY-FLUORESCENT YELLOW FYG-FLUORESCENT YELLOW GREEN																"SHSM"-STANDARD HIGHWAY SIGNS AND MARKINGS						
		C	VR-017	24	30																			MEADOWS RD (TH-64)					
		C	VR-017	24	30			5.00								1		13'-7" X							INSTALL ON EXISTING FLANGED CHANNEL SIGN POST.		6		
		A	D3-1	58	12			4.83								2		13'-0" 14'-6" X							FIELD LOCATE AS TO NOT BLOCK OTHER SIGNAGE.		11		
NB	3.370	D	R1-1	30	30											1	X							MEADOWS RD (TH-64)					
		D	R1-1	30	30			6.25																		X			
NB	3.480	A	W3-5	36	36																								
		A	W3-5	36	36			9.00								2		13'-11" 13'-9" X								X			
NB	3.532	A	VD-018	30	18			3.75								1		12'-0" X							INSTALL 275 FEET NORTH OF SPEED REDUCTION (30) SIGN ASSEMBLY.		5		
NB	3.592 3.590	A	R2-1	24	30																								
		A	R2-1	30	36			7.50								1		X							INSTALLED AS EXISTING USED EXISTING ANCHOR INSTALL ON LEFT AS EXISTING.	X			
NB	3.594 3.590	A	R7-2S	24	36		NO PARKING 12AM TO 6 AM, NOV 1 -APR 1																						
		A	VR-644P	24	12																								
		A	R3-9cP	30	12			2.50								1		X							INSTALL ON RIGHT SIDE OF SPEED LIMIT 30 SIGN.	X			
		A	R8-3	24	24			4.00																	INSTALLED AS EXISTING USED EXISTING ANCHOR	X			
		A	VR-122	24	12			2.00																			6		
SIGN SUMMARY SHEET							SHEET TOTALS	44.83	0.00	0	0	0	6	0	0	8 7		120.0 105.0		0	0.0	0.0	0.0	0.0	PROJECT NAME: STATEWIDE SOUTHWEST REGION	PROJECT NUMBER: STPG SIGN(41)			
								SF	SF	EA	EA	EA	EA	EA	EA	EA		FT		EA	LB	LB	LB	LB	FILE NAME: 12C118	PLOT DATE: 2/13/2013			
																									PROJECT MANAGER: A. GAMBLE	DRAWN BY: J. KELLY			
VERMONT AGENCY OF TRANSPORTATION							TOWN DIRECTIONAL TOTALS	438.5 443.5	0.0	32 29	2 1	2 1	88 78	0	0	63 62		945.0 930.0		0	0.0				DESIGNED BY: J. KELLY	CHECKED: A. GAMBLE			
																							JAMAICA NB SHEET 5	SHEET 33 OF 97					

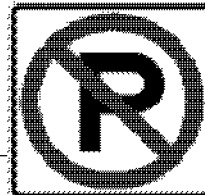DIRECTION	MILEPOINT	LOCATION CODE (SHEET 2)	SIGN CODE	WIDTH (IN)	HEIGHT (IN)	SHEETING REMARKS	SIGN LEGEND	NEW SIGNS		EXISTING SIGNS				EXIST POST		NUMBER OF NEW POSTS	SQUARE STEEL (IN)			TUBULAR STEEL Ø (IN)					SIGN FRAME REQUIRED	REMARKS	SIGN DETAIL LOCATION			
								"A"	"B"	RETAIN	SALVAGE FROM	SALVAGE TO	REMOVE	RETAIN	REMOVE		1.75	2.00	2.50	FOUNDATION	3.00	3.50	4.00	5.00			SHSM	PROJECT SHEET #	STANDARD SHEET #	
																	(LB / FT)				(LB / FT)									
																	1.88	2.42	3.35		7.60	9.00	10.80	14.60						
JAMAICA VT-30 NB							FY-FLUORESCENT YELLOW FYG-FLUORESCENT YELLOW GREEN																"SHSM"-STANDARD HIGHWAY SIGNS AND MARKINGS							
NB	3.732	A	VD-062BRN	72	16		BUSINESS SIGN			1				X																
NB	3.606 3.658	A	W11-2	30	30	FYG		6.25							1	13'-11" X								INSTALL BETWEEN GRANITE POSTS BETWEEN #3632 & #3606.	X					
		A	W16-9P	24	12	FYG		2.00																	X					
NB	3.785	C	VR-017	24	30								1	X										DEPOT ST (TH-19)						
		C	VR-017	24	30			5.00																INSTALL ON EXISTING POST.		6				
NB	3.787	D	R1-1	30	30								1		X									DEPOT ST (TH-19)						
		D	R1-1	30	30			6.25								1	9'-6" X							USED EXISTING ANCHOR INSTALL IN ISLAND.	X					
NB	3.787	D	D3-1	UNK	UNK		STREET NAME SIGN.						1		X									LOCATED IN ISLAND.						
		D	D3-1	44	12			3.67								2	11'-9" 11'-9" X							INSTALL IN ISLAND. DO NOT BLOCK STOP SIGN.		11				
NB	3.795	D	R1-1	30	30					1			+		X									DEPOT ST (TH-19)						
		D	R1-1	30	30			6.25								+	X								X					
NB	3.810	A	R2-1	24	30			5.00								+	X							INSTALL NEAR DROP INLET AT TANGENT OF SLIP-LANE. ON EXISTING POST	X					
NB	3.810	A	R8-3	24	24			4.00								+	X							INSTALL ASSEMBLY UNDERNEATH. INSTALL TO RIGHT OF SPEED LIMIT 30 SIGN-ASSEMBLY.	X					
		A	VR-122	24	12			2.00																SPEED LIMIT 30 SIGN ON SAME POST		6				
NB	3.853	C	VR-017	24	24								1	X										FACTORY ST (TH-50)						
SIGN SUMMARY SHEET							SHEET TOTALS		34.17 40.42	0.00	2 +	0	0	4 5	0	0	4 7	60.0 105.0		0	0.0	0.0	0.0	0.0	PROJECT NAME: STATEWIDE SOUTHWEST REGION					
									SF	SF	EA	EA	EA	EA	EA	EA	EA	FT		EA	LB	LB	LB	LB	PROJECT NUMBER: STPG SIGN(41)					
																									FILE NAME: 12C118			PLOT DATE: 2/13/2013		
																										PROJECT MANAGER: A. GAMBLE			DRAWN BY: J. KELLY	
VERMONT AGENCY OF TRANSPORTATION							TOWN DIRECTIONAL TOTALS		438.5 443.5	0.0	32 29	2 +	2 +	88 78	0	0	63 62	945.0 930.0	0	0.0				DESIGNED BY: J. KELLY			CHECKED: A. GAMBLE			
																			0	0.0				JAMAICA NB SHEET 6			SHEET 34 OF 97			

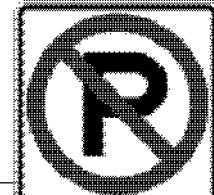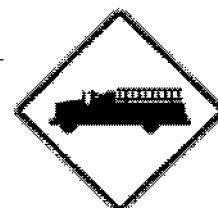DIRECTION	MILEPOINT	LOCATION CODE (SHEET 2)	SIGN CODE	WIDTH (IN)	HEIGHT (IN)	SHEETING REMARKS	SIGN LEGEND	NEW SIGNS		EXISTING SIGNS				EXIST POST		NUMBER OF NEW POSTS	SQUARE STEEL (IN)			TUBULAR STEEL Ø (IN)				SIGN FRAME REQUIRED	REMARKS	SIGN DETAIL LOCATION			
								"A"	"B"	RETAIN	SALVAGE FROM	SALVAGE TO	REMOVE	RETAIN	REMOVE		1.75	2.00	2.50	FOUNDATION	3.00	3.50	4.00			5.00	SHSM	PROJECT SHEET #	STANDARD SHEET #
																	(LB / FT)				(LB / FT)								
																	1.88	2.42	3.35		7.60	9.00	10.80			14.60			
JAMAICA VT-30 NB							FY-FLUORESCENT YELLOW FYG-FLUORESCENT YELLOW GREEN															"SHSM"-STANDARD HIGHWAY SIGNS AND MARKINGS							
		C	VR-017	24	30			5.00																	6				
NB	3.859	A	W11-2	30	30	FYG	PEDESTRIAN AHEAD ADVANCE WARNING SIGN			1				X															
		A	W16-7	24	12	FYG	DOWNWARD ARROW			1																			
NB	3.859	A	D3-1	UNK	UNK							1		X															
		A	D3-1	52	12			4.33							2		11'-0" 11'-5" X							FIELD LOCATE AS TO NOT BLOCK OTHER SIGNAGE.		11			
NB	3.859	C D	VD-700 R1-1	6 30	10 30							1 1	✖ X											FACTORY ST (TH-50)					
		C D	VD-700 R1-1	6 30	10 30		 	0.42 6.25							1		X								X				
NB	3.892	A	R7-2S	24	36		NO PARKING 12AM TO 6 AM, NOV 1 -APR 1					1	X																
		A	R8-3	24	24			4.00																INSTALL ON EXISTING FLANGED CHANNEL SIGN POST.	X				
		A	VR-122	24	12			2.00																		6			
NB	3.915	A	W11-8	30	30							1	X																
		A	W11-8	30	30			6.25																INSTALL ON EXISTING FLANGED CHANNEL SIGN POST.	X				
		SKIP TO NORTH SIDE OF BRIDGE #30																											
NB	4.180	A	R2-1	24	30							1		X															
		A	R2-1	24	30			5.00							1		14'-3" X								X				
SIGN SUMMARY SHEET							SHEET TOTALS	33.25 32.83	0.00	2	0	0	6 5	0	0	4 3		60.0 45.0		0	0.0	0.0	0.0	0.0	PROJECT NAME: STATEWIDE SOUTHWEST REGION				
								SF	SF	EA	EA	EA	EA	EA	EA	EA		FT		EA	LB	LB	LB	LB	PROJECT NUMBER: STPG SIGN(41)				
																												FILE NAME: 12C118	
VERMONT AGENCY OF TRANSPORTATION							TOWN DIRECTIONAL TOTALS	438.5 443.5	0.0	32 29	2 1	2 1	88 78	0	0	63 62		945.0 930.0		0	0.0				PLOT DATE: 2/13/2013				
																											DRAWN BY: J. KELLY		
																											CHECKED: A. GAMBLE		
																							DESIGNED BY: J. KELLY						
																							JAMAICA NB SHEET 7						
																								SHEET 35 OF 97					

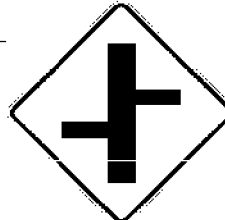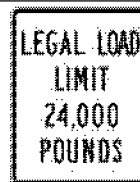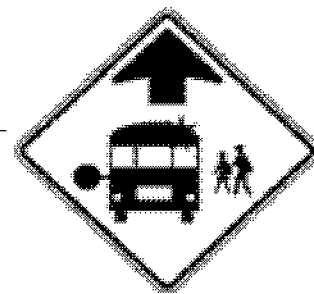
DIRECTION	MILEPOINT	LOCATION CODE (SHEET 2)	SIGN CODE	WIDTH (IN)	HEIGHT (IN)	SHEETING REMARKS	SIGN LEGEND	NEW SIGNS		EXISTING SIGNS				EXIST POST		NUMBER OF NEW POSTS	SQUARE STEEL (IN)			TUBULAR STEEL Ø (IN)					SIGN FRAME REQUIRED	REMARKS	SIGN DETAIL LOCATION								
								"A"	"B"	RETAIN	SALVAGE FROM	SALVAGE TO	REMOVE	RETAIN	REMOVE		1.75	2.00	2.50	FOUNDATION	3.00	3.50	4.00	5.00			SHSM	PROJECT SHEET #	STANDARD SHEET #						
																	(LB / FT)				(LB / FT)														
																	1.88	2.42	3.35		7.60	9.00	10.80	14.60											
JAMAICA VT-30 NB							FY-FLUORESCENT YELLOW FYG-FLUORESCENT YELLOW GREEN															"SHSM"-STANDARD HIGHWAY SIGNS AND MARKINGS													
NB	4.440	A	R2-1	24	30										X																				
		A	R2-1	24	30			5.00								1		15'-7" X							X										
NB	5.748	B	W7-1B	48	48		HILL SYMBOL - 8%								X																				
		B	W7-3A	24	18		NEXT 2 MILES																												
NB	6.323	A	W2-2ML	30	30		LEFT SIDE ROAD								X																				
		A	VW2-7L Mo	30	30			6.25								1		15'-10" X									7								
NB	6.515	C	VR-017	24	24										X											STRATTON GATE RD (TH-93)									
		C	VR-017	24	30			5.00								1		14'-9" X									6								
NB	6.521	C A	VD-700 D3-1	6 UNK	10 UNK																					STRATTON GATE RD (TH-93)									
		C D	VD-700 R1-1	6 30	10 30																														
		D	R1-1	30	30		 	0.42 6.25								1		14'-2" X								X									
		A	D3-1	72	12			6.00								2		14'-0" 14'-0" X								FIELD LOCATE AT LEAST 8 FEET FROM STOP SIGN AS TO NOT BLOCK OTHER SIGNS.		11							
NB	6.581	A	S3-1T	30	30		SCHOOL BUS STOP AHEAD 								X																				
		A	S3-1	36	36	FYG		9.00								2		14'-4" 14'-9" X							X										
NB	6.957	C	VR-017	24	30									X												STONE HEDGES RD (TH-94)									
SIGN SUMMARY SHEET							SHEET TOTALS		37.92 37.50	0.00	0	0	0	10 9	0	0	8	120.0			0	0.0	0.0	0.0	0.0	PROJECT NAME: STATEWIDE SOUTHWEST REGION PROJECT NUMBER: STPG SIGN(41)									
									SF	SF									EA	EA	EA		FT		EA	LB	LB	LB	LB	FILE NAME: 12C118 PROJECT MANAGER: A. GAMBLE DESIGNED BY: J. KELLY JAMAICA NB SHEET 8				PLOT DATE: 2/13/2013 DRAWN BY: J. KELLY CHECKED: A. GAMBLE SHEET 36 OF 97	
							TOWN DIRECTIONAL TOTALS		438.5 443.5	0.0	32 29	2 1	2 1	88 78	0	0	63 62	945.0 930.0			0	0.0													
VERMONT AGENCY OF TRANSPORTATION																																			

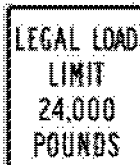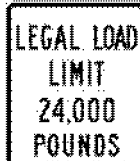DIRECTION	MILEPOINT	LOCATION CODE (SHEET 2)	SIGN CODE	WIDTH (IN)	HEIGHT (IN)	SHEETING REMARKS	SIGN LEGEND	NEW SIGNS		EXISTING SIGNS				EXIST POST		NUMBER OF NEW POSTS	SQUARE STEEL (IN)			TUBULAR STEEL Ø (IN)					SIGN FRAME REQUIRED	REMARKS	SIGN DETAIL LOCATION			
								"A"	"B"	RETAIN	SALVAGE FROM	SALVAGE TO	REMOVE	RETAIN	REMOVE		1.75	2.00	2.50	FOUNDATION	3.00	3.50	4.00	5.00			SHSM	PROJECT SHEET #	STANDARD SHEET #	
																	(LB / FT)				(LB / FT)									
																	1.88	2.42	3.35		7.60	9.00	10.80	14.60						
JAMAICA VT-30 NB							FY-FLUORESCENT YELLOW FYG-FLUORESCENT YELLOW GREEN															"SHSM"-STANDARD HIGHWAY SIGNS AND MARKINGS								
		C	VR-017	24	30			5.00															INSTALL ON EXISTING SIGN POST.		6					
NB	6.963	C D	VD-700 R1-1	6 30	10 30							1 1	X										STONE HEDGES RD (TH-94)							
		C D	VD-700 R1-1	6 30	10 30			0.42 6.25															INSTALL ON EXISTING SIGN POST.	X						
NB	6.963	A	D3-1	UNK	UNK							1		X									STONE HEDGES RD (TH-94)							
NB	6.957	A	D3-1	72	12			6.00							2		15'-6" 15'-0" X						FIELD LOCATE AT LEAST 8 FEET FROM ANY OTHER SIGN ASSEMBLY.		11					
NB	7.194	A	VW-092	36	36		UNSAFE TO PASS			1				X																
NB	7.520	A	W1-2R	30	30		RIGHT CURVE						1		X															
		A	W13-1	18	18		40 MPH ADVISORY						1																	
		A	W1-2R	30	30			6.25							1		13'-10" X								X					
		A	W13-1P	18	18			2.25																	X					
NB	7.784	C	VR-017	24	30								1	X										COLE POND RD (TH-63)						
		C	VR-017	24	30			5.00																		6				
NB	7.790	C D	VD-700 R1-1	6 30	10 30							1 1	X X	X X										COLE POND RD (TH-63)						
		C D	VD-700 R1-1	6 30	10 30			6.25							X	1		13'-6" X							X					
NB	7.790	A	D3-1	UNK	UNK							1		X										COLE POND RD (TH-63)						
SIGN SUMMARY SHEET							SHEET TOTALS	37.84 37.00	0.00	1	0	0	9 7	0	0	4 3	45.0		0	0.0	0.0	0.0	0.0	PROJECT NAME: STATEWIDE SOUTHWEST REGION PROJECT NUMBER: STPG SIGN(41)						
								SF	SF		EA	EA	EA	EA	EA	EA		FT		EA	LB	LB	LB	LB	FILE NAME: 12C118 PROJECT MANAGER: A. GAMBLE DESIGNED BY: J. KELLY JAMAICA NB SHEET 9			PLOT DATE: 2/13/2013 DRAWN BY: J. KELLY CHECKED: A. GAMBLE SHEET 37 OF 97		
VERMONT AGENCY OF TRANSPORTATION							TOWN DIRECTIONAL TOTALS	438.5 443.5	0.0	32 29	2 1	2 1	88 78	0	0	63 62	945.0 930.0		0	0.0										



DIRECTION	MILEPOINT	LOCATION CODE (SHEET 2)	SIGN CODE	WIDTH (IN)	HEIGHT (IN)	SHEETING REMARKS	SIGN LEGEND	NEW SIGNS		EXISTING SIGNS				EXIST POST		NUMBER OF NEW POSTS	SQUARE STEEL (IN)			TUBULAR STEEL Ø (IN)					SIGN FRAME REQUIRED	REMARKS	SIGN DETAIL LOCATION			
								"A"	"B"	RETAIN	SALVAGE FROM	SALVAGE TO	REMOVE	RETAIN	REMOVE		1.75	2.00	2.50	FOUNDATION	3.00	3.50	4.00	5.00			SHSM	PROJECT SHEET #	STANDARD SHEET #	
																	(LB / FT)				(LB / FT)									
																	1.88	2.42	3.35		7.60	9.00	10.80	14.60						
JAMAICA VT-30 NB							FY-FLUORESCENT YELLOW FYG-FLUORESCENT YELLOW GREEN								2 (NOT SHOWN IN PLANS)								"SHSM"-STANDARD HIGHWAY SIGNS AND MARKINGS							
		A	D3-1	62	12		Cole Pond Rd J63	5.17								2	12'-3" 11'-10" X							FIELD LOCATE AT LEAST 8 FEET FROM ANY OTHER SIGN ASSEMBLY.		11				
NB	8.061	A	VW-060	30	30		HIDDEN DRIVES			1				X																
NB	8.386	A	W3-5	36	36		SPEED REDUCTION (40)			1				X																
NB	8.425	A	VW-054L	30	30		HIDDEN DRIVE LEFT			1				X																
NB	8.467	A	VD-018	30	18								1		X															
		A	VD-018	30	18		Rawsonville Bondville 2	3.75								1	11'-8" X									5				
NB	8.518	A	R2-1	24	30								1		X															
		A	R2-1	30	36		SPEED LIMIT 40	7.50								1	14'-0" X								X					
NB	8.639	A	M2-1	21	15								1		X															
		A	M1-5	30	24								1																	
		A	M2-1	21	15			2.19								1	14'-11" X									E-136B				
		A	M3-1	24	12		JCT NORTH VERMONT 100	2.00																		E-136B				
		A	M1-5	30	24			5.00																		E-136B				
NB	8.660	C	VR-017	24	30								1	X										GOODALEVILLE RD (TH-4)						
		C	VR-017	24	30		LEGAL LOAD LIMIT 24,000 POUNDS	5.00																		6				
SIGN SUMMARY SHEET							SHEET TOTALS		30.61	0.00	3	0	0	75	0	0	75	75.0			0	0.0	0.0	0.0	0.0	PROJECT NAME: STATEWIDE SOUTHWEST REGION				
									SF	SF		EA	EA	EA	EA	EA	EA		FT		EA	LB	LB	LB	LB			PROJECT NUMBER: STPG SIGN(41)		
																												FILE NAME: 12C118		
																												PROJECT MANAGER: A. GAMBLE		
VERMONT AGENCY OF TRANSPORTATION							TOWN DIRECTIONAL TOTALS		438.5		32	2	2	88	0	0	63	945.0			0					PLOT DATE: 2/13/2013				
									443.5	0.0	29	1	1	78	0	0	62	930.0			0		0.0			DESIGNED BY: J. KELLY				
																							DRAWN BY: J. KELLY							
																							CHECKED: A. GAMBLE							
																							JAMAICA NB SHEET 10							
																							SHEET 38 OF 97							

DIRECTION	MILEPOINT	LOCATION CODE (SHEET 2)	SIGN CODE	WIDTH (IN)	HEIGHT (IN)	SHEETING REMARKS	SIGN LEGEND	NEW SIGNS		EXISTING SIGNS				EXIST POST		NUMBER OF NEW POSTS	SQUARE STEEL (IN)			TUBULAR STEEL Ø (IN)				SIGN FRAME REQUIRED	REMARKS	SIGN DETAIL LOCATION			
								"A"	"B"	RETAIN	SALVAGE FROM	SALVAGE TO	REMOVE	RETAIN	REMOVE		1.75	2.00	2.50	FOUNDATION	3.00	3.50	4.00			5.00	SHSM	PROJECT SHEET #	STANDARD SHEET #
																	(LB / FT)				(LB / FT)								
																	1.88	2.42	3.35		7.60	9.00	10.80			14.60			
JAMAICA VT-30 NB							FY-FLUORESCENT YELLOW FYG-FLUORESCENT YELLOW GREEN															"SHSM"-STANDARD HIGHWAY SIGNS AND MARKINGS							
NB	8.666	C D	VD-700 R1-1	6 30	10 30							1 1	X										GOODALEVILLE RD (TH-4)						
		C D	VD-700 R1-1	6 30	10 30			0.42 6.25																X					
NB	8.666	A	D3-1	UNK	UNK							1		X									GOODALEVILLE RD (TH-4)						
NB	8.660	A	D3-1	68	12			5.67							2	10'-9" 11'-3" X							FIELD LOCATE AT LEAST 8 FEET FROM ANY OTHER SIGN ASSEMBLY.		11				
NB	8.675	A	W2-2R	36	36							1		X															
		A	W13-1	18	18							1																	
		A	W2-2R	30	30			6.25							1	13'-11" X								X					
		A	W13-1P	18	18			2.25																X					
NB	8.710	A	VD1-1A	72	12			6.00							2	13'-11" 14'-4" X								INSTALL 70 FEET SOUTH OF EXISTING DESTINATION SIGN ASSEMBLY.		9			
		A	VD1-1A	72	12			6.00																	9				
		A	VD1-1A	72	12			6.00																	9				
NB	8.723	A	D1-1A	72	12		DESTINATION SIGN ASSEMBLY.					1		X															
		A	D1-1A	72	12							1																	
		A	D1-1S	72	12							1																	
NB	8.740	A	D1-1A	72	12		DESTINATION SIGN ASSEMBLY.					1		X															
SIGN SUMMARY SHEET							SHEET TOTALS	38.84 36.42	0.00	0	0	0	9 8	0	0	5	75.0			0	0.0	0.0	0.0	0.0	PROJECT NAME: STATEWIDE SOUTHWEST REGION PROJECT NUMBER: STPG SIGN(41)				
							SF	SF		EA	EA	EA	EA	EA	EA	EA	FT		EA	LB	LB	LB	LB	FILE NAME: 12C118 PROJECT MANAGER: A. GAMBLE DESIGNED BY: J. KELLY JAMAICA NB SHEET 11			PLOT DATE: 2/13/2013 DRAWN BY: J. KELLY CHECKED: A. GAMBLE SHEET 39 OF 97		
VERMONT AGENCY OF TRANSPORTATION							TOWN DIRECTIONAL TOTALS	438.5 443.5	0.0	32 29	2 1	2 1	88 78	0	0	63 62	945.0 930.0			0	0.0								

DIRECTION	MILEPOINT	LOCATION CODE (SHEET 2)	SIGN CODE	WIDTH (IN)	HEIGHT (IN)	SHEETING REMARKS	SIGN LEGEND	NEW SIGNS		EXISTING SIGNS				EXIST POST		NUMBER OF NEW POSTS	SQUARE STEEL (IN)			TUBULAR STEEL Ø (IN)					SIGN FRAME REQUIRED	REMARKS	SIGN DETAIL LOCATION			
								"A"	"B"	RETAIN	SALVAGE FROM	SALVAGE TO	REMOVE	RETAIN	REMOVE		1.75	2.00	2.50	FOUNDATION	3.00	3.50	4.00	5.00			SHSM	PROJECT SHEET #	STANDARD SHEET #	
																	(LB / FT)				(LB / FT)									
																	1.88	2.42	3.35		7.60	9.00	10.80	14.60						
JAMAICA VT-30 NB							FY-FLUORESCENT YELLOW FYG-FLUORESCENT YELLOW GREEN															"SHSM"-STANDARD HIGHWAY SIGNS AND MARKINGS								
		A	D1-1A	72	12								1																	
		A	D1-1S	72	12								1																	
NB	8.750	A	VD1-1A	72	12		↑ Bondville 2 ↑ Manchester 15 ↑ Ski Areas	6.00							2	15'-2" 16'-4" X							INSTALL NEW ASSEMBLY 50 FEET NORTH OF EXISTING DESTINATION SIGN ASSEMBLY.		9					
		A	VD1-1A	72	12			6.00																	9					
		A	VD1-1A	72	12			6.00																	9					
NB	8.786	A	M3-1	24	12		ROUTE MARKER SIGN ASSEMBLY.						1		X															
		A	M1-5	24	24								1																	
		A	M6-3	21	15								1																	
		A	M3-1	24	12								1																	
		A	M1-5	30	24								1																	
		A	M6-1	21	15								1																	
		A	M3-1	24	12			2.00							2	15'-1" 14'-9" X							#2A		5	E-136B				
		A	M1-5	24	24			4.00																			E-136B			
		A	M6-3	21	15			2.19																			E-136B			
		A	M3-1	24	12			2.00																			E-136B			
SIGN SUMMARY SHEET							SHEET TOTALS		28.19	0.00	0	0	0	8	0	0	4	60.0		0	0.0	0.0	0.0	0.0	PROJECT NAME: STATEWIDE SOUTHWEST REGION PROJECT NUMBER: STPG SIGN(41)					
							SF	SF			EA	EA	EA	EA	EA	EA	EA	FT		EA	LB	LB	LB	LB	FILE NAME: 12C118 PROJECT MANAGER: A. GAMBLE DESIGNED BY: J. KELLY JAMAICA NB SHEET 12			PLOT DATE: 2/13/2013 DRAWN BY: J. KELLY CHECKED: A. GAMBLE SHEET 40 OF 97		
VERMONT AGENCY OF TRANSPORTATION							TOWN DIRECTIONAL TOTALS		438.5 443.5	0.0	32 29	2 1	2 1	88 78	0	0	63 62	945.0 930.0			0	0.0								


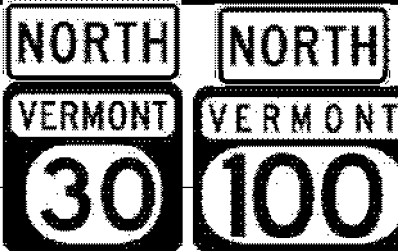
DIRECTION	MILEPOINT	LOCATION CODE (SHEET 2)	SIGN CODE	WIDTH (IN)	HEIGHT (IN)	SHEETING REMARKS	SIGN LEGEND	NEW SIGNS		EXISTING SIGNS				EXIST POST		NUMBER OF NEW POSTS	SQUARE STEEL (IN)			TUBULAR STEEL Ø (IN)					SIGN FRAME REQUIRED	REMARKS	SIGN DETAIL LOCATION		
								"A"	"B"	RETAIN	SALVAGE FROM	SALVAGE TO	REMOVE	RETAIN	REMOVE		1.75	2.00	2.50	FOUNDATION	3.00	3.50	4.00	5.00			SHSM	PROJECT SHEET #	STANDARD SHEET #
																	(LB / FT)				(LB / FT)								
																	1.88	2.42	3.35		7.60	9.00	10.80	14.60					
JAMAICA VT-30 NB							FY-FLUORESCENT YELLOW FYG-FLUORESCENT YELLOW GREEN															"SHSM"-STANDARD HIGHWAY SIGNS AND MARKINGS							
		A	M1-5	30	24			5.00																			E-136B		
		A	M6-1R	21	15			2.19																			E-136B		
NB	8.860	A	M3-1	24	12							1		X															
		A	M1-5	24	24							1																	
		A	M3-1	24	12			2.00							1		13'-11"										E-136B		
		A	M1-5	24	24			4.00																			E-136B		
NB	8.917	A	R2-1	24	30							1	✕	X	1		14'-8"	X											
		A	R2-1	24	30			5.00																		X			
NB	9.180	A	VD-700	6	10							1																	
		A	R2-1	24	30							1	X																
		A	VD-700	6	10		 	5.00																		X			
NB	9.885	A	R2-5A	24	30		REDUCED SPEED AHEAD 					1		X															
		A	W3-5	36	36			9.00							2		13'-4"	14'-6"	X						ANCHORS IN LEDGE	X			
NB	10.015	A	R2-1	24	30							1		X															
		A	R2-1	30	36			7.50							1		14'-3"	X								X			
NB	10.104	C	VR-017	24	30							1	X												AMEDEN RD (TH-22)				
SIGN SUMMARY SHEET							SHEET TOTALS	40.11 39.69	0.00	0	0	0	8 7	0	0	5 4		75.0 60.0		0	0.0	0.0	0.0	0.0	PROJECT NAME: STATEWIDE SOUTHWEST REGION				
								SF	SF	EA	EA	EA	EA	EA	EA	EA		FT		EA	LB	LB	LB	LB	PROJECT NUMBER: STPG SIGN(41)				
																											FILE NAME: 12C118		
VERMONT AGENCY OF TRANSPORTATION							TOWN DIRECTIONAL TOTALS	438.5 443.5	0.0	32 29	2 1	2 1	88 78	0	0	63 62		945.0 930.0		0	0.0				PLOT DATE: 2/13/2013				
																										DRAWN BY: J. KELLY			
																										CHECKED: A. GAMBLE			
																						DESIGNED BY: J. KELLY							
																						JAMAICA NB SHEET 13							
																							SHEET 41 OF 97						



[illegible]

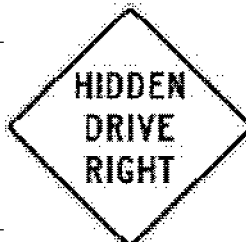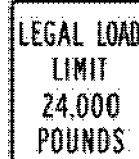DIRECTION	MILEPOINT	LOCATION CODE (SHEET 2)	SIGN CODE	WIDTH (IN)	HEIGHT (IN)	SHEETING REMARKS	SIGN LEGEND	NEW SIGNS		EXISTING SIGNS				EXIST POST		NUMBER OF NEW POSTS	SQUARE STEEL (IN)			TUBULAR STEEL Ø (IN)					SIGN FRAME REQUIRED	REMARKS	SIGN DETAIL LOCATION		
								"A"	"B"	RETAIN	SALVAGE FROM	SALVAGE TO	REMOVE	RETAIN	REMOVE		1.75	2.00	2.50	FOUNDATION	3.00	3.50	4.00	5.00			SHSM	PROJECT SHEET #	STANDARD SHEET #
																	(LB / FT)				(LB / FT)								
																	1.88	2.42	3.35		7.60	9.00	10.80	14.60					
JAMAICA VT-30 SB							FY-FLUORESCENT YELLOW FYG-FLUORESCENT YELLOW GREEN															"SHSM"-STANDARD HIGHWAY SIGNS AND MARKINGS							
SB	10.015	F	R2-1	24	30								1		X														
		F	R2-1	24	30			5.00								1		14'-0" X						INSTALL DIRECTLY ACROSS FROM NB SPEED LIMIT 40 SIGN ASSEMBLY.	X				
SB	9.302	F	W3-5	36	36		SPEED REDUCTION ADVANCE WARNING SIGN (40 MPH)			1				X															
SB	9.245	F	VD-018	30	18								1		X														
		F	VD-018	30	18			3.75								1		13'-2" X									5		
SB	9.150	F	R2-1	24	30								1		X														
		F	R2-1	30	36			7.50								1		14'-9" X								X			
SB	9.110	F	VW-054R	30	30		HIDDEN DRIVE RIGHT						1		X														
		F	VW-054R	30	30			6.25								1		16'-1" X									7		
		F	W11-5M	30	30		FARM MACHINERY						1																
SB	8.983	A	D3-1	UNK	UNK								1		X									DIERS RD (TH-9)					
		A	D3-1	40	12			3.33							2			13'-0" 13'-0" X						~~INSTALL ABOVE STOP SIGN LEGAL LOAD SIGN WITH BRACKET.~~			11		
SB	8.983	G	VR-017	24	30								1		X									DIERS RD (TH-9)					
		G	VR-017	24	30			5.00								1		13'-0" X									6		
SB	8.977	G H	VD-700 R1-1	6 30	10 30								1 1		X									DIERS RD (TH-9)					
SIGN SUMMARY SHEET							SHEET TOTALS		30.83	0.00	1	0	0	9 8	0	0	7 5		105.0 75.0		0	0.0	0.0	0.0	0.0	PROJECT NAME: STATEWIDE SOUTHWEST REGION			
									SF	SF		EA	EA	EA	EA	EA	EA		FT		EA	LB	LB	LB	LB	PROJECT NUMBER: STPG SIGN(41)			
																										FILE NAME: 12C118			
																										PROJECT MANAGER: A. GAMBLE			
VERMONT AGENCY OF TRANSPORTATION							TOWN DIRECTIONAL TOTALS		431.84 430.2	0.0	31 29	2 0	2 0	85 82	0	0	66 63		990.0 945.0		0				PLOT DATE: 2/13/2013				
																									DRAWN BY: J. KELLY				
																							CHECKED: A. GAMBLE						
																							SHEET 43 OF 97						




DIRECTION	MILEPOINT	LOCATION CODE (SHEET 2)	SIGN CODE	WIDTH (IN)	HEIGHT (IN)	SHEETING REMARKS	SIGN LEGEND	NEW SIGNS		EXISTING SIGNS				EXIST POST		NUMBER OF NEW POSTS	SQUARE STEEL (IN)			TUBULAR STEEL Ø (IN)				SIGN FRAME REQUIRED	REMARKS	SIGN DETAIL LOCATION			
								"A"	"B"	RETAIN	SALVAGE FROM	SALVAGE TO	REMOVE	RETAIN	REMOVE		1.75	2.00	2.50	FOUNDATION	3.00	3.50	4.00			5.00	SHSM	PROJECT SHEET #	STANDARD SHEET #
																	(LB / FT)				(LB / FT)								
																	1.88	2.42	3.35		7.60	9.00	10.80			14.60			
JAMAICA VT-30 SB							FY-FLUORESCENT YELLOW FYG-FLUORESCENT YELLOW GREEN															"SHSM"-STANDARD HIGHWAY SIGNS AND MARKINGS							
		G H	VD-700 R1-1	6 30	10 30			0.42 6.25							1		13'-3" X								X				
SB	8.960	F	R2-1	24	30								1		X														
		F	R2-1	24	30			5.00								1		12'-4" X								X			
SB	8.920	F	D1-1A	72	12		DESTINATION SIGNS						1	X															
		F	D1-1A	72	12								1																
		F	D1-1A	72	12								1																
		F	D1-1A	72	12								1																
		F	VD1-1A	72	12			6.00																		INSTALL NEW SIGNS ON EXISTING FLANGED CHANNEL SIGN POSTS.		9	
		F	VD1-1A	72	12			6.00																			10		
		F	VD1-1A	72	12			6.00																			10		
		F	VD1-1A	72	12			6.00																			10		
SB	8.866	F	M3-1	24	12		ROUTE MARKER ASSEMBLY						1		X														
		F	M1-5	30	24								1																
		F	M6-1	21	15								1																
		F	M3-3	24	12								1																
SIGN SUMMARY SHEET							SHEET TOTALS	35.67 35.25	0.00	0	0	0	9 9	0	0	7 2		105.0 30.0		0	0.0	0.0	0.0	0.0	PROJECT NAME: STATEWIDE SOUTHWEST REGION	PROJECT NUMBER: STPG SIGN(41)			
								SF	SF	EA	EA	EA	EA	EA	EA	EA		FT		EA	LB	LB	LB	LB	FILE NAME: 12C118	PLOT DATE: 2/13/2013			
																									PROJECT MANAGER: A. GAMBLE	DRAWN BY: J. KELLY			
							VERMONT AGENCY OF TRANSPORTATION																			DESIGNED BY: J. KELLY	CHECKED: A. GAMBLE		
TOWN DIRECTIONAL TOTALS							431.84 430.2	0.0		31 29	2 0	2 0	85 82	0	0	66 63		990.0 945.0		0	0.0				JAMAICA SB SHEET 2	SHEET 44 OF 97			


DIRECTION	MILEPOINT	LOCATION CODE (SHEET 2)	SIGN CODE	WIDTH (IN)	HEIGHT (IN)	SHEETING REMARKS	SIGN LEGEND	NEW SIGNS		EXISTING SIGNS				EXIST POST		NUMBER OF NEW POSTS	SQUARE STEEL (IN)			TUBULAR STEEL Ø (IN)				SIGN FRAME REQUIRED	REMARKS	SIGN DETAIL LOCATION				
								"A"	"B"	RETAIN	SALVAGE FROM	SALVAGE TO	REMOVE	RETAIN	REMOVE		1.75	2.00	2.50	FOUNDATION	3.00	3.50	4.00			5.00	SHSM	PROJECT SHEET #	STANDARD SHEET #	
																	(LB / FT)				(LB / FT)									
																	1.88	2.42	3.35		7.60	9.00	10.80			14.60				
JAMAICA VT-30 SB							FY-FLUORESCENT YELLOW FYG-FLUORESCENT YELLOW GREEN															"SHSM"-STANDARD HIGHWAY SIGNS AND MARKINGS								
		F	M1-5	24	24								1																	
		F	M6-3	21	15								1																	
		F	M3-3	24	12								1																	
		F	M1-5	30	24								1																	
		F	M6-3	21	15								1																	
		F	M3-1	24	12			2.00							2		10'-3" 10'-3" X						#3B		5	E-136B				
		F	M1-5	30	24			5.00																			E-136B			
		F	M6-1L	21	15			2.19																			E-136B			
		F	M3-3	24	12			2.00																			E-136B			
		F	M1-5	24	24			4.00																			E-136B			
		F	M6-3	21	15			2.19																			E-136B			
		F	M3-3	24	12		NORTH VERMONT 100 ← SOUTH VERMONT 30 ↑ SOUTH VERMONT 100 ↑	2.00																						E-136B
		F	M1-5	30	24			5.00																			E-136B			
		F	M6-3	21	15			2.19																			E-136B			
SB	8.810	F	W1-7	48	24								1		X															
SIGN SUMMARY SHEET							SHEET TOTALS		26.57	0.00	0	0	0	6	0	0	2	30.0		0	0.0	0.0	0.0	0.0	PROJECT NAME: STATEWIDE SOUTHWEST REGION					
									SF	SF	EA	EA	EA	EA	EA	EA		FT		EA	LB	LB	LB	LB	PROJECT NUMBER: STPG SIGN(41)					
																									FILE NAME: 12C118					
VERMONT AGENCY OF TRANSPORTATION							TOWN DIRECTIONAL TOTALS		431.84 430.2	0.0	31 29	2 0	2 0	85 82	0	0	66 63	990.0 945.0		0	0.0			PROJECT MANAGER: A. GAMBLE						
																								DESIGNED BY: J. KELLY						
																						PLOT DATE: 2/13/2013								
																						DRAWN BY: J. KELLY								
																						CHECKED: A. GAMBLE								
																						SHEET 46 OF 97								
																						JAMAICA SB SHEET 3								

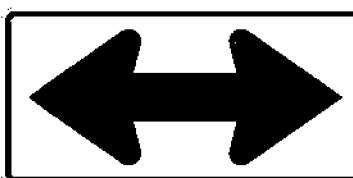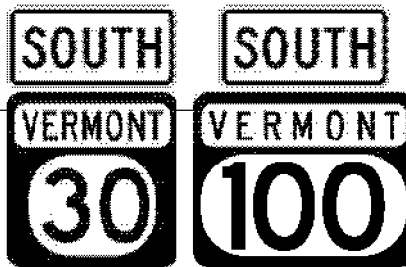
DIRECTION	MILEPOINT	LOCATION CODE (SHEET 2)	SIGN CODE	WIDTH (IN)	HEIGHT (IN)	SHEETING REMARKS	SIGN LEGEND	NEW SIGNS		EXISTING SIGNS				EXIST POST		NUMBER OF NEW POSTS	SQUARE STEEL (IN)			TUBULAR STEEL Ø (IN)					SIGN FRAME REQUIRED	REMARKS	SIGN DETAIL LOCATION		
								"A"	"B"	RETAIN	SALVAGE FROM	SALVAGE TO	REMOVE	RETAIN	REMOVE		1.75	2.00	2.50	FOUNDATION	3.00	3.50	4.00	5.00			SHSM	PROJECT SHEET #	STANDARD SHEET #
																	(LB / FT)				(LB / FT)								
																	1.88	2.42	3.35		7.60	9.00	10.80	14.60					
JAMAICA VT-30 SB							FY-FLUORESCENT YELLOW FYG-FLUORESCENT YELLOW GREEN																"SHSM"-STANDARD HIGHWAY SIGNS AND MARKINGS						
		F	W1-7	48	24			8.00							2		14'-9" 13'-7" X								X				
SB	8.785	F	M3-3	24	12		ROUTE MARKER ASSEMBLY.						1		X														
		F	M1-5	24	24								1																
		F	M3-3	24	12								1																
		F	M1-5	30	24								1																
		F	M3-3	24	12			2.00							2		15'-1" 14'-11" X					#2A			5	E-136B			
		F	M1-5	24	24			4.00																		E-136B			
		F	M3-3	24	12			2.00																			E-136B		
		F	M1-5	30	24			5.00																		E-136B			
SB	8.745	F	R2-1	24	30								1		X														
		F	R2-1	24	30			5.00							1		13'-2" X								X				
SB	8.720	F	D2-1	72	10								1		X														
		F	D2-1	72	10								1																
		F	VD2-1	72	12			6.00							2		12'-8" 12'-4" X									8			
		F	VD2-1	72	12			6.00																		8			
SIGN SUMMARY SHEET							SHEET TOTALS		38.00	0.00	0	0	0	7	0	0	7	105.0		0	0.0	0.0	0.0	0.0	PROJECT NAME: STATEWIDE SOUTHWEST REGION				
									SF	SF	EA	EA	EA	EA	EA	EA	EA	FT	EA	LB	LB	LB	LB	PROJECT NUMBER: STPG SIGN(41)					
																								FILE NAME: 12C118					
							VERMONT AGENCY OF TRANSPORTATION																		PROJECT MANAGER: A. GAMBLE				
TOWN DIRECTIONAL TOTALS									431.84 430.2	0.0	31 29	2 0	2 0	85 82	0	0	66 63	990.0 945.0		0	0.0			PLOT DATE: 2/13/2013					
																							DRAWN BY: J. KELLY						
																							CHECKED: A. GAMBLE						
																							SHEET 46 OF 97						
																							JAMAICA SB SHEET 4						


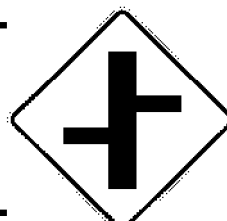
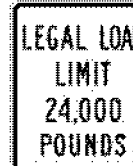
DIRECTION	MILEPOINT	LOCATION CODE (SHEET 2)	SIGN CODE	WIDTH (IN)	HEIGHT (IN)	SHEETING REMARKS	SIGN LEGEND	NEW SIGNS		EXISTING SIGNS				EXIST POST		NUMBER OF NEW POSTS	SQUARE STEEL (IN)			TUBULAR STEEL Ø (IN)					SIGN FRAME REQUIRED	REMARKS	SIGN DETAIL LOCATION		
								"A"	"B"	RETAIN	SALVAGE FROM	SALVAGE TO	REMOVE	RETAIN	REMOVE		1.75	2.00	2.50	FOUNDATION	3.00	3.50	4.00	5.00			SHSM	PROJECT SHEET #	STANDARD SHEET #
																	(LB / FT)				(LB / FT)								
																	1.88	2.42	3.35		7.60	9.00	10.80	14.60					
JAMAICA VT-30 SB							FY-FLUORESCENT YELLOW FYG-FLUORESCENT YELLOW GREEN															"SHSM"-STANDARD HIGHWAY SIGNS AND MARKINGS							
SB	8.518	F	R2-1	24	30										X														
		F	R2-1	24	30			5.00									14'-7" X							INSTALL DIRECTLY ACROSS FROM NB SPEED LIMIT 40 ASSEMBLY.	X				
SB	7.965	F	D3-1	UNK	UNK										X														
		F	D3-1	68	12		Wild Turkey Run J86	5.67									8'-10" 8'-4" X								WILD TURKEY RUN (TH-86) FIELD LOCATE AT LEAST 8 FEET FROM ANY OTHER SIGN ASSEMBLY. ANCHORS IN LEDGE		11		
SB	7.965	G	VR-017	24	24										X														
		G	VR-017	24	30			5.00									13'-1" X											6	
SB	7.957	G H	VD-700 R1-1	6 30	10 30								1 1		X														
		G H	VD-700 R1-1	6 30	10 30			0.42 6.25									13'-2" X									X			
SB	7.865	F	VW2-7L Mo	30	30			6.25									14'-7" X								INSTALL 425 NORTH AND ACROSS FROM COLE POND RD.		7		
SB	7.768	G	VR-017	24	30										X														
		F	D3-1	UNK	UNK		BOURBON RUN RD STREET SIGN																						
		G	VR-017	24	30			5.00									12'-9" X											6	
SB	7.768	F	D3-1	72	12		Bourbon Run Rd J65	6.00									11'-2" 11'-6" X								FIELD LOCATE AT LEAST 8 FEET FROM ANY OTHER SIGN ASSEMBLY.		11		
SB	7.760	G H	VD-700 R1-1	6 30	10 30								1 1	X															
		G H	VD-700 R1-1	6 30	10 30			0.42 6.25																			X		
SIGN SUMMARY SHEET							SHEET TOTALS		46.26 45.42	0.00	0	0	0	9 7	0	0	9	135.0			0	0.0	0.0	0.0	0.0	PROJECT NAME: STATEWIDE SOUTHWEST REGION			
									SF	SF	EA	EA	EA	EA	EA	EA		FT		EA	LB	LB	LB	LB	PROJECT NUMBER: STPG SIGN(41)				
																									FILE NAME: 12C118				
VERMONT AGENCY OF TRANSPORTATION							TOWN DIRECTIONAL TOTALS		431.84 430.2	0.0	31 29	2 0	2 0	85 82	0	0	66 63	990.0 945.0			0	0.0				PROJECT MANAGER: A. GAMBLE			
																									PLOT DATE: 2/13/2013				
																									DRAWN BY: J. KELLY				
																							DESIGNED BY: J. KELLY						
																							JAMAICA SB SHEET 5						
																							CHECKED: A. GAMBLE						
																							SHEET 47 OF 97						





DIRECTION	MILEPOINT	LOCATION CODE (SHEET 2)	SIGN CODE	WIDTH (IN)	HEIGHT (IN)	SHEETING REMARKS	SIGN LEGEND	NEW SIGNS		EXISTING SIGNS				EXIST POST		NUMBER OF NEW POSTS	SQUARE STEEL (IN)			TUBULAR STEEL Ø (IN)					SIGN FRAME REQUIRED	REMARKS	SIGN DETAIL LOCATION		
								"A"	"B"	RETAIN	SALVAGE FROM	SALVAGE TO	REMOVE	RETAIN	REMOVE		1.75	2.00	2.50	FOUNDATION	3.00	3.50	4.00	5.00			SHSM	PROJECT SHEET #	STANDARD SHEET #
																	(LB / FT)				(LB / FT)								
																	1.88	2.42	3.35		7.60	9.00	10.80	14.60					
JAMAICA VT-30 SB							FY-FLUORESCENT YELLOW FYG-FLUORESCENT YELLOW GREEN																"SHSM"-STANDARD HIGHWAY SIGNS AND MARKINGS						
SB	7.677	F	W1-2L	30	30		LEFT CURVE							1		X													
		F	W13-1	18	18		40 MPH							1															
		F	W1-2L	30	30	FY		6.25							1		16'-9" X								X				
		F	W13-1P	18	18	FY		2.25																	X				
SB	7.614	F	W1-8L	24	30		CHEVRON			1				X															
		E	W1-8R	24	30		CHEVRON			1																			
SB	7.586	F	W1-8L	24	30		CHEVRON			1				X															
		E	W1-8R	24	30		CHEVRON			1																			
SB	7.560	F	W1-8L	24	30		CHEVRON			1				X															
		E	W1-8R	24	30		CHEVRON			1																			
SB	7.535	F	W1-8L	24	30		CHEVRON			1				X															
		E	W1-8R	24	30		CHEVRON			1																			
SB	7.397	F	VW-092	36	36								1	X	X														
		F	VW-092	36	36			9.00							2		14'-11" 15'-0" X								7				
SB	6.900	F	VW-060	30	30							1		X															
SIGN SUMMARY SHEET							SHEET TOTALS		17.50	0.00	8	0	0	4	0	0	~~3~~ 1	~~45.0~~ 15.0	0	0.0	0.0	0.0	0.0	PROJECT NAME: STATEWIDE SOUTHWEST REGION					
									SF	SF	EA	EA	EA	EA	EA	EA	EA	FT	EA	LB	LB	LB	LB	PROJECT NUMBER: STPG SIGN(41)					
																								FILE NAME: 12C118					
																								DESIGNED BY: J. KELLY					
VERMONT AGENCY OF TRANSPORTATION							TOWN DIRECTIONAL TOTALS		431.84 430.2	0.0	31 29	2 0	2 0	85 82	0	0	66 63	990.0 945.0	0	0.0					PLOT DATE: 2/13/2013				
																						DRAWN BY: J. KELLY							
																						CHECKED: A. GAMBLE							
																						SHEET 48 OF 97							

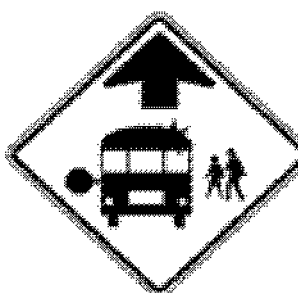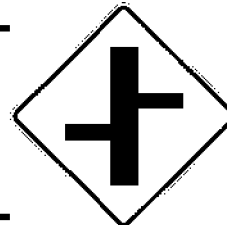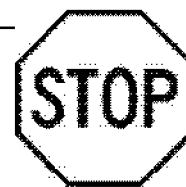
DIRECTION	MILEPOINT	LOCATION CODE (SHEET 2)	SIGN CODE	WIDTH (IN)	HEIGHT (IN)	SHEETING REMARKS	SIGN LEGEND	NEW SIGNS		EXISTING SIGNS				EXIST POST		NUMBER OF NEW POSTS	SQUARE STEEL (IN)			TUBULAR STEEL Ø (IN)					SIGN FRAME REQUIRED	REMARKS	SIGN DETAIL LOCATION		
								"A"	"B"	RETAIN	SALVAGE FROM	SALVAGE TO	REMOVE	RETAIN	REMOVE		1.75	2.00	2.50	FOUNDATION	3.00	3.50	4.00	5.00			SHSM	PROJECT SHEET #	STANDARD SHEET #
																	(LB / FT)				(LB / FT)								
																	1.88	2.42	3.35		7.60	9.00	10.80	14.60					
JAMAICA VT-30 SB							FY-FLUORESCENT YELLOW FYG-FLUORESCENT YELLOW GREEN																"SHSM"-STANDARD HIGHWAY SIGNS AND MARKINGS						
		F	VW-060	30	30			6.25							1		15'-0" X									7			
SB	6.830	F	S3-1T	30	30		SCHOOL BUS STOP AHEAD 						1		X														
		F	S3-1	36	36	FYG		9.00								2		15'-0" X							X				
SB	6.575	F	VW2-7L Mo	30	30			6.25								1		16'-5" X							INSTALL 450 FEET NORTH OF STRATTON GATE RD.		7		
SB	6.500	F	W2-2R	30	30		RIGHT SIDE ROAD						1		X														
SB	6.408	G	VR-017	24	30								1		X										MTN ACRES RD (TH-11)				
		G	VR-017	24	30			5.00								1		13'-3" X									6		
SB	6.403	F	D3-1	UNK	UNK								1		X										MTN ACRES RD (TH-11)				
		F	D3-1	60	12		Mtn Acres Rd JII	5.00								2		13'-0" X 14'-0" X								FIELD LOCATE AT LEAST 8 FEET FROM ANY OTHER SIGN ASSEMBLY.		11	
SB	6.403	G	VD-700	6	10		0300 1309 0646			1																MTN ACRES RD (TH-11)			
		H	R1-1	30	30			6.25																		X			
		H	R1-1	30	30																								
SB	5.748	F	W7-1B	36	36								1		X														
		F	W7-3A	24	18								1																
		F	W7-1a	36	36	FY		9.00								2		15'-3" X 14'-4" X								X			
		F	W7-3A	24	18	FY	NEXT 2 MILES	3.00																		X			
SIGN SUMMARY SHEET							SHEET TOTALS		49.75	0.00	~~1~~ 0	0	0	7	0	0	~~3~~ 9	135.0		0	0.0	0.0	0.0	0.0	PROJECT NAME: STATEWIDE SOUTHWEST REGION				
									SF	SF	EA	EA	EA	EA	EA	EA	EA	FT		EA	LB	LB	LB	LB	PROJECT NUMBER: STPG SIGN(41)				
																										FILE NAME: 12C118			
VERMONT AGENCY OF TRANSPORTATION							TOWN DIRECTIONAL TOTALS		431.84 430.2	0.0	31 29	~~2~~ 0	~~2~~ 0	85 82	0	0	66 63	990.0 945.0		0	0.0				PROJECT MANAGER: A. GAMBLE				
																									DRAWN BY: J. KELLY				
																									CHECKED: A. GAMBLE				
																						DESIGNED BY: J. KELLY							
																						JAMAICA SB SHEET 7							
																							PLOT DATE: 2/13/2013						
																							SHEET 49 OF 97						

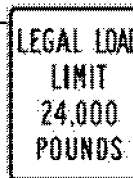DIRECTION	MILEPOINT	LOCATION CODE (SHEET 2)	SIGN CODE	WIDTH (IN)	HEIGHT (IN)	SHEETING REMARKS	SIGN LEGEND	NEW SIGNS		EXISTING SIGNS				EXIST POST		NUMBER OF NEW POSTS	SQUARE STEEL (IN)			TUBULAR STEEL Ø (IN)					SIGN FRAME REQUIRED	REMARKS	SIGN DETAIL LOCATION		
								"A"	"B"	RETAIN	SALVAGE FROM	SALVAGE TO	REMOVE	RETAIN	REMOVE		1.75	2.00	2.50	FOUNDATION	3.00	3.50	4.00	5.00			SHSM	PROJECT SHEET #	STANDARD SHEET #
																	(LB / FT)				(LB / FT)								
																	1.88	2.42	3.35		7.60	9.00	10.80	14.60					
JAMAICA VT-30 SB							FY-FLUORESCENT YELLOW FYG-FLUORESCENT YELLOW GREEN																"SHSM"-STANDARD HIGHWAY SIGNS AND MARKINGS						
SB	5.450	F	VW-054R	30	30									1		X													
		F	VW-054R	30	30			6.25										14'-10" X									7		
SB	5.410	F	W7-1B	36	36		HILL SYMBOL							1		X													
SB	4.960	F	W7-1B	36	36									1		X													
		F	W7-3A	24	18									1															
		F	W7-1A	36	36			9.00										15'-0" 14'-6" X									X		
		F	W7-3A	24	18			3.00																			X		
SB	4.705	G	D3-1	UNK	UNK									1		X									W HILL RD S (TH-15)				
		G	D3-1	56	12		W. Hill Rd S. J15	4.67										13'-0" 14'-0" X							FIELD LOCATE AT LEAST 8 FEET FROM ANY OTHER SIGN ASSEMBLY.		11		
SB	4.705	G	VR-017	24	30									1		X									W HILL RD S (TH-15)				
		G	VR-017	24	30			5.00										12'-6" X									6		
SB	4.697	G H	VD-700 R1-1	6 30	10 30		0300 1309 0472				1			1		X									W HILL RD S (TH-15)				
		G H	VD-700 R1-1	6 30	10 30			6.25				1						12'-3" X								X			
SB	4.605	F	W3-5	36	36									1		X													
		F	W3-5	36	36			9.00										16'-3" 15'-8" X									X		
SIGN SUMMARY SHEET							SHEET TOTALS	43.17	0.00	0	1-0	1-0	8	0	0	9	135.0			0	0.0	0.0	0.0	0.0	PROJECT NAME: STATEWIDE SOUTHWEST REGION				
								SF	SF	EA	EA	EA	EA	EA	EA	EA		FT		EA	LB	LB	LB	LB	PROJECT NUMBER: STPG SIGN(41)				
							VERMONT AGENCY OF TRANSPORTATION			TOWN DIRECTIONAL TOTALS	431.84 430.2	0.0	31 29	2-0 -0	2-0 -0	85 82	0	0	66 63	990.0 945.0			0	0.0				FILE NAME: 12C118	
																							PROJECT MANAGER: A. GAMBLE			PLOT DATE: 2/13/2013			
																								DESIGNED BY: J. KELLY			DRAWN BY: J. KELLY		
																								JAMAICA SB SHEET 8			CHECKED: A. GAMBLE		
																											SHEET 50 OF 97		

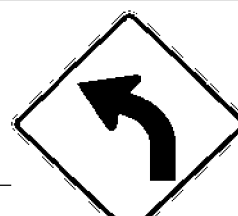DIRECTION	MILEPOINT	LOCATION CODE (SHEET 2)	SIGN CODE	WIDTH (IN)	HEIGHT (IN)	SHEETING REMARKS	SIGN LEGEND	NEW SIGNS		EXISTING SIGNS				EXIST POST		NUMBER OF NEW POSTS	SQUARE STEEL (IN)			TUBULAR STEEL Ø (IN)					SIGN FRAME REQUIRED	REMARKS	SIGN DETAIL LOCATION		
								"A"	"B"	RETAIN	SALVAGE FROM	SALVAGE TO	REMOVE	RETAIN	REMOVE		1.75	2.00	2.50	FOUNDATION	3.00	3.50	4.00	5.00			SHSM	PROJECT SHEET #	STANDARD SHEET #
																	(LB / FT)				(LB / FT)								
																	1.88	2.42	3.35		7.60	9.00	10.80	14.60					
JAMAICA VT-30 SB							FY-FLUORESCENT YELLOW FYG-FLUORESCENT YELLOW GREEN																"SHSM"-STANDARD HIGHWAY SIGNS AND MARKINGS						
SB	4.500	F	W7-1B	36	36		HILL SYMBOL							1		X													
SB	4.480	F	VD-018	30	18			3.75							1		15'-0" X							INSTALL 100 FEET NORTH OF EXISTING VILLAGE SIGN ASSEMBLY.		5			
SB	4.460	F	VD-018	30	18		JAMAICA EAST JAMAICA 3						1		X														
SB	4.440	F	R2-1	24	30								1		X														
		F	R2-1	30	36			7.50							1		15'-0" X							INSTALL DIRECTLY ACROSS FROM NB SPEED LIMIT 50 SIGN ASSEMBLY.	X				
SB	4.390	F	W1-2L	30	30		LEFT CURVE						1		X														
		F	W13-1	18	18		35 MPH ADVISORY						1																
SB	4.340	F	W1-2L	30	30			6.25								1		14'-11" X						INSTALL 200 FEET NORTH OF SPEED REDUCTION (30) SIGN ASSEMBLY.	X				
		F	W13-1P	18	18			2.25																	X				
SB	4.300	F	W3-5	36	36								1		X														
		F	W3-5	36	36			9.00							2		14'-6" 14'-4" X								X				
SB	4.255	F	VD-062B	72	16		BUSINESS SIGN			1				X															
		F	VD-062BRN	72	16		BUSINESS SIGN			1																			
SB	4.220	F	VW-054L	30	30								1		X														
		F	VW-054L	30	30			6.25							1		14'-2" X									7			
SIGN SUMMARY SHEET							SHEET TOTALS		35.00	0.00	2	0	0	7	0	0	6	90.0		0	0.0	0.0	0.0	0.0	PROJECT NAME: STATEWIDE SOUTHWEST REGION				
									SF	SF	EA	EA	EA	EA	EA	EA		FT		EA	LB	LB	LB	LB	PROJECT NUMBER: STPG SIGN(41)				
																									FILE NAME: 12C118				
																										PROJECT MANAGER: A. GAMBLE			
VERMONT AGENCY OF TRANSPORTATION							TOWN DIRECTIONAL TOTALS		431.84		31	2	2	85	0	0	66	990.0	0	0.0				PLOT DATE: 2/13/2013					
									430.2	0.0	29	0	0	82	0	0	63	945.0					DRAWN BY: J. KELLY						
																						CHECKED: A. GAMBLE							
																						SHEET 51 OF 97							

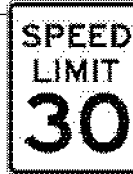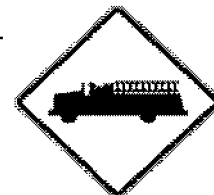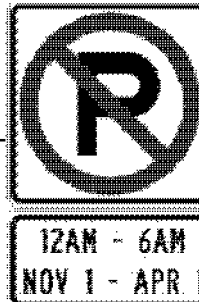
DIRECTION	MILEPOINT	LOCATION CODE (SHEET 2)	SIGN CODE	WIDTH (IN)	HEIGHT (IN)	SHEETING REMARKS	SIGN LEGEND	NEW SIGNS		EXISTING SIGNS				EXIST POST		NUMBER OF NEW POSTS	SQUARE STEEL (IN)			TUBULAR STEEL Ø (IN)					SIGN FRAME REQUIRED	REMARKS	SIGN DETAIL LOCATION			
								"A"	"B"	RETAIN	SALVAGE FROM	SALVAGE TO	REMOVE	RETAIN	REMOVE		1.75	2.00	2.50	FOUNDATION	3.00	3.50	4.00	5.00			SHSM	PROJECT SHEET #	STANDARD SHEET #	
																	(LB / FT)				(LB / FT)									
																	1.88	2.42	3.35		7.60	9.00	10.80	14.60						
JAMAICA VT-30 SB							FY-FLUORESCENT YELLOW FYG-FLUORESCENT YELLOW GREEN															"SHSM"-STANDARD HIGHWAY SIGNS AND MARKINGS								
SB	4.180	F	R2-1	30	36								1		X															
		F	R2-1	30	36			7.50							1		13'-1" X							INSTALL NEW SIGN DIRECTLY ACROSS FROM THE NB SPEED LIMIT 40 SIGN.	X					
SB	4.132	F	W11-8	36	36								1		X															
		F	W11-8	30	30			6.25							1		14'-3" X									X				
			SKIP TO SOUTH SIDE OF BRIDGE #30																											
SB	3.903	F	R8-3	24	24			4.00								1		12'-10" X								INSTALL AT END OF STONE WALL.	X			
		F	VR-122	24	12			2.00																				6		
SB	3.878	F	W11-2	30	30		PEDESTRIAN ADVANCE WARNING SIGN			1				X																
		F	W16-7	24	12		DOWNWARD ARROW			1																				
SB	3.851 ~~3.858~~	G	VR-017	24	24								1	~~X~~													PIKES FALLS RD (TH-1)			
SB	3.858	G	R2-1	24	30						1	1					1		14'-4" X							INSTALLED ON POST WITH VILLAGE SPEED LIMIT 25 SIGN ~~INSTALL ON EXISTING SIGN POST.~~		6		
SB	3.858	H	R1-1	30	30			STOP						~~1~~													NOT FOUND IN FIELD			
SB	3.851	G	VD-700	6	10								1		X												PIKES FALLS RD (TH-1)			
		G	VD-700	6	10				0.42																		INSTALL ON EXISTING SIGN POST.	X		
SB	3.851	F	D3-1	60	12			5.00								~~2~~		~~X~~								~~FIELD LOCATE SIGN ASSEMBLY AS TO NOT BLOCK OTHER SIGNS.~~		11		
SIGN SUMMARY SHEET							SHEET TOTALS		36.42 36.00	0.00	2	1 0	1 0	5	0	0	4 5	60.0 75.0			0	0.0	0.0	0.0	0.0	PROJECT NAME: STATEWIDE SOUTHWEST REGION				
									SF	SF	EA	EA	EA	EA	EA	EA		FT		EA	LB	LB	LB	LB	PROJECT NUMBER: STPG SIGN(41)					
																									FILE NAME: 12C118					
VERMONT AGENCY OF TRANSPORTATION							TOWN DIRECTIONAL TOTALS		431.84 430.2	0.0	31 29	2 0	2 0	85 82	0	0	66 63	990.0 945.0			0	0.0				PROJECT MANAGER: A. GAMBLE				
																									PLOT DATE: 2/13/2013					
																									DRAWN BY: J. KELLY					
																											CHECKED: A. GAMBLE			
																											JAMAICA SB SHEET 10			
																											SHEET 52 OF 97			

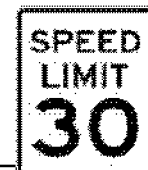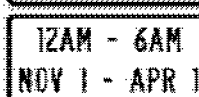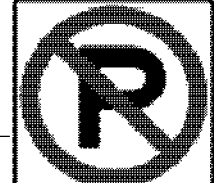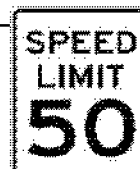
DIRECTION	MILEPOINT	LOCATION CODE (SHEET 2)	SIGN CODE	WIDTH (IN)	HEIGHT (IN)	SHEETING REMARKS	SIGN LEGEND	NEW SIGNS		EXISTING SIGNS				EXIST POST		NUMBER OF NEW POSTS	SQUARE STEEL (IN)			TUBULAR STEEL Ø (IN)					SIGN FRAME REQUIRED	REMARKS	SIGN DETAIL LOCATION				
								"A"	"B"	RETAIN	SALVAGE FROM	SALVAGE TO	REMOVE	RETAIN	REMOVE		1.75	2.00	2.50	FOUNDATION	3.00	3.50	4.00	5.00			SHSM	PROJECT SHEET #	STANDARD SHEET #		
																	(LB / FT)				(LB / FT)										
																	1.88	2.42	3.35		7.60	9.00	10.80	14.60							
JAMAICA VT-30 SB							FY-FLUORESCENT YELLOW FYG-FLUORESCENT YELLOW GREEN																"SHSM"-STANDARD HIGHWAY SIGNS AND MARKINGS								
SB	3.815	F	R2-1	24	30																										
		F	R7-2S	24	36		NO PARKING (DATES)																								
		F	R2-1	24	30			5.00																	INSTALL NEW SIGNS ON EXISTING FLANGED CHANNEL SIGN POST.	X					
		F	R8-3	24	24			4.00																		X					
		F	VR-122	24	12			2.00																			6				
SB	3.755	F	R2-1	24	30			5.00								1	12'-8" X								INSTALL NORTH OF UTILITY POLE WITH CONDUIT, ACROSS FROM THREE MOUNTAIN INN.	X					
SB	3.590	F	R2-1	24	30																										
		F	R2-1	24	30			5.00								1	13'-11" X								INSTALL DIRECTLY ACROSS FROM NB SPEED LIMIT 30 SIGN ASSEMBLY.	X					
SB	3.590	F	R7-2S	24	36		NO PARKING (DATES)																								
		F	M4-6	24	12		END																								
		F	R3-9dP	30	12			2.50								1	11'-11" X								INSTALL TO THE RIGHT OF SPEED LIMIT 40 ASSEMBLY.	X					
		F	R8-3	24	24			4.00																		X					
		F	VR-122	24	12			2.00																			6				
SB	3.310	F	R2-1	24	30																										
		F	R2-1	24	30			5.00								1	13'-6" X										X				
SIGN SUMMARY SHEET							SHEET TOTALS		34.50	0.00	0	0	0	6	0	0	4	60.0		0	0.0	0.0	0.0	0.0	PROJECT NAME: STATEWIDE SOUTHWEST REGION						
								SF	SF	EA	EA	EA	EA	EA	EA	EA		FT		EA	LB	LB	LB	LB	PROJECT NUMBER: STPG SIGN(41)						
																										FILE NAME: 12C118					
VERMONT AGENCY OF TRANSPORTATION																							PROJECT MANAGER: A. GAMBLE			PLOT DATE: 2/13/2013					
																									DRAWN BY: J. KELLY						
																									CHECKED: A. GAMBLE						
TOWN DIRECTIONAL TOTALS							431.84 430.2	0.0	31 29	2 0	2 0	85 82	0	0	66 63	990.0 945.0		0	0.0				DESIGNED BY: J. KELLY			JAMAICA SB SHEET 11			SHEET 53 OF 97		

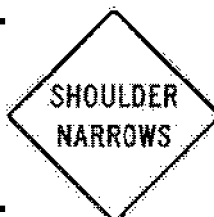
DIRECTION	MILEPOINT	LOCATION CODE (SHEET 2)	SIGN CODE	WIDTH (IN)	HEIGHT (IN)	SHEETING REMARKS	SIGN LEGEND	NEW SIGNS		EXISTING SIGNS				EXIST POST		NUMBER OF NEW POSTS	SQUARE STEEL (IN)			TUBULAR STEEL Ø (IN)				SIGN FRAME REQUIRED	REMARKS	SIGN DETAIL LOCATION			
								"A"	"B"	RETAIN	SALVAGE FROM	SALVAGE TO	REMOVE	RETAIN	REMOVE		1.75	2.00	2.50	FOUNDATION	3.00	3.50	4.00			5.00	SHSM	PROJECT SHEET #	STANDARD SHEET #
																	(LB / FT)				(LB / FT)								
																	1.88	2.42	3.35		7.60	9.00	10.80			14.60			
JAMAICA VT-30 SB							FY-FLUORESCENT YELLOW FYG-FLUORESCENT YELLOW GREEN															"SHSM"-STANDARD HIGHWAY SIGNS AND MARKINGS							
SB	1.952	G	VR-017	24	24								1	X									RIVER RD (TH-41)						
		G	VR-017	24	30			5.00															INSTALL ON EXISTING FLANGED CHANNEL SIGN POST.		6				
		G	UNK	18	24		CHILDREN AT PLAY						1										REMOVE NON-COMPLIANT SIGN.						
SB	1.945	G H	VD-700 R1-1	6 30	10 30									1	X								RIVER RD (TH-41)						
		H	R1-1	30	30			6.25															INSTALL ON EXISTING FLANGED CHANNEL SIGN POST.	X					
SB	1.945	F	D3-1	UNK	UNK									1		X							RIVER RD (TH-41)						
		F	D3-1	44	12			3.67							2	11'-0" 11'-6" X							ANCHORS IN LEDGE		11				
SB	1.856	F	VW-619	30	30		SHOULDER NARROWS						1		X														
SB	1.704	F	VW-619	36	36			9.00							2	12'-10" 13'-8" X							INSTALL 800 FEET SOUTH OF EXISTING SHOULDER NARROWS SIGN ASSEMBLY.		7				
SB	0.834	F	M2-1	21	15		JCT			1				X															
		F	M1-5	30	24		VERMONT ROUTE 100			1																			
SB	0.789	F	D1-1A	72	10		DESTINATION SIGN ASSEMBLY			1				X															
		F	D1-1A	72	10					1																			
		F	D1-1A	72	10					1																			
		F	D1-1A	72	10					1																			
SIGN SUMMARY SHEET							SHEET TOTALS	23.92	0.00	~~7~~ 6	0	0	5	0	0	4	60.0		0	0.0	0.0	0.0	0.0	PROJECT NAME: STATEWIDE SOUTHWEST REGION					
								SF	SF		EA	EA	EA	EA	EA	EA	FT		EA	LB	LB	LB	LB	PROJECT NUMBER: STPG SIGN(41)					
																								FILE NAME: 12C118					
VERMONT AGENCY OF TRANSPORTATION																									PROJECT MANAGER: A. GAMBLE				
																												DRAWN BY: J. KELLY	
																								CHECKED: A. GAMBLE					
																									SHEET 54 OF 97				
																								JAMAICA SB SHEET 12					


DIRECTION	MILEPOINT	LOCATION CODE (SHEET 2)	SIGN CODE	WIDTH (IN)	HEIGHT (IN)	SHEETING REMARKS	SIGN LEGEND	NEW SIGNS		EXISTING SIGNS				EXIST POST		NUMBER OF NEW POSTS	SQUARE STEEL (IN)			TUBULAR STEEL Ø (IN)				SIGN FRAME REQUIRED	REMARKS	SIGN DETAIL LOCATION					
								"A"	"B"	RETAIN	SALVAGE FROM	SALVAGE TO	REMOVE	RETAIN	REMOVE		1.75	2.00	2.50	FOUNDATION	3.00	3.50	4.00			5.00	SHSM	PROJECT SHEET #	STANDARD SHEET #		
																	(LB / FT)				(LB / FT)										
																	1.88	2.42	3.35		7.60	9.00	10.80			14.60					
JAMAICA VT-30 SB							FY-FLUORESCENT YELLOW FYG-FLUORESCENT YELLOW GREEN															"SHSM"-STANDARD HIGHWAY SIGNS AND MARKINGS									
SB	0.733	F	M3-3	24	12		ROUTE MARKER ASSEMBLY			1				X																	
		F	M1-5	24	24					1																					
		F	M6-3	21	15					1																					
		F	M3-3	24	12					1																					
		F	M1-5	30	24					1																					
		F	M6-1	21	15					1																					
SB	0.649	F	M3-3	24	12		SOUTH			1				X																	
		F	M1-5	24	24		VERMONT ROUTE 30			1																					
SB	0.609	F	D2-1	72	10		DESTINATION SIGN ASSEMBLY			1				X																	
		F	D2-1	72	10					1																					
SB	0.570	F	R2-1	24	30								1	X																	
		F	R2-1	24	30			5.00																INSTALL ON EXISTING FLANGED CHANNEL SIGN POST.	X						
SB	0.487	F	W11-3A	30	30		DEER CROSSING TEXT						1	X																	
		F	W7-3A	24	18								1																		
		F	W11-3A	30	30			6.25																INSTALL SIGNS ON EXISTING FLANGED CHANNEL SIGN POST.	X						
SIGN SUMMARY SHEET							SHEET TOTALS		11.25	0.00	10	0	0	3	0	0	0	0.0			0	0.0	0.0	0.0	0.0	PROJECT NAME: STATEWIDE SOUTHWEST REGION					
									SF	SF	EA	EA	EA	EA	EA	EA		FT		EA	LB	LB	LB	LB				PROJECT NUMBER: STPG SIGN(41)			
																									FILE NAME: 12C118			PLOT DATE: 2/13/2013			
																									PROJECT MANAGER: A. GAMBLE			DRAWN BY: J. KELLY			
VERMONT AGENCY OF TRANSPORTATION							TOWN DIRECTIONAL TOTALS		431.84 430.2	0.0	31 29	2 0	2 0	85 82	0	0	66 63	990.0 945.0			0	0.0				DESIGNED BY: J. KELLY			CHECKED A. GAMBLE		
																									JAMAICA SB SHEET 13			SHEET 55 OF 97			



[illegible]

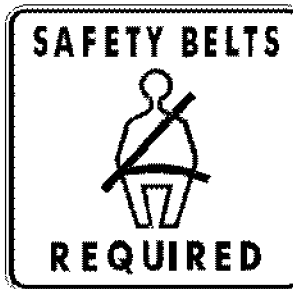
DIRECTION	MILEPOINT	LOCATION CODE (SHEET 2)	SIGN CODE	WIDTH (IN)	HEIGHT (IN)	SHEETING REMARKS	SIGN LEGEND	NEW SIGNS		EXISTING SIGNS				EXIST POST		NUMBER OF NEW POSTS	SQUARE STEEL (IN)			TUBULAR STEEL Ø (IN)				SIGN FRAME REQUIRED	REMARKS	SIGN DETAIL LOCATION			
								"A"	"B"	RETAIN	SALVAGE FROM	SALVAGE TO	REMOVE	RETAIN	REMOVE		1.75	2.00	2.50	FOUNDATION	3.00	3.50	4.00			5.00	SHSM	PROJECT SHEET #	STANDARD SHEET #
																	(LB / FT)				(LB / FT)								
																	1.88	2.42	3.35		7.60	9.00	10.80			14.60			
WELLS VT-31 NB							FY-FLUORESCENT YELLOW FYG-FLUORESCENT YELLOW GREEN															"SHSM"-STANDARD HIGHWAY SIGNS AND MARKINGS							
NB	0.000	B	VR-040	24	24		THROUGH WAY ENDS HERE						1		X														
		A	VR-041	24	24		THROUGH WAY BEGINS HERE						1																
		A	R2-1	24	30								1																
		A	VR-039	24	18			3.00							1		15'-0" X										6		
		A	R2-1	24	30		 	5.00																		X			
		B	VR-038	24	18			3.00																			6		
NB	0.025	A	VD-421	60	48			20.00							2		10'-7" 10'-7" X								INSTALL AT NORTH END OF PULL-OFF, NORTH OF TRAFFIC COUNTER..		5		
NB	0.061	A	M3-1	24	12								1		X														
		A	M1-5	24	24								1																
		A	M3-1	24	12			2.00							1		14'-0" X											E-136B	
		A	M1-5	24	24			4.00																			E-136B		
NB	0.095	A	VR-048	24	30		STATE LAW STOP FOR SCHOOL BUS						1		X														
		A	VR-654	24	24			4.00							1		14'-0" X										6		
NB	0.187	A	VR-601A	24	30		BUCKLE UP IT'S THE LAW						1	X															
		A	VR-601	36	36			9.00																	INSTALL NEW ON EXISTING FLANGED CHANNEL POST BEHIND RAIL.		6		
SIGN SUMMARY SHEET							SHEET TOTALS	50.00	0.00	0	0	0	7	0	0	5	75.0			0	0.0	0.0	0.0	0.0	PROJECT NAME: STATEWIDE SOUTHWEST REGION				
								SF	SF	EA	EA	EA	EA	EA	EA	EA		FT		EA	LB	LB	LB	LB	PROJECT NUMBER: STPG SIGN(41)				
																											FILE NAME: 12C118		
VERMONT AGENCY OF TRANSPORTATION							TOWN DIRECTIONAL TOTALS	136.7	0.0	0	0	0	31 ~~30~~	0	0	19	285.0			0	0.0				PROJECT MANAGER: A. GAMBLE				
																										DRAWN BY: J. KELLY			
																										CHECKED A. GAMBLE			
																						DESIGNED BY: J. KELLY							
																						WELLS NB SHEET 1							
																						PLOT DATE: 2/13/2013							
																						SHEET 57 OF 97							

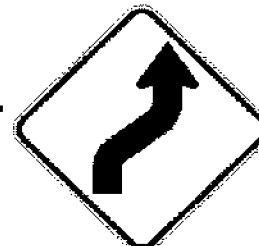DIRECTION	MILEPOINT	LOCATION CODE (SHEET 2)	SIGN CODE	WIDTH (IN)	HEIGHT (IN)	SHEETING REMARKS	SIGN LEGEND	NEW SIGNS		EXISTING SIGNS				EXIST POST		NUMBER OF NEW POSTS	SQUARE STEEL (IN)			TUBULAR STEEL Ø (IN)					SIGN FRAME REQUIRED	REMARKS	SIGN DETAIL LOCATION		
								"A"	"B"	RETAIN	SALVAGE FROM	SALVAGE TO	REMOVE	RETAIN	REMOVE		1.75	2.00	2.50	FOUNDATION	3.00	3.50	4.00	5.00			SHSM	PROJECT SHEET #	STANDARD SHEET #
																	(LB / FT)				(LB / FT)								
																	1.88	2.42	3.35		7.60	9.00	10.80	14.60					
WELLS VT-31 NB							FY-FLUORESCENT YELLOW FYG-FLUORESCENT YELLOW GREEN															"SHSM"-STANDARD HIGHWAY SIGNS AND MARKINGS							
NB	0.266	A	VR-654	24	24		NO DWI							1	X														
		A	VR-655	24	18		STRICTLY ENFORCED							1															
NB	0.342	A	W1-4R	30	30		RIGHT REVERSE CURVE							1	X														
		A	W13-1	18	18		35 MPH ADVISORY							1															
NB	0.400	A	VW-060	30	30									1	X														
		A	VW-060	30	30			6.25																	INSTALL ON EXISTING FLANGED CHANNEL SIGN POST.		7		
NB	0.438	A	W1-4R	30	30			6.25								1		16'-0" X							INSTALL 200 FEET NORTH OF HIDDEN DRIVES SIGN ASSEMBLY.	X			
		A	W13-1P	18	18			2.25																		X			
NB	0.593	A	R2-1	24	30									1	X														
		A	R2-1	24	30			5.00								1		14'-0" X								X			
NB	0.800	C	VD-700	6	10		RIGHT REVERSE CURVE						1		X														
NB	1.085	A	W1-4R	30	30		RIGHT REVERSE CURVE							1	X														
		A	W13-1	18	18		35 MPH ADVISORY							1															
NB	1.135	A	W1-4R	30	30			6.25								1		15'-0" X							INSTALL 260 FEET NORTH OF EXISTING ASSEMBLY.	X			
NB	1.270	D	R1-1	30	30								~~1~~	~~X~~										HILL TOP RD (TH-11) SOUTHERLY LEG.	SIGN ASSEMBLY NOT FOUND IN THE FIELD				
SIGN SUMMARY SHEET							SHEET TOTALS	26.00	0.00	0	0	0	10	0	0	3	45.0			0	0.0	0.0	0.0	0.0	PROJECT NAME: STATEWIDE SOUTHWEST REGION				
								SF	SF	EA	EA	EA	EA	EA	EA	EA		FT		EA	LB	LB	LB	LB	PROJECT NUMBER: STPG SIGN(41)				
																									FILE NAME: 12C118				
							VERMONT AGENCY OF TRANSPORTATION																			PROJECT MANAGER: A. GAMBLE			
TOWN DIRECTIONAL TOTALS																								DESIGNED BY: J. KELLY					
																									WELLS NB SHEET 2				
																								PLOT DATE: 2/13/2013					
																								DRAWN BY: J. KELLY					
																								CHECKED: A. GAMBLE					
																								SHEET 58 OF 97					

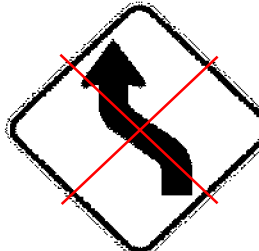
DIRECTION	MILEPOINT	LOCATION CODE (SHEET 2)	SIGN CODE	WIDTH (IN)	HEIGHT (IN)	SHEETING REMARKS	SIGN LEGEND	NEW SIGNS		EXISTING SIGNS				EXIST POST		NUMBER OF NEW POSTS	SQUARE STEEL (IN)			TUBULAR STEEL Ø (IN)					SIGN FRAME REQUIRED	REMARKS	SIGN DETAIL LOCATION		
								"A"	"B"	RETAIN	SALVAGE FROM	SALVAGE TO	REMOVE	RETAIN	REMOVE		1.75	2.00	2.50	FOUNDATION	3.00	3.50	4.00	5.00			SHSM	PROJECT SHEET #	STANDARD SHEET #
																	(LB / FT)				(LB / FT)								
																	1.88	2.42	3.35		7.60	9.00	10.80	14.60					
WELLS VT-31 NB							FY-FLUORESCENT YELLOW FYG-FLUORESCENT YELLOW GREEN															"SHSM"-STANDARD HIGHWAY SIGNS AND MARKINGS							
		D	R1-1	30	30			6.25							1	13'-10" X							INSTALL IN ISLAND.	X					
NB	1.270	A	D3-1	38	12			3.17							2	14'-6" 14'-8" X							HILL TOP RD (TH-11) FIELD LOCATE AND INSTALL IN ISLAND.		12				
NB	1.280	C	VR-017	24	24								1		X								HILL TOP RD (TH-11).						
		C	VR-017	24	30			5.00							1	13'-9" X							INSTALL WHERE BOTH LEGS COME TOGETHER.		6				
NB	1.285	D	R1-1	30	30			6.25							1	14'-2" X							HILL TOP RD (TH-11) NORTHERLY LEG.	X					
NB	1.330	A	R2-1	24	30			5.00							1	14'-7" X							INSTALL NEW SIGN 475 FEET SOUTH OF EXISTING SPEED LIMIT 50 ASSEMBLY.	X					
NB	1.420	A	R2-1	24	30		SPEED LIMIT 45 MPH						1		X														
NB	1.490	A	W1-2L	30	30		LEFT CURVE						1		X														
		A	W13-1	18	18		35 MPH ADVISORY						1																
NB	1.540	A	W1-2L	30	30	FY		6.25								1	15'-3" X							INSTALL 265 FEET NORTH OF EXISTING LEFT CURVE SIGN ASSEMBLY.	X				
		A	W13-1P	18	18	FY		2.25																	X				
NB	1.565	A	W1-8L	18	24								1		X														
		B	W1-8R	18	24								1																
		A	W1-8L	18	24	FY		3.00								1	14'-4" X							INSTALL SIGNS BACK TO BACK ON SAME SIGN POST.	X				
		B	W1-8R	18	24	FY		3.00																	X				
SIGN SUMMARY SHEET							SHEET TOTALS	40.17	0.00	0	0	0	6	0	0	8	120.0			0	0.0	0.0	0.0	0.0	PROJECT NAME: STATEWIDE SOUTHWEST REGION				
								SF	SF	EA	EA	EA	EA	EA	EA	EA		FT		EA	LB	LB	LB	LB	PROJECT NUMBER: STPG SIGN(41)				
																											FILE NAME: 12C118		
VERMONT AGENCY OF TRANSPORTATION							TOWN DIRECTIONAL TOTALS	136.7	0.0	0	0	0	31 ~~30~~	0	0	19	285.0			0	0.0				PROJECT MANAGER: A. GAMBLE				
																										DRAWN BY: J. KELLY			
																										DESIGNED BY: J. KELLY			
																						CHECKED: A. GAMBLE							
																							WELLS NB SHEET 3						
																							PLOT DATE: 2/13/2013						
																							SHEET 59 OF 97						



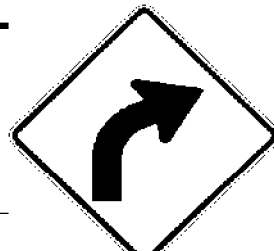
DIRECTION	MILEPOINT	LOCATION CODE (SHEET 2)	SIGN CODE	WIDTH (IN)	HEIGHT (IN)	SHEETING REMARKS	SIGN LEGEND	NEW SIGNS		EXISTING SIGNS				EXIST POST		NUMBER OF NEW POSTS	SQUARE STEEL (IN)			TUBULAR STEEL Ø (IN)					SIGN FRAME REQUIRED	REMARKS	SIGN DETAIL LOCATION		
								"A"	"B"	RETAIN	SALVAGE FROM	SALVAGE TO	REMOVE	RETAIN	REMOVE		1.75	2.00	2.50	FOUNDATION	3.00	3.50	4.00	5.00			SHSM	PROJECT SHEET #	STANDARD SHEET #
																	(LB / FT)				(LB / FT)								
																	1.88	2.42	3.35		7.60	9.00	10.80	14.60					
WELLS VT-31 NB							FY-FLUORESCENT YELLOW FYG-FLUORESCENT YELLOW GREEN															"SHSM"-STANDARD HIGHWAY SIGNS AND MARKINGS							
NB	1.585	A	W1-8L	18	24										X														
		B	W1-8R	18	24																								
		A	W1-8L	18	24	FY		3.00								1	13'-3" X							INSTALL SIGNS BACK TO BACK ON SAME SIGN POST.	X				
		B	W1-8R	18	24	FY		3.00																		X			
NB	1.595	A	VD-700 S3-1T	6 30	10 30		SCHOOL BUS STOP AHEAD 						1		X														
NB	1.601	A	W1-8L	18	24										X														
		B	W1-8R	18	24																								
		A	W1-8L	18	24	FY		3.00								1	14'-8" X							INSTALL SIGNS BACK TO BACK ON SAME SIGN POST.	X				
		B	W1-8R	18	24	FY		3.00																		X			
NB	1.630	A	W1-2R	30	30		RIGHT CURVE								X														
		A	W13-1	18	18		35 MPH ADVISORY																						
NB	1.680	A	W1-2R	30	30	FY		6.25								1	14'-3" X							INSTALL 250 NORTH OF EXISTING RIGHT CURVE SIGN ASSEMBLY.	X				
		A	W13-1P	18	18	FY		2.25																		X			
SIGN SUMMARY SHEET							SHEET TOTALS	20.50	0.00	0	0	0	87	0	0	3	45.0	0	0.0	0.0	0.0	0.0	PROJECT NAME: STATEWIDE SOUTHWEST REGION	PROJECT NUMBER: STPG SIGN(41)					
								SF	SF	EA	EA	EA	EA	EA	EA	EA	FT	EA	LB	LB	LB	LB	FILE NAME: 12C118				PROJECT MANAGER: A. GAMBLE	PLOT DATE: 2/13/2013	
							VERMONT AGENCY OF TRANSPORTATION	TOWN DIRECTIONAL TOTALS	136.7	0.0	0	0	0	3130	0	0	19	285.0	0	0.0				DESIGNED BY: J. KELLY	WELLS NB SHEET 4	DRAWN BY: J. KELLY	CHECKED: A. GAMBLE	SHEET 60 OF 97	

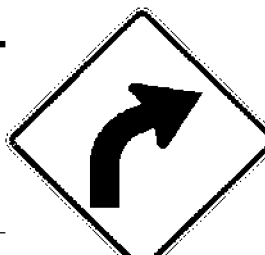
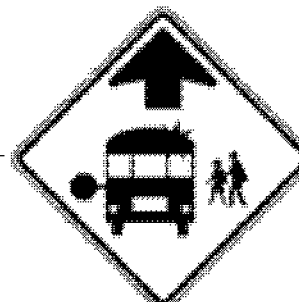
DIRECTION	MILEPOINT	LOCATION CODE (SHEET 2)	SIGN CODE	WIDTH (IN)	HEIGHT (IN)	SHEETING REMARKS	SIGN LEGEND	NEW SIGNS		EXISTING SIGNS				EXIST POST		NUMBER OF NEW POSTS	SQUARE STEEL (IN)			TUBULAR STEEL Ø (IN)					SIGN FRAME REQUIRED	REMARKS	SIGN DETAIL LOCATION		
								"A"	"B"	RETAIN	SALVAGE FROM	SALVAGE TO	REMOVE	RETAIN	REMOVE		1.75	2.00	2.50	FOUNDATION	3.00	3.50	4.00	5.00			SHSM	PROJECT SHEET #	STANDARD SHEET #
																	(LB / FT)				(LB / FT)								
																	1.88	2.42	3.35		7.60	9.00	10.80	14.60					
WELLS VT-31 SB							FY-FLUORESCENT YELLOW FYG-FLUORESCENT YELLOW GREEN															"SHSM"-STANDARD HIGHWAY SIGNS AND MARKINGS							
SB	1.738	F	W1-8L	18	24																								
		E	W1-8R	18	24																								
		F	W1-8L	18	24	FY		3.00								1	14'-3" X							INSTALL SIGNS BACK TO BACK ON SAME SIGN POST.	X				
		E	W1-8R	18	24	FY		3.00																		X			
SB	1.710	F	W1-8	18	24																			SIGN ASSEMBLY NOT FOUND IN THE FIELD					
		E	W1-8	18	24																								
		F	W1-8L	18	24	FY		3.00								1	14'-5" X							INSTALL SIGNS BACK TO BACK ON SAME SIGN POST.	X				
		E	W1-8R	18	24	FY		3.00																		X			
SB	1.680	F	W1-2R	30	30		RIGHT CURVE																						
		F	W13-1	18	18		35 MPH ADVISORY																						
SB	1.660	F	W1-2R	30	30	FY		6.25								1	15'-2" X							INSTALL 100 FEET SOUTH OF EXISTING RIGHT CURVE SIGN ASSEMBLY.	X				
		F	W13-1P	18	18	FY		2.25																		X			
SB	1.630	F	S3-1T	30	30		SCHOOL BUS STOP AHEAD																						
		F	S3-1	36	36	FYG		9.00								2	14'-6" 14'-2" X									X			
SB	1.465	F	R2-1	24	30																								
SIGN SUMMARY SHEET							SHEET TOTALS		29.50	0.00	0	0	0	6 8	0	0	5	75.0		0	0.0	0.0	0.0	0.0	PROJECT NAME: STATEWIDE SOUTHWEST REGION				
									SF	SF	EA	EA	EA	EA	EA	EA	EA		FT		EA	LB	LB	LB	LB	PROJECT NUMBER: STPG SIGN(41)			
																											FILE NAME: 12C118		
									TOWN DIRECTIONAL TOTALS						75.8	0.0	1	0	0	15 18	0	0	11	165.0		0	0.0		PROJECT MANAGER: A. GAMBLE
VERMONT AGENCY OF TRANSPORTATION																							DESIGNED BY: J. KELLY			PLOT DATE: 2/13/2013			
																							WELLS SB SHEET 1			DRAWN BY: J. KELLY			
																							CHECKED: A. GAMBLE			SHEET 61 OF 97			


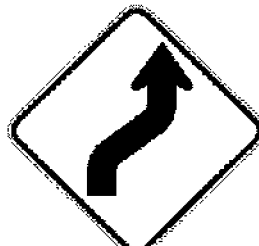
DIRECTION	MILEPOINT	LOCATION CODE (SHEET 2)	SIGN CODE	WIDTH (IN)	HEIGHT (IN)	SHEETING REMARKS	SIGN LEGEND	NEW SIGNS		EXISTING SIGNS				EXIST POST		NUMBER OF NEW POSTS	SQUARE STEEL (IN)			TUBULAR STEEL Ø (IN)					SIGN FRAME REQUIRED	REMARKS	SIGN DETAIL LOCATION		
								"A"	"B"	RETAIN	SALVAGE FROM	SALVAGE TO	REMOVE	RETAIN	REMOVE		1.75	2.00	2.50	FOUNDATION	3.00	3.50	4.00	5.00			SHSM	PROJECT SHEET #	STANDARD SHEET #
																	(LB / FT)				(LB / FT)								
																	1.88	2.42	3.35		7.60	9.00	10.80	14.60					
WELLS VT-31 SB							FY-FLUORESCENT YELLOW FYG-FLUORESCENT YELLOW GREEN															"SHSM"-STANDARD HIGHWAY SIGNS AND MARKINGS							
		F	R2-1	24	30			5.00							1		12'-5" X								X				
SB	1.360	F	W1-4R	30	30		RIGHT REVERSE CURVE						1		X														
		F	W13-1	18	18		35 MPH ADVISORY						1																
SB	1.300	F	W1-4R	30	30			6.25							1		14'-2" X							INSTALL 325 FEET SOUTH OF EXISTING REVERSE CURVE ASSEMBLY.	X				
SB	1.070	F	W1-4R	30	30		RIGHT REVERSE CURVE						1		X														
SB	0.765	F	W11-5	30	30		FARM MACHINERY					~~1~~		~~X~~									SIGN ASSEMBLY NOT FOUND IN THE FIELD						
		F	R2-1	24	30			5.00							1		14'-7" X								X				
SB	0.710	F	R2-1	24	30		SPEED LIMIT 45						1		X														
SB	0.670	F	W1-4R	30	30		RIGHT REVERSE CURVE						1		X														
		F	W13-1	18	18		35 MPH ADVISORY						1																
SB	0.625	F	VW-060	30	30								1	~~X~~	X														
		F	VW-060	30	30			6.25							1		11'-0" X							~~INSTALL ON EXISTING FLANGED CHANNEL SIGN POST.~~			7		
SB	0.587	F	W1-4R	30	30			6.25								1		15'-0" X						INSTALL 200 FEET SOUTH OF HIDDEN DRIVES SIGN ASSEMBLY.	X				
		F	W13-1P	18	18			2.25																	X				
SB		F	S3-1T	30	30		NEW YORK INSTALLED SCHOOL BUS STOP AHEAD			1				X										EXACT MILE POINT UNKNOWN. RETAIN ASSEMBLY.					
SIGN SUMMARY SHEET							SHEET TOTALS		31.00	0.00	1	0	0	~~7~~ 8	0	0	4	60.0			0	0.0	0.0	0.0	0.0	PROJECT NAME: STATEWIDE SOUTHWEST REGION			
									SF	SF	EA	EA	EA	EA	EA	EA	EA		FT		EA	LB	LB	LB	LB	PROJECT NUMBER: STPG SIGN(41)			
																											FILE NAME: 12C118		
									TOWN DIRECTIONAL TOTALS						75.8	0.0	1	0	0	~~15~~ 18	0	0	11	165.0			0	0.0	
VERMONT AGENCY OF TRANSPORTATION																									PLOT DATE: 2/13/2013				
																											DRAWN BY: J. KELLY		
																											CHECKED: A. GAMBLE		
																							DESIGNED BY: J. KELLY						
																								WELLS SB SHEET 2					
																								SHEET 62 OF 97					



[illegible]


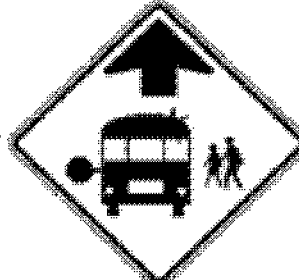
DIRECTION	MILEPOINT	LOCATION CODE (SHEET 2)	SIGN CODE	WIDTH (IN)	HEIGHT (IN)	SHEETING REMARKS	SIGN LEGEND	NEW SIGNS		EXISTING SIGNS				EXIST POST		NUMBER OF NEW POSTS	SQUARE STEEL (IN)			TUBULAR STEEL Ø (IN)					SIGN FRAME REQUIRED	REMARKS	SIGN DETAIL LOCATION							
								"A"	"B"	RETAIN	SALVAGE FROM	SALVAGE TO	REMOVE	RETAIN	REMOVE		1.75	2.00	2.50	FOUNDATION	3.00	3.50	4.00	5.00			SHSM	PROJECT SHEET #	STANDARD SHEET #					
																	(LB / FT)				(LB / FT)													
																	1.88	2.42	3.35		7.60	9.00	10.80	14.60										
POULTNEY VT-31 NB							FY-FLUORESCENT YELLOW FYG-FLUORESCENT YELLOW GREEN															"SHSM"-STANDARD HIGHWAY SIGNS AND MARKINGS												
NB	0.000	C	VD-700 VD-024	60	10 7.5		MILE MARKERS (2) Poultney Wells						2 1		X			10'-0" 10'-0" X																
		C	VD-024	72	10		0310 1117 0000	5.00																					ANCHORS IN LEDGE		8			
		C	VD-700	6	10			0.42																							E-138			
		C	VD-700	6	10		0310 1126 0176	0.42																									E-138	
NB	0.270	A	R2-1	24	30								1		X																			
		A	R2-1	24	30		SPEED LIMIT 45	5.00									1		14'-0" X												X			
NB	0.340	A	UNK				UNKNOWN MISSING SIGN						~~1~~		~~X~~													EMPTY POST NOT FOUND IN FIELD ~~REMOVE EMPTY SIGN POST.~~						
NB	0.570	A	W11-5	30	30			6.25					1	X																				
		A	W11-5	30	30																									X				
NB	0.710	A	R2-1	24	30								1		X																			
		A	R2-1	24	30		SPEED LIMIT 45	5.00									1		15'-6" X												X			
		A	W8-9	30	30		LOW SHOULDERS						1																					
NB	0.768	A	S3-1T	30	30		SCHOOL BUS STOP AHEAD						1	X																				
		A	VW-054L	30	30		HIDDEN DRIVE LEFT						1																					
		A	S3-1	36	36	FYG		9.00																								X		
SIGN SUMMARY SHEET							SHEET TOTALS	31.09	0.00	0	0	0	~~9~~ 8	0	0	4	60.0			0	0.0	0.0	0.0	0.0	PROJECT NAME: STATEWIDE SOUTHWEST REGION									
								SF	SF	EA	EA	EA	EA	EA	EA	EA		FT		EA	LB	LB	LB	LB	PROJECT NUMBER: STPG SIGN(41)									
																												FILE NAME: 12C118						
																												PROJECT MANAGER: A. GAMBLE						
VERMONT AGENCY OF TRANSPORTATION							TOWN DIRECTIONAL TOTALS	~~248.2~~ 243.2	0.0	2	0	0	~~60~~ 57	0	0	~~27~~ 25	~~405.0~~ 375.0			0	0.0				DESIGNED BY: J. KELLY									
																						POULTNEY NB SHEET 1			PLOT DATE: 2/13/2013									
																						DRAWN BY: J. KELLY												
																						CHECKED: A. GAMBLE												
																						SHEET 64 OF 97												

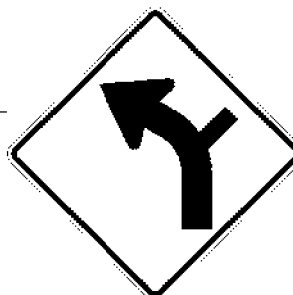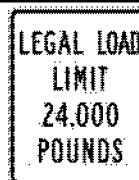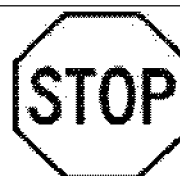DIRECTION	MILEPOINT	LOCATION CODE (SHEET 2)	SIGN CODE	WIDTH (IN)	HEIGHT (IN)	SHEETING REMARKS	SIGN LEGEND	NEW SIGNS		EXISTING SIGNS				EXIST POST		NUMBER OF NEW POSTS	SQUARE STEEL (IN)			TUBULAR STEEL Ø (IN)				SIGN FRAME REQUIRED	REMARKS	SIGN DETAIL LOCATION			
								"A"	"B"	RETAIN	SALVAGE FROM	SALVAGE TO	REMOVE	RETAIN	REMOVE		1.75	2.00	2.50	FOUNDATION	3.00	3.50	4.00			5.00	SHSM	PROJECT SHEET #	STANDARD SHEET #
																	(LB / FT)				(LB / FT)								
																	1.88	2.42	3.35		7.60	9.00	10.80			14.60			
POULTNEY VT-31 NB							FY-FLUORESCENT YELLOW FYG-FLUORESCENT YELLOW GREEN															"SHSM"-STANDARD HIGHWAY SIGNS AND MARKINGS							
NB	0.812	A	W1-2ML	30	30		MODIFIED LEFT CURVE						1		X								REMOVE ENTIRE SIGN ASSEMBLY.						
		A	W13-1	18	18		35 MPH ADVISORY						1																
		A	W1-10L	36	36	FY		9.00								2	15'-1" 15'-5" X						INSTALL 125 FEET NORTH OF EXISTING CURVE WARNING SIGN ASSEMBLY.	X					
		A	W13-1P	18	18	FY		2.25																X					
NB	0.847	A	D3-1	UNK	UNK		RUBY RD STREET SIGN						1		X														
NB	0.848	C	VR-017	24	24								1	X	X								RUBY RD (TH-8)						
		C	VR-017	24	30			5.00								1	14'-4" X							~~INSTALL SIGN ON EXISTING FLANGED CHANNEL SIGN POST.~~		6			
NB	0.860	A	D3-1	32	12			2.66															RUBY RD (TH-8) INSTALL ABOVE STOP SIGN.		12				
		D	R1-1	30	30								1	X	X														
		D	R1-1	30	30			6.25								1	13'-6" X												
NB	0.878	A	W1-8L	18	24								1	X															
		A	W1-8L	18	24	FY		3.00															INSTALL ON EXISTING FLANGED CHANNEL SIGN POST.	X					
NB	0.878	B	W1-8R	18	24								1	X															
		B	W1-8R	18	24	FY		3.00															INSTALL ON EXISTING FLANGED CHANNEL SIGN POST.	X					
NB	0.902	A	W1-8L	18	24								1	X															
SIGN SUMMARY SHEET							SHEET TOTALS		31.16	0.00	0	0	0	8	0	0	~~4~~ ~~-2~~	~~60.0~~ ~~-30.0~~	0	0.0	0.0	0.0	0.0	PROJECT NAME: STATEWIDE SOUTHWEST REGION	PROJECT NUMBER: STPG SIGN(41)				
									SF	SF	EA	EA	EA	EA	EA	EA		FT		EA	LB	LB	LB	LB	FILE NAME: 12C118	PLOT DATE: 2/13/2013			
																									PROJECT MANAGER: A. GAMBLE	DRAWN BY: J. KELLY			
							VERMONT AGENCY OF TRANSPORTATION		TOWN DIRECTIONAL TOTALS		~~248.2~~ ~~243.2~~	0.0	2	0	0	~~60~~ ~~-57~~	0	0	~~27~~ ~~-25~~	~~405.0~~ ~~375.0~~	0	0.0				DESIGNED BY: J. KELLY	CHECKED A. GAMBLE		
																					POULTNEY NB SHEET 2			SHEET 65	OF 97				

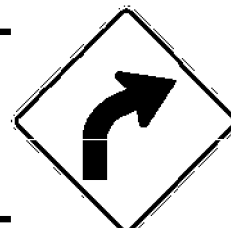
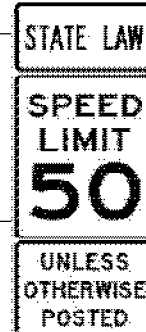
DIRECTION	MILEPOINT	LOCATION CODE (SHEET 2)	SIGN CODE	WIDTH (IN)	HEIGHT (IN)	SHEETING REMARKS	SIGN LEGEND	NEW SIGNS		EXISTING SIGNS				EXIST POST		NUMBER OF NEW POSTS	SQUARE STEEL (IN)			TUBULAR STEEL Ø (IN)					SIGN FRAME REQUIRED	REMARKS	SIGN DETAIL LOCATION		
								"A"	"B"	RETAIN	SALVAGE FROM	SALVAGE TO	REMOVE	RETAIN	REMOVE		1.75	2.00	2.50	FOUNDATION	3.00	3.50	4.00	5.00			SHSM	PROJECT SHEET #	STANDARD SHEET #
																	(LB / FT)				(LB / FT)								
																	1.88	2.42	3.35		7.60	9.00	10.80	14.60					
POULTNEY VT-31 NB							FY-FLUORESCENT YELLOW FYG-FLUORESCENT YELLOW GREEN															"SHSM"-STANDARD HIGHWAY SIGNS AND MARKINGS							
		A	W1-8L	18	24	FY		3.00															INSTALL ON EXISTING FLANGED CHANNEL SIGN POST.	X					
NB	0.902	B	W1-8R	18	24							1	X																
		B	W1-8R	18	24	FY		3.00															INSTALL ON EXISTING FLANGED CHANNEL SIGN POST.	X					
NB	0.920	A	W1-8L	18	24							1	X																
		A	W1-8L	18	24	FY		3.00															INSTALL ON EXISTING FLANGED CHANNEL SIGN POST.	X					
NB	0.920	B	W1-8R	18	24							1	X																
		B	W1-8R	18	24	FY		3.00															INSTALL ON EXISTING FLANGED CHANNEL SIGN POST.	X					
NB	0.961	A	W1-2R	30	30		RIGHT CURVE					1		X															
		A	W13-1	18	18		35 MPH					1																	
NB	1.065	A	W1-2R	30	30			6.25							1	14'-10" X							INSTALL 550 FEET NORTH OF EXISTING RIGHT CURVE SIGN ASSEMBLY.	X					
NB	1.225	A	VW16-18P	24	12	FY		2.00							1	15'-4" X							INSTALL 75 FEET SOUTH OF EXISTING SPEED LIMIT 50 SIGN ASSEMBLY.		6				
		A	R2-1	24	30			5.00																X					
		A	R2-5P	24	18			3.00																X					
NB	1.240	A	R2-1	24	30		SPEED LIMIT 50					1		X															
		A	VR-208	24	24		UNLESS OTHERWISE POSTED					1																	
SIGN SUMMARY SHEET							SHEET TOTALS	28.25	0.00	0	0	0	7	0	0	2	30.0			0	0.0	0.0	0.0	0.0	PROJECT NAME: STATEWIDE SOUTHWEST REGION				
								SF	SF	EA	EA	EA	EA	EA	EA	EA		FT		EA	LB	LB	LB	LB	PROJECT NUMBER: STPG SIGN(41)				
																											FILE NAME: 12C118		
VERMONT AGENCY OF TRANSPORTATION							TOWN DIRECTIONAL TOTALS	248.2 243.2	0.0	2	0	0	60 57	0	0	27 25	405.0 375.0			0	0.0				PROJECT MANAGER: A. GAMBLE				
																											PLOT DATE: 2/13/2013		
																											DRAWN BY: J. KELLY		
																							DESIGNED BY: J. KELLY						
																											CHECKED: A. GAMBLE		
																							POULTNEY NB SHEET 3						
																											SHEET 66 OF 97		

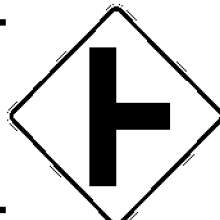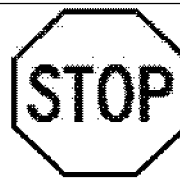DIRECTION	MILEPOINT	LOCATION CODE (SHEET 2)	SIGN CODE	WIDTH (IN)	HEIGHT (IN)	SHEETING REMARKS	SIGN LEGEND	NEW SIGNS		EXISTING SIGNS				EXIST POST		NUMBER OF NEW POSTS	SQUARE STEEL (IN)			TUBULAR STEEL Ø (IN)					SIGN FRAME REQUIRED	REMARKS	SIGN DETAIL LOCATION			
								"A"	"B"	RETAIN	SALVAGE FROM	SALVAGE TO	REMOVE	RETAIN	REMOVE		1.75	2.00	2.50	FOUNDATION	3.00	3.50	4.00	5.00			SHSM	PROJECT SHEET #	STANDARD SHEET #	
																	(LB / FT)				(LB / FT)									
																	1.88	2.42	3.35		7.60	9.00	10.80	14.60						
POULTNEY VT-31 NB							FY-FLUORESCENT YELLOW FYG-FLUORESCENT YELLOW GREEN															"SHSM"-STANDARD HIGHWAY SIGNS AND MARKINGS								
NB	2.003	A	VD-700 W2-2R	6 30	10 30		RIGHT SIDE ROAD 						1		X															
NB	2.050	A	W2-2R	30	30			6.25								1		13'-5" X						INSTALL 250 NORTH OF EXISTING RIGHT SIDE ROAD SIGN ASSEMBLY.	X					
NB	2.128	C	VR-079	24	30								1		X									UPPER RD (TH-11)						
		C	VR-079	24	30			5.00								1		12'-9" X									6			
NB	2.132	C D	VD-700 R1-1	6 30	10 30					1			1	X										UPPER RD (TH-11)						
		D	R1-1	30	30			6.25																INSTALL ON EXISTING FLANGED CHANNEL SIGN POST.	X					
NB	2.133	A	D3-1	UNK	UNK		UPPER RD STREET SIGN						1		X									UPPER RD (TH-11)						
		A	D3-1	34	12			2.83								1		11'-9" X									12			
NB	2.390	A	R2-5A	24	30		REDUCED SPEED AHEAD 						1		X															
		A	W3-5	36	36			9.00								2		14'-2" 14'-4" X								X				
NB	2.429	A	VD-018	30	18								1	X																
		A	VD-018	30	18			3.75																INSTALL SIGN ON EXISTING FLANGED CHANNEL SIGN POST.			5			
NB	2.470	A	R2-1	24	30		SPEED LIMIT 40						1		X															
NB	2.473	A	R2-1	30	36			7.50								1		13'-7" X						INSTALL NEW 10+/- FEET NORTH OF AND ACROSS FROM UTILITY POLE.	X					
NB	2.506	C C	R2-1 VR-017	18 24	24 30								1 1		X									JONES RD (TH-35)						
SIGN SUMMARY SHEET							SHEET TOTALS	40.58	0.00	~~1~~ 0	0	0	~~10~~ 8	0	0	6	90.0			0	0.0	0.0	0.0	0.0	PROJECT NAME: STATEWIDE SOUTHWEST REGION					
								SF	SF	EA	EA	EA	EA	EA	EA	EA		FT		EA	LB	LB	LB	LB	PROJECT NUMBER: STPG SIGN(41)					
																											FILE NAME: 12C118			
							VERMONT AGENCY OF TRANSPORTATION																					PROJECT MANAGER: A. GAMBLE		
TOWN DIRECTIONAL TOTALS																								DESIGNED BY: J. KELLY						
																											PLOT DATE: 2/13/2013			
																							DRAWN BY: J. KELLY							
																								CHECKED: A. GAMBLE						
																								POULTNEY NB SHEET 4						
																								SHEET 67 OF 97						

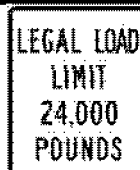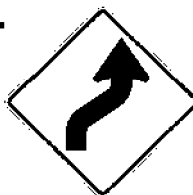
DIRECTION	MILEPOINT	LOCATION CODE (SHEET 2)	SIGN CODE	WIDTH (IN)	HEIGHT (IN)	SHEETING REMARKS	SIGN LEGEND	NEW SIGNS		EXISTING SIGNS				EXIST POST		NUMBER OF NEW POSTS	SQUARE STEEL (IN)			TUBULAR STEEL Ø (IN)					SIGN FRAME REQUIRED	REMARKS	SIGN DETAIL LOCATION		
								"A"	"B"	RETAIN	SALVAGE FROM	SALVAGE TO	REMOVE	RETAIN	REMOVE		1.75	2.00	2.50	FOUNDATION	3.00	3.50	4.00	5.00			SHSM	PROJECT SHEET #	STANDARD SHEET #
																	(LB / FT)				(LB / FT)								
																	1.88	2.42	3.35		7.60	9.00	10.80	14.60					
POULTNEY VT-31 NB							FY-FLUORESCENT YELLOW FYG-FLUORESCENT YELLOW GREEN															"SHSM"-STANDARD HIGHWAY SIGNS AND MARKINGS							
		C	R2-1	24	30		 	5.00							1		14'-9" X						INSTALL SPEED LIMIT 25 BELOW LEGAL LOAD LIMIT		6				
NB	2.510	D	R1-1	30	30								1		X								JONES RD (TH-35)						
		D	R1-1	30	30			6.25						1		8'-3" X							INSTALL ON EAST SIDE OF TREE.	X					
NB	2.510	A	D3-1	UNK	UNK								1		X								JONES RD (TH-35)						
		A	D3-1	34	12			2.83						1		11'-6" X							INSTALL ON WEST SIDE OF TREE.		12				
NB	2.700	A	W1-4R	30	30		RIGHT REVERSE CURVE						1	X															
		A	W13-1	18	18		35 MPH ADVISORY						1																
		A	R2-1	24	30			5.00															INSTALL NEW SIGN ON EXISTING FLANGED CHANNEL SIGN POST.	X					
NB	2.812 ~~2.850~~	A	W1-4R	30	30			6.25							1		15'-0" X						INSTALL SIGN ASSEMBLY 800 FEET NORTH OF EXISTING RIGHT REVERSE CURVE ASSEMBLY.	X					
		A	W13-1P	18	18			2.25																X					
NB	3.117	A	R2-5A	24	30		REDUCED SPEED AHEAD						1		X														
NB	3.160	A	VD-062C	74.75	16		BUSINESS SIGN			1				X															
		A	VD-062BC	74.75	16		BUSINESS SIGN			1																			
NB	3.202	B	VR-039	24	18		STATE HIGHWAY BEGINS						1	X															
		A	VR-040	24	24		THROUGH WAY ENDS HERE						1																
SIGN SUMMARY SHEET							SHEET TOTALS	32.58 27.58	0.00	2	0	0	7	0	0	4	60.0			0	0.0	0.0	0.0	0.0	PROJECT NAME: STATEWIDE SOUTHWEST REGION				
								SF	SF	EA	EA	EA	EA	EA	EA	EA		FT		EA	LB	LB	LB	LB	PROJECT NUMBER: STPG SIGN(41)				
																											FILE NAME: 12C118		
							VERMONT AGENCY OF TRANSPORTATION																					PROJECT MANAGER: A. GAMBLE	
TOWN DIRECTIONAL TOTALS								248.2 243.2	0.0	2	0	0	60 57	0	0	27 25	405.0 375.0			0	0.0				PLOT DATE: 2/13/2013				
																										DRAWN BY: J. KELLY			
																										CHECKED: A. GAMBLE			
																						DESIGNED BY: J. KELLY							
																							POULTNEY NB SHEET 5						
																							SHEET 68 OF 97						

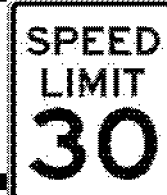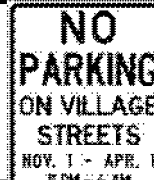DIRECTION	MILEPOINT	LOCATION CODE (SHEET 2)	SIGN CODE	WIDTH (IN)	HEIGHT (IN)	SHEETING REMARKS	SIGN LEGEND	NEW SIGNS		EXISTING SIGNS				EXIST POST		NUMBER OF NEW POSTS	SQUARE STEEL (IN)			TUBULAR STEEL Ø (IN)				SIGN FRAME REQUIRED	REMARKS	SIGN DETAIL LOCATION			
								"A"	"B"	RETAIN	SALVAGE FROM	SALVAGE TO	REMOVE	RETAIN	REMOVE		1.75	2.00	2.50	FOUNDATION	3.00	3.50	4.00			5.00	SHSM	PROJECT SHEET #	STANDARD SHEET #
																	(LB / FT)				(LB / FT)								
																	1.88	2.42	3.35		7.60	9.00	10.80			14.60			
POULTNEY VT-31 NB							FY-FLUORESCENT YELLOW FYG-FLUORESCENT YELLOW GREEN															"SHSM"-STANDARD HIGHWAY SIGNS AND MARKINGS							
		A	R2-1	24	30								1																
		C	VD-700	6	10			3.00		1														INSTALL SIGNS ON EXISTING FLANGED CHANNEL SIGN POST.		6			
		A	VR-038	24	18																								
		A	R2-1	30	36			7.50																		X			
			BEGINNING OF CLASS 1 SECTION OF ROADWAY (NORTHBOUND) NOTE: STICKERS ON BACK OF SIGNS IN CLASS 1 SECTION OF POULTNEY TOWN SHALL HAVE "POULTNEY (DATE) TH-1"																										
NB	3.462	A	W12-2	36	36								1		X														
		A	W12-2	36	36			9.00								2		15'-4" 15'-2" X								X			
		A	W16-2P	24	18			3.00																		X			
NB	3.520	A	R2-5A	24	30		REDUCED SPEED AHEAD						1		X														
		A	R2-1	24	30			5.00								1		13'-4" X								X			
NB	3.575	A	W12-2	36	36								1		X														
		A	W12-2	36	36			9.00								2		14'-6" 14'-6" X								X			
			STICKERS ON BACK OF SIGNS IN CLASS 1 SECTIONS OF POULTNEY VILLAGE (NORTH OF TRUSS BRIDGE) SHALL HAVE "POULTNEY (DATE) TH-2"																										
NB	3.616	A	R2-1	30	36			7.50								1		14'-2" X								X			
NB	3.616	A	R8-1 MOD	24	30			5.00								1		14'-6" X									6		
NB	3.625	A	UNK	24	30		SPEED ZONE AHEAD						1		X														
SIGN SUMMARY SHEET							SHEET TOTALS	49.00	0.00	~~1~~ 0	0	0	5	0	0	7	105.0			0	0.0	0.0	0.0	0.0	PROJECT NAME: STATEWIDE SOUTHWEST REGION				
								SF	SF	EA	EA	EA	EA	EA	EA	EA		FT		EA	LB	LB	LB	LB	PROJECT NUMBER: STPG SIGN(41)				
							VERMONT AGENCY OF TRANSPORTATION			TOWN DIRECTIONAL TOTALS	~~248.2~~ 243.2	0.0	2	0	0	~~60~~ 57	0	0	~~27~~ 25	~~405.0~~ 375.0			0	0.0				FILE NAME: 12C118	
																							PROJECT MANAGER: A. GAMBLE			PLOT DATE: 2/13/2013			
																								DESIGNED BY: J. KELLY			DRAWN BY: J. KELLY		
																								POULTNEY NB SHEET 6			CHECKED: A. GAMBLE		
																								SHEET 69			OF 97		


DIRECTION	MILEPOINT	LOCATION CODE (SHEET 2)	SIGN CODE	WIDTH (IN)	HEIGHT (IN)	SHEETING REMARKS	SIGN LEGEND	NEW SIGNS		EXISTING SIGNS				EXIST POST		NUMBER OF NEW POSTS	SQUARE STEEL (IN)			TUBULAR STEEL Ø (IN)				SIGN FRAME REQUIRED	REMARKS	SIGN DETAIL LOCATION			
								"A"	"B"	RETAIN	SALVAGE FROM	SALVAGE TO	REMOVE	RETAIN	REMOVE		1.75	2.00	2.50	FOUNDATION	3.00	3.50	4.00			5.00	SHSM	PROJECT SHEET #	STANDARD SHEET #
																	(LB / FT)				(LB / FT)								
																	1.88	2.42	3.35		7.60	9.00	10.80			14.60			
POULTNEY VT-31 NB							FY-FLUORESCENT YELLOW FYG-FLUORESCENT YELLOW GREEN															"SHSM"-STANDARD HIGHWAY SIGNS AND MARKINGS							
NB	3.635	A	R2-1	24	30		SPEED LIMIT 30						1		X														
		A	UNK	18	24		NO PARKING ON VILLAGE STREETS						1																
NB	3.660	A	M4-6	24	12		ROUTE MARKER ASSEMBLY.						1		X														
		A	MI-5	24	24								1																
		A	M2-1	21	15								1																
		A	M1-5	24	24								1																
		A	M4-6	24	12			2.00																FABRICATE SIGN WITH GREEN LEGEND ON WHITE BACKGROUND	X				
		A	MI-5	24	24			4.00																INSTALL NEW SIGNS ON EXISTING FRAME AND SIGN POSTS.				E-136B	
		A	M2-1	21	15		END JCT	2.19																					E-136B
		A	M1-5	24	24		VERMONT 31 VERMONT 30	4.00																					E-136B
NB	3.733	A	M3-1	24	12		ROUTE MARKER ASSEMBLY.						1		X														
		A	M1-5	24	24								1																
		A	M6-3	21	15								1																
		A	M3-3	24	12								1																
		A	M1-5	24	24								1																
SIGN SUMMARY SHEET							SHEET TOTALS		12.19	0.00	0	0	0	11	0	0	0	0.0			0	0.0	0.0	0.0	0.0	PROJECT NAME: STATEWIDE SOUTHWEST REGION PROJECT NUMBER: STPG SIGN(41)			
							SF	SF			EA	EA	EA	EA	EA	EA		FT		EA	LB	LB	LB	LB	FILE NAME: 12C118 PROJECT MANAGER: A. GAMBLE			PLOT DATE: 2/13/2013 DRAWN BY: J. KELLY	
VERMONT AGENCY OF TRANSPORTATION							TOWN DIRECTIONAL TOTALS		248.2 243.2	0.0	2	0	0	60 57	0	0	27 25	405.0 375.0			0	0.0				DESIGNED BY: J. KELLY POULTNEY NB SHEET 7			CHECKED A. GAMBLE SHEET 70 OF 97

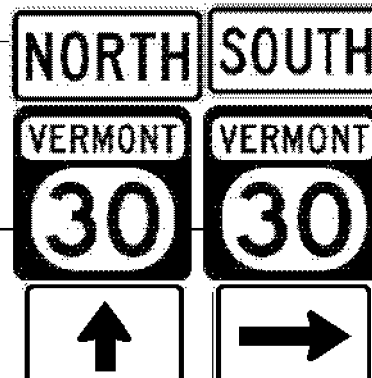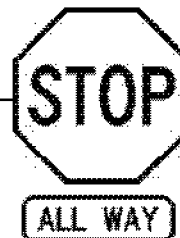
DIRECTION	MILEPOINT	LOCATION CODE (SHEET 2)	SIGN CODE	WIDTH (IN)	HEIGHT (IN)	SHEETING REMARKS	SIGN LEGEND	NEW SIGNS		EXISTING SIGNS				EXIST POST		NUMBER OF NEW POSTS	SQUARE STEEL (IN)			TUBULAR STEEL Ø (IN)				SIGN FRAME REQUIRED	REMARKS	SIGN DETAIL LOCATION				
								"A"	"B"	RETAIN	SALVAGE FROM	SALVAGE TO	REMOVE	RETAIN	REMOVE		1.75	2.00	2.50	FOUNDATION	3.00	3.50	4.00			5.00	SHSM	PROJECT SHEET #	STANDARD SHEET #	
																	(LB / FT)				(LB / FT)									
																	1.88	2.42	3.35		7.60	9.00	10.80			14.60				
POULTNEY VT-31 NB							FY-FLUORESCENT YELLOW FYG-FLUORESCENT YELLOW GREEN															"SHSM"-STANDARD HIGHWAY SIGNS AND MARKINGS								
		A	M6-1R	21	15							1											INSTALL NEW SIGNS ON EXISTING FRAME AND SIGN POSTS.							
		A	M3-1	24	12			2.00																		E-136B				
		A	M1-5	24	24			4.00																		E-136B				
		A	M6-3	21	15			2.19																		E-136B				
		A	M3-3	24	12			2.00																		E-136B				
		A	M1-5	24	24			4.00																		E-136B				
		A	M6-1R	21	15			2.19																		E-136B				
NB	3.775	A	R1-1	30	30							1	X																	
		A	R1-3	12	6	4-WAY						1																		
		A	R1-1	30	30			6.25																INSTALL NEW SIGNS ON EXISTING FLANGED CHANNEL SIGN POST.	X					
		A	R1-3P	18	6			0.75																	X					
SIGN SUMMARY SHEET							SHEET TOTALS	23.38	0.00	0	0	0	3	0	0	0	0.0			0	0.0	0.0	0.0	0.0	PROJECT NAME: STATEWIDE SOUTHWEST REGION					
								SF	SF	EA	EA	EA	EA	EA	EA	EA		FT		EA	LB	LB	LB	LB	PROJECT NUMBER: STPG SIGN(41)			DRAWN BY: J. KELLY		
																									FILE NAME: 12C118			PLOT DATE: 2/13/2013		
VERMONT AGENCY OF TRANSPORTATION							TOWN DIRECTIONAL TOTALS	248.2 243.2	0.0	2	0	0	60 57	0	0	27 25	405.0 375.0			0	0.0				PROJECT MANAGER: A. GAMBLE			DESIGNED BY: J. KELLY		
																						POULTNEY NB SHEET 8			CHECKED A. GAMBLE			SHEET 71 OF 97		


DIRECTION	MILEPOINT	LOCATION CODE (SHEET 2)	SIGN CODE	WIDTH (IN)	HEIGHT (IN)	SHEETING REMARKS	SIGN LEGEND	NEW SIGNS		EXISTING SIGNS				EXIST POST		NUMBER OF NEW POSTS	SQUARE STEEL (IN)			TUBULAR STEEL Ø (IN)				SIGN FRAME REQUIRED	REMARKS	SIGN DETAIL LOCATION							
								"A"	"B"	RETAIN	SALVAGE FROM	SALVAGE TO	REMOVE	RETAIN	REMOVE		1.75	2.00	2.50	FOUNDATION	3.00	3.50	4.00			5.00	SHSM	PROJECT SHEET #	STANDARD SHEET #				
																	(LB / FT)				(LB / FT)												
																	1.88	2.42	3.35		7.60	9.00	10.80			14.60							
POULTNEY VT-31 SB							FY-FLUORESCENT YELLOW FYG-FLUORESCENT YELLOW GREEN															"SHSM"-STANDARD HIGHWAY SIGNS AND MARKINGS											
			BEGINNING OF CLASS 1 SECTION OF ROADWAY (SOUTHBOUND). NOTE: STICKERS ON BACK OF SIGNS IN CLASS 1 SECTION OF POULTNEY VILLAGE SHALL HAVE "POULTNEY (DATE) TH-2"																														
SB	3.768	F	W12-2	36	36								1		X																		
		F	W12-2	36	36			9.00								2		15'-0" 15'-0" X								X							
		F	W16-2P	24	18			3.00																		X							
SB	3.757	F	R2-1	24	30			5.00								1		13'-6" X								INSTALL 10 FEET NORTH OF UTILITY POLE WITH GUY WIRES.	X						
SB	3.721	F	M1-5	24	24								1	X																			
		F	M3-3	24	12								1																				
		F	M3-3	24	12			2.00																		INSTALL NEW SIGNS ON EXISTING FLANGED CHANNEL SIGN POST.			E-136B				
		F	M1-5	24	24			4.00																				E-136B					
SB	3.609	F	W12-2	36	36			9.00								2		14'-9" 14'-11" X								INSTALL TO RIGHT OF SIDEWALK AND IN LINE WITH LARGE GREEN MAIL BOX.	X						
			STICKERS ON BACK OF SIGNS IN CLASS 1 SECTION OF POULTNEY TOWN SHALL HAVE "POULTNEY (DATE) TH-1"																														
SB	3.568	F	R2-1	24	30								1		X																		
		F	R2-1	24	30			5.00								1		13'-8" X								X							
SB	3.400	F	R2-1	24	30			5.00								1		13'-7" X								INSTALL ACROSS FROM DRIVE #461 SOUTH ST.	X						
			END CLASS 1 AND BEGINNING OF STATE SECTION OF ROADWAY (SOUTHBOUND).																														
SIGN SUMMARY SHEET							SHEET TOTALS		42.00	0.00	0	0	0	4	0	0	7	105.0			0	0.0	0.0	0.0	0.0	PROJECT NAME: STATEWIDE SOUTHWEST REGION							
									SF	SF	EA	EA	EA	EA	EA	EA	EA		FT		EA	LB	LB	LB	LB	PROJECT NUMBER: STPG SIGN(41)							
																											FILE NAME: 12C118			PLOT DATE: 2/13/2013			
							VERMONT AGENCY OF TRANSPORTATION																					PROJECT MANAGER: A. GAMBLE			DRAWN BY: J. KELLY		
							TOWN DIRECTIONAL TOTALS		207.2	0.0	2	0	0	43 41	0	0	31 29	465.0 435.0			0	0.0				DESIGNED BY: J. KELLY			CHECKED: A. GAMBLE				
																								POULTNEY SB SHEET 1			SHEET 72 OF 97						

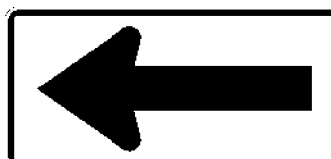DIRECTION	MILEPOINT	LOCATION CODE (SHEET 2)	SIGN CODE	WIDTH (IN)	HEIGHT (IN)	SHEETING REMARKS	SIGN LEGEND	NEW SIGNS		EXISTING SIGNS				EXIST POST		NUMBER OF NEW POSTS	SQUARE STEEL (IN)			TUBULAR STEEL Ø (IN)					SIGN FRAME REQUIRED	REMARKS	SIGN DETAIL LOCATION			
								"A"	"B"	RETAIN	SALVAGE FROM	SALVAGE TO	REMOVE	RETAIN	REMOVE		1.75	2.00	2.50	FOUNDATION	3.00	3.50	4.00	5.00			SHSM	PROJECT SHEET #	STANDARD SHEET #	
																	(LB / FT)				(LB / FT)									
																	1.88	2.42	3.35		7.60	9.00	10.80	14.60						
POULTNEY VT-31 SB							FY-FLUORESCENT YELLOW FYG-FLUORESCENT YELLOW GREEN															"SHSM"-STANDARD HIGHWAY SIGNS AND MARKINGS								
SB	3.202	E	VR-038	24	18								1	X																
		F	VR-041	24	24								1																	
		F	R2-1	24	30								1																	
		F	VR-039	24	18			3.00																INSTALL NEW SIGNS ON EXISTING FLANGED CHANNEL SIGN POST.		6				
		F	R2-1	24	30			5.00																		X				
SB	3.037	F	W1-3R	30	30		RIGHT REVERSE CURVE						1		X															
		F	W13-1	18	18		35 MPH ADVISORY						1																	
SB	2.965	F	W1-3R	30	30			6.25								1		17'-11" X						INSTALL 375 FEET SOUTH OF EXISTING RIGHT REVERSE CURVE SIGN ASSEMBLY.	X					
		F	W13-1P	18	18			2.25																		X				
SB	2.895	F	W1-8L	18	24		CHEVRON						1																	
		E	W1-6R	48	24			8.00								2		12'-6" 13'-6" X								X				
SB	2.888	F	W1-8L	18	24		CHEVRON						1		X															
		F	W1-6L	48	24			8.00								2		13'-8" 13'-10" X								X				
SB	2.881	F	W1-8L	18	24		CHEVRON						1		X															
SB	2.873	F	W1-8L	18	24		CHEVRON						1		X															
SIGN SUMMARY SHEET							SHEET TOTALS	32.50	0.00	0	0	0	9	0	0	5	75.0			0	0.0	0.0	0.0	0.0	PROJECT NAME: STATEWIDE SOUTHWEST REGION					
								SF	SF	EA	EA	EA	EA	EA	EA	EA		FT		EA	LB	LB	LB	LB	PROJECT NUMBER: STPG SIGN(41)					
																											FILE NAME: 12C118			
							VERMONT AGENCY OF TRANSPORTATION																					PROJECT MANAGER: A. GAMBLE		
TOWN DIRECTIONAL TOTALS																							DESIGNED BY: J. KELLY							
							207.2	0.0	2	0	0	43 41-	0	0	31 29-	465.0 435.0			0	0.0				PLOT DATE: 2/13/2013						
																						DRAWN BY: J. KELLY								
																							CHECKED: A. GAMBLE							
																						POULTNEY SB SHEET 2								
																						SHEET 73 OF 97								

DIRECTION	MILEPOINT	LOCATION CODE (SHEET 2)	SIGN CODE	WIDTH (IN)	HEIGHT (IN)	SHEETING REMARKS	SIGN LEGEND	NEW SIGNS		EXISTING SIGNS				EXIST POST		NUMBER OF NEW POSTS	SQUARE STEEL (IN)			TUBULAR STEEL Ø (IN)					SIGN FRAME REQUIRED	REMARKS	SIGN DETAIL LOCATION		
								"A"	"B"	RETAIN	SALVAGE FROM	SALVAGE TO	REMOVE	RETAIN	REMOVE		1.75	2.00	2.50	FOUNDATION	3.00	3.50	4.00	5.00			SHSM	PROJECT SHEET #	STANDARD SHEET #
																	(LB / FT)				(LB / FT)								
																	1.88	2.42	3.35		7.60	9.00	10.80	14.60					
POULTNEY VT-31 SB							FY-FLUORESCENT YELLOW FYG-FLUORESCENT YELLOW GREEN															"SHSM"-STANDARD HIGHWAY SIGNS AND MARKINGS							
SB	2.480	F	R2-1	24	30		SPEED LIMIT 50							1	X														
SB	2.473	F	R2-1	24	30		SPEED LIMIT 50	5.00								1	14'-0" X							INSTALL NEW SIGN 10 FEET NORTH OF UTILITY POLE AND DIRECTLY ACROSS FROM NB SPEED LIMIT 40.					
SB	2.275	F	VW-054R	30	30		HIDDEN DRIVE RIGHT							1	X														
		F	S3-1	36	36	FYG		9.00								2	15'-6" 15'-7" X									X			
SB	2.240	F	W2-2L	30	30		SIDE ROAD LEFT							1	X														
		F	S3-1T	30	30		SCHOOL BUS STOP AHEAD							1															
		F	W2-2L	30	30			6.25																	INSTALL NEW SIGNS ON EXISTING FLANGED CHANNEL SIGN POSTS.	X			
		F	VW-054R	30	30			6.25																			7		
SB	2.200	F	VD-062B	72	16		BUSINESS SIGN			1				X															
		F	VD-062B	72	16		BUSINESS SIGN			1																			
SB	2.000	F	VW-054R	30	30		HIDDEN DRIVE RIGHT							1	X														
SB	1.976	F	VW-054R	30	30			6.25								1	13'-0" X								INSTALL 125 FEET SOUTH OF EXISTING HIDDEN DRIVE RIGHT SIGN ASSEMBLY.		7		
SB	1.225	F	R2-1	30	36			7.50								1	16'-9" X								INSTALL DIRECTLY ACROSS FROM NEW NB SPEED LIMIT 50 SIGN ASSEMBLY.	X			
SB	1.205	F	W1-2L	30	30		LEFT CURVE							1	X														
		F	W13-1	18	18		35 MPH ADVISORY							1															
SIGN SUMMARY SHEET							SHEET TOTALS	40.25	0.00	2	0	0	7	0	0	5	75.0			0	0.0	0.0	0.0	0.0	PROJECT NAME: STATEWIDE SOUTHWEST REGION				
								SF	SF	EA	EA	EA	EA	EA	EA		FT		EA	LB	LB	LB	LB	PROJECT NUMBER: STPG SIGN(41)					
																									FILE NAME: 12C118				
							VERMONT AGENCY OF TRANSPORTATION			TOWN DIRECTIONAL TOTALS	207.2	0.0	2	0	0	43 41	0	0	31 29		465.0 435.0		0	0.0				PROJECT MANAGER: A. GAMBLE	
																							DESIGNED BY: J. KELLY			PLOT DATE: 2/13/2013			
																								DRAWN BY: J. KELLY			CHECKED: A. GAMBLE		
																								POULTNEY SB SHEET 3			SHEET 74 OF 97		

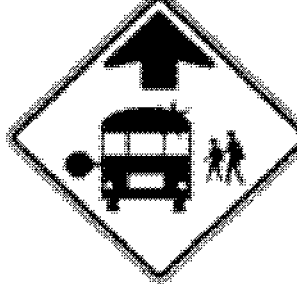DIRECTION	MILEPOINT	LOCATION CODE (SHEET 2)	SIGN CODE	WIDTH (IN)	HEIGHT (IN)	SHEETING REMARKS	SIGN LEGEND	NEW SIGNS		EXISTING SIGNS				EXIST POST		NUMBER OF NEW POSTS	SQUARE STEEL (IN)			TUBULAR STEEL Ø (IN)					SIGN FRAME REQUIRED	REMARKS	SIGN DETAIL LOCATION		
								"A"	"B"	RETAIN	SALVAGE FROM	SALVAGE TO	REMOVE	RETAIN	REMOVE		1.75	2.00	2.50	FOUNDATION	3.00	3.50	4.00	5.00			SHSM	PROJECT SHEET #	STANDARD SHEET #
																	(LB / FT)				(LB / FT)								
																	1.88	2.42	3.35		7.60	9.00	10.80	14.60					
POULTNEY VT-31 SB							FY-FLUORESCENT YELLOW FYG-FLUORESCENT YELLOW GREEN															"SHSM"-STANDARD HIGHWAY SIGNS AND MARKINGS							
SB	1.167	F	W1-2L	30	30			6.25							1		15'-0" X						INSTALL 200 FEET SOUTH OF EXISTING LEFT CURVE SIGN ASSEMBLY.	X					
SB	1.150	F	W1-8L	18	24		CHEVRON						1		X														
SB	1.14-1.07	E/F	N/A	6	8		INSTALL ⁷ (8) NEW DELINEATOR POSTS																INSTALL 8 BACK TO BACK DELINEATOR ASSEMBLIES AT 50 FT SPACINGS. SEE SHEET 4		4				
SB	1.145	E	W1-8R	18	24		CHEVRON						1		X														
SB	1.120	F	W1-8L	18	24		CHEVRON						1		X														
SB	1.120	E	W1-8R	18	24		CHEVRON						1		X														
SB	1.090	F	W1-8R	18	24		CHEVRON						1		X														
SB	1.090	E	W1-8L	18	24		CHEVRON						1		X														
SB	1.000	F	VW-054R	30	30		HIDDEN DRIVE RIGHT						1	X															
		F	S3-1T	30	30		SCHOOL BUS STOP AHEAD 						1																
		F	W1-10R	36	36	FY		9.00															INSTALL NEW SIGNS ON EXISTING FLANGED CHANNEL SIGN POSTS.	X					
		F	S3-1	36	36	FYG		9.00																	X				
SB	0.955	F	W1-2MR	30	30		MODIFIED RIGHT CURVE						1		X														
		F	W13-1	18	18		35 MPH ADVISORY 						1																
SB	0.940	F	VW-133R	30	30			6.25							1		12'-8" X						INSTALL 80 FEET SOUTH OF EXISTING RIGHT CURVE SIGN ASSEMBLY.		7				
SIGN SUMMARY SHEET							SHEET TOTALS	30.50	0.00	0	0	0	10	0	0	~~2~~ 1		~~30.0~~ 15.0		0	0.0	0.0	0.0	0.0	PROJECT NAME: STATEWIDE SOUTHWEST REGION				
								SF	SF	EA	EA	EA	EA	EA	EA	EA		FT		EA	LB	LB	LB	LB	PROJECT NUMBER: STPG SIGN(41)				
							VERMONT AGENCY OF TRANSPORTATION																				FILE NAME: 12C118	PLOT DATE: 2/13/2013	
TOWN DIRECTIONAL TOTALS																								PROJECT MANAGER: A. GAMBLE					
																										DRAWN BY: J. KELLY			
																										DESIGNED BY: J. KELLY			
																						CHECKED A. GAMBLE							
																							POULTNEY SB SHEET 4						
																							SHEET 75 OF 97						

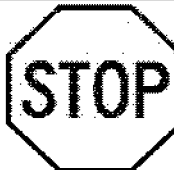
DIRECTION	MILEPOINT	LOCATION CODE (SHEET 2)	SIGN CODE	WIDTH (IN)	HEIGHT (IN)	SHEETING REMARKS	SIGN LEGEND	NEW SIGNS		EXISTING SIGNS				EXIST POST		NUMBER OF NEW POSTS	SQUARE STEEL (IN)			TUBULAR STEEL Ø (IN)					SIGN FRAME REQUIRED	REMARKS	SIGN DETAIL LOCATION			
								"A"	"B"	RETAIN	SALVAGE FROM	SALVAGE TO	REMOVE	RETAIN	REMOVE		1.75	2.00	2.50	FOUNDATION	3.00	3.50	4.00	5.00			SHSM	PROJECT SHEET #	STANDARD SHEET #	
																	(LB / FT)				(LB / FT)									
																	1.88	2.42	3.35		7.60	9.00	10.80	14.60						
POULTNEY VT-31 SB							FY-FLUORESCENT YELLOW FYG-FLUORESCENT YELLOW GREEN															"SHSM"-STANDARD HIGHWAY SIGNS AND MARKINGS								
SB	0.908	F	W11-5	30	30								1	X																
		F	W11-5	30	30			6.25																	INSTALL NEW SIGN ON EXISTING FLANGED CHANNEL SIGN POST.	X				
SB	0.730	G	VR-017	24	30								1		X											NEW BOSTON RD (TH-40)		6		
		G	VR-017	24	30			5.00								1		14'-11" X												
SB	0.724	H	R1-1	30	30								1		X											NEW BOSTON RD (TH-40)				
		H	R1-1	30	30			6.25								1		13'-10" X								X				
SB	0.720	F	D3-1	UNK	UNK								1		X											NEW BOSTON RD (TH-40)				
		F	D3-1	56	12		New Boston Rd	4.67								2		14'-8" 14'-0" X										12		
SB	0.715	F	UNK	UNK	UNK		EMPTY POST						+		✕											EMPTY POST NOT FOUND IN THE FIELD REMOVE EMPTY POST.				
SB	0.710	F	R2-1	24	30								1		X															
		F	R2-1	24	30			5.00								1		14'-3" X								INSTALL NEW SIGN AT LEAST 10 FEET NORTH OF UTILITY POLE.	X			
SB	0.600	F	VD-700 VW-054R	30	30		HIDDEN DRIVE RIGHT  0310 1117 0060						1		X															
SB	0.500	F	VW-054R	30	30			6.25								1		18'-4" X								INSTALL 525 FEET SOUTH OF EXISTING HIDDEN DRIVE RIGHT SIGN ASSEMBLY.		7		
SB	0.274	F	R2-1	24	30								1		X															
		F	R2-1	24	30			5.00								1		15'-0" X										X		
SIGN SUMMARY SHEET							SHEET TOTALS	38.42	0.00	0	0	0	8	0	0	7	105.0			0	0.0	0.0	0.0	0.0	PROJECT NAME: STATEWIDE SOUTHWEST REGION					
								SF	SF	EA	EA	EA	EA	EA	EA	EA		FT		EA	LB	LB	LB	LB	PROJECT NUMBER: STPG SIGN(41)					
																												FILE NAME: 12C118		
VERMONT AGENCY OF TRANSPORTATION							TOWN DIRECTIONAL TOTALS	207.2	0.0	2	0	0	43 41	0	0	31 29	465.0 435.0			0	0.0				PROJECT MANAGER: A. GAMBLE					
																											PLOT DATE: 2/13/2013			
																											DRAWN BY: J. KELLY			
																						DESIGNED BY: J. KELLY								
																							CHECKED A. GAMBLE							
																							SHEET 76 OF 97							

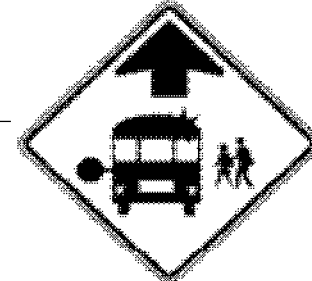
DIRECTION	MILEPOINT	LOCATION CODE (SHEET 2)	SIGN CODE	WIDTH (IN)	HEIGHT (IN)	SHEETING REMARKS	SIGN LEGEND	NEW SIGNS		EXISTING SIGNS				EXIST POST		NUMBER OF NEW POSTS	SQUARE STEEL (IN)			TUBULAR STEEL Ø (IN)					SIGN FRAME REQUIRED	REMARKS	SIGN DETAIL LOCATION				
								"A"	"B"	RETAIN	SALVAGE FROM	SALVAGE TO	REMOVE	RETAIN	REMOVE		1.75	2.00	2.50	FOUNDATION	3.00	3.50	4.00	5.00			SHSM	PROJECT SHEET #	STANDARD SHEET #		
																	(LB / FT)				(LB / FT)										
																	1.88	2.42	3.35		7.60	9.00	10.80	14.60							
POULTNEY VT-31 SB							FY-FLUORESCENT YELLOW FYG-FLUORESCENT YELLOW GREEN															"SHSM"-STANDARD HIGHWAY SIGNS AND MARKINGS									
SB	0.200	F	S3-1T	30	30		SCHOOL BUS STOP AHEAD 						1		X																
		F	S3-1	36	36	FYG		9.00									2	18'-8" 19'-0" X									X				
SB	0.074	F	W1-2L	30	30		LEFT CURVE						1		X																
		F	W13-1	18	18		35 MPH ADVISORY						1																		
SB	0.040	F	W1-2L	30	30	FY	 	6.25								1	18'-10" X								INSTALL 180 FEET SOUTH OF EXISTING LEFT CURVE SIGN ASSEMBLY.	X					
		F	W13-1P	18	18	FY		2.25																			X				
SB	0.000	F	W1-8L	18	24		 					1		X																	
		E	W1-8R	18	24			1																							
		F	W1-8L	18	24	FY		3.00								1	13'-10" X								INSTALL SIGNS BACK TO BACK ON SAME SIGN POST.	X					
		E	W1-8R	18	24	FY		3.00																			X				
SIGN SUMMARY SHEET							SHEET TOTALS	23.50	0.00	0	0	0	5 3	0	0	4	60.0			0	0.0	0.0	0.0	0.0	PROJECT NAME: STATEWIDE SOUTHWEST REGION						
								SF	SF	EA	EA	EA	EA	EA	EA	EA		FT		EA	LB	LB	LB	LB	PROJECT NUMBER: STPG SIGN(41)						
																											FILE NAME: 12C118				
VERMONT AGENCY OF TRANSPORTATION							TOWN DIRECTIONAL TOTALS	207.2	0.0	2	0	0	43 41	0	0	31 29	465.0 435.0			0	0.0				PROJECT MANAGER: A. GAMBLE						
																											DRAWN BY: J. KELLY				
																											DESIGNED BY: J. KELLY				
																							POULTNEY SB SHEET 6								
																								PLOT DATE: 2/13/2013							
																								CHECKED: A. GAMBLE							
																								SHEET 77 OF 97							


DIRECTION	MILEPOINT	LOCATION CODE (SHEET 2)	SIGN CODE	WIDTH (IN)	HEIGHT (IN)	SHEETING REMARKS	SIGN LEGEND	NEW SIGNS		EXISTING SIGNS				EXIST POST		NUMBER OF NEW POSTS	SQUARE STEEL (IN)			TUBULAR STEEL Ø (IN)				SIGN FRAME REQUIRED	REMARKS	SIGN DETAIL LOCATION									
								"A"	"B"	RETAIN	SALVAGE FROM	SALVAGE TO	REMOVE	RETAIN	REMOVE		1.75	2.00	2.50	FOUNDATION	3.00	3.50	4.00			5.00	SHSM	PROJECT SHEET #	STANDARD SHEET #						
																	(LB / FT)				(LB / FT)														
																	1.88	2.42	3.35		7.60	9.00	10.80			14.60									
POWNAL VT-346 NB							FY-FLUORESCENT YELLOW FYG-FLUORESCENT YELLOW GREEN															"SHSM"-STANDARD HIGHWAY SIGNS AND MARKINGS													
NB	0.020	A	VD-700 M3-1	6 24	10 12		3460 0208 0000			1			1	X																					
		A	M1-5	30	24							1																							
		A	M3-1	24	12		NORTH VERMONT 346	2.00																INSTALL SIGNS ON EXISTING FLANGED CHANNEL SIGN POST.			E-136B								
		A	M1-5	30	24			5.00																			E-136B								
NB	0.033	A	VR-644P	24	12							1	X																						
		A	R8-3A	24	24							1																							
		A	R3-9cP	30	12		BEGIN	2.50																INSTALL SIGNS ON EXISTING FLANGED CHANNEL SIGN POSTS.	X										
		A	R8-3A	24	24		R	4.00																	X										
NB	0.070	A	R2-1	24	30							1	X																						
		A	R2-1	24	30		SPEED LIMIT 35	5.00																INSTALL SIGN ON EXISTING FLANGED CHANNEL SIGN POST.	X										
NB	0.087	A	D1-1M	72	10							1	X																						
		A	D2-1	72	10							1																							
		A	VD2-1	72	12		Pownal	6.00																INSTALL NEW SIGNS ON EXISTING FLANGED CHANNEL SIGN POSTS.		8									
		A	VD2-1	72	12		N. Pownal 3	6.00																		8									
NB	0.129	A	W11-8	30	30							1		X																					
SIGN SUMMARY SHEET							SHEET TOTALS		30.50	0.00	~~1~~ 0	0	0	8	0	0	0	0.0			0	0.0	0.0	0.0	0.0	PROJECT NAME: STATEWIDE SOUTHWEST REGION									
									SF	SF	EA	EA	EA	EA	EA	EA	EA	EA	EA	EA	EA	EA	EA	EA	EA	EA	EA	EA	EA	EA	EA	PROJECT NUMBER: STPG SIGN(41)			
																																FILE NAME: 12C118	PLOT DATE: 2/15/2013		
																																PROJECT MANAGER: A. GAMBLE	DRAWN BY: J. KELLY		
VERMONT AGENCY OF TRANSPORTATION							TOWN DIRECTIONAL TOTALS		224.3	0.0	~~31~~ 28	~~3~~ 0	~~3~~ 0	~~47~~ 44	0	0	~~32~~ 31	480.0 465.0			0	0.0				DESIGNED BY: J. KELLY			CHECKED: A. GAMBLE						
																									POWNAL NB SHEET 1			SHEET 78 OF 97							



DIRECTION	MILEPOINT	LOCATION CODE (SHEET 2)	SIGN CODE	WIDTH (IN)	HEIGHT (IN)	SHEETING REMARKS	SIGN LEGEND	NEW SIGNS		EXISTING SIGNS				EXIST POST		NUMBER OF NEW POSTS	SQUARE STEEL (IN)			TUBULAR STEEL Ø (IN)					SIGN FRAME REQUIRED	REMARKS	SIGN DETAIL LOCATION		
								"A"	"B"	RETAIN	SALVAGE FROM	SALVAGE TO	REMOVE	RETAIN	REMOVE		1.75	2.00	2.50	FOUNDATION	3.00	3.50	4.00	5.00			SHSM	PROJECT SHEET #	STANDARD SHEET #
																	(LB / FT)				(LB / FT)								
																	1.88	2.42	3.35		7.60	9.00	10.80	14.60					
POWNAL VT-346 NB							FY-FLUORESCENT YELLOW FYG-FLUORESCENT YELLOW GREEN															"SHSM"-STANDARD HIGHWAY SIGNS AND MARKINGS							
		A	VD-700	6	10		MILE MARKER			1																			
		A	W1-4R	30	30		RIGHT REVERSE CURVE					1																	
		A	VD-700	6	10		MILE MARKER	6.25			1					1	15'-0" X									X			
NB	0.157	A	R8-3A	24	24		NO PARKING			1				X															
NB	0.185	A	VD-018	30	18		VILLAGE SIGN			1				X															
NB	0.205	A	R8-3A	24	24		NO PARKING			1				X															
NB	0.273	C	VR-017	24	30		LEGAL LOAD 24K			1				X															
NB	0.273	D	R1-1	30	30		STOP			1				X															
NB	0.275	A	D3-1	70	12		Oak Hill School Rd	5.83				1			X	2	13'-0" 13'-0" X											12	
NB	0.295	A	R2-1	24	30		SPEED LIMIT 35			1				X															
		A	R8-3A	24	24		NO PARKING			1																			
NB	0.400	A	W1-2L	30	30		LEFT CURVE			1				X															
NB	0.464	A	W1-1R	30	30		RIGHT TURN			1				X															
		A	W13-1	18	18		20 MPH ADVISORY			1																			
NB	0.503	A	M3-1	24	12		NORTH			1				X															
		A	M1-5	30	24		VERMONT ROUTE 346			1																			
SIGN SUMMARY SHEET							SHEET TOTALS	12.08	0.00	12	1-0-	1-0-	2-1-	0	0	3	45.0		0	0.0	0.0	0.0	0.0	PROJECT NAME: STATEWIDE SOUTHWEST REGION					
								SF	SF	EA	EA	EA	EA	EA	EA	EA		FT		EA	LB	LB	LB	LB	PROJECT NUMBER: STPG SIGN(41)				
																										FILE NAME: 12C118			
							VERMONT AGENCY OF TRANSPORTATION																				PROJECT MANAGER: A. GAMBLE		
TOWN DIRECTIONAL TOTALS																							PLOT DATE: 2/15/2013						
																										DRAWN BY: J. KELLY			
																						CHECKED A. GAMBLE							
																						SHEET 79 OF 97							
																						DESIGNED BY: J. KELLY							
																						POWNAL NB SHEET 2							

DIRECTION	MILEPOINT	LOCATION CODE (SHEET 2)	SIGN CODE	WIDTH (IN)	HEIGHT (IN)	SHEETING REMARKS	SIGN LEGEND	NEW SIGNS		EXISTING SIGNS				EXIST POST		NUMBER OF NEW POSTS	SQUARE STEEL (IN)			TUBULAR STEEL Ø (IN)					SIGN FRAME REQUIRED	REMARKS	SIGN DETAIL LOCATION			
								"A"	"B"	RETAIN	SALVAGE FROM	SALVAGE TO	REMOVE	RETAIN	REMOVE		1.75	2.00	2.50	FOUNDATION	3.00	3.50	4.00	5.00			SHSM	PROJECT SHEET #	STANDARD SHEET #	
																	(LB / FT)				(LB / FT)									
																	1.88	2.42	3.35		7.60	9.00	10.80	14.60						
POWNAL VT-346 NB							FY-FLUORESCENT YELLOW FYG-FLUORESCENT YELLOW GREEN															"SHSM"-STANDARD HIGHWAY SIGNS AND MARKINGS								
NB	0.575	A	R8-3A	24	24		NO PARKING			1				X																
NB	0.650	A	R2-1	24	30		SPEED LIMIT 50			1				X																
NB	0.723	A	VW-054L	30	30		HIDDEN DRIVE LEFT						1		X															
NB	0.823	A	R8-3A	24	24		NO PARKING			1				X																
		A	M4-6P	24	12		END			1																				
NB	0.884	A	UNK	UNK	UNK		EMPTY POST						1		X											REMOVE EMPTY POST.				
NB	1.112	A	W11-5	30	30			6.25								1	14'-11" X								INSTALL 875 FEET SOUTH OF EXISTING FARM MACHINERY SIGN ASSEMBLY.	X				
NB	1.285	A	W11-5	30	30		FARM MACHINERY						1		X															
NB	1.548	A	R2-1	24	30			5.00								1	14'-11" X								INSTALL ACROSS FROM RED GARAGE AT BEGINNING OF MARKED PASSING ZONE.	X				
NB	2.074	C	VR-017	24	30								4		X										CEDAR HILL RD (TH-27)					
		C	VR-017	24	30			5.00								1	14'-5" X											6		
NB	2.083	C D	VD-700 R1-1	6 30	10 30		MILE MARKER 			1					X											CEDAR HILL RD (TH-27)				
		A	D3-1	UNK	UNK		CEDAR HILL RD STREET SIGN																							
		C D	VD-700 R1-1	6 30	10 30		MILE MARKER 	6.25					1				14'-5" X										X			
NB	2.083	A	D3-1	50	12			4.17								2	13'-0" 13'-0" X									FIELD LOCATE AT LEAST 8 FT FROM ANY OTHER SIGN.		12		
SIGN SUMMARY SHEET							SHEET TOTALS		26.67	0.00	4	1-0	1-0	5-6	0	0	6	90.0		0	0.0	0.0	0.0	0.0	PROJECT NAME: STATEWIDE SOUTHWEST REGION					
									SF	SF	EA	EA	EA	EA	EA	EA	EA	FT		EA	LB	LB	LB	LB	PROJECT NUMBER: STPG SIGN(41)					
																									FILE NAME: 12C118					
																									PROJECT MANAGER: A. GAMBLE					
VERMONT AGENCY OF TRANSPORTATION							TOWN DIRECTIONAL TOTALS		224.3	0.0	31-28	3-0	3-0	47-44	0	0	32-31	480.0 465.0	0	0.0				PLOT DATE: 2/15/2013						
																								DRAWN BY: J. KELLY						
																						DESIGNED BY: J. KELLY								
																						CHECKED: A. GAMBLE								
																						POWNAL NB SHEET 3								
																						SHEET 80 OF 97								

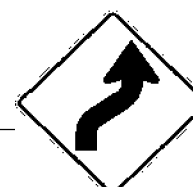
DIRECTION	MILEPOINT	LOCATION CODE (SHEET 2)	SIGN CODE	WIDTH (IN)	HEIGHT (IN)	SHEETING REMARKS	SIGN LEGEND	NEW SIGNS		EXISTING SIGNS				EXIST POST		NUMBER OF NEW POSTS	SQUARE STEEL (IN)			TUBULAR STEEL Ø (IN)				SIGN FRAME REQUIRED	REMARKS	SIGN DETAIL LOCATION			
								"A"	"B"	RETAIN	SALVAGE FROM	SALVAGE TO	REMOVE	RETAIN	REMOVE		1.75	2.00	2.50	FOUNDATION	3.00	3.50	4.00			5.00	SHSM	PROJECT SHEET #	STANDARD SHEET #
																	(LB / FT)				(LB / FT)								
																	1.88	2.42	3.35		7.60	9.00	10.80			14.60			
POWNA VT-346 NB							FY-FLUORESCENT YELLOW FYG-FLUORESCENT YELLOW GREEN															"SHSM"-STANDARD HIGHWAY SIGNS AND MARKINGS							
NB	2.113	A	VW-444	30	30		WATCH FOR FALLEN ROCK						1		X														
		A	W1-4R	30	30		RIGHT REVERSE CURVE						1																
		A	W13-1	18	18		40 MPH ADVISORY						1																
NB	2.142	A	VW-285	30	30			6.25								1		14'-4" X						INSTALL NEW 150 FEET NORTH OF EXISTING FALLEN ROCK SIGN ASSEMBLY.		7			
NB	2.193	A	W1-4R	30	30			6.25								1		15'-0" X						INSTALL 425 FEET NORTH OF EXISTING REVERSE CURVE SIGN ASSEMBLY.	X				
		A	W13-1P	18	18			2.25																	X				
NB	2.465	A	W3-5	36	36		SPEED REDUCTION (35)			1				X															
NB	2.564	A	VD-018	30	18		NORTH POWNA			1				X															
NB	2.610	A	R2-1	24	30		SPEED LIMIT 35			1				X															
NB	2.635	A	W1-4L	30	30		LEFT REVERSE CURVE			1				X															
NB	2.703	A	S3-1T	36	36		SCHOOL BUS STOP AHEAD			1				X															
NB	2.764	A	VW-133R	30	30		HIDDEN DRIVES RIGHT			1				X															
NB	2.798	A	R2-1	24	30		SPEED LIMIT 35			1				X															
NB	2.996	A	W11-8	30	30								1		X														
		A	W11-8	30	30			6.25								1		14'-9" X							X				
SIGN SUMMARY SHEET							SHEET TOTALS		21.00	0.00	7	0	0	4	0	0	3 -2-	45.0 -30.0-	0	0.0	0.0	0.0	0.0	PROJECT NAME: STATEWIDE SOUTHWEST REGION					
									SF	SF	EA	EA	EA	EA	EA	EA	EA	FT	EA	LB	LB	LB	LB	PROJECT NUMBER: STPG SIGN(41)					
																										FILE NAME: 12C118			
																										PROJECT MANAGER: A. GAMBLE			
VERMONT AGENCY OF TRANSPORTATION							TOWN DIRECTIONAL TOTALS		224.3	0.0	31 -28	3 -0-	3 -0-	47 -44-	0	0	32 -31-	480.0 -465.0-	0	0.0				PLOT DATE: 2/15/2013					
																						DRAWN BY: J. KELLY							
																						CHECKED: A. GAMBLE							
																						POWNA NB SHEET 4							
																						SHEET 81 OF 97							



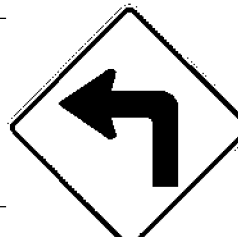
DIRECTION	MILEPOINT	LOCATION CODE (SHEET 2)	SIGN CODE	WIDTH (IN)	HEIGHT (IN)	SHEETING REMARKS	SIGN LEGEND	NEW SIGNS		EXISTING SIGNS				EXIST POST		NUMBER OF NEW POSTS	SQUARE STEEL (IN)			TUBULAR STEEL Ø (IN)				SIGN FRAME REQUIRED	REMARKS	SIGN DETAIL LOCATION			
								"A"	"B"	RETAIN	SALVAGE FROM	SALVAGE TO	REMOVE	RETAIN	REMOVE		1.75	2.00	2.50	FOUNDATION	3.00	3.50	4.00			5.00	SHSM	PROJECT SHEET #	STANDARD SHEET #
																	(LB / FT)				(LB / FT)								
																	1.88	2.42	3.35		7.60	9.00	10.80			14.60			
POWNAL VT-346 NB							FY-FLUORESCENT YELLOW FYG-FLUORESCENT YELLOW GREEN															"SHSM"-STANDARD HIGHWAY SIGNS AND MARKINGS							
NB	3.036	A	R2-1	24	30								1	X															
		A	R2-1	24	30			5.00																INSTALL ON EXISTING FLANGED CHANNEL SIGN POST.	X				
NB	3.202	A	VW-622	30	30								1		X														
		A	VW-622	30	30			6.25								1	14'-6" X										7		
NB	3.344	A	R2-1	24	30					1			1	X															
		A	R2-1	24	30			5.00																INSTALL NEW SIGN ON EXISTING FLANGED CHANNEL SIGN POST.	X				
NB	3.472	A	W1-1L	30	30		LEFT TURN						1		X														
		A	W13-1	18	18		25 MPH ADVISORY						1																
NB	3.493	A	VD1-1	72	12			6.00								2	14'-0" 14'-0" X								INSTALL NEW SIGNS IN GRASS STRIP BETWEEN GREEN HOUSE AND CHURCH DRIVE.		10		
		A	VD1-1	72	12			6.00																			10		
NB	3.527	A	D1-1M	72	10		DESTINATION SIGNS 						1		X														
		A	D1-1M	72	10								1																
		A	W1-1L	30	30			6.25								1	15'-0" X								INSTALL SIGNS 10 FEET SOUTH OF UTILITY POLE.	X			
		A	W13-1P	18	18			2.25																		X			
NB	3.558	C	VR-017	24	30		LEGAL LOAD 24K			1				X											N POWNAL RD (TH-2)				
SIGN SUMMARY SHEET							SHEET TOTALS	36.75	0.00	~~2~~ 1	0	0	~~8~~ 7	0	0	4	~~45.0~~ 60.0		0	0.0	0.0	0.0	0.0	PROJECT NAME: STATEWIDE SOUTHWEST REGION	PROJECT NUMBER: STPG SIGN(41)				
								SF	SF	EA	EA	EA	EA	EA	EA	EA		FT		EA	LB			LB	LB	LB	FILE NAME: 12C118	PLOT DATE: 2/15/2013	
							VERMONT AGENCY OF TRANSPORTATION																					PROJECT MANAGER: A. GAMBLE	DRAWN BY: J. KELLY
TOWN DIRECTIONAL TOTALS							224.3	0.0	~~31~~ 28	~~3~~ 0	~~3~~ 0	~~47~~ 44	0	0	~~32~~ 31	~~480.0~~ 465.0		0	0.0				DESIGNED BY: J. KELLY	CHECKED A. GAMBLE					
																							POWNAL NB SHEET 5		SHEET 82 OF 97				

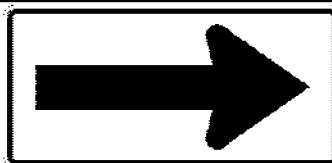DIRECTION	MILEPOINT	LOCATION CODE (SHEET 2)	SIGN CODE	WIDTH (IN)	HEIGHT (IN)	SHEETING REMARKS	SIGN LEGEND	NEW SIGNS		EXISTING SIGNS				EXIST POST		NUMBER OF NEW POSTS	SQUARE STEEL (IN)			TUBULAR STEEL Ø (IN)					SIGN FRAME REQUIRED	REMARKS	SIGN DETAIL LOCATION		
								"A"	"B"	RETAIN	SALVAGE FROM	SALVAGE TO	REMOVE	RETAIN	REMOVE		1.75	2.00	2.50	FOUNDATION	3.00	3.50	4.00	5.00			SHSM	PROJECT SHEET #	STANDARD SHEET #
																	(LB / FT)				(LB / FT)								
																	1.88	2.42	3.35		7.60	9.00	10.80	14.60					
POWNAL VT-346 NB							FY-FLUORESCENT YELLOW FYG-FLUORESCENT YELLOW GREEN															"SHSM"-STANDARD HIGHWAY SIGNS AND MARKINGS							
NB	3.558	A	W1-6	48	24								1		X									N POWNAL RD (TH-2)					
		A	W1-6L	48	24			8.00									2		12'-4" 12'-3" X						INSTALL IN ISLAND AS EXISTING.	X			
NB	3.559	B	W1-6	48	24								1		X									N POWNAL RD (TH-2)					
		B	W1-6R	48	24			8.00									2		12'-5" 12'-5" X						INSTALL IN ISLAND AS EXISTING.	X			
NB	3.559	D	R1-1	30	30		STOP			1				X										N POWNAL RD (TH-2)					
NB	3.565	D	R1-1	30	30		STOP			1				X										N POWNAL RD (TH-2)					
NB	3.565	A	D3-1	UNK	UNK		NORTH POWNAL STREET SIGN			1				X										N POWNAL RD (TH-2)					
NB	3.578	A	OM-3R	12	36								1	X															
		A	OM3-R	12	36			3.00																	INSTALL ON EXISTING FLANGED CHANNEL SIGN POST.	X			
NB	3.587	B	OM-3L	12	36								1	X															
		B	OM3-L	12	36			3.00																	INSTALL ON EXISTING FLANGED CHANNEL SIGN POST.	X			
NB	3.589	C	VR-017	24	30								1		X										TUBS RD (TH-12)				
		C	VR-017	24	30			5.00									1		13'-9" X								6		
NB	3.596	A	D3-1	UNK	UNK								1		X										TUBS RD (TH-12)				
		C	VD-700	6	10		MILE MARKER 						1																
		D	R1-1	30	30								1																
SIGN SUMMARY SHEET							SHEET TOTALS		27.00	0.00	3	0	0	~~8~~ 7	0	0	5	75.0			0	0.0	0.0	0.0	0.0	PROJECT NAME: STATEWIDE SOUTHWEST REGION			
									SF	SF	EA	EA	EA	EA	EA	EA		FT		EA	LB	LB	LB	LB	PROJECT NUMBER: STPG SIGN(41)				
																									FILE NAME: 12C118				
VERMONT AGENCY OF TRANSPORTATION																								PROJECT MANAGER: A. GAMBLE			PLOT DATE: 2/15/2013		
																									DRAWN BY: J. KELLY				
																								DESIGNED BY: J. KELLY			CHECKED A. GAMBLE		
																									POWNAL NB SHEET 6			SHEET 83 OF 97	
							TOWN DIRECTIONAL TOTALS		224.3	0.0	~~31~~ 28	~~3~~ 0	~~3~~ 0	~~47~~ 44	0	0	~~32~~ 31	~~480.0~~ 465.0			0	0.0							

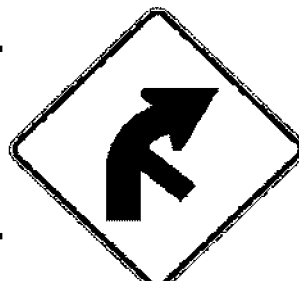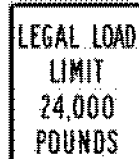
DIRECTION	MILEPOINT	LOCATION CODE (SHEET 2)	SIGN CODE	WIDTH (IN)	HEIGHT (IN)	SHEETING REMARKS	SIGN LEGEND	NEW SIGNS		EXISTING SIGNS				EXIST POST		NUMBER OF NEW POSTS	SQUARE STEEL (IN)			TUBULAR STEEL Ø (IN)					SIGN FRAME REQUIRED	REMARKS	SIGN DETAIL LOCATION		
								"A"	"B"	RETAIN	SALVAGE FROM	SALVAGE TO	REMOVE	RETAIN	REMOVE		1.75	2.00	2.50	FOUNDATION	3.00	3.50	4.00	5.00			SHSM	PROJECT SHEET #	STANDARD SHEET #
																	(LB / FT)				(LB / FT)								
																	1.88	2.42	3.35		7.60	9.00	10.80	14.60					
POWNAL VT-346 NB							FY-FLUORESCENT YELLOW FYG-FLUORESCENT YELLOW GREEN															"SHSM"-STANDARD HIGHWAY SIGNS AND MARKINGS							
		D	R1-1	30	30			6.25							1		14'-9" X								X				
		A	D3-1	30	12			2.50																INSTALL SIGN ABOVE STOP SIGN AS EXISTING.		12			
NB	3.618	A	M3-1	24	12								1		X														
		A	M1-5A	30	24								1																
		A	M3-1	24	12			2.00							1		15'-0" X										E-136B		
		A	M1-5	30	24			5.00																			E-136B		
NB	3.695	A	VD-700 R2-1	24	30					1			1	X															
		A	R2-1	24	30			5.00																INSTALL NEW SIGN ON EXISTING FLANGED CHANNEL SIGN POST.	X				
NB	3.829	A	VD-700 W1-2MR	30	30		RIGHT CURVE WITH RIGHT SIDE ROAD 						1		X														
NB	3.864	A	W1-2MR	36	36			9.00							2		14'-1" 14'-2" X							INSTALL 185 FEET NORTH OF EXISTING RIGHT CURVE SIGN AND NEXT TO END OF FENCE.		8			
NB	3.916	D	R1-1	30	30					1			1		X									INDIAN MASSACRE RD (TH-11)					
		D	R1-1	30	30			6.25							1		12'-6" X								X				
NB	3.924	C	VR-017	24	30								1		X									INDIAN MASSACRE RD (TH-11)					
		C	VR-017	24	30			5.00							1		12'-6" X									6			
NB	3.924	A	D3-1	UNK	UNK								1		X														
SIGN SUMMARY SHEET							SHEET TOTALS	41.00	0.00	~~1~~ 0	~~1~~ 0	~~1~~ 0	~~8~~ 7	0	0	6	90.0			0	0.0	0.0	0.0	0.0	PROJECT NAME: STATEWIDE SOUTHWEST REGION				
								SF	SF	EA	EA	EA	EA	EA	EA	EA		FT		EA	LB	LB	LB	LB	PROJECT NUMBER: STPG SIGN(41)				
																												FILE NAME: 12C118	
VERMONT AGENCY OF TRANSPORTATION							TOWN DIRECTIONAL TOTALS	224.3	0.0	~~31~~ 28	~~3~~ 0	~~3~~ 0	~~47~~ 44	0	0	~~32~~ 31	480.0 465.0			0	0.0				PROJECT MANAGER: A. GAMBLE				
																											PLOT DATE: 2/15/2013		
																											DRAWN BY: J. KELLY		
																							DESIGNED BY: J. KELLY						
																								CHECKED: A. GAMBLE					
																								SHEET 84 OF 97					


DIRECTION	MILEPOINT	LOCATION CODE (SHEET 2)	SIGN CODE	WIDTH (IN)	HEIGHT (IN)	SHEETING REMARKS	SIGN LEGEND	NEW SIGNS		EXISTING SIGNS				EXIST POST		NUMBER OF NEW POSTS	SQUARE STEEL (IN)			TUBULAR STEEL Ø (IN)					SIGN FRAME REQUIRED	REMARKS	SIGN DETAIL LOCATION		
								"A"	"B"	RETAIN	SALVAGE FROM	SALVAGE TO	REMOVE	RETAIN	REMOVE		1.75	2.00	2.50	FOUNDATION	3.00	3.50	4.00	5.00			SHSM	PROJECT SHEET #	STANDARD SHEET #
																	(LB / FT)				(LB / FT)								
																	1.88	2.42	3.35		7.60	9.00	10.80	14.60					
POWNAL VT-346 NB							FY-FLUORESCENT YELLOW FYG-FLUORESCENT YELLOW GREEN															"SHSM"-STANDARD HIGHWAY SIGNS AND MARKINGS							
		A	D3-1	72	12		Indian Massacre Rd	6.00							2	12'-10" 13'-0" X							INSTALL AT POINT OF ISLAND AS EXISTING. DO NOT BLOCK ANY OTHER SIGNAGE.		12				
NB	3.931	D	R1-1	30	30								1		X								INDIAN MASSACRE RD (TH-11)						
		D	R1-1	30	30			6.25							1	13'-5" X								X					
NB	4.053	A	R2-1	24	30								1		X														
		A	R2-1	24	30			5.00							1	14'-3" X								X					
NB	4.222	A	W10-1	36	36								1	X															
		A	W10-1	36	36			7.07																INSTALL NEW SIGN ON EXISTING FLANGED CHANNEL SIGN POST.	X				
NB	4.335	A	R15-1	48	9		RAILROAD CROSSBUCKS			1				X															
NB	4.406	A	R2-1	24	30								1		X														
		A	R2-1	24	30			5.00							1	13'-6" X								X					
SIGN SUMMARY SHEET							SHEET TOTALS	29.32	0.00	1	0	0	4	0	0	5	75.0		0	0.0	0.0	0.0	0.0	PROJECT NAME: STATEWIDE SOUTHWEST REGION					
								SF	SF	EA	EA	EA	EA	EA	EA	EA	FT		EA	LB	LB	LB	LB	PROJECT NUMBER: STPG SIGN(41)					
VERMONT AGENCY OF TRANSPORTATION																								FILE NAME: 12C118					
							TOWN DIRECTIONAL TOTALS	224.3	0.0	31 28	3 0	3 0	47 44	0	0	32 31	480.0 465.0		0	0.0				PLOT DATE: 2/15/2013					
																								DRAWN BY: J. KELLY					
																								CHECKED A. GAMBLE					
																								SHEET 85 OF 97					
																								POWNAL NB SHEET 8					

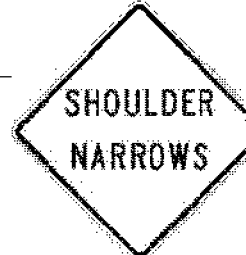DIRECTION	MILEPOINT	LOCATION CODE (SHEET 2)	SIGN CODE	WIDTH (IN)	HEIGHT (IN)	SHEETING REMARKS	SIGN LEGEND	NEW SIGNS		EXISTING SIGNS				EXIST POST		NUMBER OF NEW POSTS	SQUARE STEEL (IN)			TUBULAR STEEL Ø (IN)					SIGN FRAME REQUIRED	REMARKS	SIGN DETAIL LOCATION		
								"A"	"B"	RETAIN	SALVAGE FROM	SALVAGE TO	REMOVE	RETAIN	REMOVE		1.75	2.00	2.50	FOUNDATION	3.00	3.50	4.00	5.00			SHSM	PROJECT SHEET #	STANDARD SHEET #
																	(LB / FT)				(LB / FT)								
																	1.88	2.42	3.35		7.60	9.00	10.80	14.60					
POWNAL VT-346 SB							FY-FLUORESCENT YELLOW FYG-FLUORESCENT YELLOW GREEN															"SHSM"-STANDARD HIGHWAY SIGNS AND MARKINGS							
SB	4.628	F	VR-039	24	12		STATE HIGHWAY BEGINS							1		X													
		E	VR-038	24	12		STATE HIGHWAY ENDS							1															
		F	VD-700	6	10						1																		
		F	R2-1	24	30									1															
		F	VW16-18P	24	12	FY		2.00									1	15'-6" X										6	
		F	R2-1	24	30			5.00																		X			
		F	VD-700	6	10			MILE MARKER				1														X			
		F	R2-5P	24	18			3.00																					
SB	4.628	F	VR-039	24	12			3.00									1	15'-4" X								INSTALL BACK TO BACK SIGN ASSEMBLY TO THE RIGHT OF THE SPEED LIMIT 50 SIGN ASSEMBLY.		6	
		E	VR-038	24	12			3.00																			6		
SB	4.595	F	VW-619	30	30		SHOULDER NARROWS 						1			X													
		F	VD-421	60	48			20.00									11'-0" 12'-0" X								INSTALL AT SOUTH END OF BRIDGE BEHIND RAIL.		5		
SB	4.557	F	VD-421A	60	48		WELCOME TO VERMONT						1			X													
		F	VW-619	36	36			9.00									15'-0" 13'-8" X										7		
SB	4.502	F	W3-5	36	36								1			X													
		F	W3-5	36	36			9.00										13'-11" 14'-3" X								X			
SB	4.465	F	W10-1	36	36								1			X													
SIGN SUMMARY SHEET							SHEET TOTALS	54.00	0.00	0	1-0	1-0	7	0	0	8	120.0			0	0.0	0.0	0.0	0.0	PROJECT NAME: STATEWIDE SOUTHWEST REGION				
								SF	SF	EA	EA	EA	EA	EA	EA	EA		FT		EA	LB	LB	LB	LB	PROJECT NUMBER: STPG SIGN(41)				
							VERMONT AGENCY OF TRANSPORTATION																		FILE NAME: 12C118				
							TOWN DIRECTIONAL TOTALS	346.1 339.8	0.0	33 32	5-0- 0-0-	5-0- 0-0-	72 66	0	0	30 28	450.0 420.0			0	0.0				PROJECT MANAGER: A. GAMBLE				
																						PLOT DATE: 2/13/2013							
																							DRAWN BY: J. KELLY						
																							CHECKED: A. GAMBLE						
																							DESIGNED BY: J. KELLY						
																							POWNAL SB SHEET 1						
																							SHEET 86 OF 97						

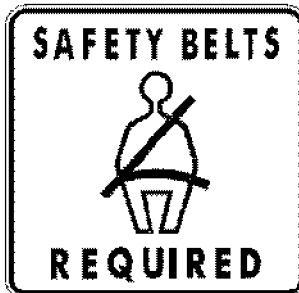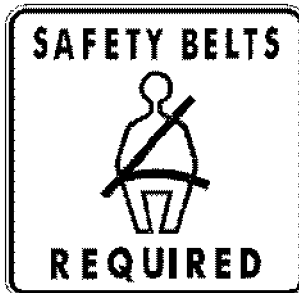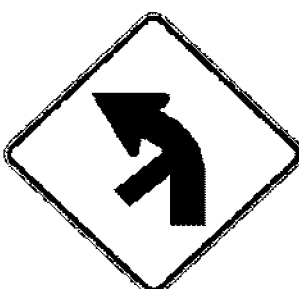DIRECTION	MILEPOINT	LOCATION CODE (SHEET 2)	SIGN CODE	WIDTH (IN)	HEIGHT (IN)	SHEETING REMARKS	SIGN LEGEND	NEW SIGNS		EXISTING SIGNS				EXIST POST		NUMBER OF NEW POSTS	SQUARE STEEL (IN)			TUBULAR STEEL Ø (IN)					SIGN FRAME REQUIRED	REMARKS	SIGN DETAIL LOCATION		
								"A"	"B"	RETAIN	SALVAGE FROM	SALVAGE TO	REMOVE	RETAIN	REMOVE		1.75	2.00	2.50	FOUNDATION	3.00	3.50	4.00	5.00			SHSM	PROJECT SHEET #	STANDARD SHEET #
																	(LB / FT)				(LB / FT)								
																	1.88	2.42	3.35		7.60	9.00	10.80	14.60					
POWNAL VT-346 SB							FY-FLUORESCENT YELLOW FYG-FLUORESCENT YELLOW GREEN															"SHSM"-STANDARD HIGHWAY SIGNS AND MARKINGS							
		F	W10-1	36	36			7.07							1		13'-6" X							X					
SB	4.406	F	R2-1	24	30							1		X															
		F	R2-1	30	36			7.50							1		14'-0" X							X	INSTALL DIRECTLY ACROSS FROM NORTH BOUND SPEED LIMIT 50 SIGN ASSEMBLY.				
SB	4.345	F	R15-1	48	9		RAILROAD CROSSBUCKS 			1				X															
SB	4.303	A	VR-601	36	36			9.00							2		14'-5" 15'-0" X								INSTALL 185 FEET NORTH OF EXISTING \$500 FINE SIGN ASSEMBLY (EDGE OF LAWN)		6		
SB	4.268	F	VR-023B	24	30		\$500 FINE FOR LITTERING					1		X															
		F	VR-654	24	24			4.00																	INSTALL NEW SIGN ON EXISTING FLANGED CHANNEL SIGN POST.		6		
SB	4.178	F	R2-1	24	30							1		X															
		F	R2-1	24	30			5.00																X	INSTALL NEW SIGN ON EXISTING FLANGED CHANNEL SIGN POST.				
SB	4.053	F	R2-1	24	30							1		X															
		F	R2-1	30	36			7.50																X	INSTALL NEW SIGN ON EXISTING FLANGED CHANNEL SIGN POST.				
SB	4.015	F	W1-2ML	30	30		MODIFIED LEFT CURVE					1		X															
SB	3.974	F	VR-048	24	30		STOP FOR SCHOOL BUS					1		X															
SB	3.960	F	W1-2ML	36	36			9.00							2		15'-0" 15'-0" X								INSTALL 75 FEET SOUTH OF EXISTING "STOP FOR SCHOOL BUS" SIGN ASSEMBLY.		8		
SB	3.914	F	W1-6	48	24							1		X															
SIGN SUMMARY SHEET							SHEET TOTALS	49.07	0.00	1	0	0	7	0	0	6	90.0			0	0.0	0.0	0.0	0.0	PROJECT NAME: STATEWIDE SOUTHWEST REGION				
								SF	SF	EA	EA	EA	EA	EA	EA	EA		FT		EA	LB	LB	LB	LB	PROJECT NUMBER: STPG SIGN(41)				
																											FILE NAME: 12C118		
VERMONT AGENCY OF TRANSPORTATION							TOWN DIRECTIONAL TOTALS	346.1 339.8	0.0	33 32	5 0	5 0	72 66	0	0	30 28	450.0 420.0			0	0.0				PROJECT MANAGER: A. GAMBLE				
																										DRAWN BY: J. KELLY			
																										CHECKED: A. GAMBLE			
																							PLOT DATE: 2/13/2013						
																							SHEET 87 OF 97						

[illegible]



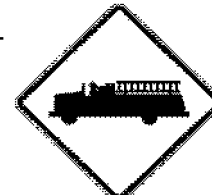
DIRECTION	MILEPOINT	LOCATION CODE (SHEET 2)	SIGN CODE	WIDTH (IN)	HEIGHT (IN)	SHEETING REMARKS	SIGN LEGEND	NEW SIGNS		EXISTING SIGNS				EXIST POST		NUMBER OF NEW POSTS	SQUARE STEEL (IN)			TUBULAR STEEL Ø (IN)					SIGN FRAME REQUIRED	REMARKS	SIGN DETAIL LOCATION		
								"A"	"B"	RETAIN	SALVAGE FROM	SALVAGE TO	REMOVE	RETAIN	REMOVE		1.75	2.00	2.50	FOUNDATION	3.00	3.50	4.00	5.00			SHSM	PROJECT SHEET #	STANDARD SHEET #
																	(LB / FT)				(LB / FT)								
																	1.88	2.42	3.35		7.60	9.00	10.80	14.60					
POWNAL VT-346 SB							FY-FLUORESCENT YELLOW FYG-FLUORESCENT YELLOW GREEN															"SHSM"-STANDARD HIGHWAY SIGNS AND MARKINGS							
		F	VD1-1A	72	12			6.00															INSTALL NEW ON EXISTING FLANGED CHANNEL SIGN POSTS.		10				
SB	3.588	F	OM-3R	12	36								1	X															
		F	OM3-R	12	36			3.00																INSTALL ON EXISTING FLANGED CHANNEL SIGN POST.	X				
SB	3.580	E	OM-3L	12	36								1	X															
		E	OM3-L	12	36			3.00																INSTALL ON EXISTING FLANGED CHANNEL SIGN POST.	X				
SB	3.534	F	M3-3	24	12								1	X															
		F	M1-5	30	24								1																
		F	M3-3	24	12			2.00																INSTALL ON EXISTING FLANGED CHANNEL SIGN POST.				E-136B	
		F	M1-5	30	24			5.00																				E-136B	
SB	3.419	F	VD-700	6	10						1																		
		F	VW-622	30	30								1		X														
		F	VD-700	6	10																								
		F	VW-622	30	30			6.25								1		11'-0" X									7		
SB	3.342	F	R2-1	24	30								1	X															
		F	R2-1	24	30			5.00																INSTALL ON EXISTING FLANGED CHANNEL SIGN POST.	X				
SB	3.233	F	VD-700	6	10						1																		
		F	W11-8	30	30								1	X	X														
		F	VD-700	6	10																								
		F	W11-8	30	30			6.25								1		15'-0" X											
SIGN SUMMARY SHEET							SHEET TOTALS	36.50	0.00	0	2-0	2-0	7	0	0	2-1		30.0-15.0		0	0.0	0.0	0.0	0.0	PROJECT NAME: STATEWIDE SOUTHWEST REGION				
								SF	SF	EA	EA	EA	EA	EA	EA	EA		FT		EA	LB	LB	LB	LB	PROJECT NUMBER: STPG SIGN(41)				
																								FILE NAME: 12C118					
VERMONT AGENCY OF TRANSPORTATION																								PROJECT MANAGER: A. GAMBLE					
							TOWN DIRECTIONAL TOTALS	346.1339.8	0.0	33-32	5-0	5-0	72-66	0	0	30-28		450.0420.0		0					PLOT DATE: 2/13/2013				
																								DRAWN BY: J. KELLY					
																								CHECKED: A. GAMBLE					
																								SHEET 89 OF 97					
																								DESIGNED BY: J. KELLY					
																								POWNAL SB SHEET 4					

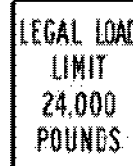DIRECTION	MILEPOINT	LOCATION CODE (SHEET 2)	SIGN CODE	WIDTH (IN)	HEIGHT (IN)	SHEETING REMARKS	SIGN LEGEND	NEW SIGNS		EXISTING SIGNS				EXIST POST		NUMBER OF NEW POSTS	SQUARE STEEL (IN)			TUBULAR STEEL Ø (IN)					SIGN FRAME REQUIRED	REMARKS	SIGN DETAIL LOCATION		
								"A"	"B"	RETAIN	SALVAGE FROM	SALVAGE TO	REMOVE	RETAIN	REMOVE		1.75	2.00	2.50	FOUNDATION	3.00	3.50	4.00	5.00			SHSM	PROJECT SHEET #	STANDARD SHEET #
																	(LB / FT)				(LB / FT)								
																	1.88	2.42	3.35		7.60	9.00	10.80	14.60					
POWNAL VT-346 SB							FY-FLUORESCENT YELLOW FYG-FLUORESCENT YELLOW GREEN															"SHSM"-STANDARD HIGHWAY SIGNS AND MARKINGS							
SB	3.146	F	R2-1	24	30			5.00							1		14'-3" X							INSTALL 460 FEET SOUTH OF FIRE TRUCK SYMBOL SIGN ASSEMBLY.	X				
SB	3.006	G	VR-017	24	30								1											DEAN RD (TH-24)					
		G	VR-017	24	30			5.00						X										INSTALL ON EXISTING FLANGED CHANNEL SIGN POST.		6			
SB	3.000	A	D3-1	UNK	UNK		DEAN RD STREET SIGN						1											DEAN RD (TH-24)					
		G	VD-700	6	10		MILE MARKERS UNREADABLE						2											MILE MARKERS UNREADABLE					
		H	R1-1	30	30								1		X														
		A	D3-1	30	12			2.50								1		13'-0" X							INSTALL STREET SIGN ABOVE STOP SIGN.		12		
		H	R1-1	30	30			6.25																		X			
SB	2.971	F	R2-1	24	30		SPEED LIMIT 35			1				X															
SB	2.941	F	S3-1	36	36		SCHOOL BUS STOP AHEAD			1				X															
SB	2.911	F	VW-133L	30	30		HIDDEN DRIVES LEFT			1				X															
SB	2.790	F	W1-4L	30	30		LEFT REVERSE CURVE			1				X															
SB	2.600	F	R2-1	24	30		SPEED LIMIT 50			1				X															
SB	2.491	F	VW-444	30	30		WATCH FOR FALLEN ROCK						1		X														
		F	W1-4R	30	30		RIGHT REVERSE CURVE						1																
		F	VD-700	6	10								1																
		F	W13-1	18	18		40 MPH ADVISORY						1																
SIGN SUMMARY SHEET							SHEET TOTALS	18.75	0.00	5	0	0	9 6	0	0	2	30.0			0	0.0	0.0	0.0	0.0	PROJECT NAME: STATEWIDE SOUTHWEST REGION				
								SF	SF	EA	EA	EA	EA	EA	EA	EA		FT		EA	LB	LB	LB	LB	PROJECT NUMBER: STPG SIGN(41)				
																											FILE NAME: 12C118		
VERMONT AGENCY OF TRANSPORTATION							TOWN DIRECTIONAL TOTALS	346.1 339.8	0.0	33 32	5 0	5 0	72 66	0	0	30 28	450.0 420.0			0	0.0				PROJECT MANAGER: A. GAMBLE				
																											DRAWN BY: J. KELLY		
																											CHECKED: A. GAMBLE		
																							DESIGNED BY: J. KELLY						
																							POWNAL SB SHEET 5						
																							PLOT DATE: 2/13/2013						
																							SHEET 90 OF 97						

DIRECTION	MILEPOINT	LOCATION CODE (SHEET 2)	SIGN CODE	WIDTH (IN)	HEIGHT (IN)	SHEETING REMARKS	SIGN LEGEND	NEW SIGNS		EXISTING SIGNS				EXIST POST		NUMBER OF NEW POSTS	SQUARE STEEL (IN)			TUBULAR STEEL Ø (IN)					SIGN FRAME REQUIRED	REMARKS	SIGN DETAIL LOCATION		
								"A"	"B"	RETAIN	SALVAGE FROM	SALVAGE TO	REMOVE	RETAIN	REMOVE		1.75	2.00	2.50	FOUNDATION	3.00	3.50	4.00	5.00			SHSM	PROJECT SHEET #	STANDARD SHEET #
																	(LB / FT)				(LB / FT)								
																	1.88	2.42	3.35		7.60	9.00	10.80	14.60					
POWNAL VT-346 SB							FY-FLUORESCENT YELLOW FYG-FLUORESCENT YELLOW GREEN															"SHSM"-STANDARD HIGHWAY SIGNS AND MARKINGS							
SB	2.440	F	VW-285	30	30			6.25							1		15'-6" X							INSTALL 200 FEET NORTH OF THE 2.40 MILE MARKER		7			
SB	2.400	F	W1-4R	30	30			6.25							1		16'-9" X							INSTALL AT 2.40 MILE MARKER.	X				
		F	W13-1P	18	18			2.25																		X			
SB	1.518	F	VD-700 W11-5	30	30					1			1	X															
		F	W11-5	30	30			6.25																INSTALL NEW SIGN ON EXISTING FLANGED CHANNEL SIGN POST.	X				
SB	1.074	F	VW-054R	30	30		HIDDEN DRIVE RIGHT						1		X														
SB	0.826	A	D3-1	UNK	UNK								1											LINCOLN ST (TH-30)					
		G	VR-017	24	30								1	X	X														
		A	D3-1	40	12			3.33																INSTALL ABOVE LEGAL LOAD AS EXISTING.		12			
		G	VR-017	24	30			5.00							1		13'-0" X									6			
SB	0.820	H	R1-1	30	30		STOP			1				X										LINCOLN ST (TH-30)					
SB	0.815	F	R8-3A	24	24		NO PARKING			1				X															
		F	VR-644P	24	12		BEGIN			1																			
SB	0.729	F	W3-5	36	36		SPEED REDUCTION (35)			1				X															
SB	0.693	F	VD-018	30	18		POWNAL VILLAGE SIGN			1				X															
SIGN SUMMARY SHEET							SHEET TOTALS	29.33	0.00	~~6~~ 5	0	0	4	0	0	~~3~~ 2		~~45.0~~ 30.0		0	0.0	0.0	0.0	0.0	PROJECT NAME: STATEWIDE SOUTHWEST REGION	PROJECT NUMBER: STPG SIGN(41)			
								SF	SF	EA	EA	EA	EA	EA	EA	EA		FT		EA	LB	LB	LB	LB	FILE NAME: 12C118	PLOT DATE: 2/13/2013			
																									PROJECT MANAGER: A. GAMBLE	DRAWN BY: J. KELLY			
VERMONT AGENCY OF TRANSPORTATION							TOWN DIRECTIONAL TOTALS	346.1 339.8	0.0	~~33~~ 32	~~5~~ 0	~~5~~ 0	~~72~~ 66	0	0	~~30~~ 28		~~450.0~~ 420.0		0	0.0				DESIGNED BY: J. KELLY	CHECKED: A. GAMBLE			
																							POWNAL SB SHEET 6	SHEET 91 OF 97					

DIRECTION	MILEPOINT	LOCATION CODE (SHEET 2)	SIGN CODE	WIDTH (IN)	HEIGHT (IN)	SHEETING REMARKS	SIGN LEGEND	NEW SIGNS		EXISTING SIGNS				EXIST POST		NUMBER OF NEW POSTS	SQUARE STEEL (IN)			TUBULAR STEEL Ø (IN)					SIGN FRAME REQUIRED	REMARKS	SIGN DETAIL LOCATION		
								"A"	"B"	RETAIN	SALVAGE FROM	SALVAGE TO	REMOVE	RETAIN	REMOVE		1.75	2.00	2.50	FOUNDATION	3.00	3.50	4.00	5.00			SHSM	PROJECT SHEET #	STANDARD SHEET #
																	(LB / FT)				(LB / FT)								
																	1.88	2.42	3.35		7.60	9.00	10.80	14.60					
POWNAL VT-346 SB							FY-FLUORESCENT YELLOW FYG-FLUORESCENT YELLOW GREEN															"SHSM"-STANDARD HIGHWAY SIGNS AND MARKINGS							
SB	0.648	F	R2-1	30	36		SPEED LIMIT 35			1				X															
SB	0.564	F	W1-1L	30	30		LEFT TURN			1				X															
		F	W13-1	18	18		20 MPH ADVISORY						1												REMOVE 20 MPH ADVISORY				
		F	W13-1P	18	18		15 MPH	2.25																	INSTALL NEW 15 MPH ADVISORY.	X			
SB	0.503	F	R8-3A	24	24		NO PARKING			1				X															
SB	0.492	E	M3-1	24	12		ROUTE MARKER ASSEMBLY.			1				X															
SB	0.492	E	M1-5	30	24					1																			
SB	0.492	E	M6-1	21	15					1																			
SB	0.490	E	W1-6	48	24		LARGE RIGHT ARROW			1				X															
SB	0.489	G	VR-017	24	30								1	X											MAIN STREET (TH-8)				
		G	VR-017	24	30		LEGAL LOAD LIMIT 24,000 POUNDS	5.00																		INSTALL NEW SIGN ON EXISTING FLANGED CHANNEL SIGN POST.		6	
SB	0.485	F	D3-1	UNK	UNK								1												MAIN STREET (TH-8)				
		G	VD-700	6	10		3460 0208 0048			1																			
		H	R1-1	30	30								1	X															
		F	D3-1	30	12		Main st	2.50																	INSTALL STREET NAME SIGN ABOVE STOP SIGN AND ON EXISTING POST.		12		
		H	R1-1	30	30		STOP	6.25																			X		
SIGN SUMMARY SHEET							SHEET TOTALS		16.00	0.00	8 7	0	0	4	0	0	0	0.0		0	0.0	0.0	0.0	0.0	PROJECT NAME: STATEWIDE SOUTHWEST REGION				
									SF	SF	EA	EA	EA	EA	EA	EA		FT		EA	LB	LB	LB	LB	PROJECT NUMBER: STPG SIGN(41)				
							TOWN DIRECTIONAL TOTALS		346.1 339.8	0.0	33 32	5 0	5 0	72 66	0	0	30 28	450.0 420.0		0	0.0				FILE NAME: 12C118			PLOT DATE: 2/13/2013	
VERMONT AGENCY OF TRANSPORTATION																							PROJECT MANAGER: A. GAMBLE			DRAWN BY: J. KELLY			
																										DESIGNED BY: J. KELLY			CHECKED: A. GAMBLE
																							POWNAL SB SHEET 7			SHEET 92 OF 97			

DIRECTION	MILEPOINT	LOCATION CODE (SHEET 2)	SIGN CODE	WIDTH (IN)	HEIGHT (IN)	SHEETING REMARKS	SIGN LEGEND	NEW SIGNS		EXISTING SIGNS				EXIST POST		NUMBER OF NEW POSTS	SQUARE STEEL (IN)			TUBULAR STEEL Ø (IN)				SIGN FRAME REQUIRED	REMARKS	SIGN DETAIL LOCATION			
								"A"	"B"	RETAIN	SALVAGE FROM	SALVAGE TO	REMOVE	RETAIN	REMOVE		1.75	2.00	2.50	FOUNDATION	3.00	3.50	4.00			5.00	SHSM	PROJECT SHEET #	STANDARD SHEET #
																	(LB / FT)				(LB / FT)								
																	1.88	2.42	3.35		7.60	9.00	10.80			14.60			
POWNAL VT-346 SB							FY-FLUORESCENT YELLOW FYG-FLUORESCENT YELLOW GREEN															"SHSM"-STANDARD HIGHWAY SIGNS AND MARKINGS							
SB	0.484	G	VR-017	24	30								1	X									CHURCH ST (TH-1)						
		G	VR-017	24	30			5.00															INSTALL ON EXISTING FLANGED CHANNEL SIGN POST.		6				
SB	0.483	H	R1-1	30	30								1	X									CHURCH ST (TH-1)						
		F	D3-1	38	12			3.17															INSTALL ABOVE STOP SIGN.		12				
		H	R1-1	30	30			6.25															INSTALL ON EXISTING FLANGED CHANNEL SIGN POST.	X					
SB	0.483	F	D3-1	UNK	UNK		CHURCH ST STREET NAME SIGN						1		X														
SB	0.482	F	W1-6	48	24		LARGE LEFT ARROW			1				X															
SB	0.481	F	M3-3	24	12		SOUTH			1				X															
		F	M1-5	30	24		VERMONT ROUTE 346			1																			
		F	M6-1	21	15		LEFT ARROW			1																			
SB	0.456	F	M3-3	24	12		SOUTH			1				X															
		F	M1-5	30	24		VERMONT ROUTE 346			1																			
SB	0.410	F	R8-3A	24	24		NO PARKING			1				X															
SB	0.355	F	W1-4R	30	30		RIGHT REVERSE CURVE						1		X														
		F	W11-8	30	30								1																
SIGN SUMMARY SHEET							SHEET TOTALS		14.42	0.00	7	0	0	5	0	0	0.0			0	0.0	0.0	0.0	0.0	PROJECT NAME: STATEWIDE SOUTHWEST REGION				
									SF	SF	EA	EA	EA	EA	EA	EA		FT		EA	LB	LB	LB	LB	PROJECT NUMBER: STPG SIGN(41)				
																										FILE NAME: 12C118			
																										PROJECT MANAGER: A. GAMBLE			
VERMONT AGENCY OF TRANSPORTATION							TOWN DIRECTIONAL TOTALS		346.1 339.8	0.0	33 32	5 0	5 0	72 66	0	0	30 28	450.0 420.0			0	0.0				PLOT DATE: 2/13/2013			
																									DRAWN BY: J. KELLY				
																						CHECKED A. GAMBLE							
																						SHEET 93 OF 97							

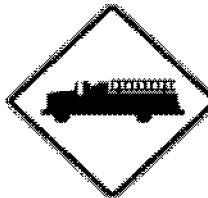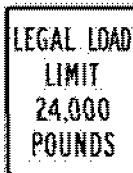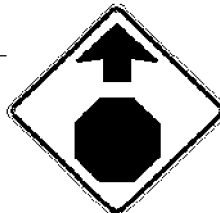DIRECTION	MILEPOINT	LOCATION CODE (SHEET 2)	SIGN CODE	WIDTH (IN)	HEIGHT (IN)	SHEETING REMARKS	SIGN LEGEND	NEW SIGNS		EXISTING SIGNS				EXIST POST		NUMBER OF NEW POSTS	SQUARE STEEL (IN)			TUBULAR STEEL Ø (IN)					SIGN FRAME REQUIRED	REMARKS	SIGN DETAIL LOCATION		
								"A"	"B"	RETAIN	SALVAGE FROM	SALVAGE TO	REMOVE	RETAIN	REMOVE		1.75	2.00	2.50	FOUNDATION	3.00	3.50	4.00	5.00			SHSM	PROJECT SHEET #	STANDARD SHEET #
																	(LB / FT)				(LB / FT)								
																	1.88	2.42	3.35		7.60	9.00	10.80	14.60					
POWNAL VT-346 SB							FY-FLUORESCENT YELLOW FYG-FLUORESCENT YELLOW GREEN															"SHSM"-STANDARD HIGHWAY SIGNS AND MARKINGS							
		F	W11-8	30	30			6.25							1	15'-0" X								X					
SB	0.300	F	R8-3A	24	24		NO PARKING			1				X															
SB	0.300	F	R2-1	24	30		SPEED LIMIT 35			1																			
SB	0.250	E	W1-6	48	24		LARGE RIGHT ARROW			1				X															
SB	0.248	G	VR-017	24	30							1		X										CHURCH STREET (TH-1)					
		G	VR-017	24	30			5.00							1	14'-4" X									6				
SB	0.242	F	D3-1	UNK	UNK								1											CHURCH STREET (TH-1)					
		G	VD-700	6	10					1																			
		H	R1-1	30	30							1	X																
		F	D3-1	38	12			3.17																INSTALL NEW ABOVE STOP SIGN.		12			
		H	R1-1	30	30			6.25																INSTALL NEW SIGN ON EXISTING SIGN POST.	X				
SB	0.180	F	W3-1	36	36								1	X															
		F	W3-1	30	30			6.25																INSTALL ON EXISTING FLANGED CHANNEL SIGN POST.	X				
SB	0.151	F	M2-1	21	15								1		X														
		F	M1-4	24	24								1																
		F	M4-6	24	12								1																
SIGN SUMMARY SHEET							SHEET TOTALS	26.92	0.00	~~4~~ 3	0	0	7	0	0	2	30.0			0	0.0	0.0	0.0	0.0	PROJECT NAME: STATEWIDE SOUTHWEST REGION				
								SF	SF	EA	EA	EA	EA	EA	EA	EA		FT		EA	LB	LB	LB	LB	PROJECT NUMBER: STPG SIGN(41)				
							TOWN DIRECTIONAL TOTALS	346.1 339.8	0.0	~~33~~ 32	~~5~~ 0	~~5~~ 0	~~72~~ 66	0	0	~~30~~ 28	450.0 420.0			0	0.0				FILE NAME: 12C118				
VERMONT AGENCY OF TRANSPORTATION																							PROJECT MANAGER: A. GAMBLE			PLOT DATE: 2/13/2013			
																										DRAWN BY: J. KELLY			CHECKED: A. GAMBLE
																						DESIGNED BY: J. KELLY			SHEET 94 OF 97				
																							POWNAL SB SHEET 9						

DIRECTION	MILEPOINT	LOCATION CODE (SHEET 2)	SIGN CODE	WIDTH (IN)	HEIGHT (IN)	SHEETING REMARKS	SIGN LEGEND	NEW SIGNS		EXISTING SIGNS				EXIST POST		NUMBER OF NEW POSTS	SQUARE STEEL (IN)			TUBULAR STEEL Ø (IN)				SIGN FRAME REQUIRED	REMARKS	SIGN DETAIL LOCATION			
								"A"	"B"	RETAIN	SALVAGE FROM	SALVAGE TO	REMOVE	RETAIN	REMOVE		1.75	2.00	2.50	FOUNDATION	3.00	3.50	4.00			5.00	SHSM	PROJECT SHEET #	STANDARD SHEET #
																	(LB / FT)				(LB / FT)								
																	1.88	2.42	3.35		7.60	9.00	10.80			14.60			
POWNAL VT-346 SB							FY-FLUORESCENT YELLOW FYG-FLUORESCENT YELLOW GREEN															"SHSM"-STANDARD HIGHWAY SIGNS AND MARKINGS							
		F	M1-5	30	24								1																
		F	M2-1	21	15			2.19							2		14'-2" 14'-5" X					#1A		X	5				
		F	M1-4	24	24			4.00																X					
		F	M4-6	24	12		JCT END 7 VERMONT 346	2.00																FABRICATE "END" SIGN WITH GREEN LEGEND ON WHITE BACKGROUND.	X				
		F	M1-5	30	24			5.00																		E-136B			
SB	0.085	F	D1-1A	72	10								1	X															
		F	D1-1A	72	10								1																
		F	D1-1A	72	10								1																
		F	VD1-1A	72	12		← Pownal Center 3	6.00																					
		F	VD1-1A	72	12		← Bennington 9	6.00																			10		
		F	VD1-1A	72	12		Williamstown MA 4 →	6.00																			10		
SB	0.062	F	M3-1	24	12		ROUTE MARKER ASSEMBLY						1	X															
		F	M1-4	24	24								1																
		F	M6-1	21	15								1																
		F	M3-3	24	12								1																
SIGN SUMMARY SHEET							SHEET TOTALS	31.19	0.00	0	0	0	8	0	0	2	30.0			0	0.0	0.0	0.0	0.0	PROJECT NAME: STATEWIDE SOUTHWEST REGION PROJECT NUMBER: STPG SIGN(41)				
								SF	SF	EA	EA	EA	EA	EA	EA	EA		FT		EA	LB	LB	LB	LB	FILE NAME: 12C118 PROJECT MANAGER: A. GAMBLE DESIGNED BY: J. KELLY			PLOT DATE: 2/13/2013 DRAWN BY: J. KELLY CHECKED: A. GAMBLE	
VERMONT AGENCY OF TRANSPORTATION							TOWN DIRECTIONAL TOTALS	346.1 339.8	0.0	33 32	5 0	5 0	72 66	0	0	30 28	450.0 420.0			0	0.0				POWNAL SB SHEET 10 SHEET 96 OF 97				

DIRECTION	MILEPOINT	LOCATION CODE (SHEET 2)	SIGN CODE	WIDTH (IN)	HEIGHT (IN)	SHEETING REMARKS	SIGN LEGEND	NEW SIGNS		EXISTING SIGNS				EXIST POST		NUMBER OF NEW POSTS	SQUARE STEEL (IN)			TUBULAR STEEL Ø (IN)				SIGN FRAME REQUIRED	REMARKS	SIGN DETAIL LOCATION						
								"A"	"B"	RETAIN	SALVAGE FROM	SALVAGE TO	REMOVE	RETAIN	REMOVE		1.75	2.00	2.50	FOUNDATION	3.00	3.50	4.00			5.00	SHSM	PROJECT SHEET #	STANDARD SHEET #			
																	(LB / FT)				(LB / FT)											
																	1.88	2.42	3.35		7.60	9.00	10.80			14.60						
POWNA VT-346 SB							FY-FLUORESCENT YELLOW FYG-FLUORESCENT YELLOW GREEN															"SHSM"-STANDARD HIGHWAY SIGNS AND MARKINGS										
		F	M1-4	24	24																											
		F	M6-1	21	15																											
		F	M3-1	24	12			2.00															INSTALL SIGNS ON EXISTING SIGN FRAME AND FLANGED CHANNEL SIGN POSTS.	X								
		F	M1-4	24	24			4.00																X								
		F	M6-1L	21	15			2.19																X								
		F	M3-3	24	12			2.00																X								
		F	M1-4	24	24			4.00																X								
		F	M6-1R	21	15			2.19																X								
SB	0.033	F	R8-3A	24	30		NO PARKING			1				X																		
SB	0.033	F	M4-6P	24	12		END			1																						
SB	0.021	F	VR-656	24	30										X																	
		F	VR-656	24	30		DO NOT BLOCK DRIVE	5.00								1										6						
SB	0.018	TG	R1-1	30	30																											
		TG	R1-1	30	30		STOP	6.25							X									INSTALL ON EXISTING SIGN POST.	X							
SB	0.000	F	R1-1	30	30										X									INSTALL ON EXISTING POST	X							
		F	R1-1	30	30		STOP	6.25																								
SIGN SUMMARY SHEET							SHEET TOTALS			33.88 27.63	0.00	2	0	0	5 4	0	0	1	15.0			0	0.0	0.0	0.0	0.0	PROJECT NAME: STATEWIDE SOUTHWEST REGION PROJECT NUMBER: STPG SIGN(41)					
										SF	SF	EA	EA	EA	EA	EA	EA	EA	FT			EA	LB	LB	LB	LB	FILE NAME: 12C118 PROJECT MANAGER: A. GAMBLE DESIGNED BY: J. KELLY POWNA SB SHEET 11			PLOT DATE: 2/13/2013 DRAWN BY: J. KELLY CHECKED: A. GAMBLE SHEET 96 OF 97		
							VERMONT AGENCY OF TRANSPORTATION			TOWN DIRECTIONAL TOTALS			346.1 339.8	0.0	33 32	5 0	5 0	72 66	0	0	30 28	450.0 420.0			0	0.0						

TOWN TOTAL SIGN SUMMARY SHEET

STATEWIDE STPG SIGN(41)

Town name-Route	County	Town Mileage	NEW SIGNS (SF)		EXISTING SIGNS (EA)				EXIST POST (EA)		NUMBER OF NEW POSTS (EA)				SQUARE STEEL (IN)			TUBULAR STEEL Ø (IN)				
			TYPE A	TYPE B	RETAIN	SALVAGE FROM	SALVAGE TO	REMOVE	RETAIN	REMOVE	1.75"	2"	2.5"	TOTAL POSTS	1.75	2.00	2.50	FOUNDATION	3.00	3.50	4.00	5.00
											(LB / FT)				(LB / FT)				(LB / FT)			
											1.88	2.42	3.35		1.88	2.42	3.35		7.60	9.00	10.80	14.60
Readsboro VT-8 NB	Bennington	2.507	~~89.8~~ 90.6	0	1	0	0	18	0	0	0	13	0	13	0	195	0					
Readsboro VT-8 SB	Bennington	2.507	~~123.4~~ 124.3	0	1	0	0	27	0	0	0	10	2	12	0	150	30					
Searsburg VT-8 NB	Bennington	2.703	~~151.9~~ 158.6	0	~~1~~ 3	0	0	~~32~~ 37	0	0	0	~~20~~ 21	~~2~~ 23	~~22~~	0	~~300~~ 23	30					
Searsburg VT-8 SB	Bennington	2.703	121.5	0	0	0	0	~~30~~ 29	0	0	0	19	0	19	0	285	0					
Jamaica VT-30 NB	Windham	10.119	~~443.5~~ 438.5	0	~~29~~ 32	~~1~~ 2	~~1~~ 2	~~78~~ 88	0	0	0	~~62~~ 63	0	~~62~~ 63	0	~~930~~ 315	0					
Jamaica VT-30 SB	Windham	10.119	~~430.2~~ 431.8	0	~~29~~ 31	~~0~~ 2	~~0~~ 2	~~82~~ 85	0	0	0	~~61~~ 64	~~2~~ 66	~~63~~	0	~~915~~ 945	30					
Wells VT-31 NB	Rutland	1.756	136.7	0	0	0	0	~~30~~ 31	0	0	0	17	2	19	0	255	30					
Wells VT-31 SB	Rutland	1.756	75.8	0	1	0	0	~~18~~ 15	0	0	0	11	0	11	0	165	0					
Poultney VT-31 NB	Rutland	3.779	~~243.2~~ 248.2	0	2	0	0	~~57~~ 60	0	0	0	~~25~~ 27	0	~~25~~ 27	0	~~375~~ 960	0					
Poultney VT-31 SB	Rutland	3.779	207.2	0	2	0	0	~~41~~ 43	0	0	0	~~29~~ 31	0	~~29~~ 31	0	~~435~~ 405	0					
Pownal VT-346 NB	Bennington	4.628	224.3	0	~~28~~ 33	~~0~~ 3	~~0~~ 3	~~44~~ 46	0	0	0	~~31~~ 32	0	~~31~~ 32	0	~~465~~ 450	0					
Pownal VT-346 SB	Bennington	4.628	~~339.8~~ 346.1	0	~~32~~ 33	~~0~~ 5	~~0~~ 5	~~66~~ 72	0	0	0	~~26~~ 28	~~2~~ 30	~~28~~	0	~~390~~ 420	30					
				Sub-Total		1	1	523			Sub-Total				0	4860	150					
Estimated Salvaged Street Name Signs to be erected onto new posts =							0															
Estimated Salvaged Mile Markers to be erected onto new posts =							5															
Salvaged From signs to be added to Remove total =								1														
		REVISED TOTALS:	~~2603.6~~		137	12	12	551				336		346		5190						
		TOTAL =	2587.3	0	126	~~1~~	6	524	0	0	0	324	10	334	~~5010~~			0	0	0	0	0