
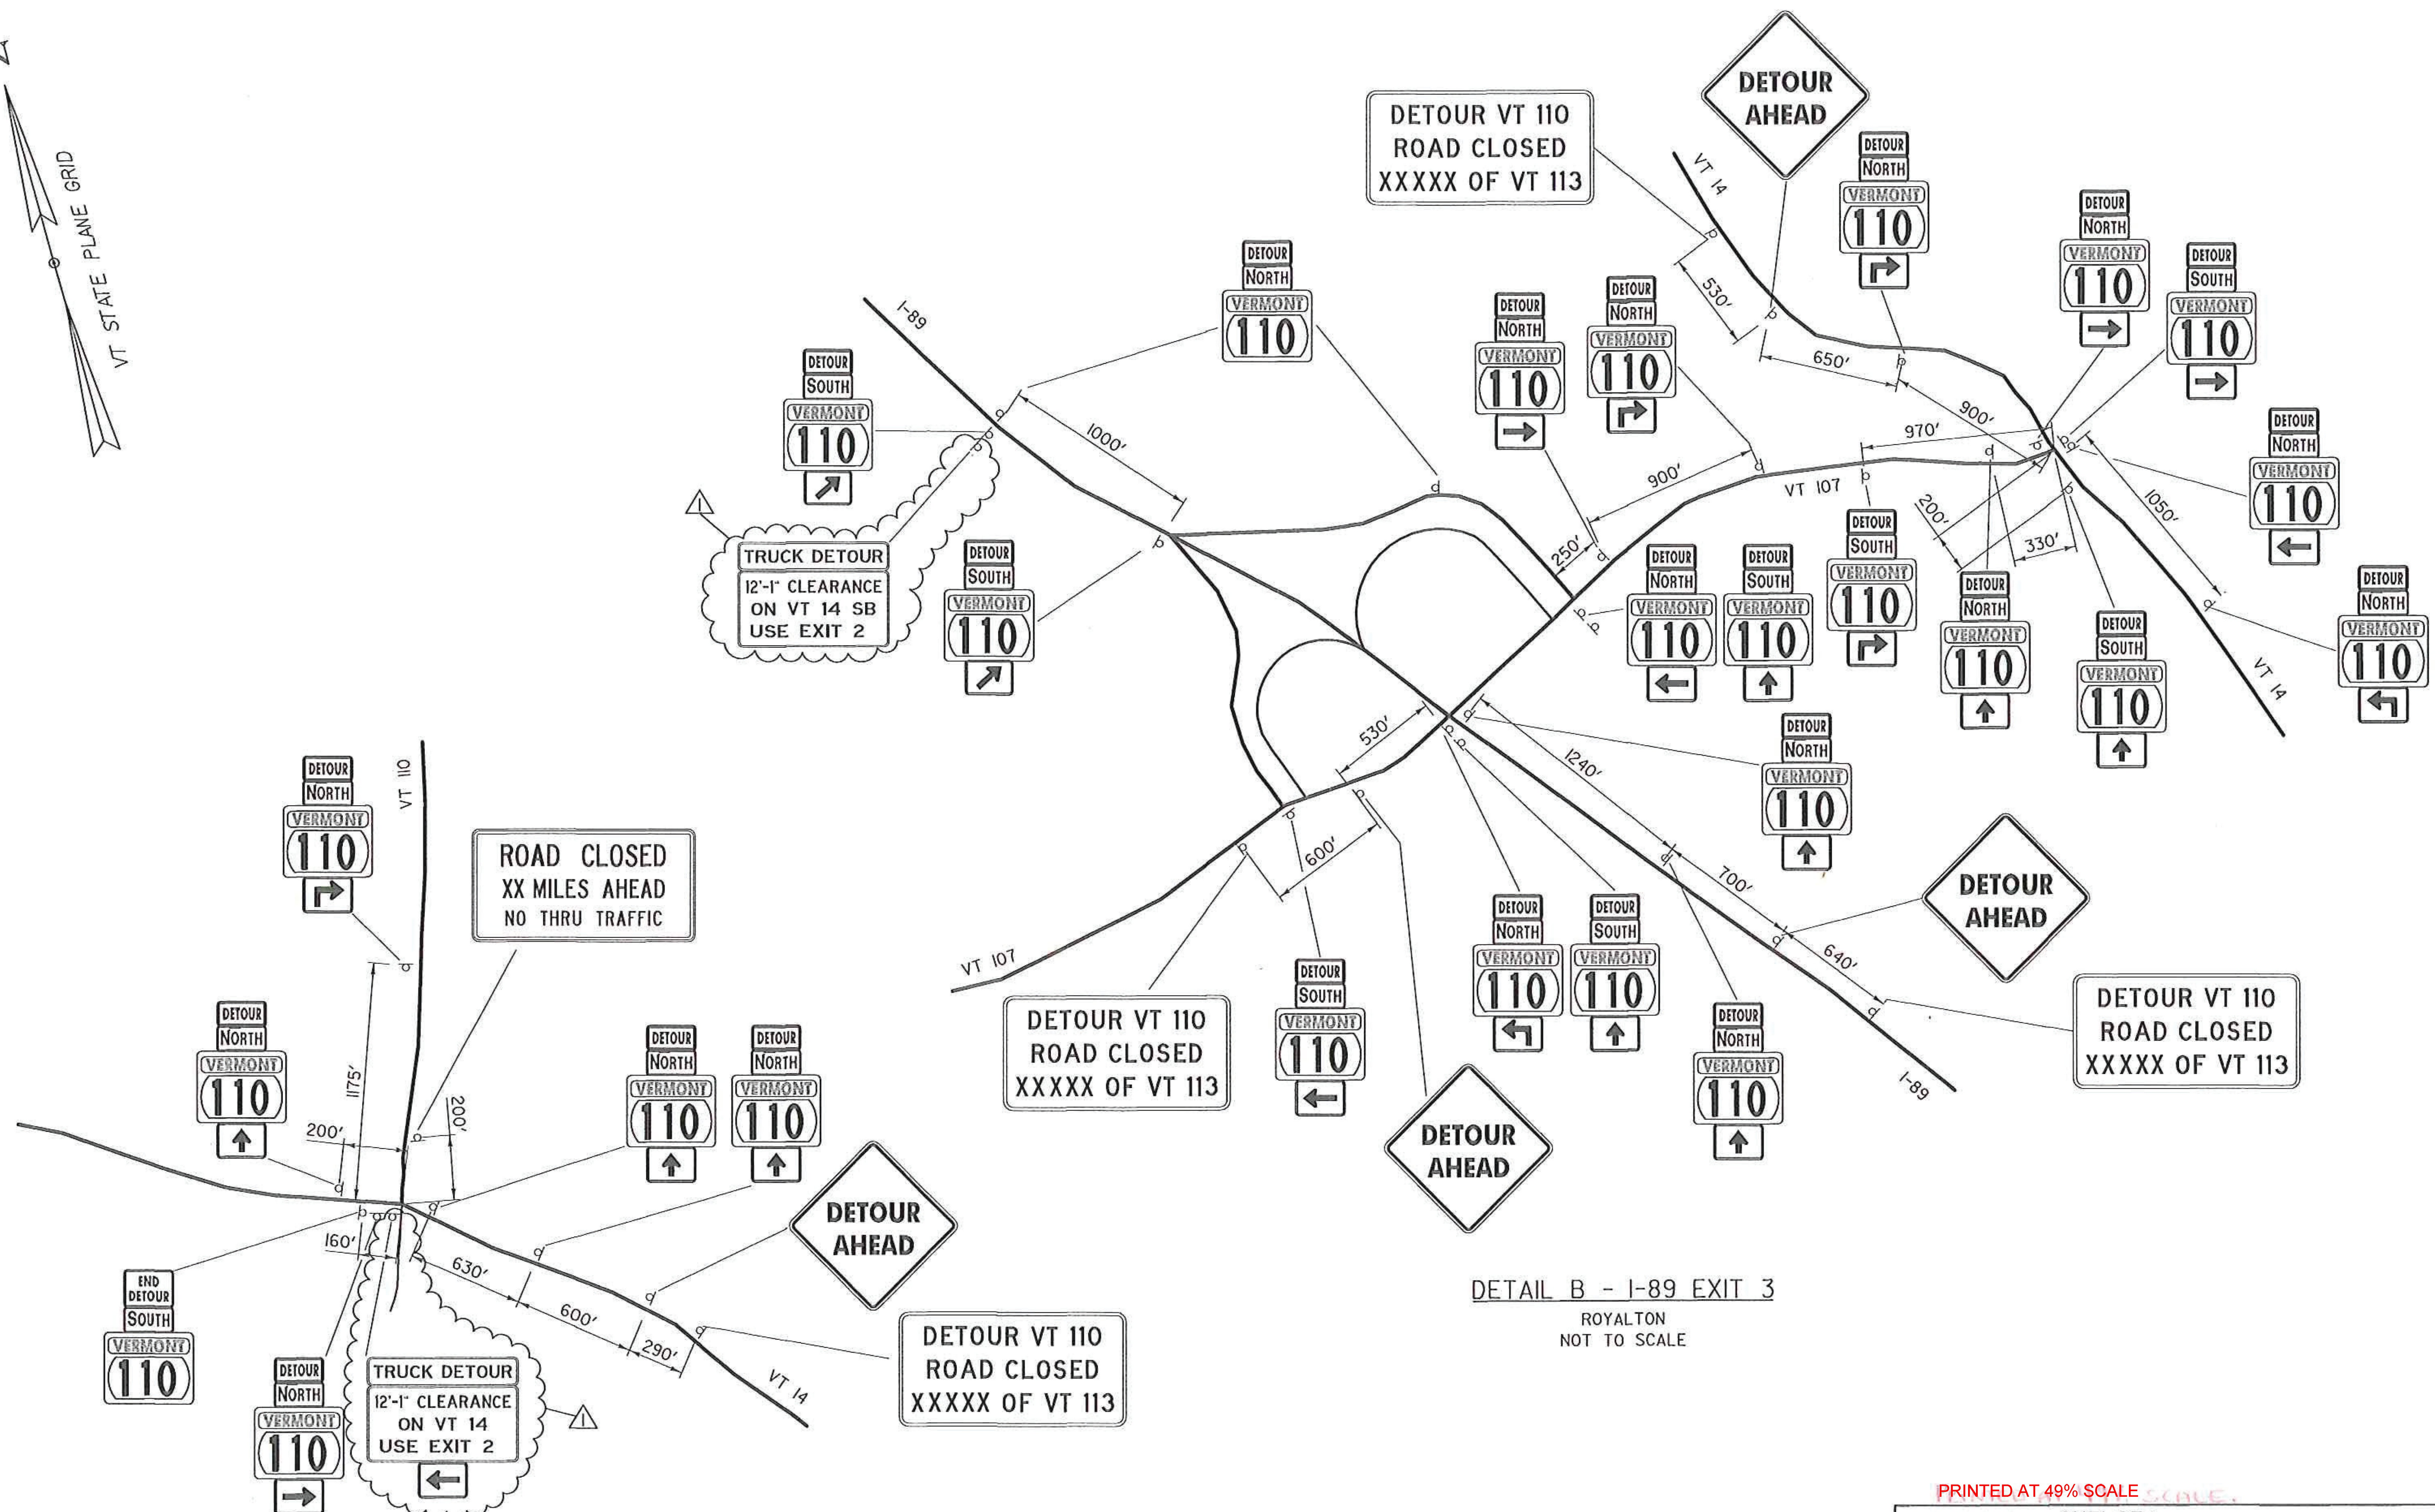


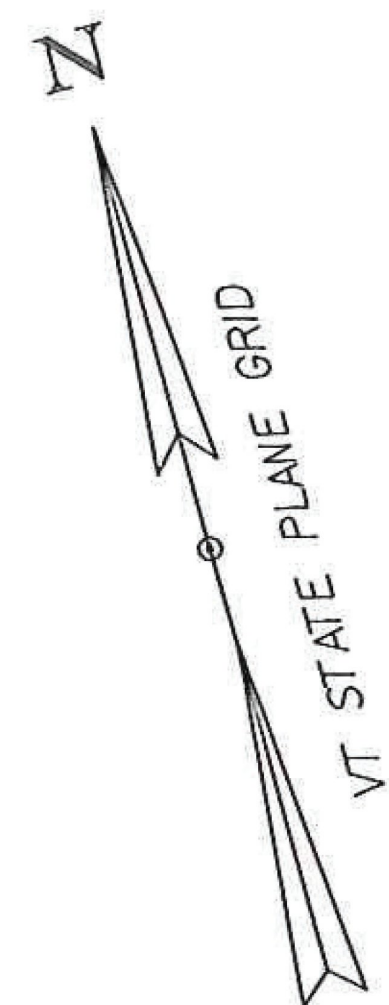

DETAIL A - VT 110 & VT 14
ROYALTON
NOT TO SCALE

DETAIL B - I-89 EXIT 3
ROYALTON
NOT TO SCALE

PRINTED AT 49% SCALE

PROJECT NAME:	CHelsea	FILE NAME:	z12c150regdtr1.dgn	PLOT DATE:	4/5/2017
PROJECT NUMBER:	BHF 0169(9) & BHF 0169(10)	PROJECT LEADER:	J. OLUND	DRAWN BY:	P. MCCLURE
		DESIGNED BY:	A. GREENLAW	CHECKED BY:	K. DUCHARME
		REGIONAL TRAFFIC CONTROL DETAILS I		SHEET	7A OF 137

REV	DATE	DESCRIPTION
△	4/5/2017	ADDED SIGNS

TYLIN INTERNATIONAL