




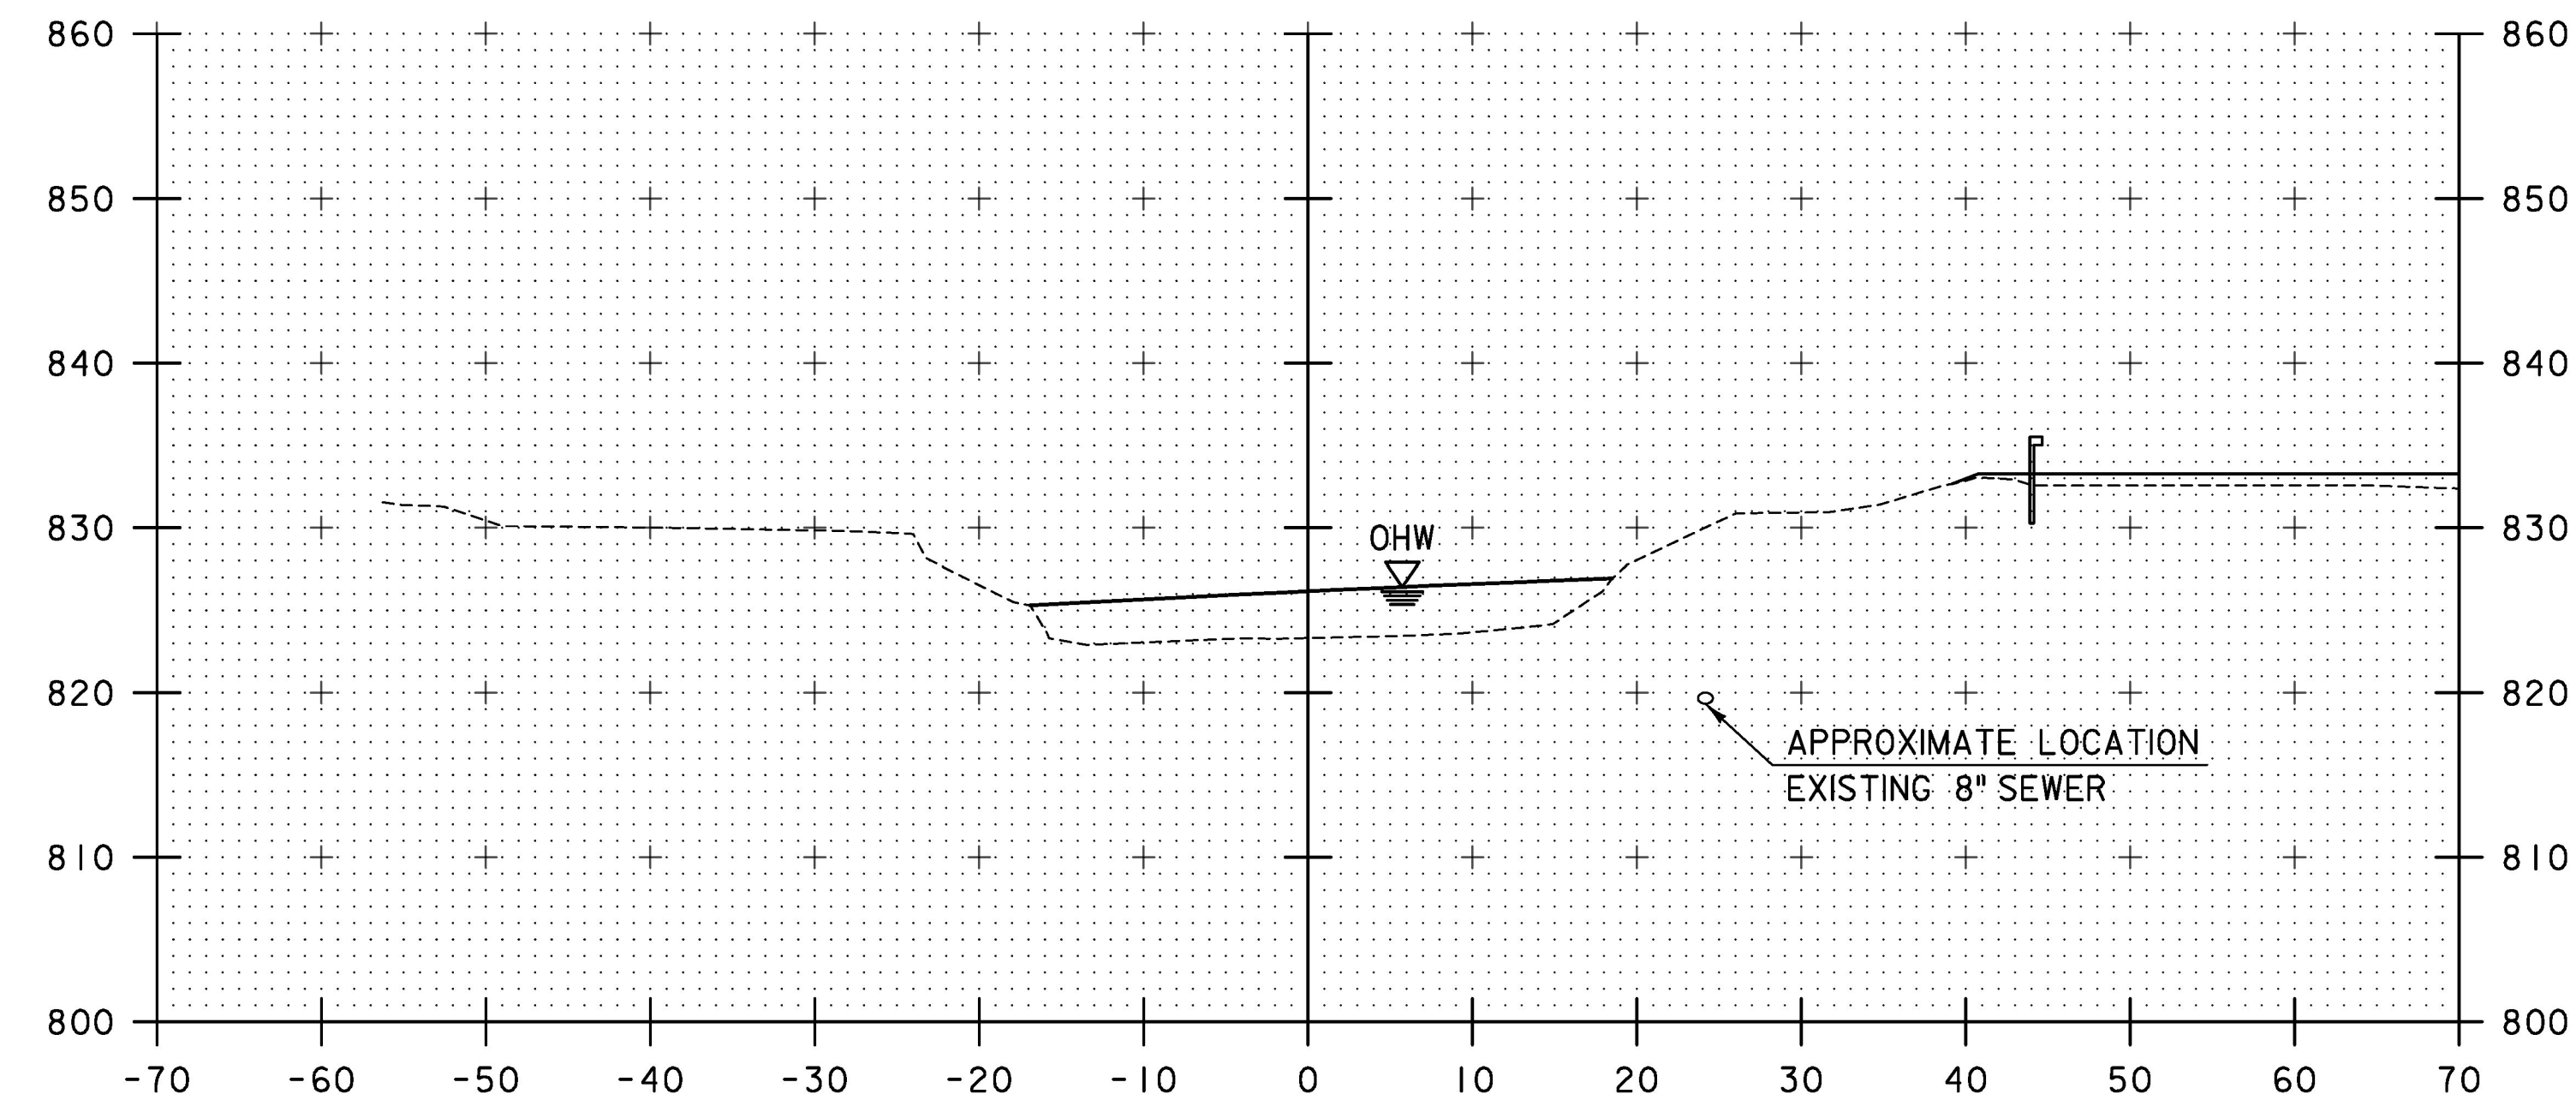


50+25

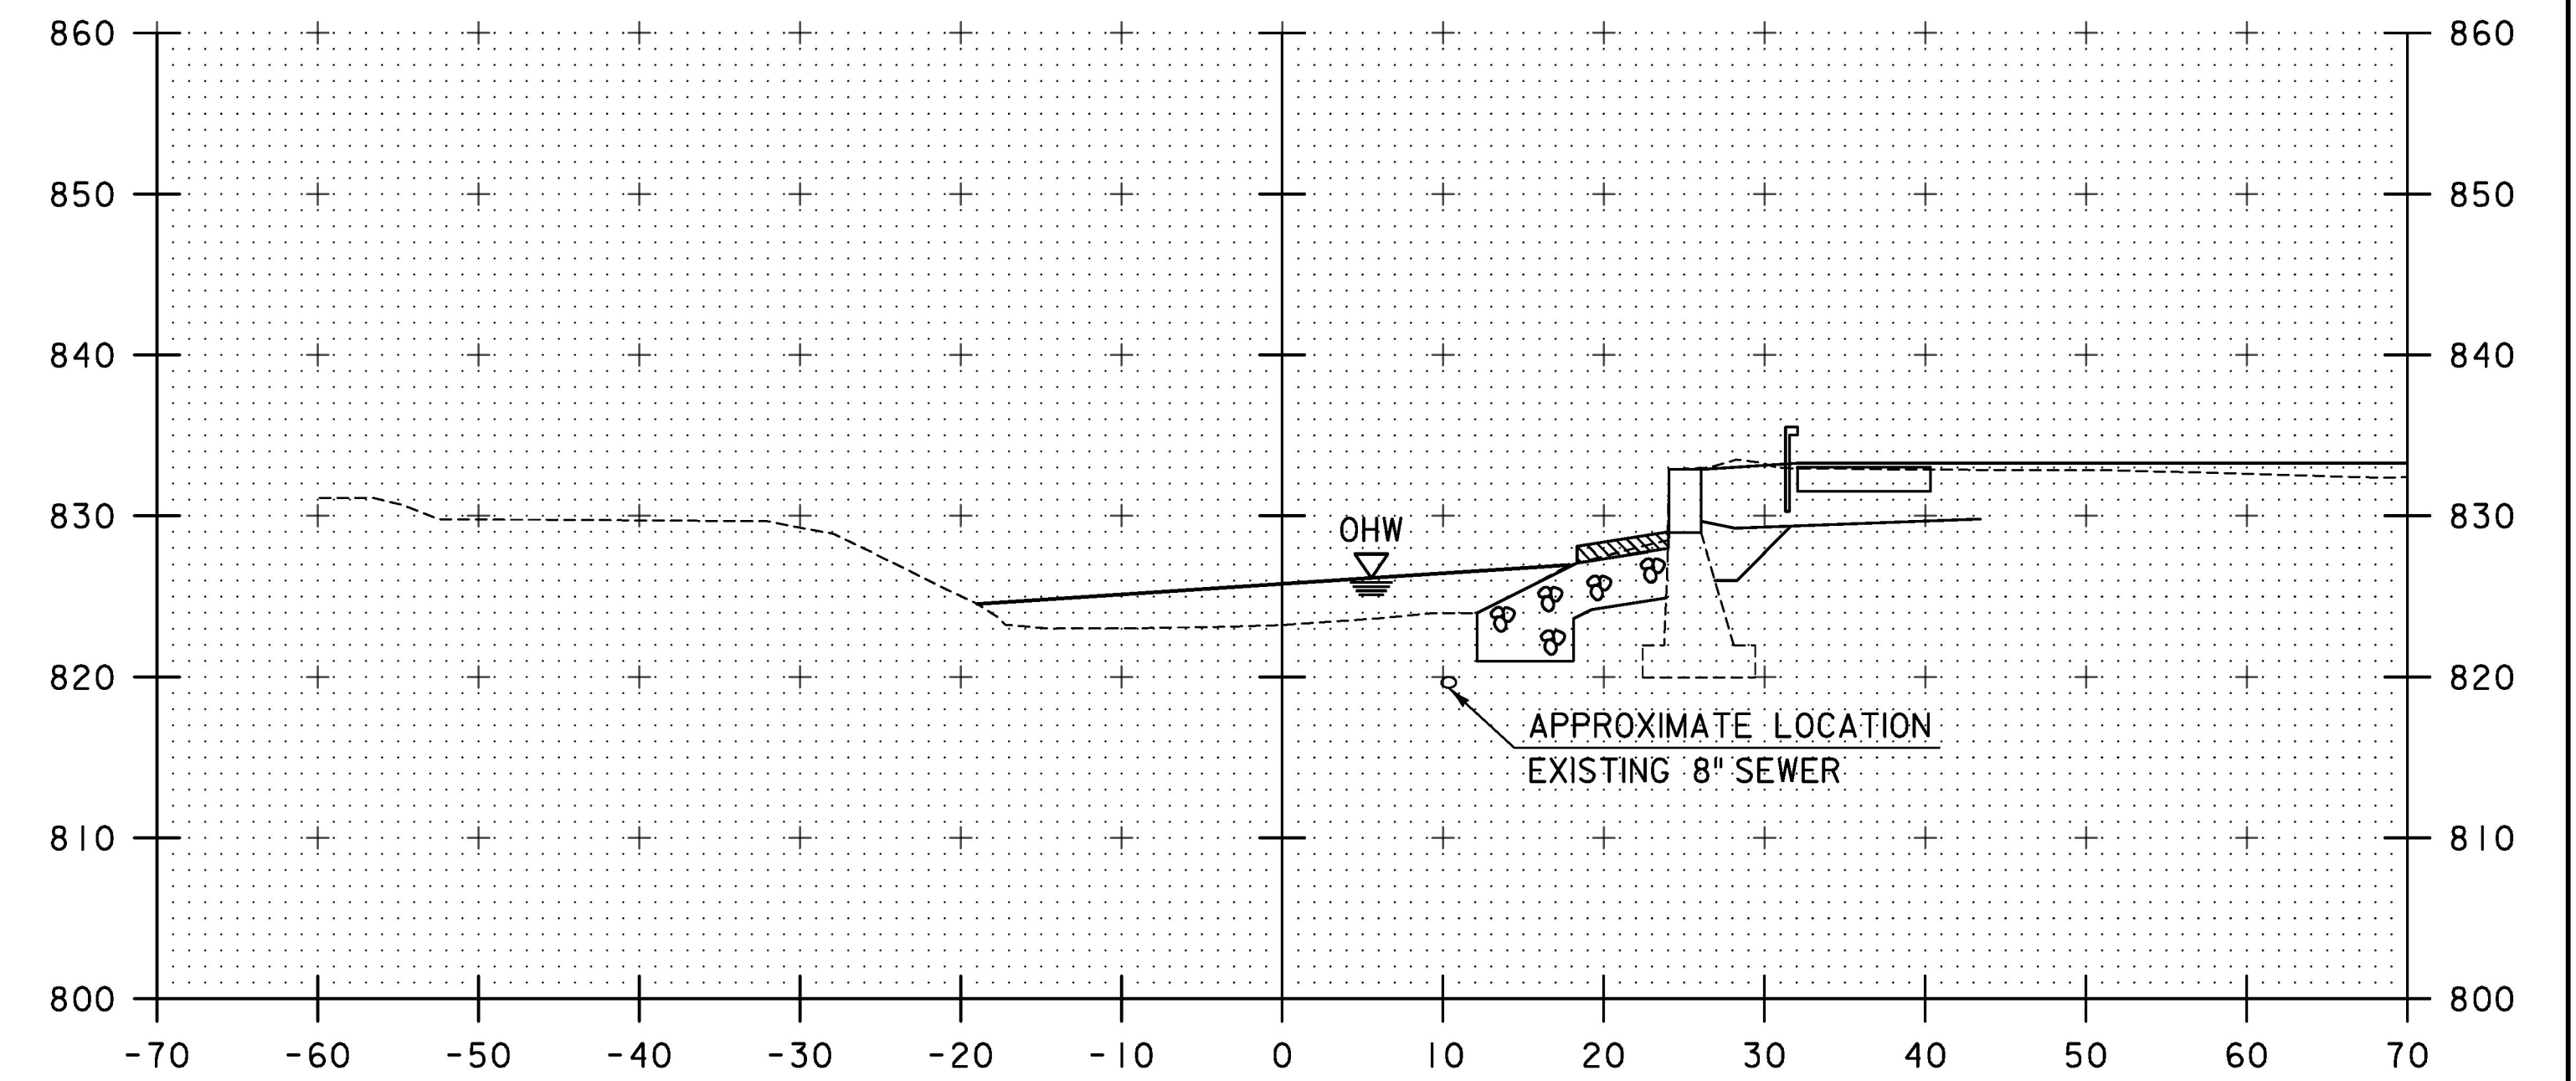

50+40

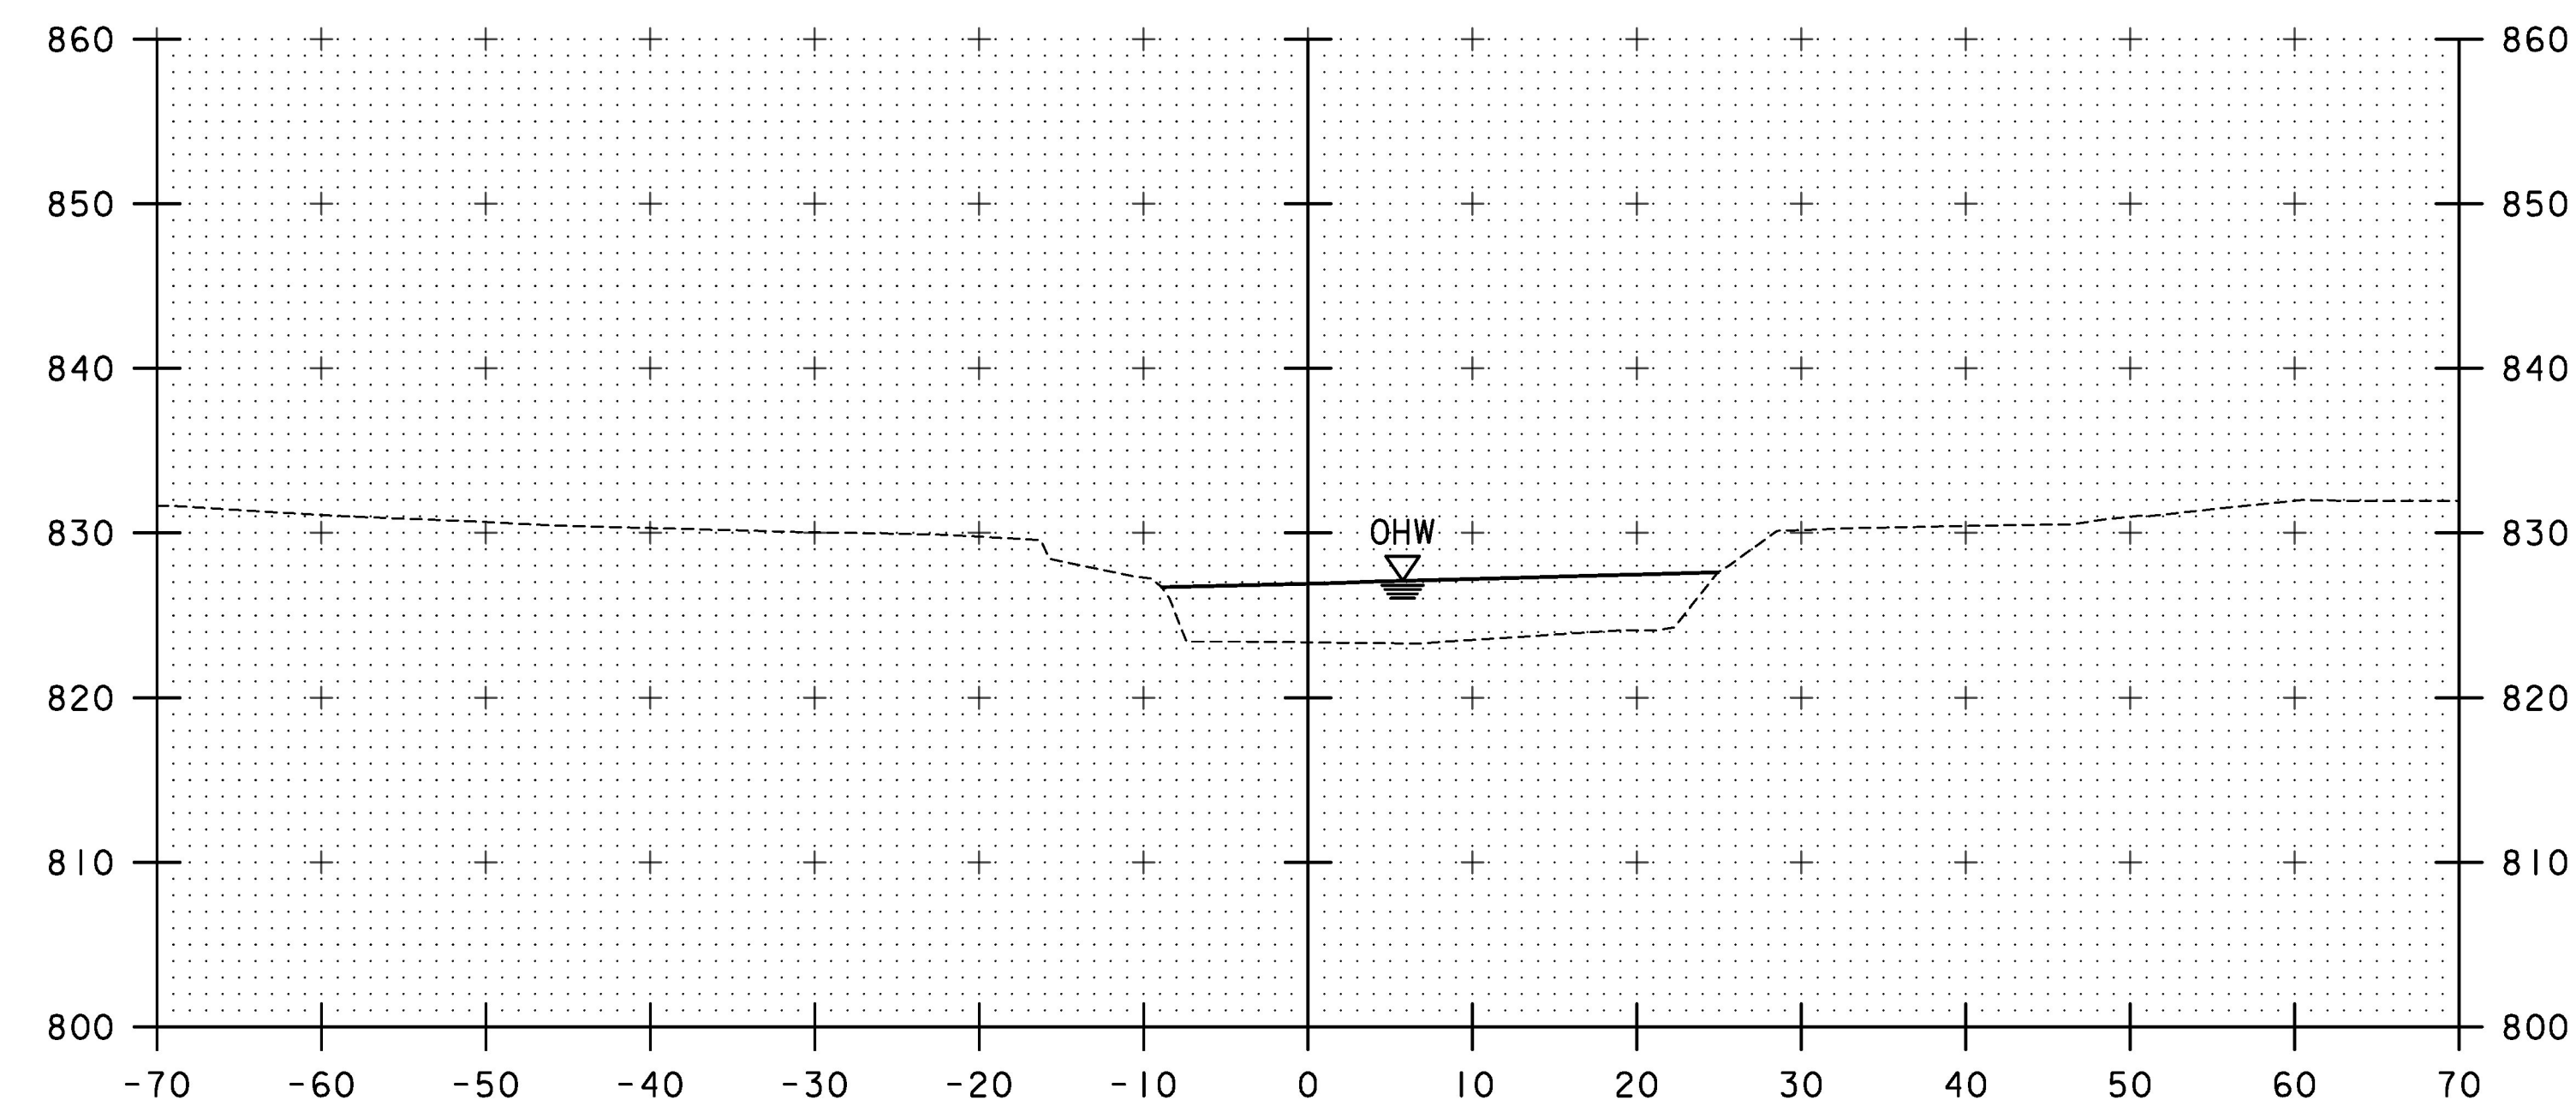

50+00

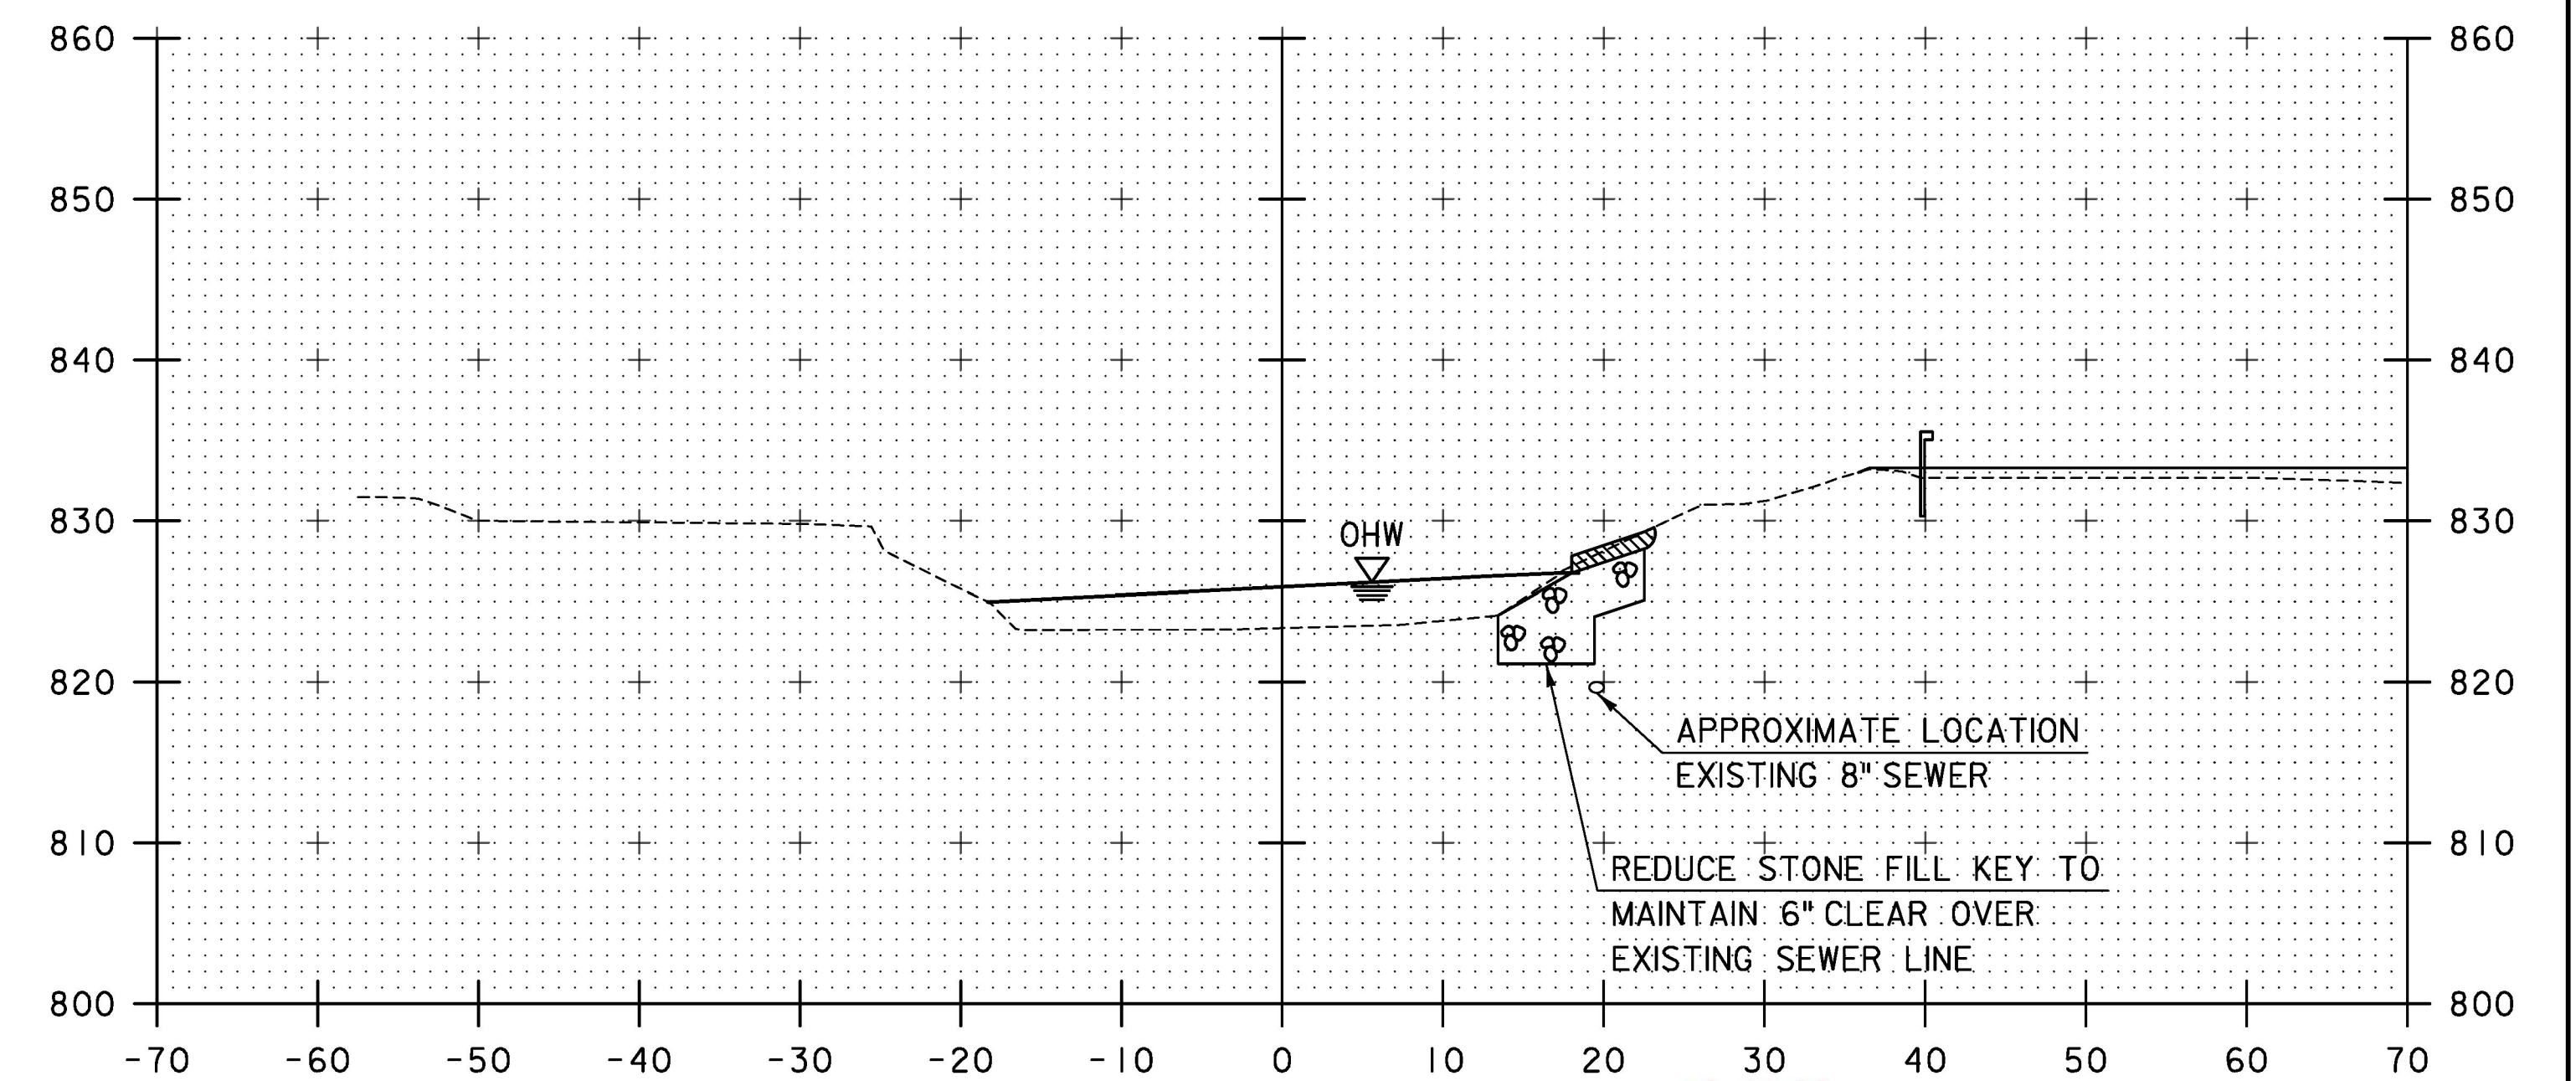

50+30

50+35.00
50+28.37, RT
BEGIN UNCLASSIFIED CHANNEL EXCAVATION
BEGIN GEOTEXTILE UNDER STONE FILL, TYPE III
BEGIN STONE FILL, TYPE III
BEGIN GRUBBING MATERIAL

STA. 50+00 TO STA. 50+40

TYLIN INTERNATIONAL

PROJECT NAME:	CHELSEA
PROJECT NUMBER:	BHF 0169(10)
FILE NAME:	z12ci52xschnl.dgn
PROJECT LEADER:	J. OLUND
DESIGNED BY:	T. POULIN
CHANNEL SECTIONS I	
PLOT DATE:	8/31/2016
DRAWN BY:	T. POULIN
CHECKED BY:	J. OLUND
SHEET	125 OF 137