
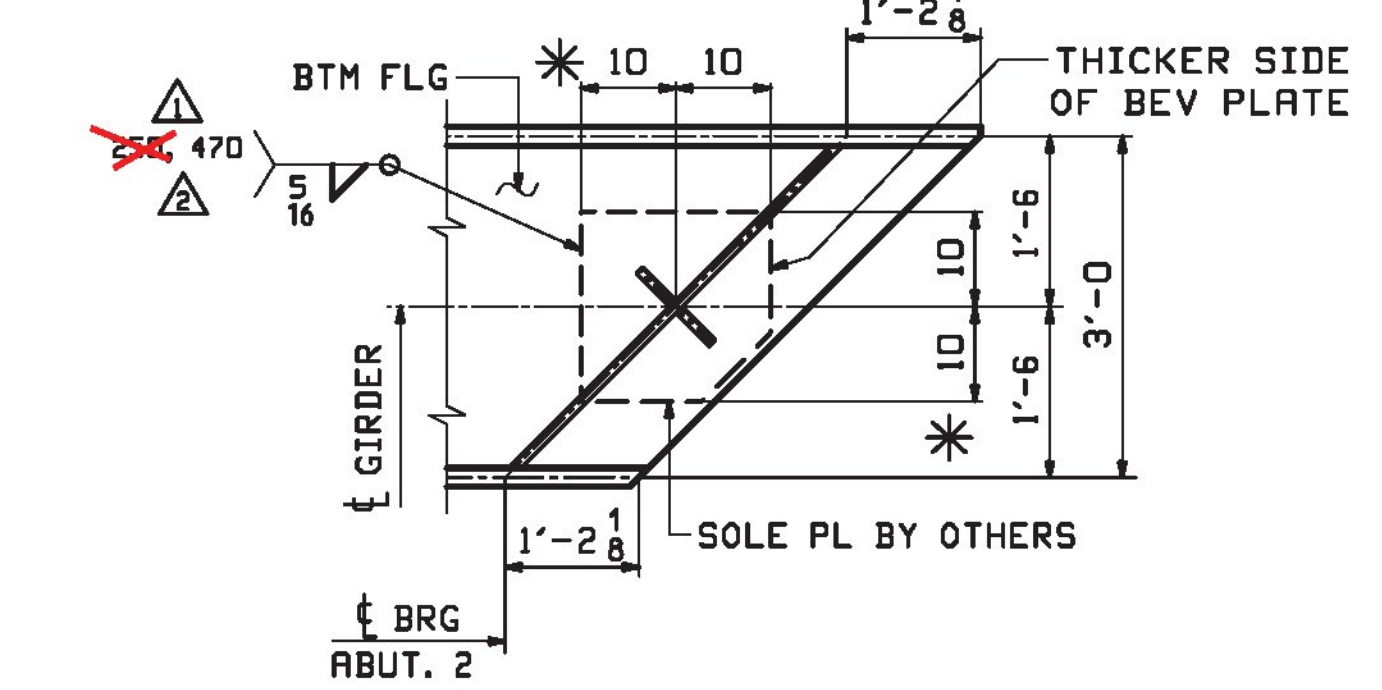
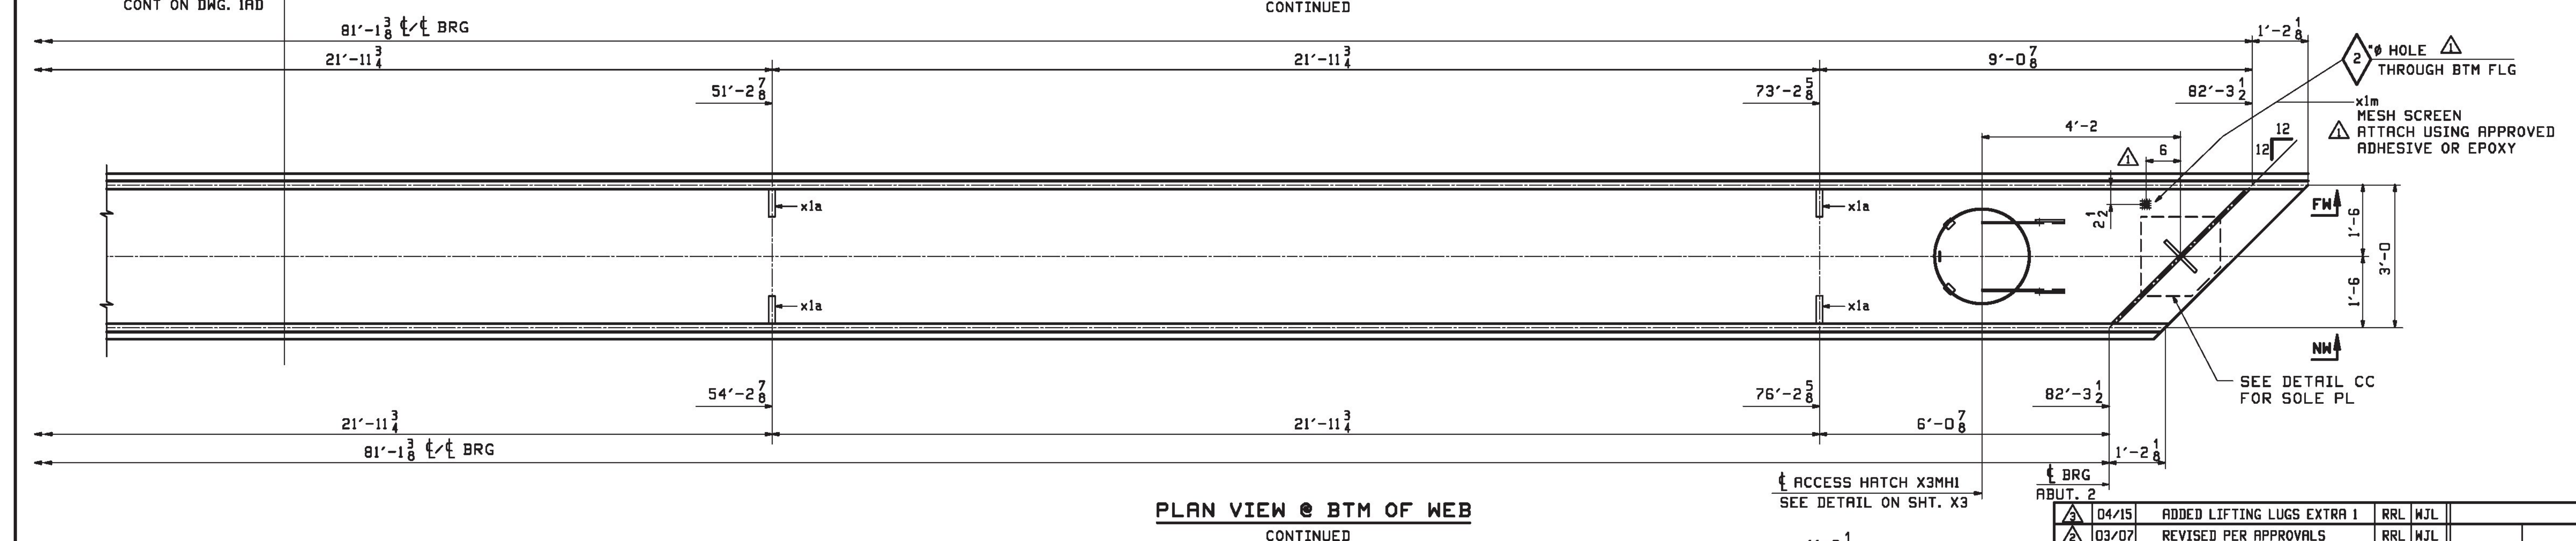


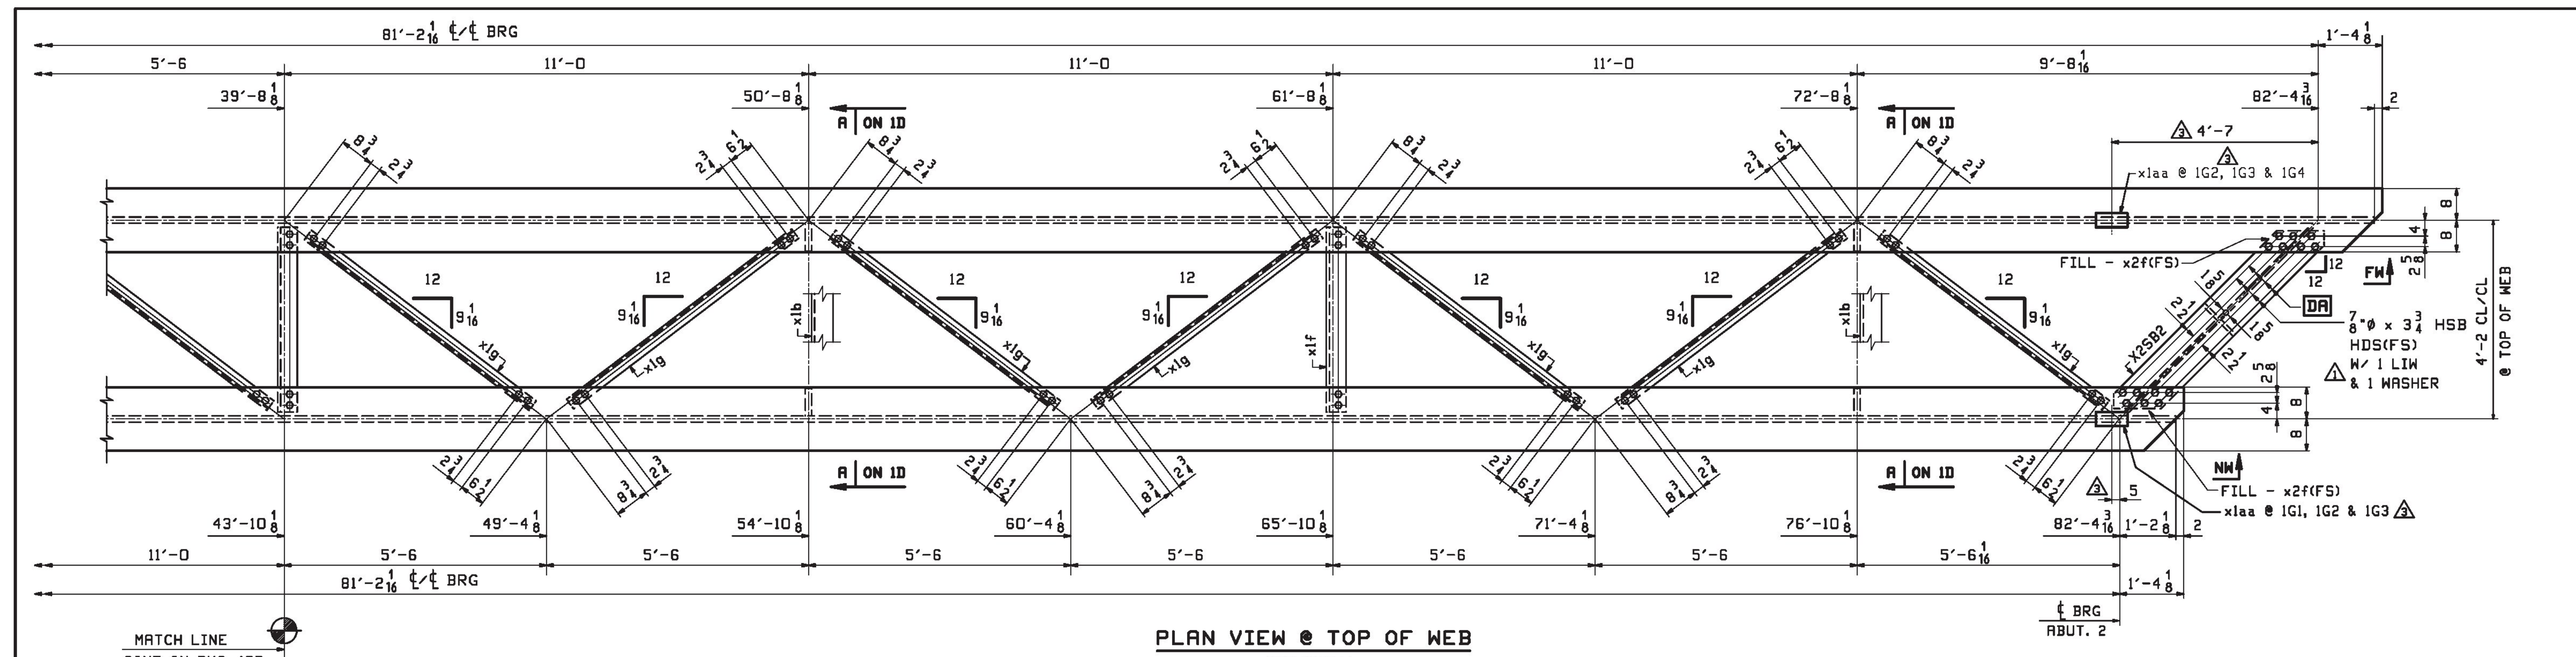

REV.	DATE	REMARKS	DWN	CHK	APVL	SHOP
0	04/15	ADDED LIFTING LUGS EXTRA 1	RRL	WJL		
1	03/07	REVISED PER APPROVALS	RRL	WJL		
2	02/15	REVISED PER APPROVALS	RRL	WJL		
DESCRIPTION: BOX GIRDER PLAN 1G1, 1G2, 1G3 & 1G4						
 CASCO BAY STEEL STRUCTURES, INC. 1 WALLACE AVE. SOUTH PORTLAND, ME 04106 PHONE (207) 780-6722 FAX (207) 780-6726						
STRUCTURE:			DRAWN:		DATE:	
VT ROUTE 110 OVER 1ST BRANCH WHITE RIVER			RRL		12/21	
BRIDGE NO. 9			CHKD:		DATE:	
			WJL		01/06/17	
LOCATION:			JOB NO.		DWG NO.	
TOWN OF CHELSEA, ORANGE COUNTY, VT.					696	
PROJ NO.			REV.		1BD	
BHF 0169(9)						
CUSTOMER:			CPM CONSTRUCTORS			

T.Y. LIN INTERNATIONAL
THE STAMPED DOCUMENTS ARE HEREBY:

APPROVED
X APPROVED AS NOTED
REVISE AND RESUBMIT

SEE TRANSMITTAL FOR ADDITIONAL INFORMATION AS APPLICABLE.

THIS REVIEW IS FOR GENERAL CONFORMANCE WITH DESIGN CONCEPT ONLY. ANY DEVIATION FROM THE PLANS OR SPECIFICATIONS NOT CLEARLY NOTED BY THE CONTRACTOR HAS NOT BEEN REVIEWED. REVIEW BY THE ENGINEER SHALL NOT RELIEVE THE CONTRACTOR OF THE CONTRACTUAL RESPONSIBILITY FOR ANY ERRORS OR DEVIATION FROM THE CONTRACT REQUIREMENTS.

JOSH OLUND
REVIEWER

April 19, 2017
DATE

Vermont Agency of Transportation
RECEIVED

CK'D BY TYLin, R. Foster OK'D BY TYLin, R. Foster

April 17, 2017

RESUBMIT No Approved AsNoted
BY Kristin Higgins DATE 4/20/2017

WORK THIS SHEET WITH SHEET 1AD, 1CD & 1D

* FLAT & TRUE AREA ADD 1" FROM EDGE OF BRG