



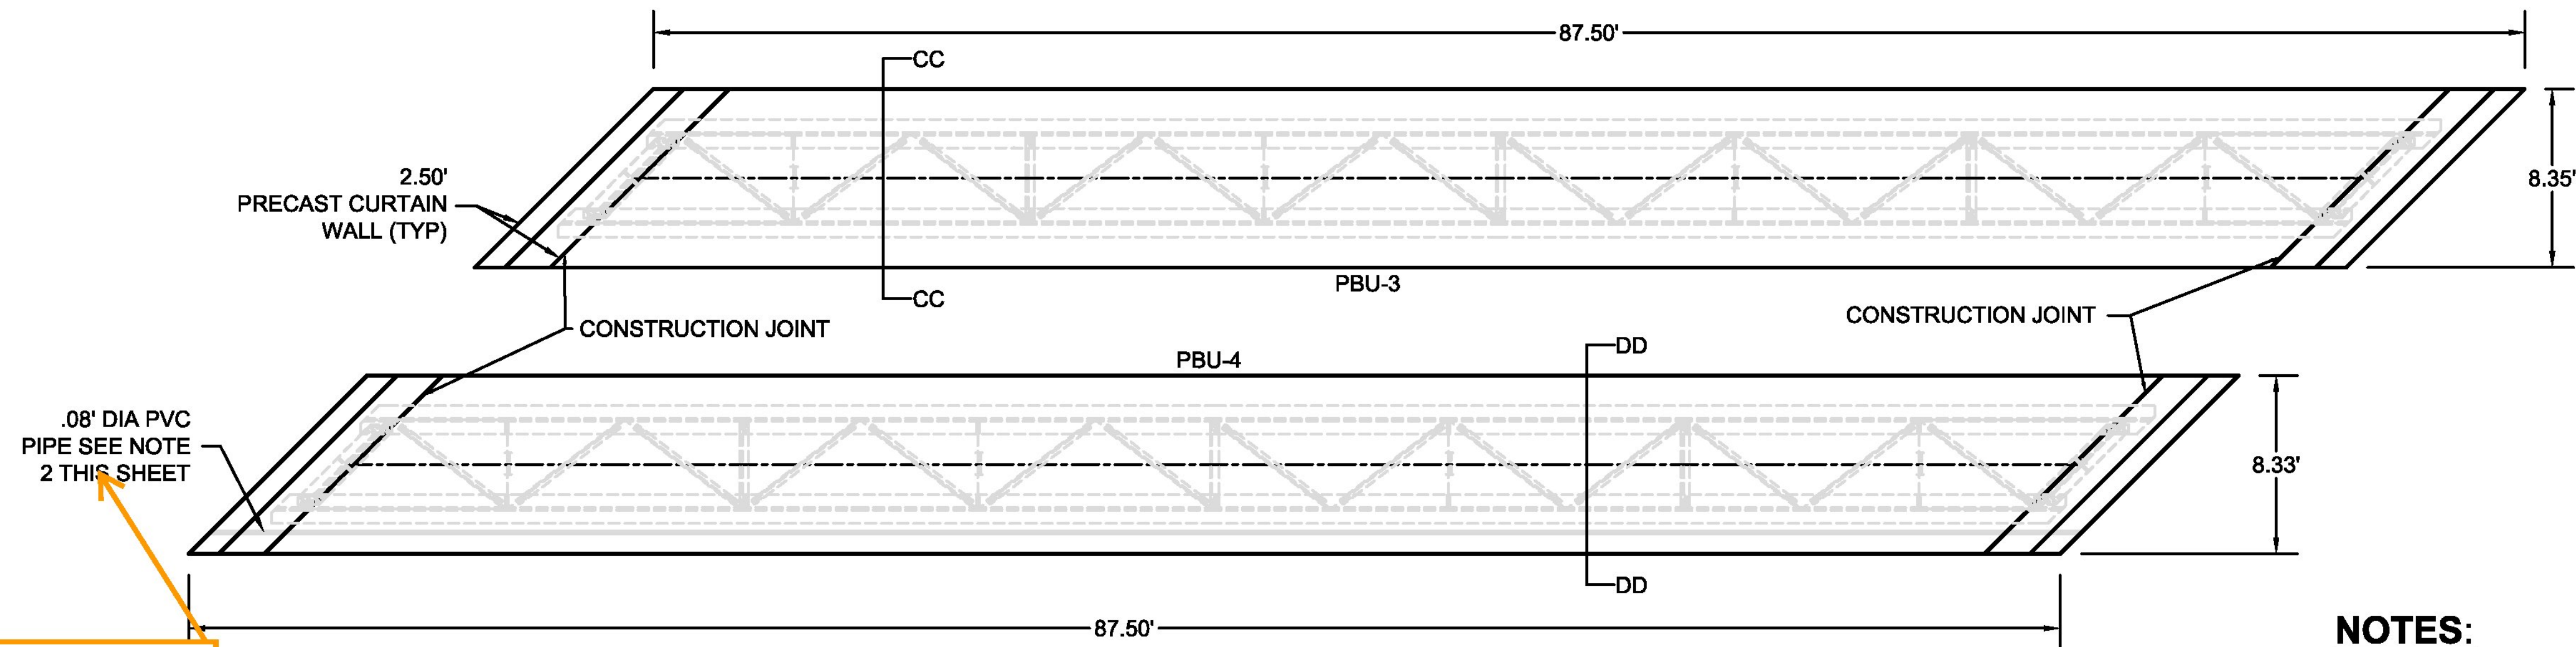


BRIDGE NO. 9
PBU 3&4 PLAN
 SCALE: 1"=10'

- NOTES:**
1. SEE STRUCTURAL STEEL SHOP DRAWINGS FOR GIRDER INFORMATION.
 2. ONE INCH SCHEDULE 80 PVC CONFORMING TO ASTM D 1784 SPECIFICATIONS.

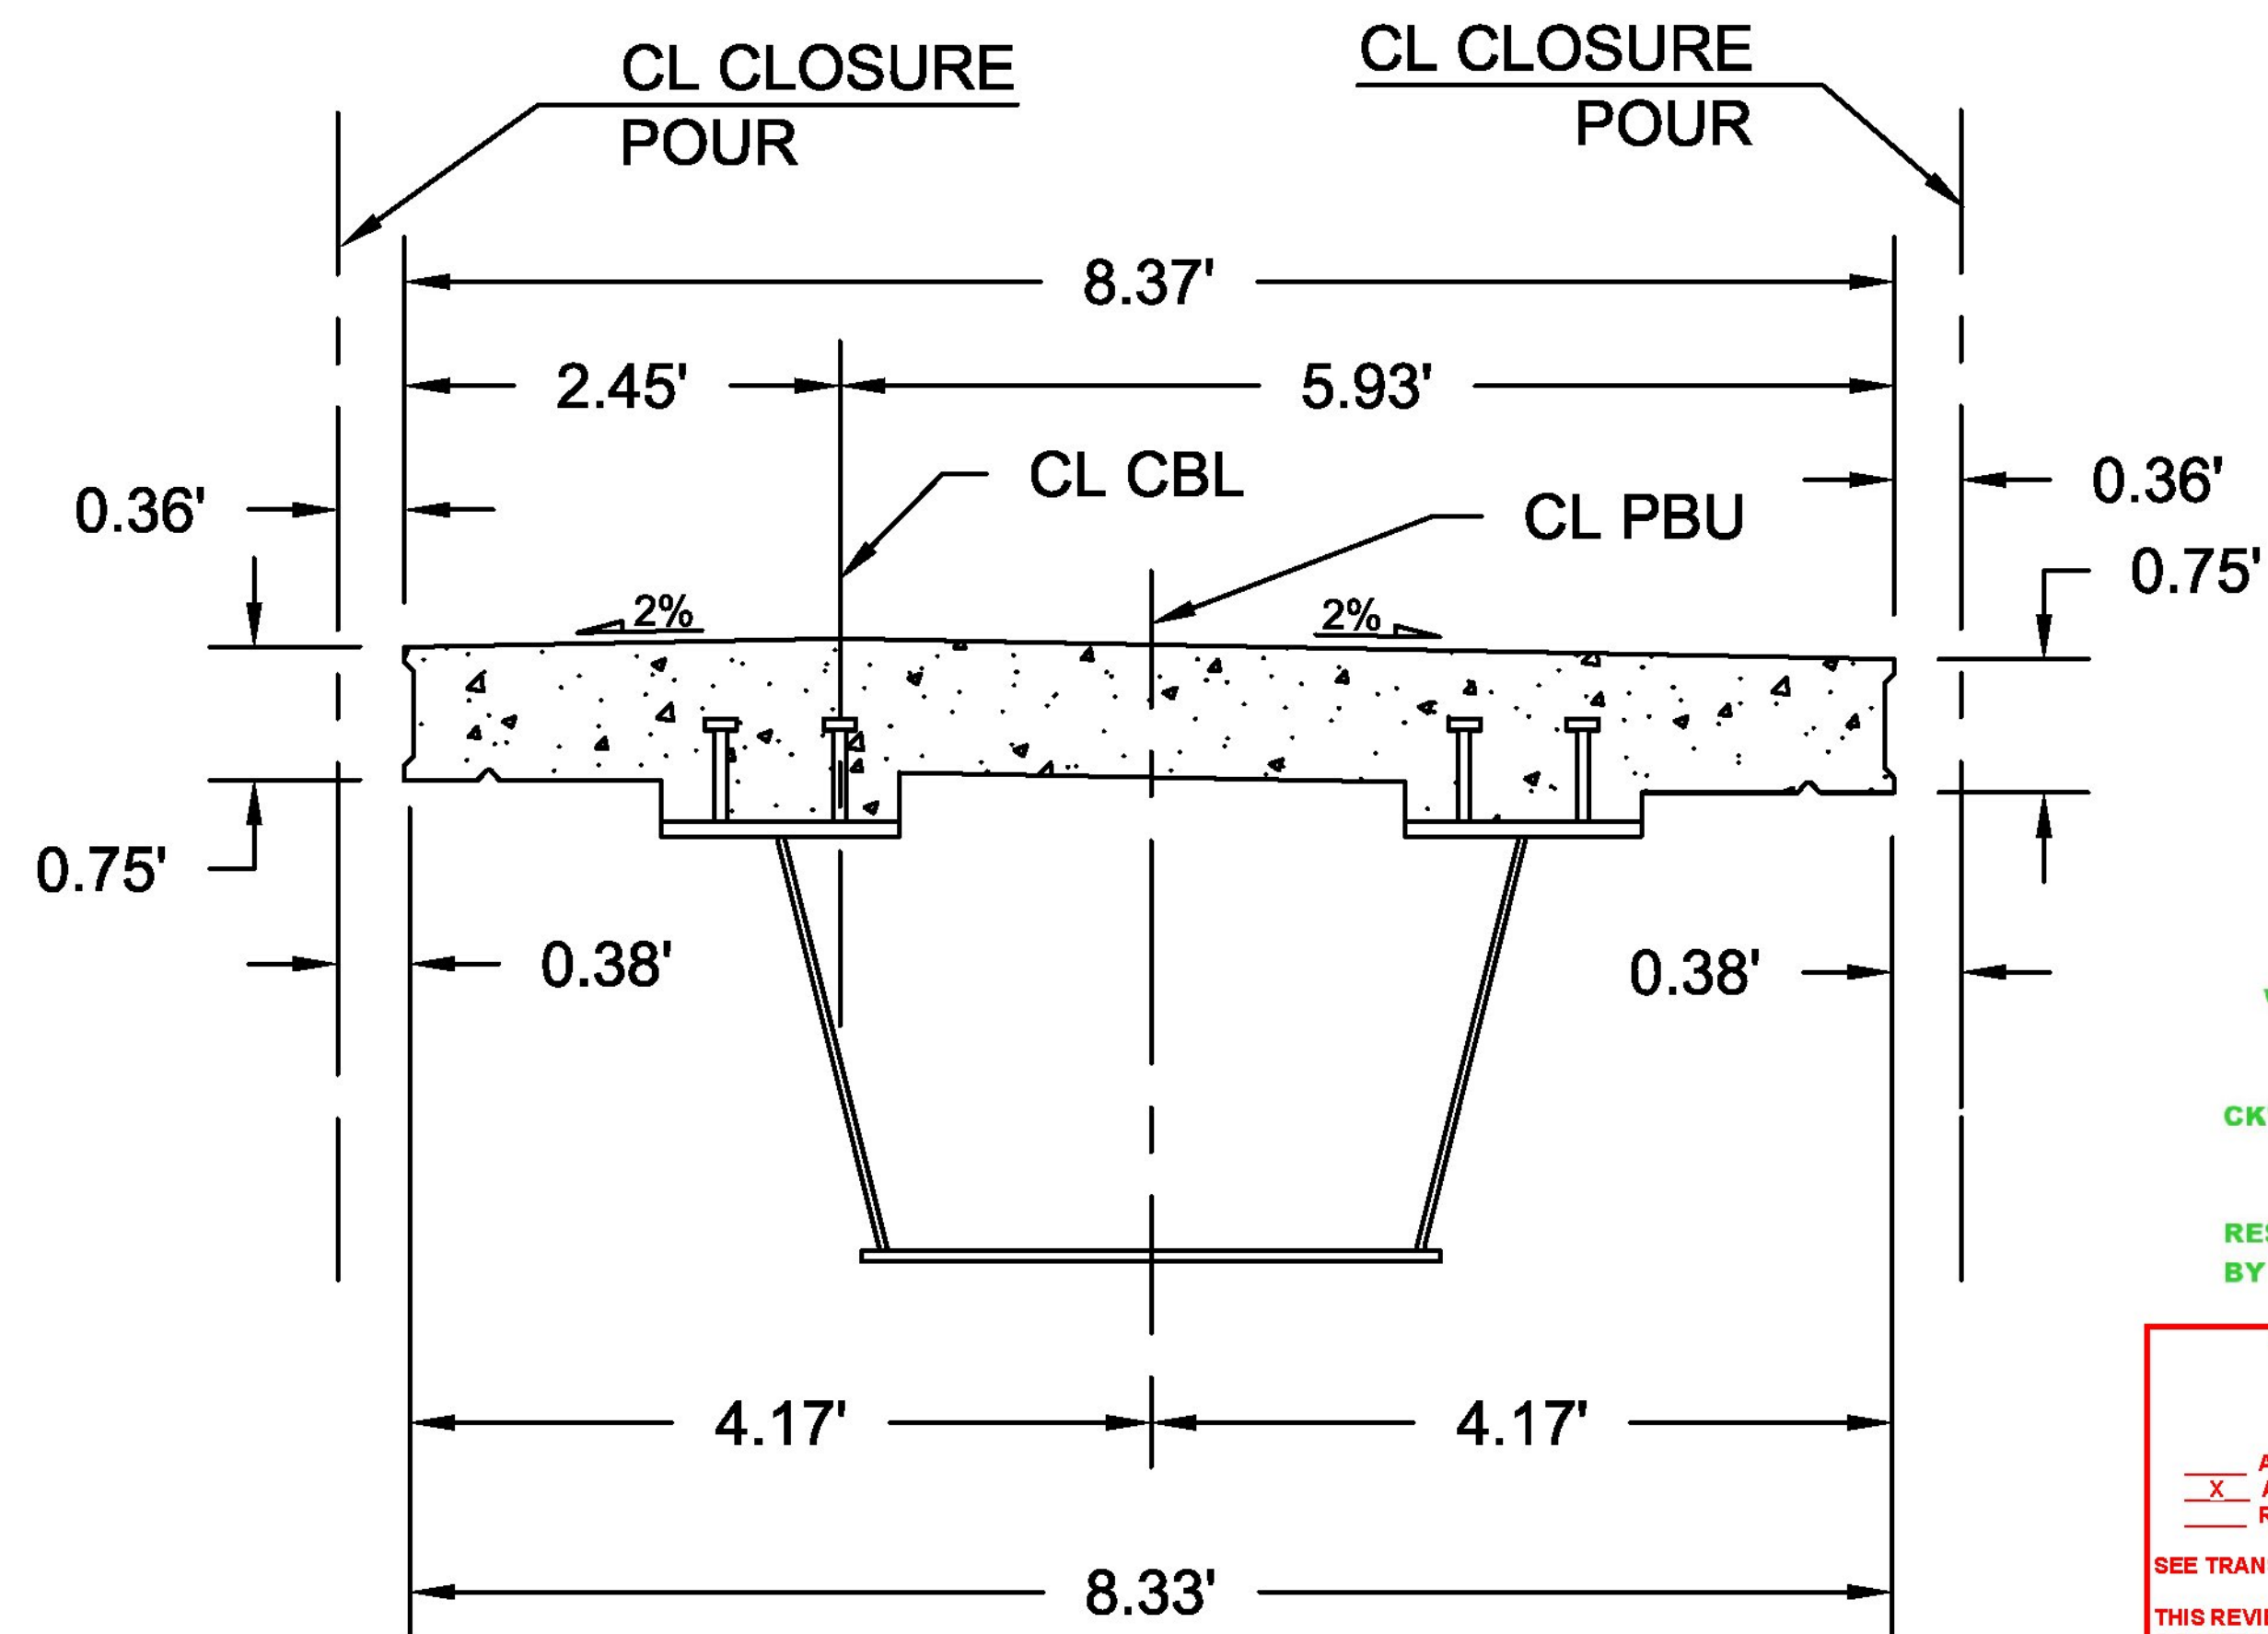

PBU 3 SECTION "CC"
 N.T.S.

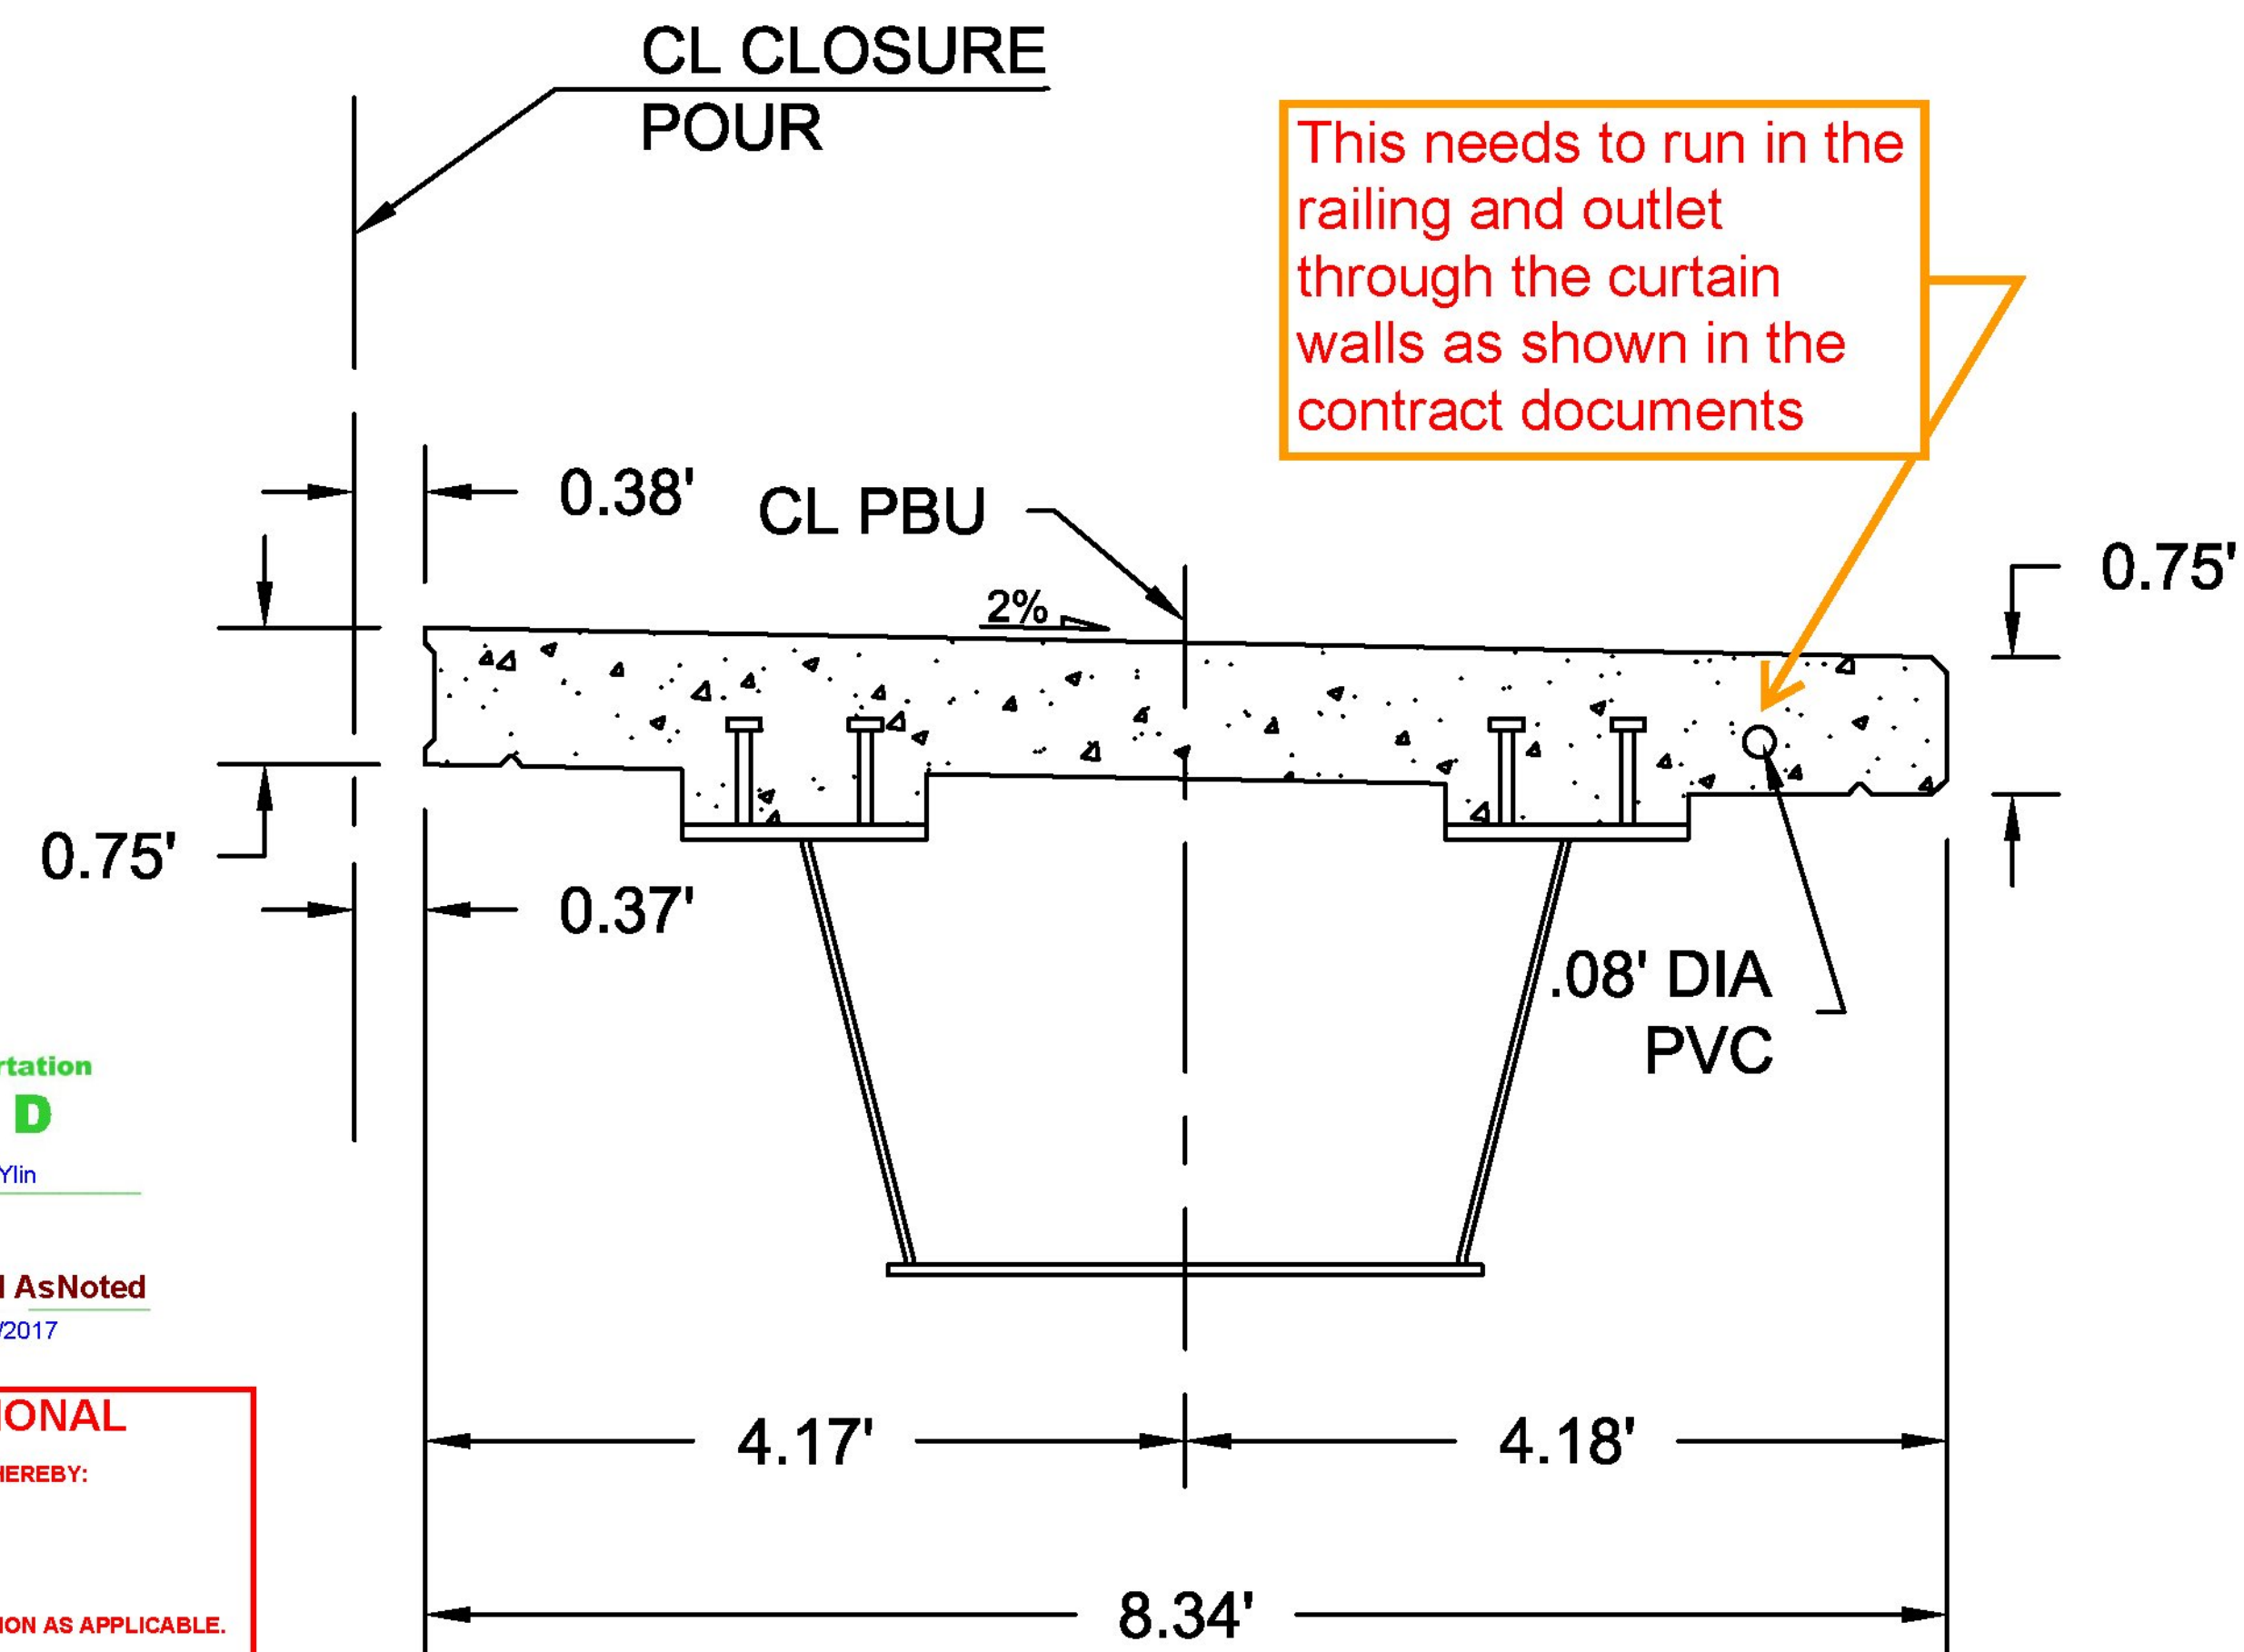

PBU 4 SECTION "DD"
 N.T.S.

Vermont Agency of Transportation
RECEIVED

CK'D BY TYlin OK'D BY TYlin

April 5, 2017

RESUBMIT No Approved AsNoted
 BY Kristin Higgins DATE 4/7/2017

T.Y. LIN INTERNATIONAL

THE STAMPED DOCUMENTS ARE HEREBY:

APPROVED
 X APPROVED AS NOTED
 REVISE AND RESUBMIT

SEE TRANSMITTAL FOR ADDITIONAL INFORMATION AS APPLICABLE.

THIS REVIEW IS FOR GENERAL CONFORMANCE WITH DESIGN CONCEPT ONLY. ANY DEVIATION FROM THE PLANS OR SPECIFICATIONS NOT CLEARLY NOTED BY THE CONTRACTOR HAS NOT BEEN REVIEWED. REVIEW BY THE ENGINEER SHALL NOT RELIEVE THE CONTRACTOR OF THE CONTRACTUAL RESPONSIBILITY FOR ANY ERRORS OR DEVIATION FROM THE CONTRACT REQUIREMENTS.

JOSH OLUND April 5, 2017
 REVIEWER DATE

CPM CONSTRUCTORS
 80 BARNETT STREET
 P.O. BOX 9
 FARMINGTON, CT 06031
 (860) 646-0000 FAX (860) 646-0000



PROJECT INFORMATION				
JOB NAME:	WAT COLUMBA	DRAWING:		
JOB NUMBER:	00-0			
APPROVED BY:	JAYE BELL	P.E. NUMBER:		
DRAWN BY:	KEH DECKED			
DATE:	SEP-1 04/24/2011	DATE:		
SCALE:	1" = 10'			

PBU 3 & 4
DETAILS
BHF 0169(09)
CHELSEA, VERMONT

SHEET NUMBER

5

OF 11