




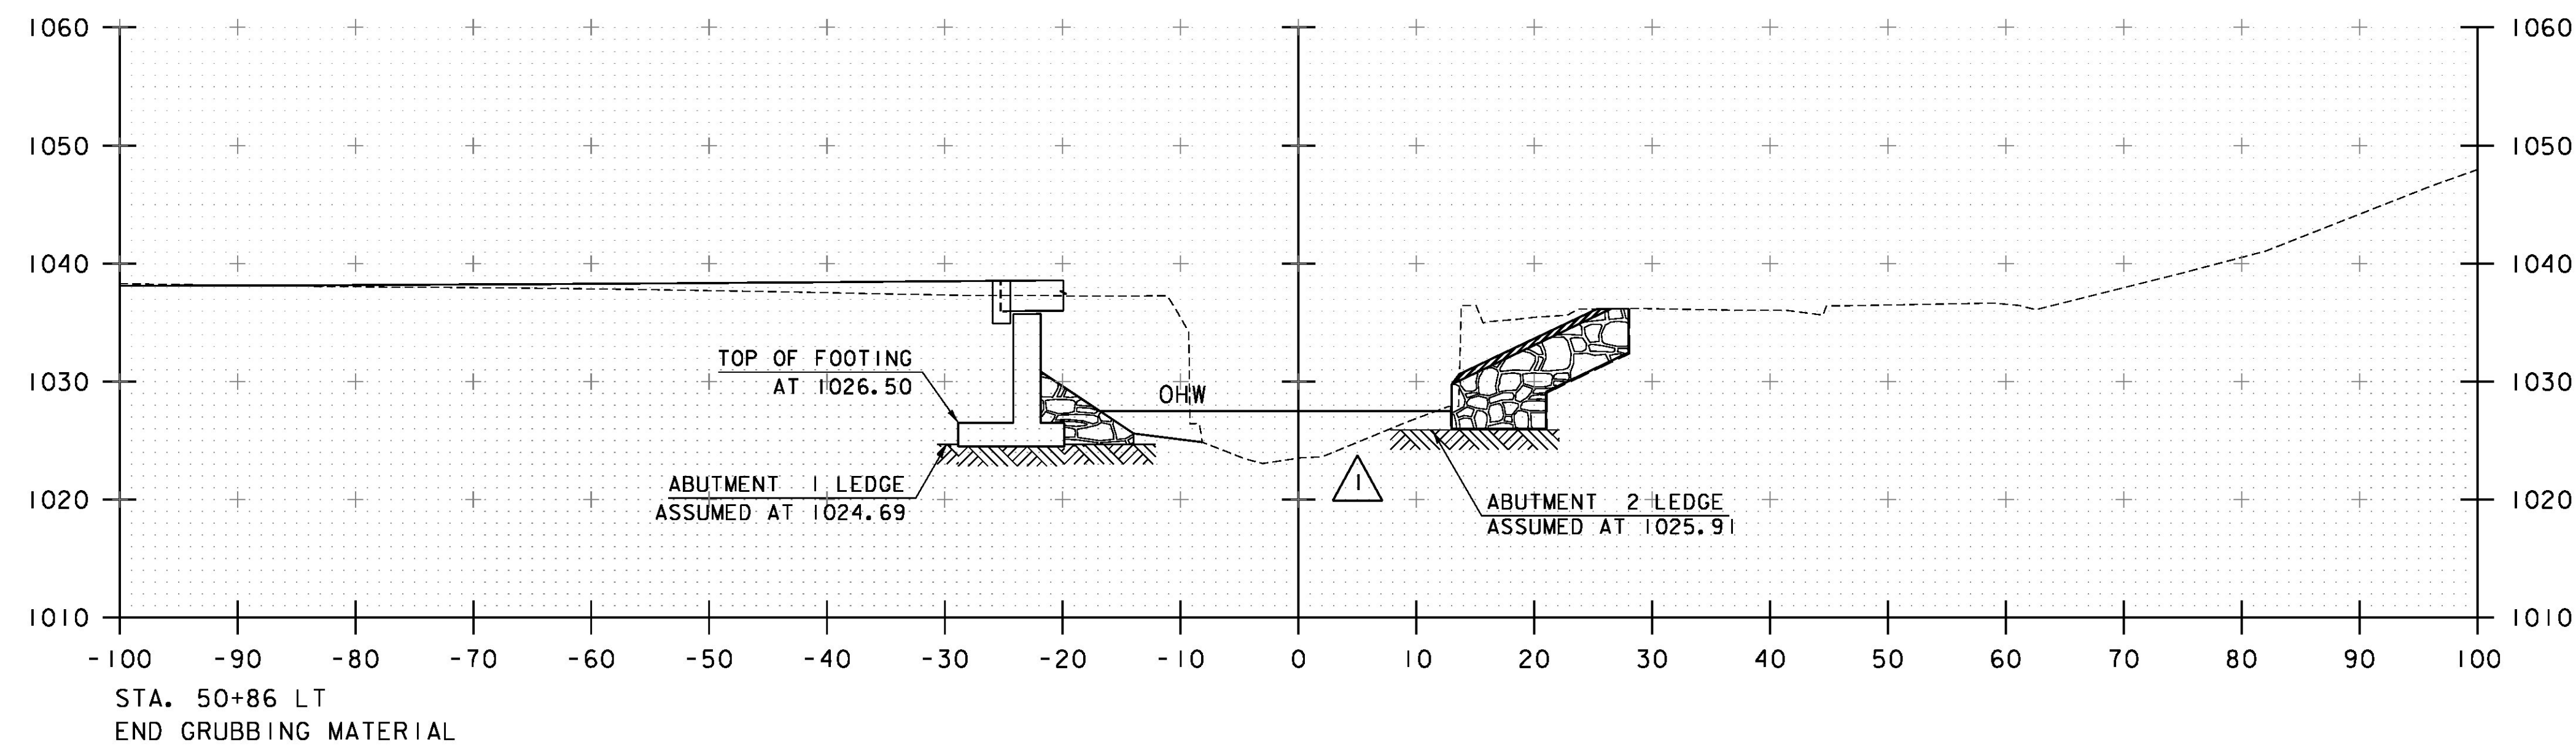

50+94

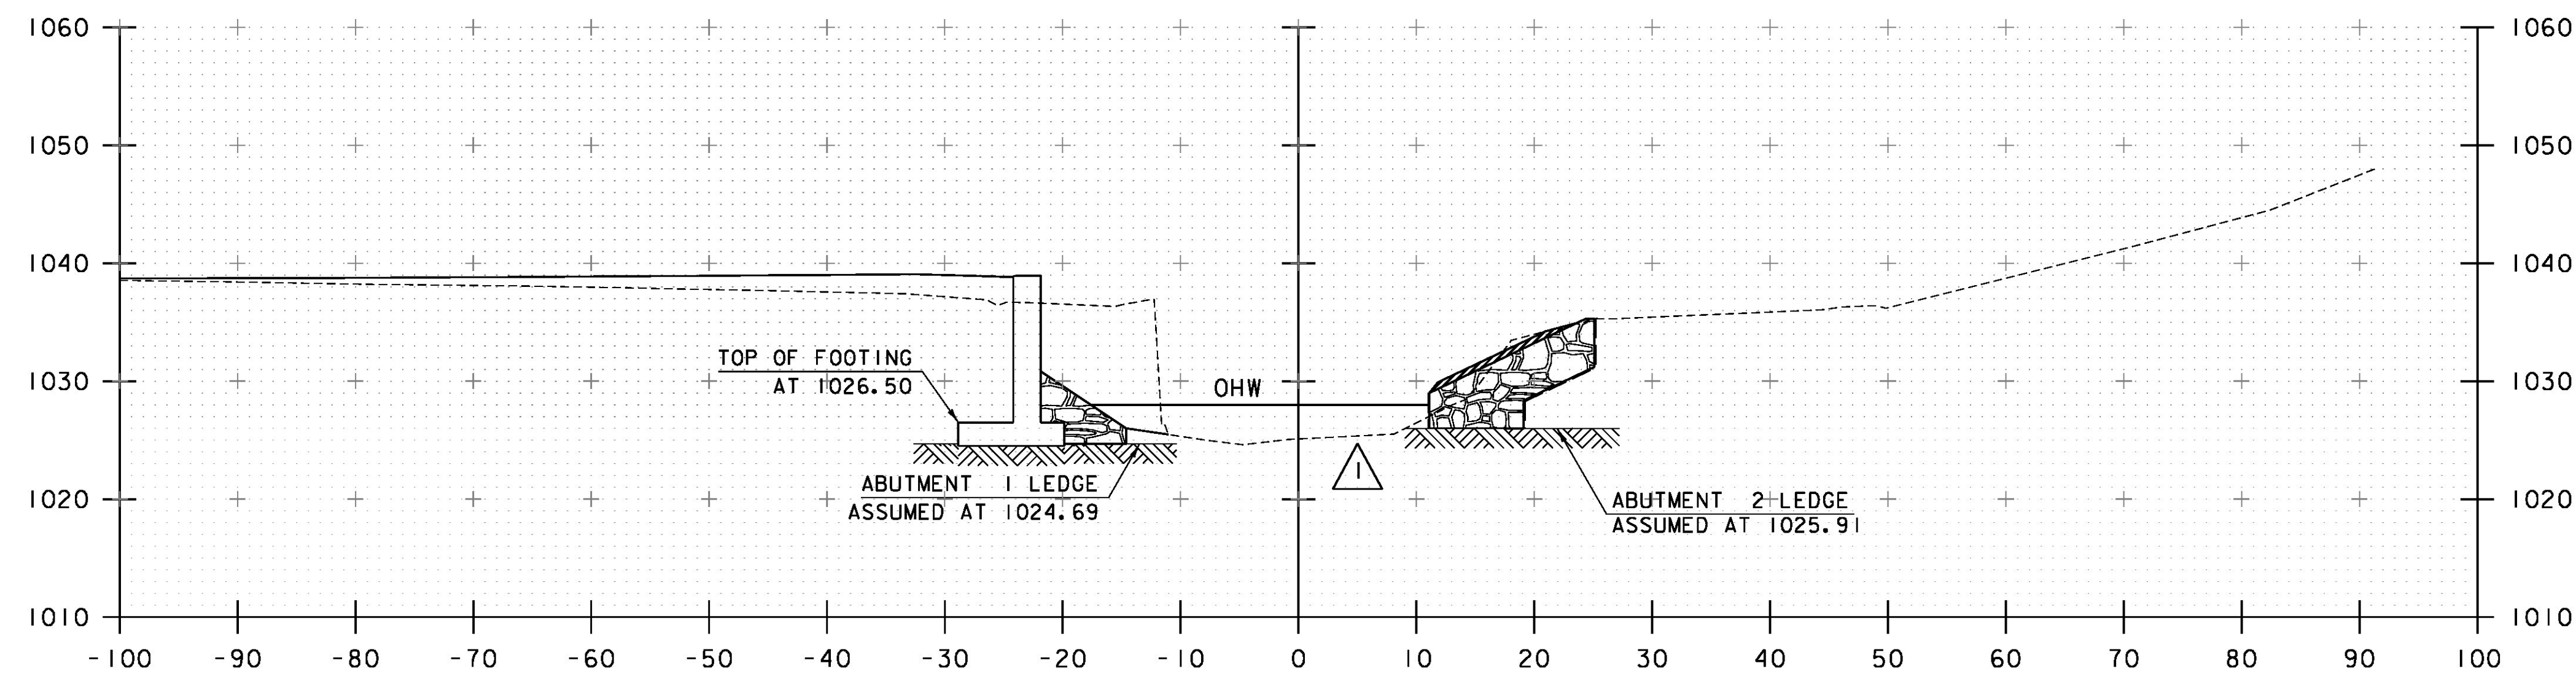

50+85

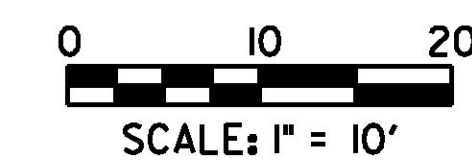

| STA. 50+85 TO STA. 50+94       |          |                         |
|--------------------------------|----------|-------------------------|
| REVISIONS                      |          |                         |
|                                | 09.27.16 | REMOVE SAND BAG SYMBOLS |
| PROJECT NAME: JAY              |          |                         |
| PROJECT NUMBER: BHF 0278(3)    |          |                         |
| FILE NAME: z12ci54xsl.dgn      |          | PLOT DATE: 9/26/2016    |
| PROJECT LEADER: M. CHENETTE    |          | DRAWN BY: L. BUXTON     |
| DESIGNED BY: J. HUNGERFORD     |          | CHECKED BY: M. CHENETTE |
| CHANNEL CROSS SECTIONS - CXS 3 |          | SHEET 50 OF 72          |