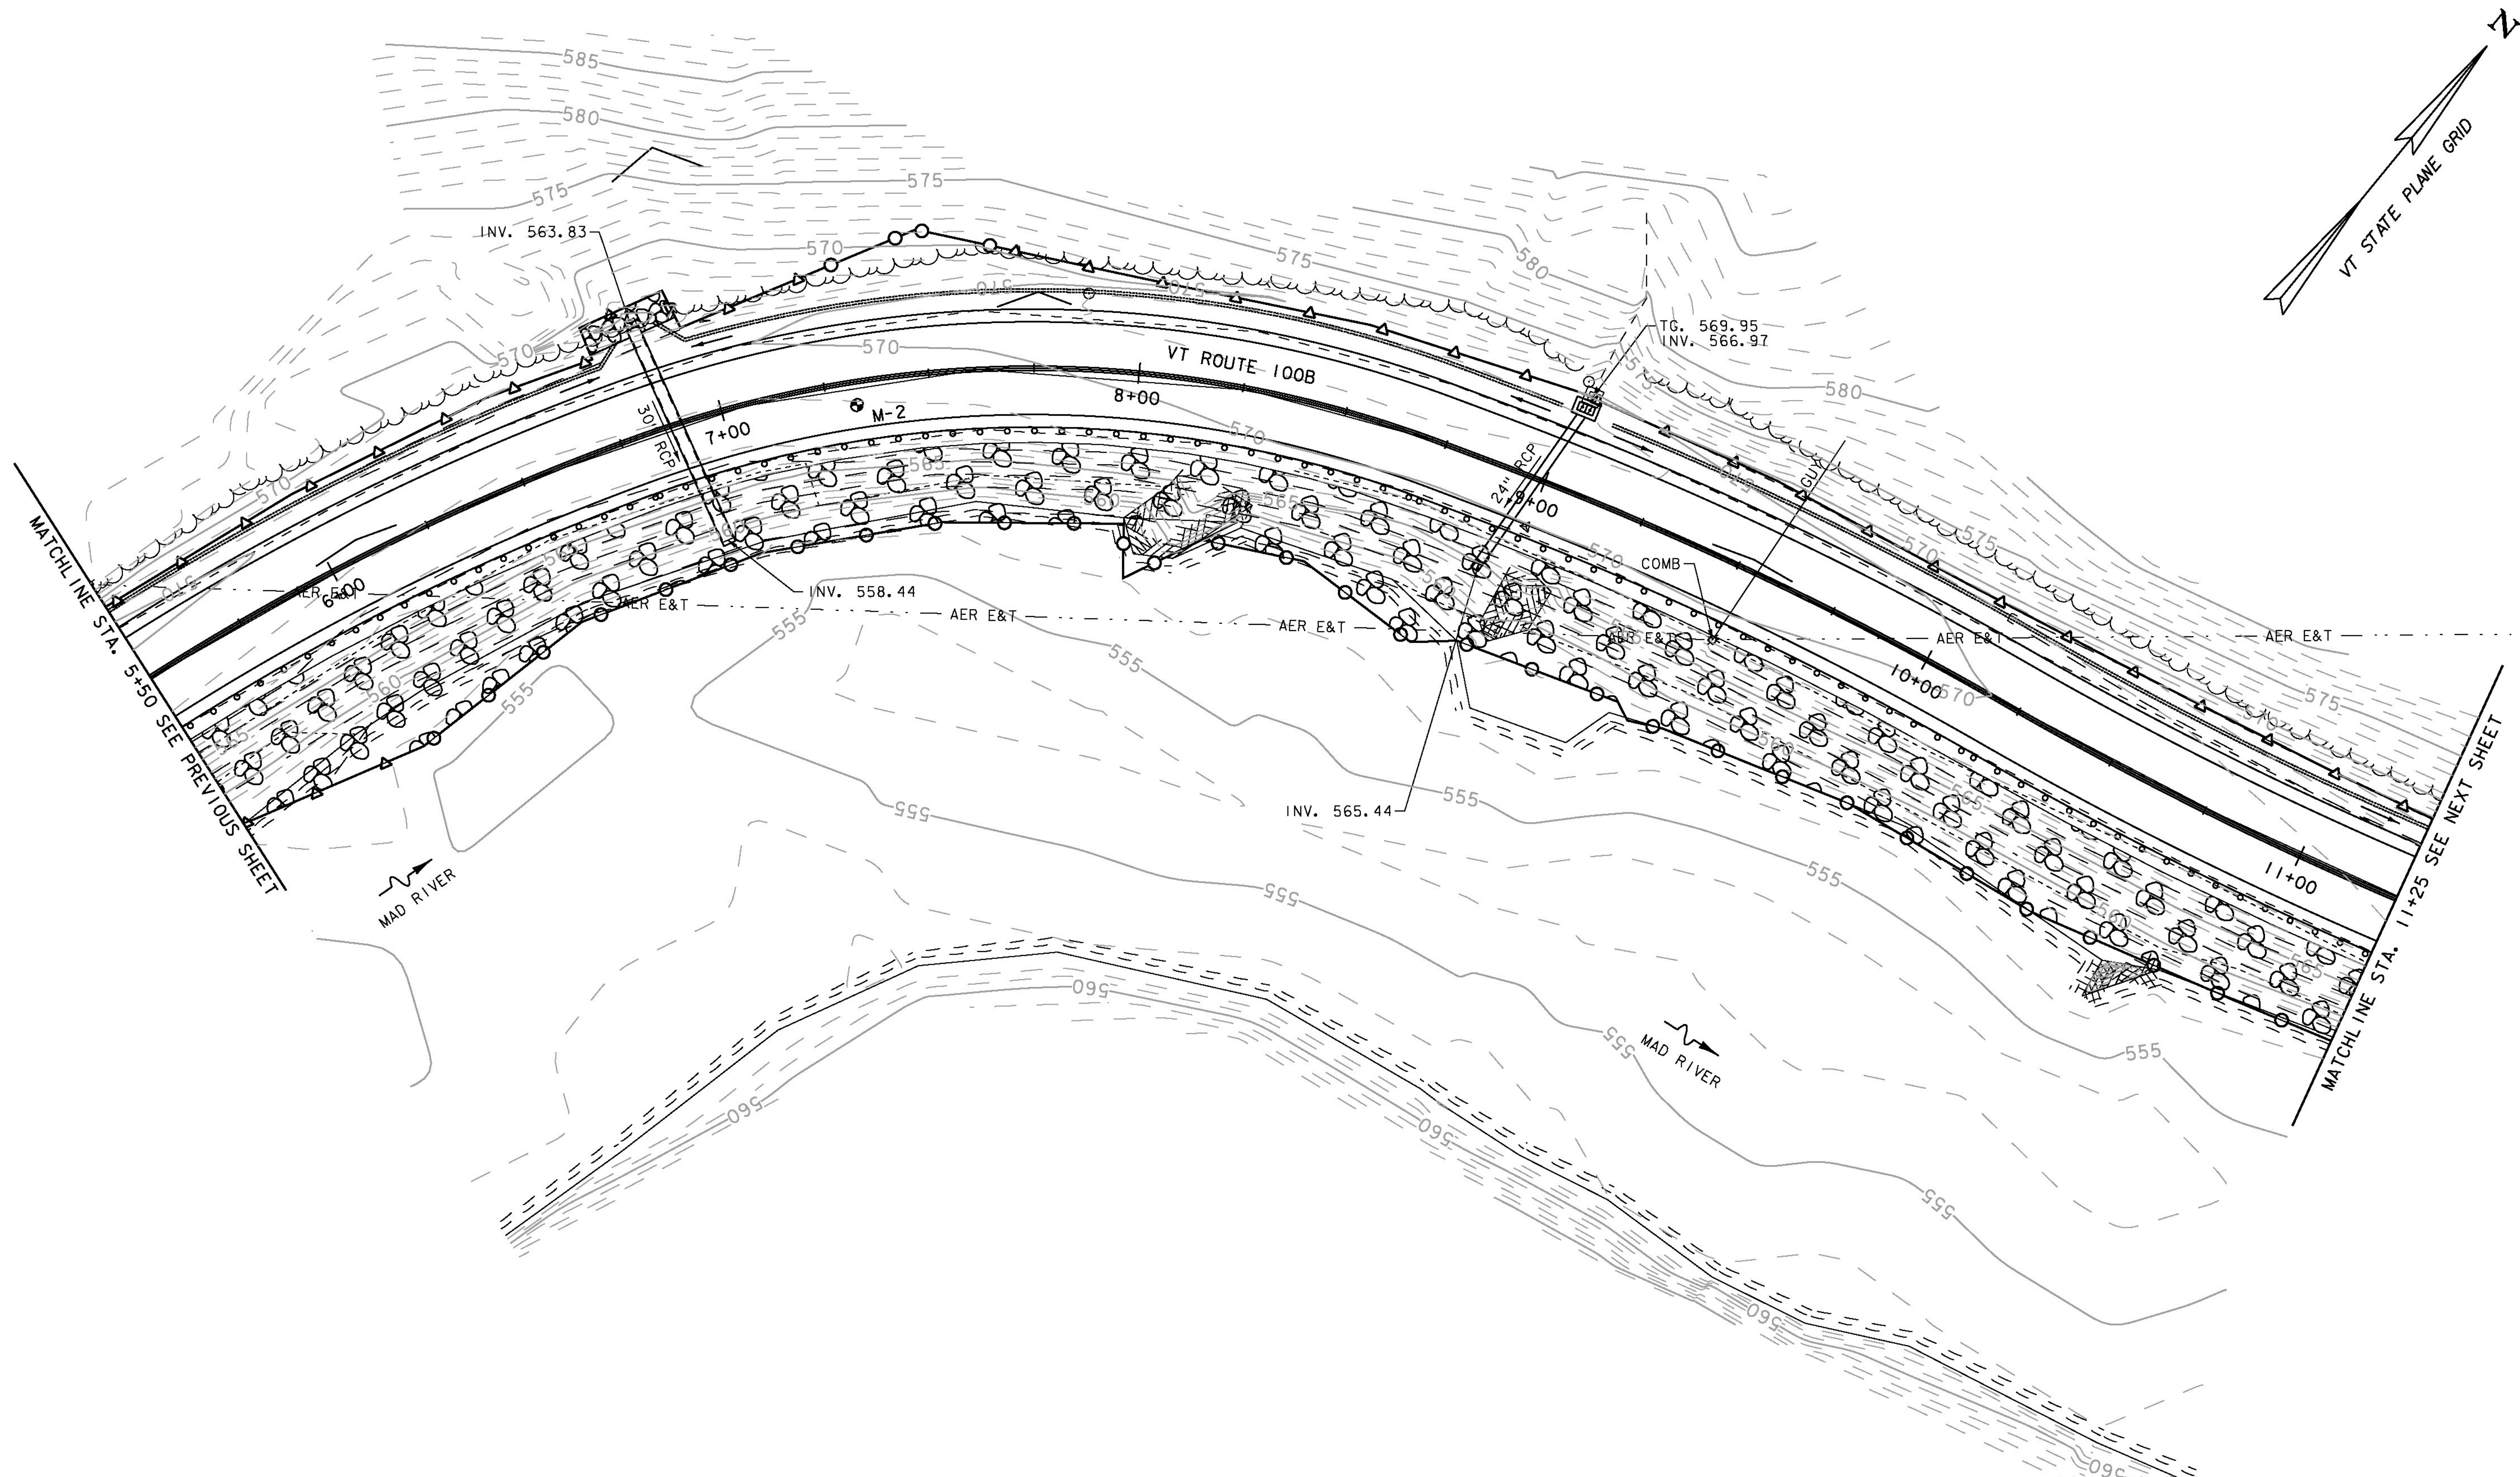


PROJECT NAME: MORETOWN	
PROJECT NUMBER: ER STP 0167 (15)	
FILE NAME: z12c524.EPSC.dgn	PLOT DATE: 2/17/2015
PROJECT LEADER: J. TUCKER	DRAWN BY: B. MACK
DESIGNED BY: B. BRESLEND	CHECKED BY: J. TUCKER
EPSC FINAL CONDITIONS - SHEET 2	SHEET 39 OF 57