
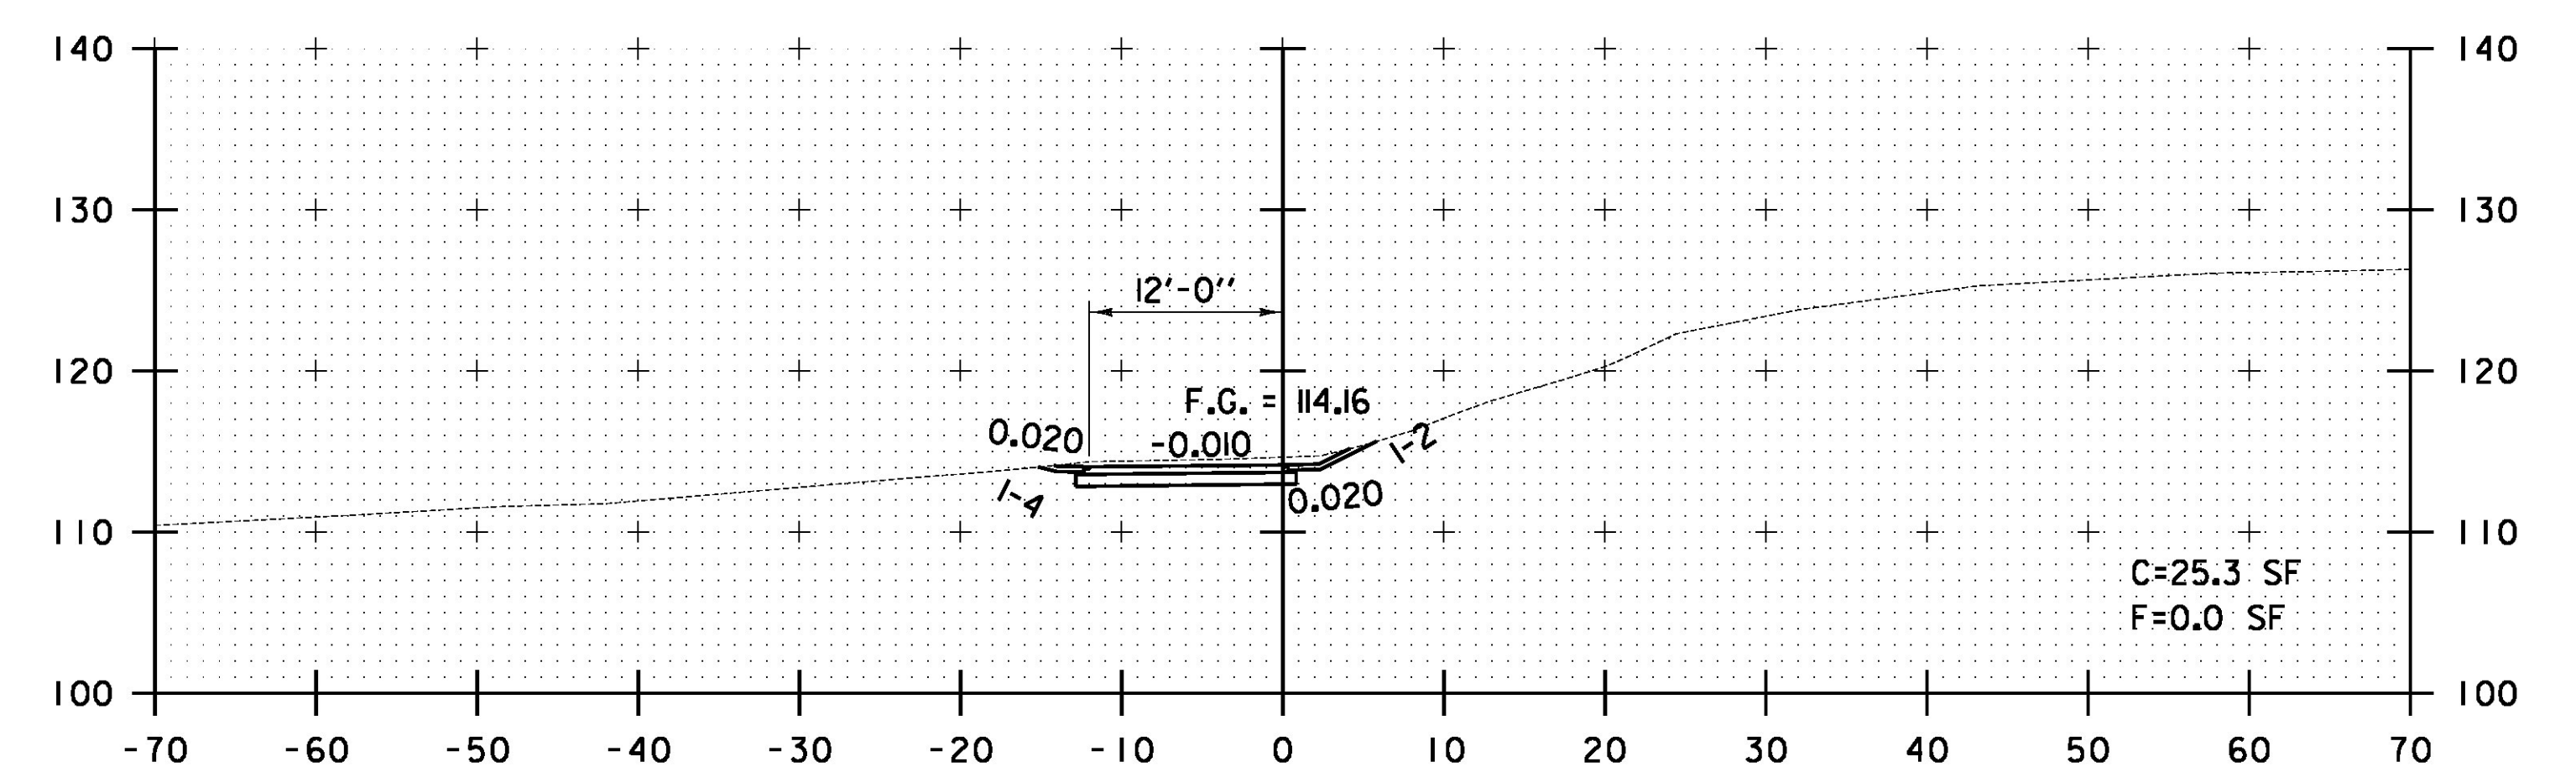
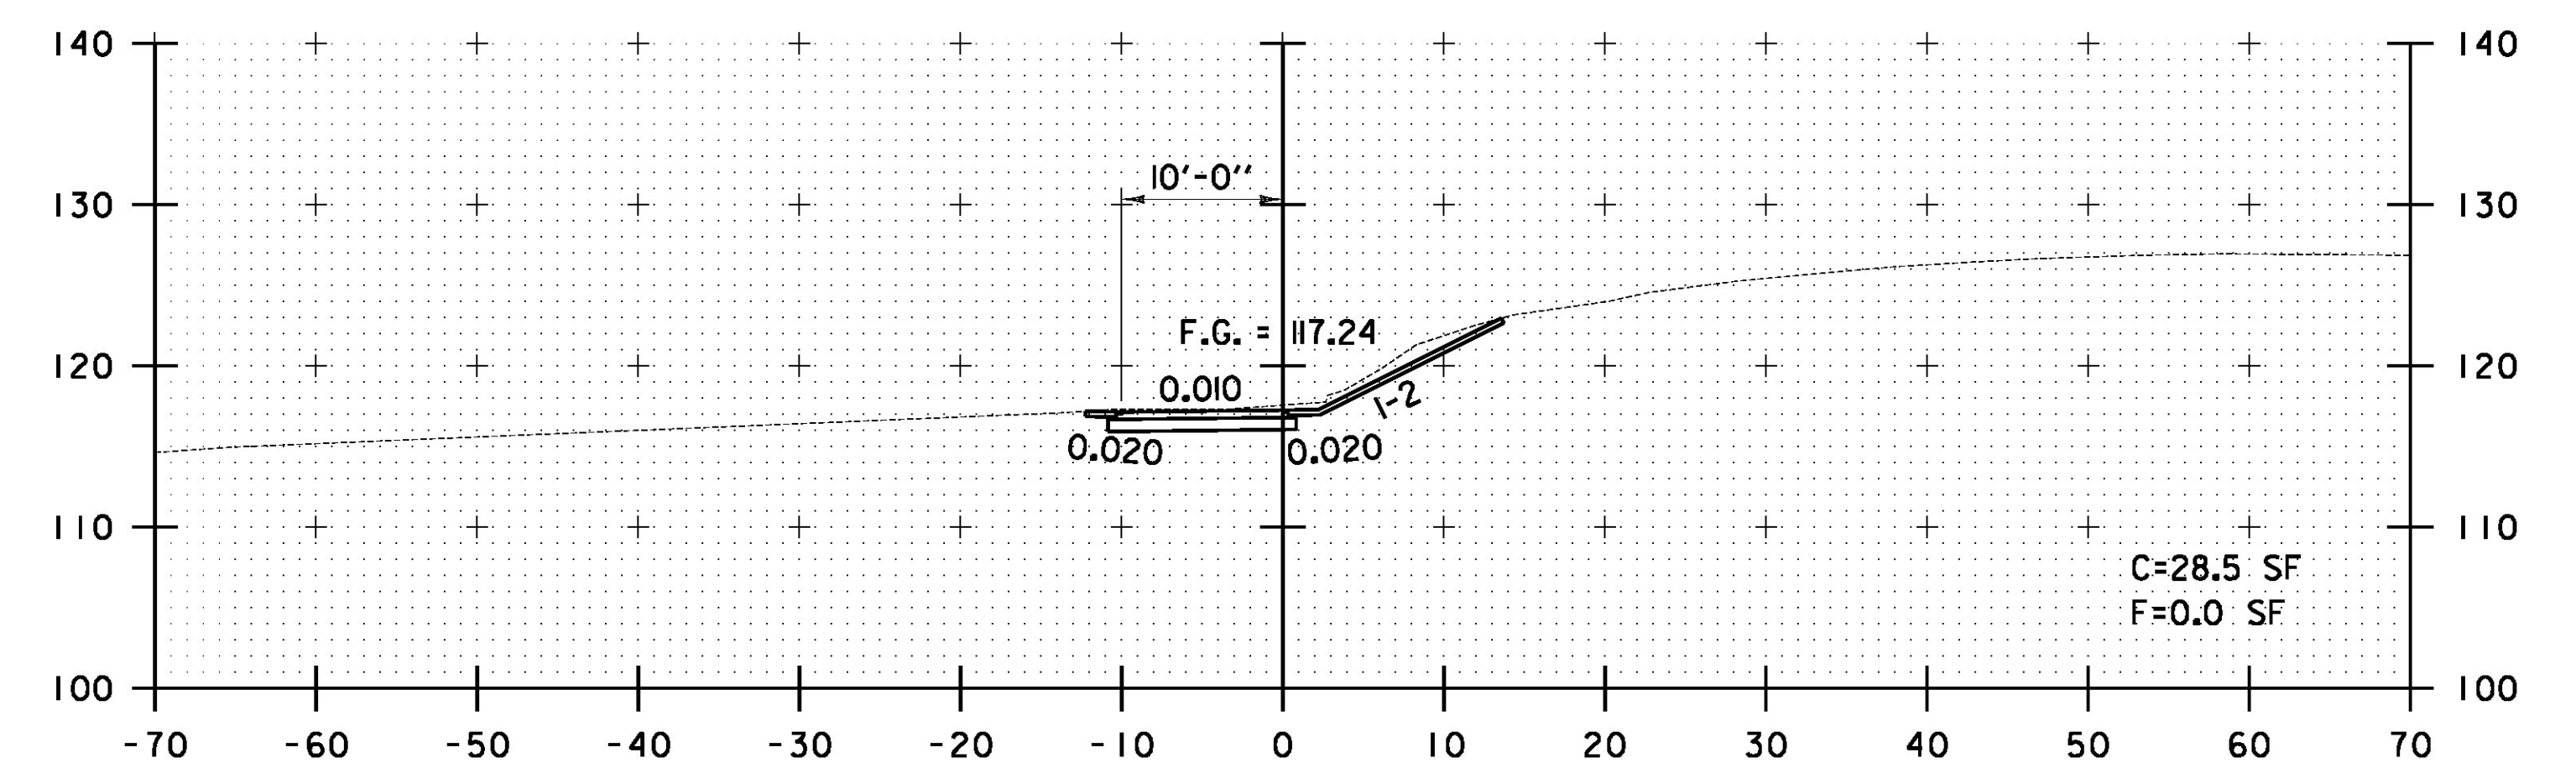
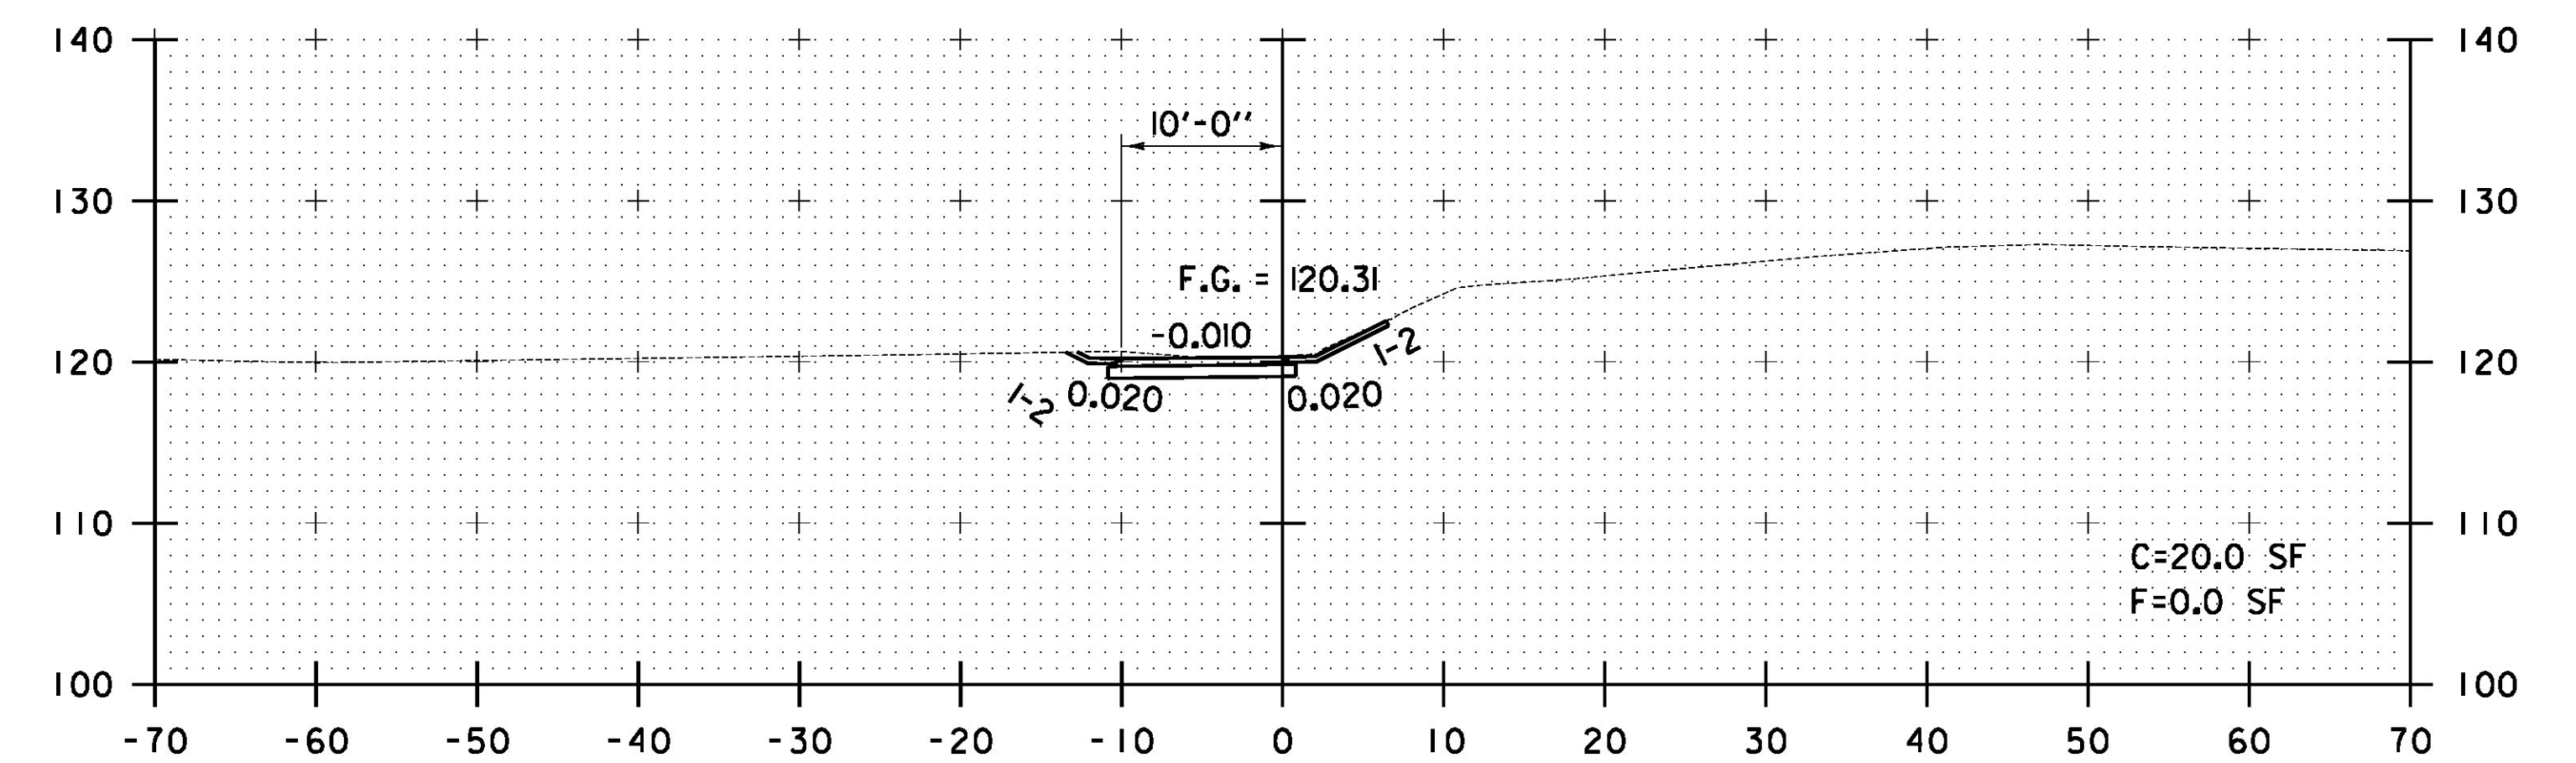
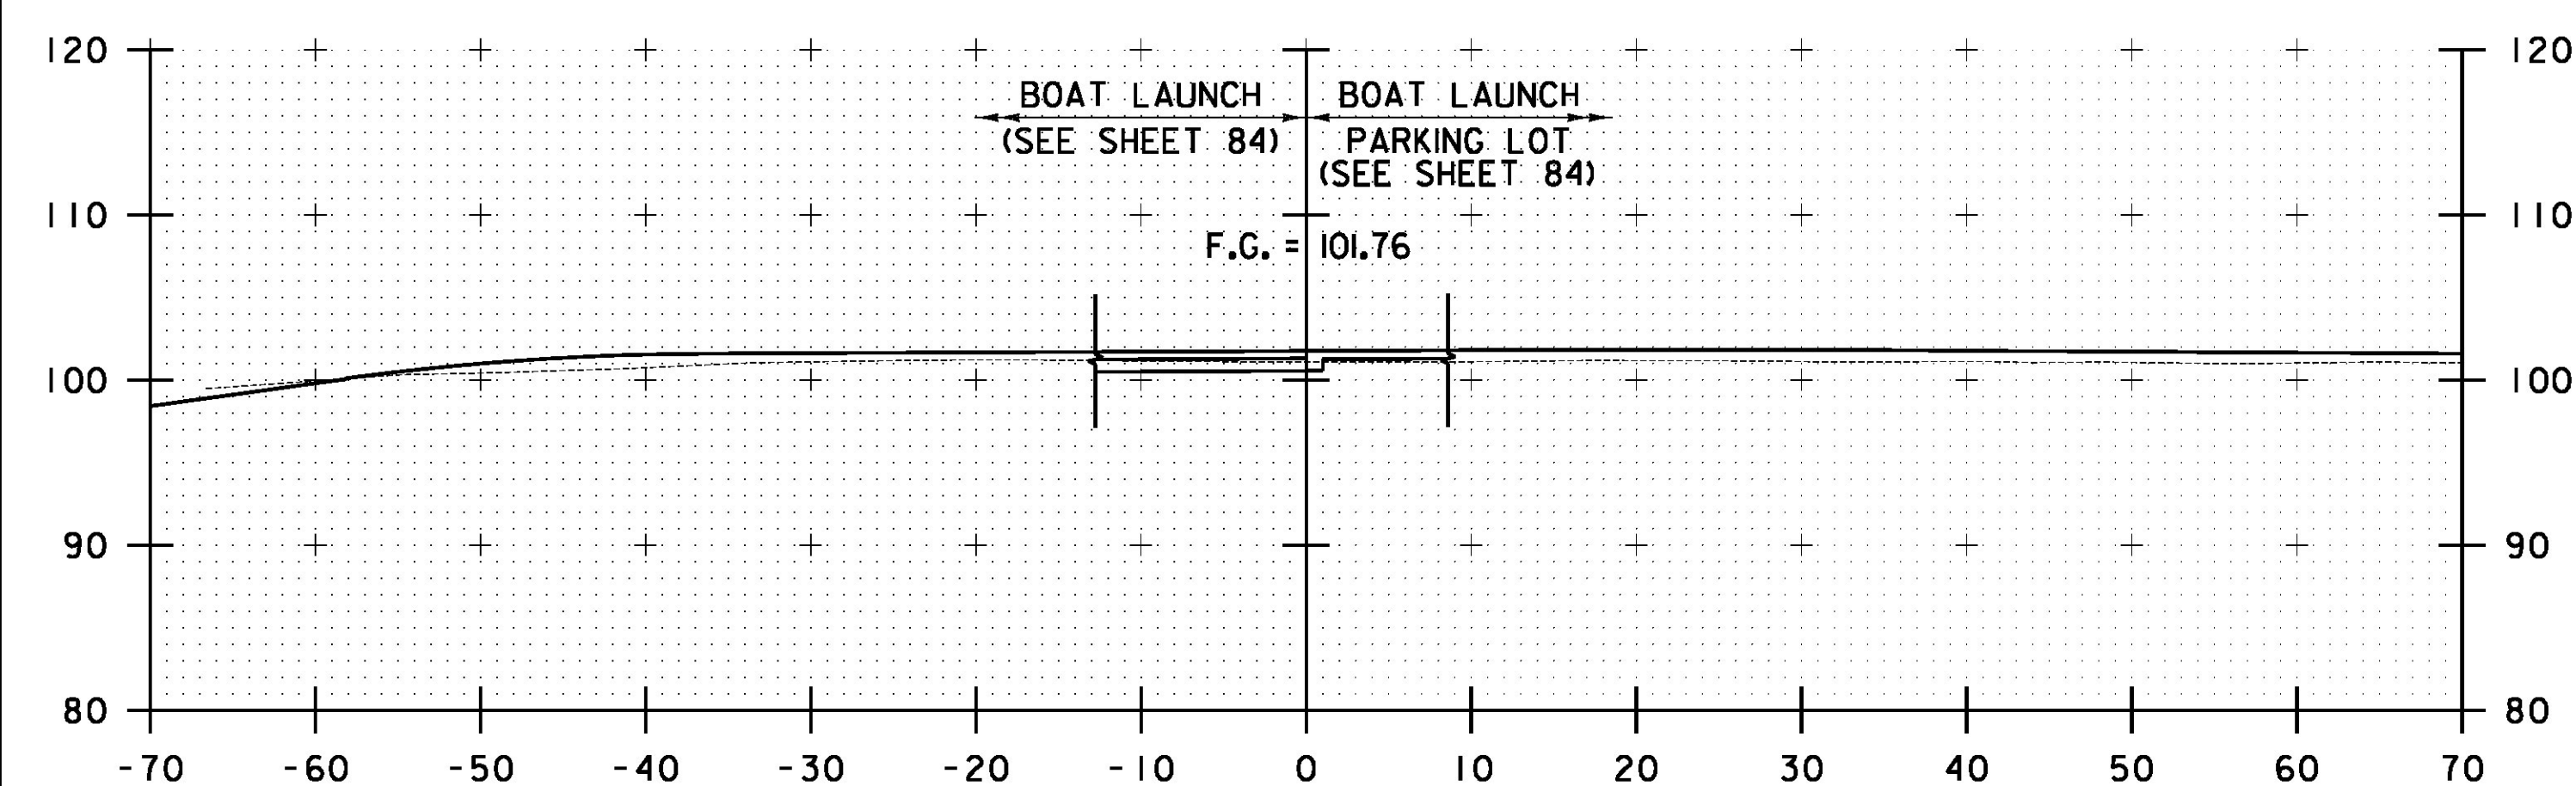
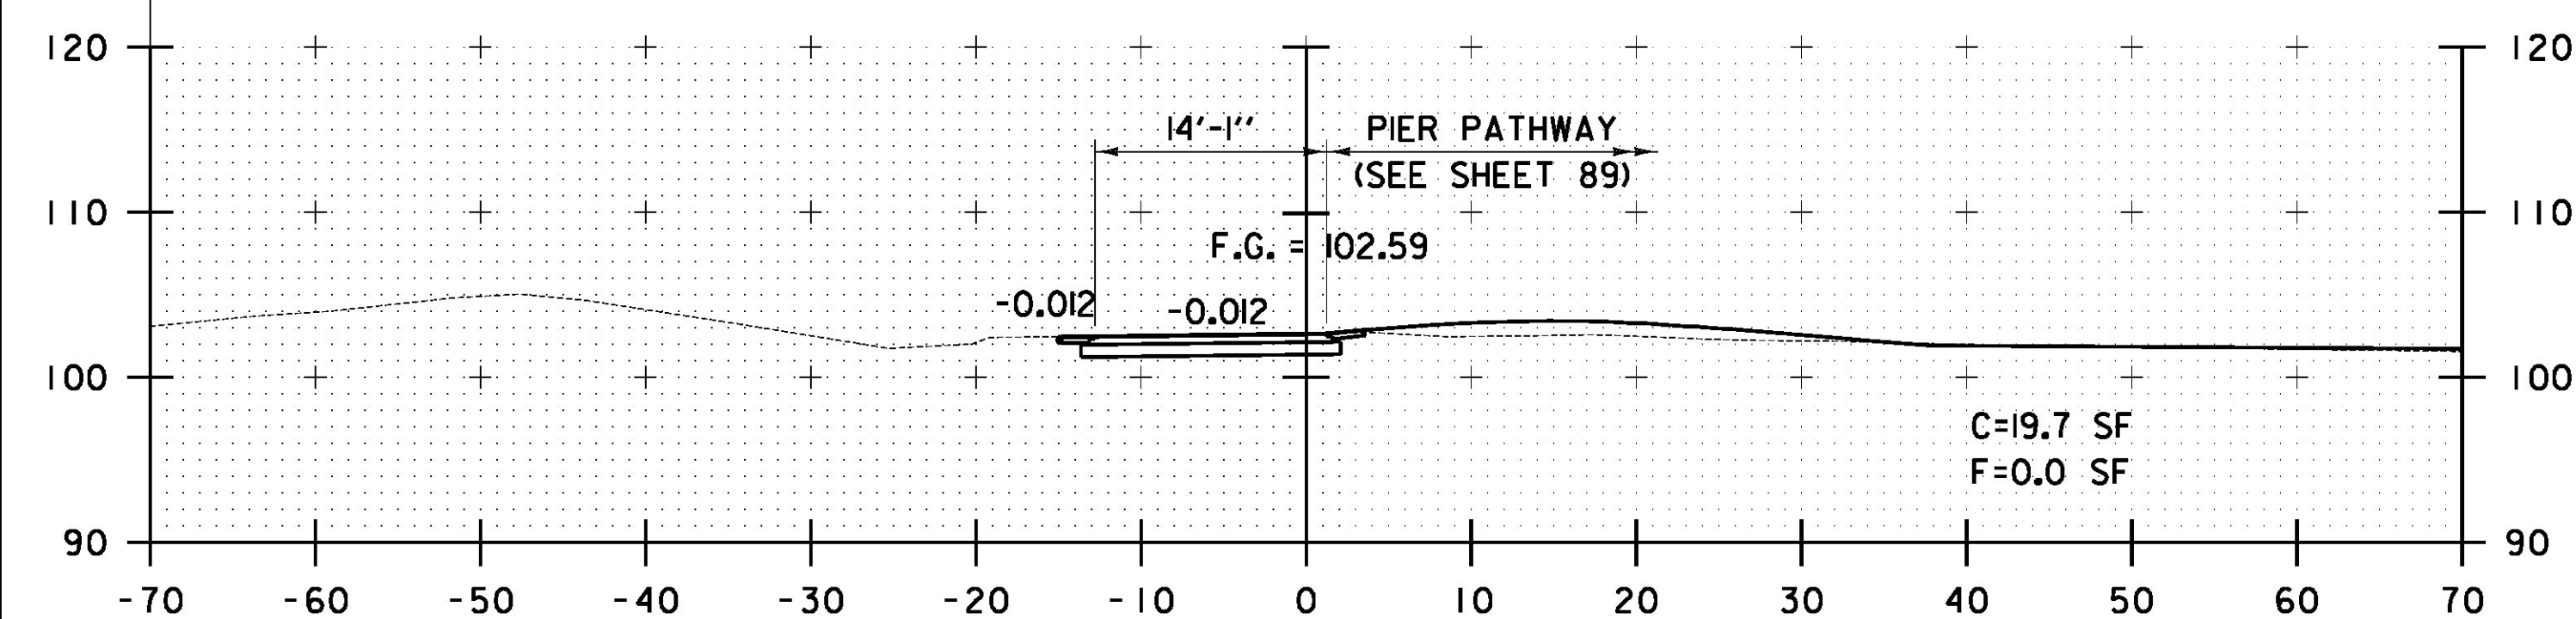


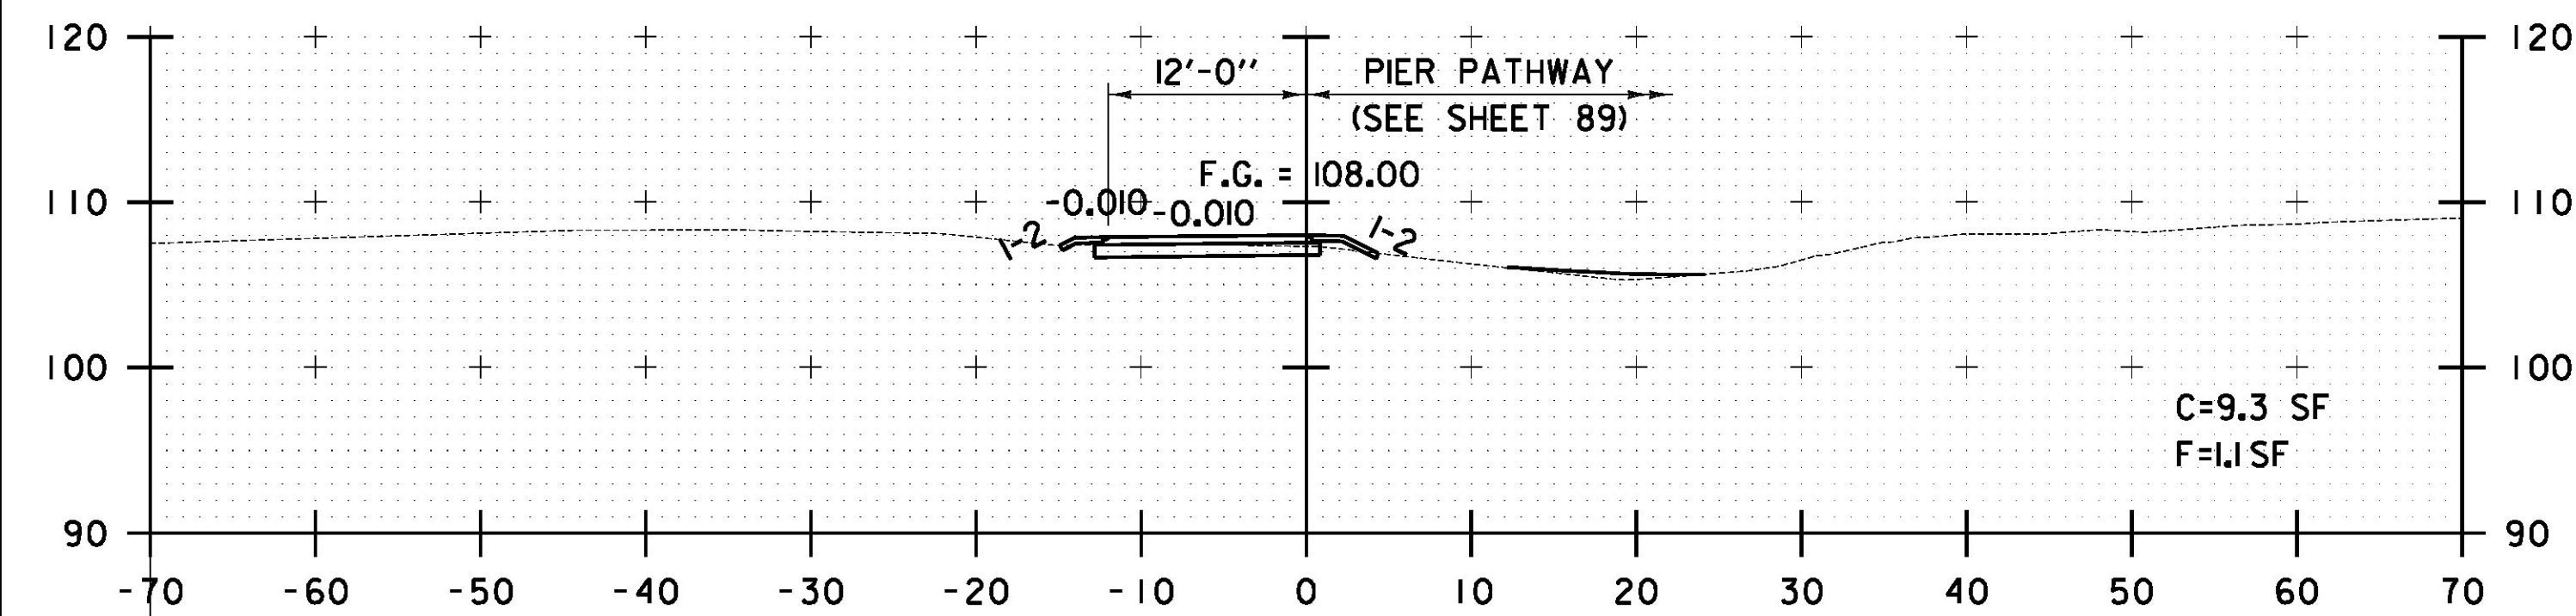

STA. CP 10+00 TO STA. CP 12+00

```
FILE NAME = U:\20330\CADD\MSTN\z12E008_xsec_01.dgn
DATE/TIME = 7/12/2012
USER = 4066
```

CROSS SECTION SHEET #1

PROJECT NAME:	LAKE CHAMPLAIN SITE RESTORATION
PROJECT NUMBER:	STP 032-1(I18)

FILE NAME: z12E008_xsec_01.dgn
PROJECT LEADER: D.E.G.
DESIGNED BY: B.T.H.
DWG. NO.: XS-I

PLOT DATE: 7/12/2012
DRAWN BY: W.G.P.
CHECKED BY: D.E.G.
SHEET 75 OF 100