
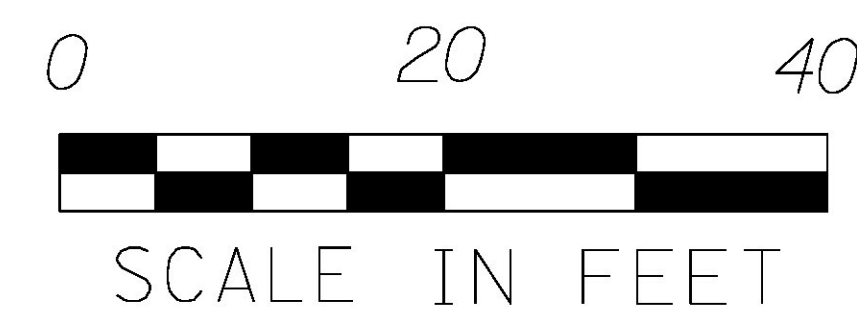
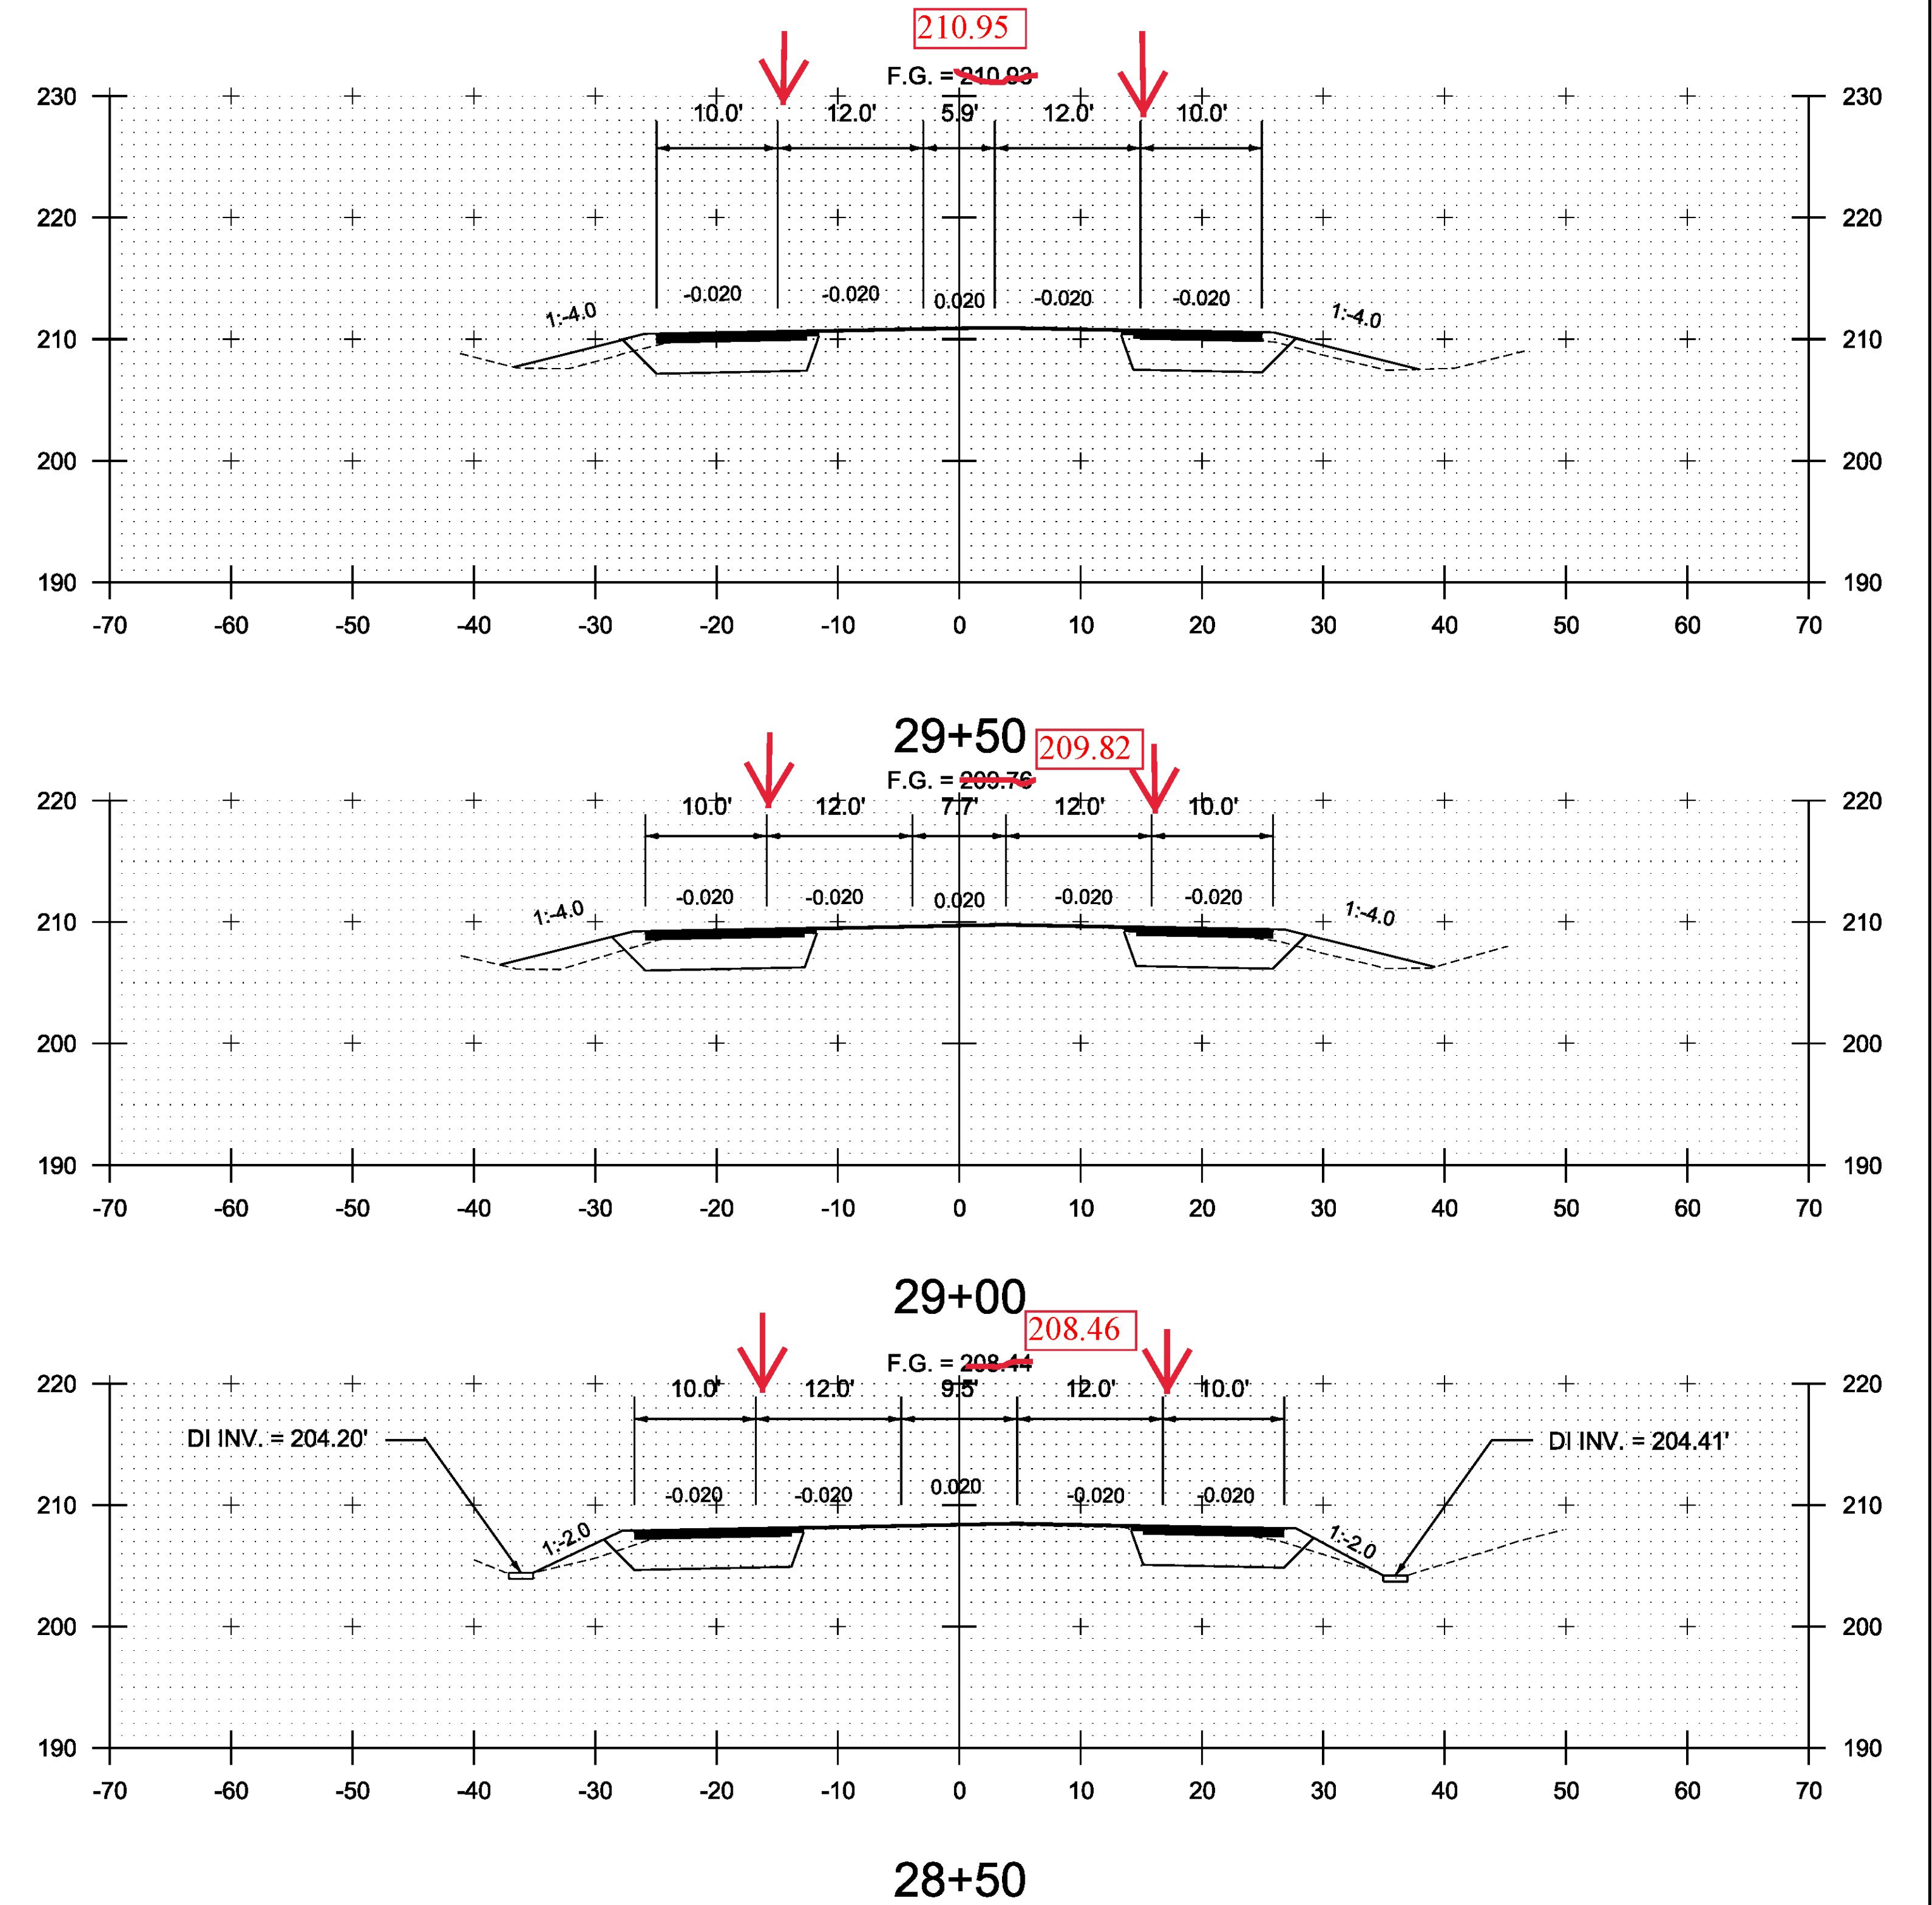


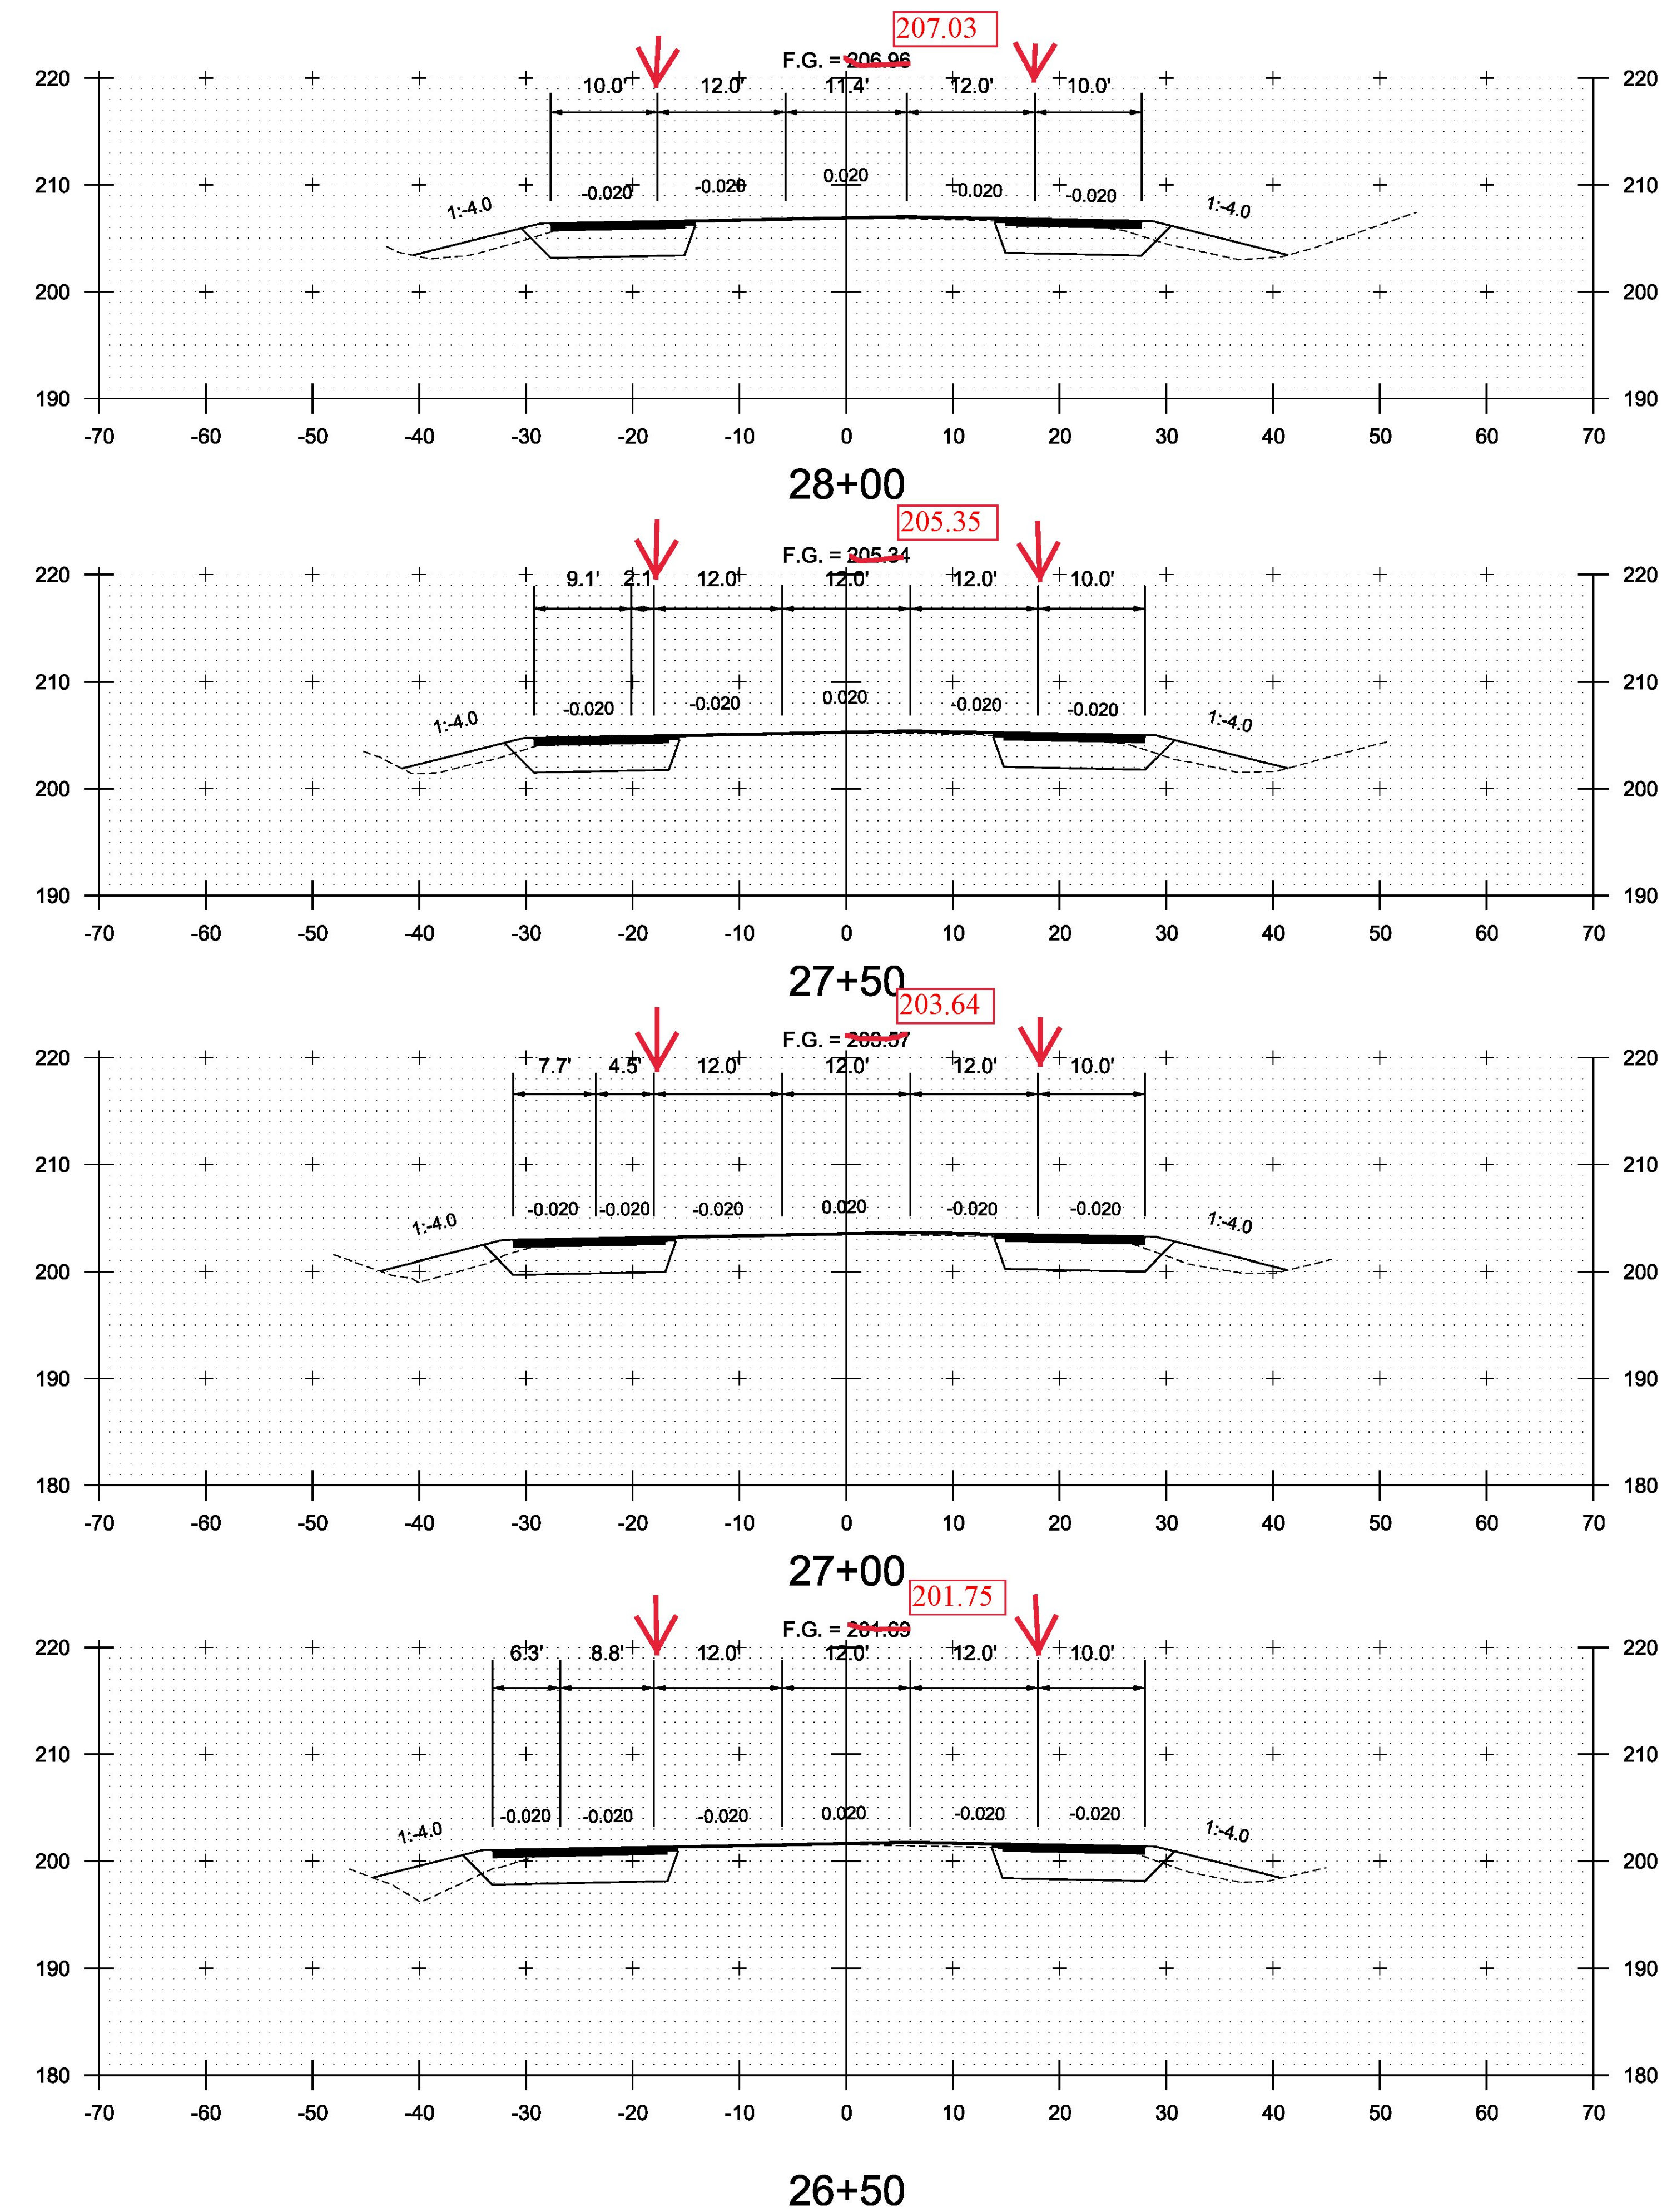

STA. 26+50 TO STA. 29+50

PROJECT NAME: COLCHESTER	
PROJECT NUMBER: HES 028-I(28)	
FILE NAME: i13b028xsl.dgn	PLOT DATE: 12/7/2015
PROJECT LEADER: P. COBURN	DRAWN BY: M. BOGACZYK
DESIGNED BY: M. BOGACZYK	CHECKED BY: M. LACROIX
CROSS SECTION SHEET 7	SHEET 69 OF 91