


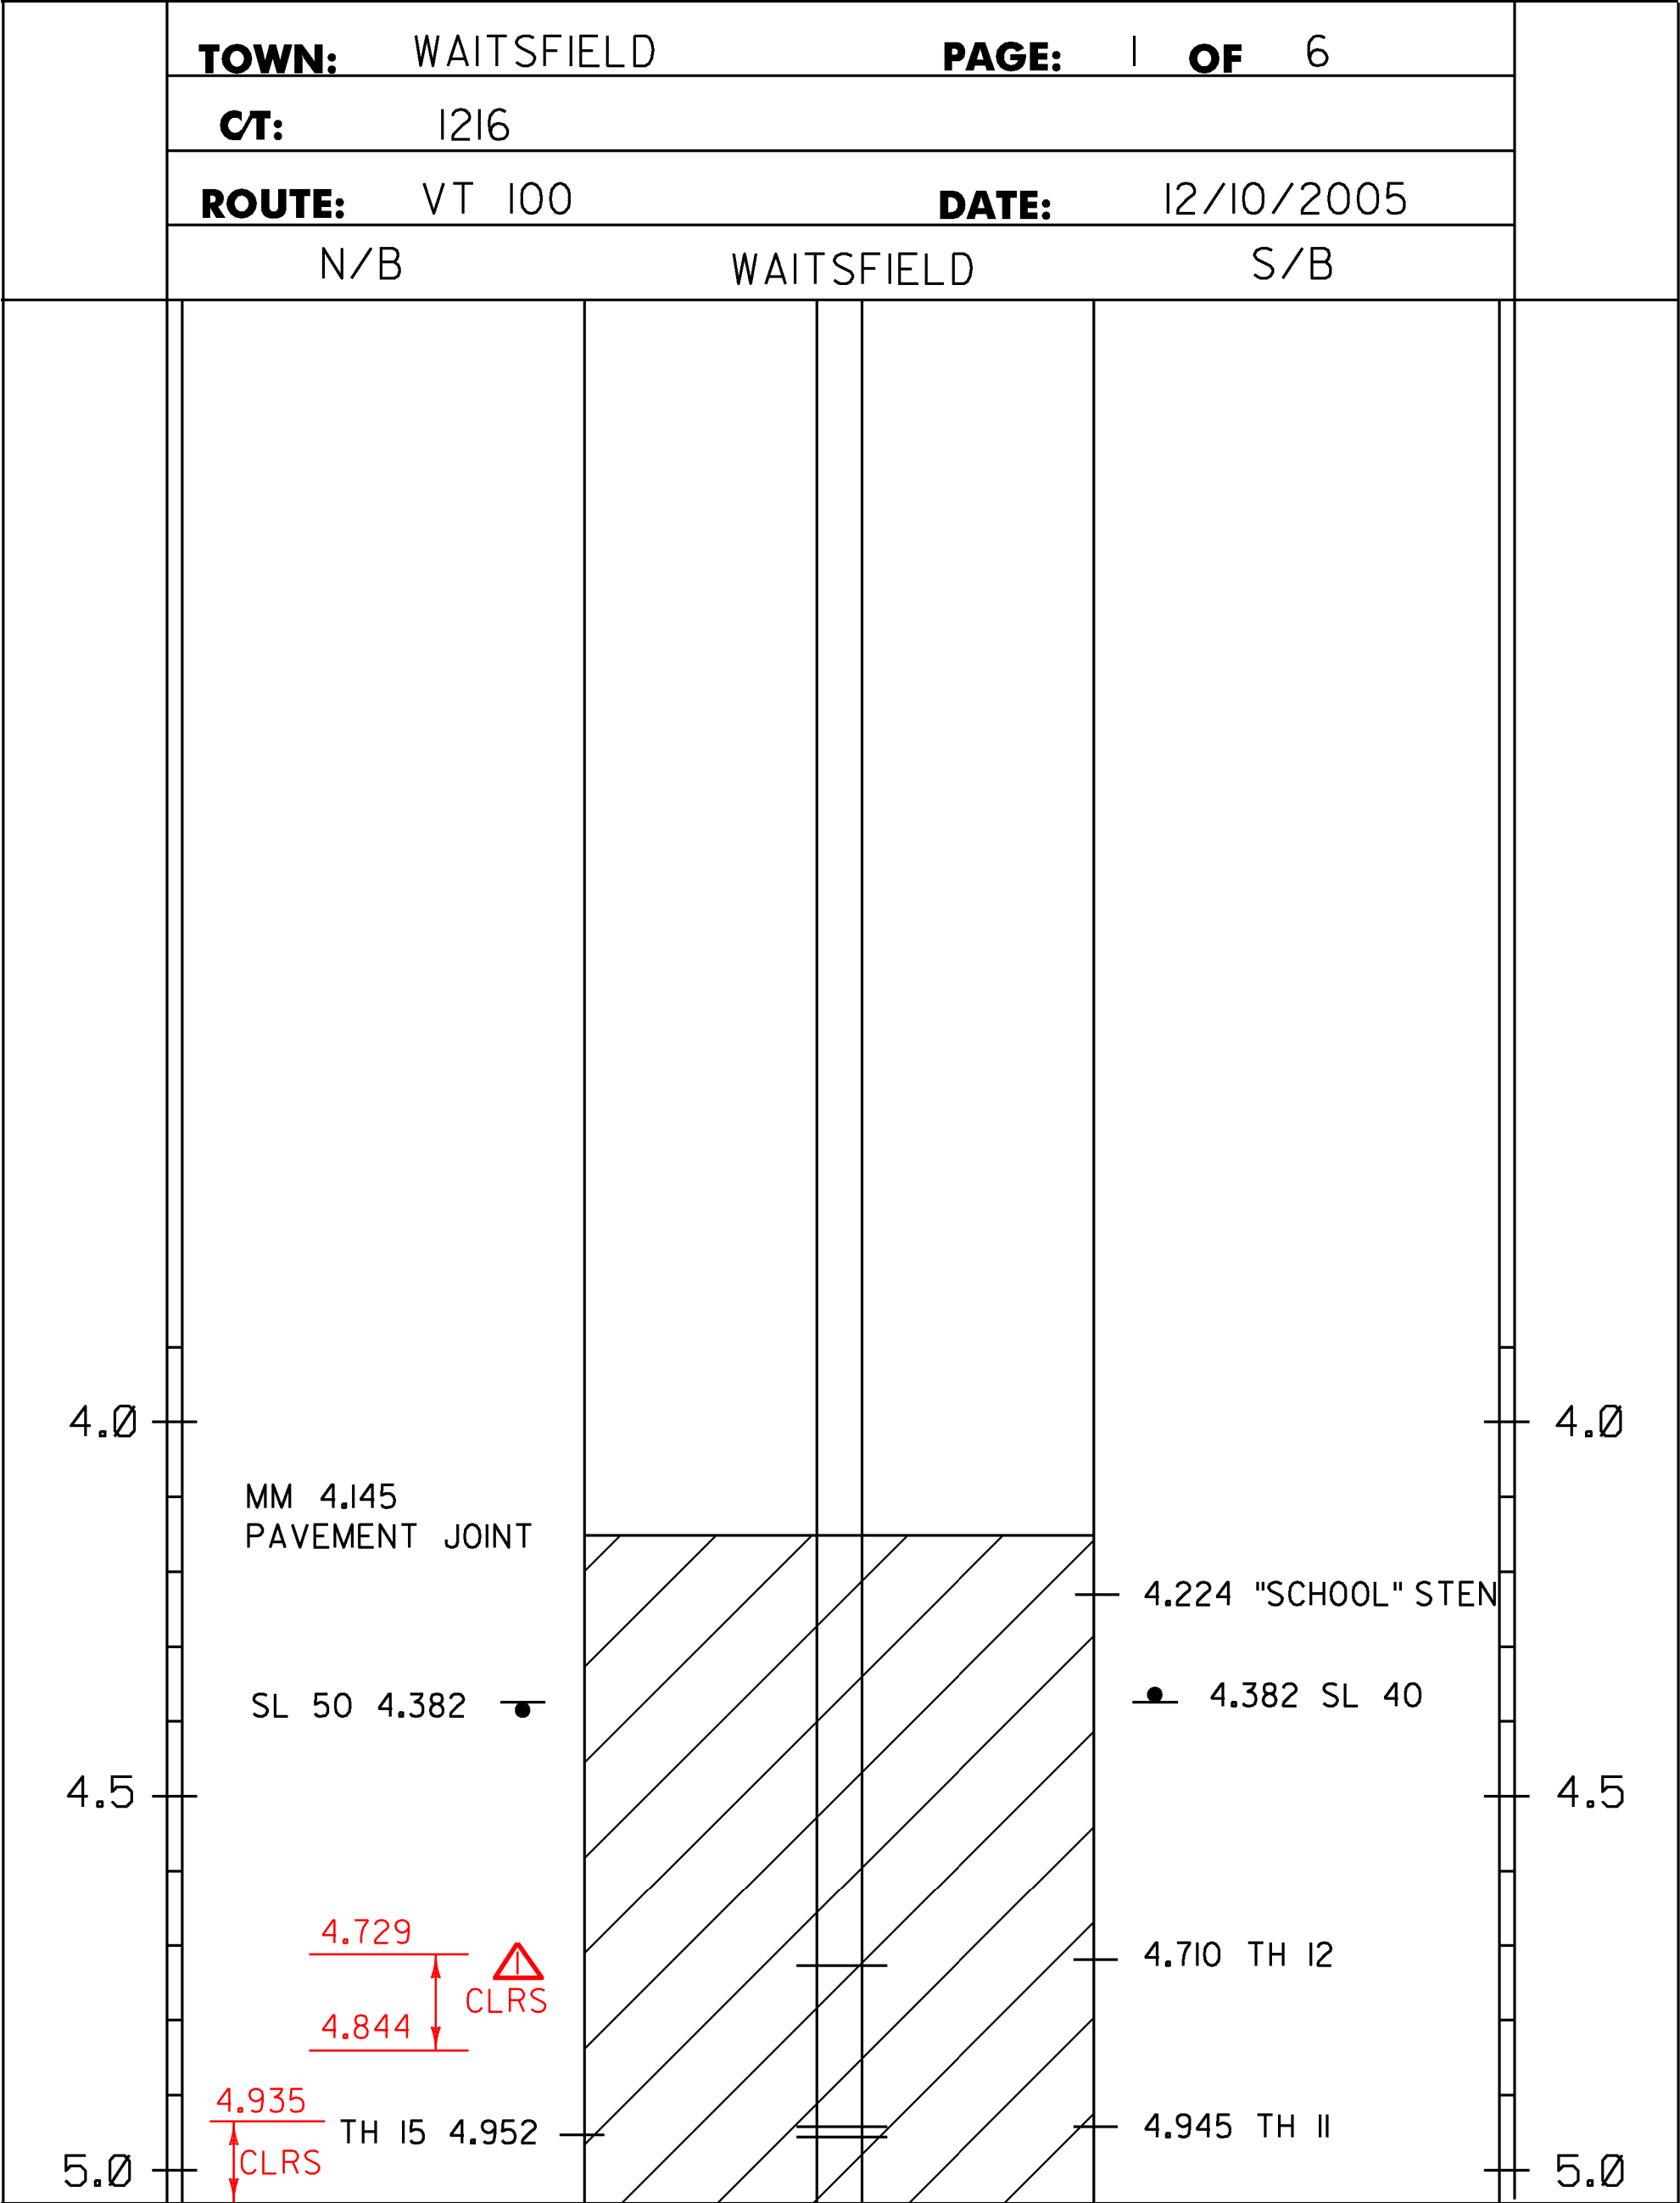

646.404 DURABLE 4 INCH WHITE LINE, POLYUREA
646.602 TEMPORARY 4 INCH WHITE LINE, PAINT

WAITSFIELD:
MM 4.15 - MM 7.580 LT & RT
(WITH BREAKS OR RADII AT TOWN HIGHWAYS)

646.414 DURABLE 4 INCH YELLOW LINE, POLYUREA
646.612 TEMPORARY 4 INCH YELLOW LINE, PAINT



WAITSFIELD:
MM 4.15 - MM 5.943 SOLID RT
MM 5.943 - MM 6.095 DASH RT
MM 6.095 - MM 7.580 SOLID RT
MM 4.15 - MM 6.073 SOLID LT
MM 6.073 - MM 6.225 DASH LT
MM 6.225 - MM 6.810 SOLID LT
MM 6.810 - MM 6.953 DASH LT
MM 6.953 - MM 7.580 SOLID LT
(WITH CENTERLINE BREAKS AT TOWN HIGHWAYS)

646.492 DURABLE LETTER OR SYMBOL, THERMOPLASTIC OR
646.494 DURABLE LETTER OR SYMBOL, POLYUREA

WAITSFIELD:
MM 3.989 NB "SCHOOL"
MM 4.224 SB "SCHOOL"

646.692 TEMPORARY LETTER OR SYMBOL, PAINT

WAITSFIELD:
MM 3.989 NB "SCHOOL"
MM 4.224 SB "SCHOOL"

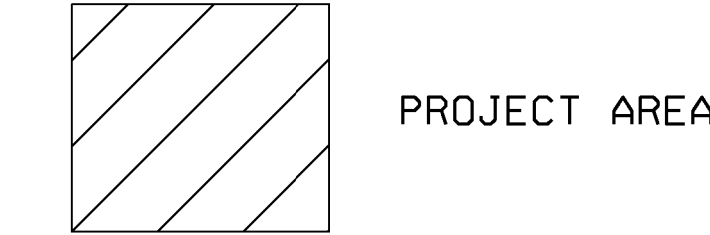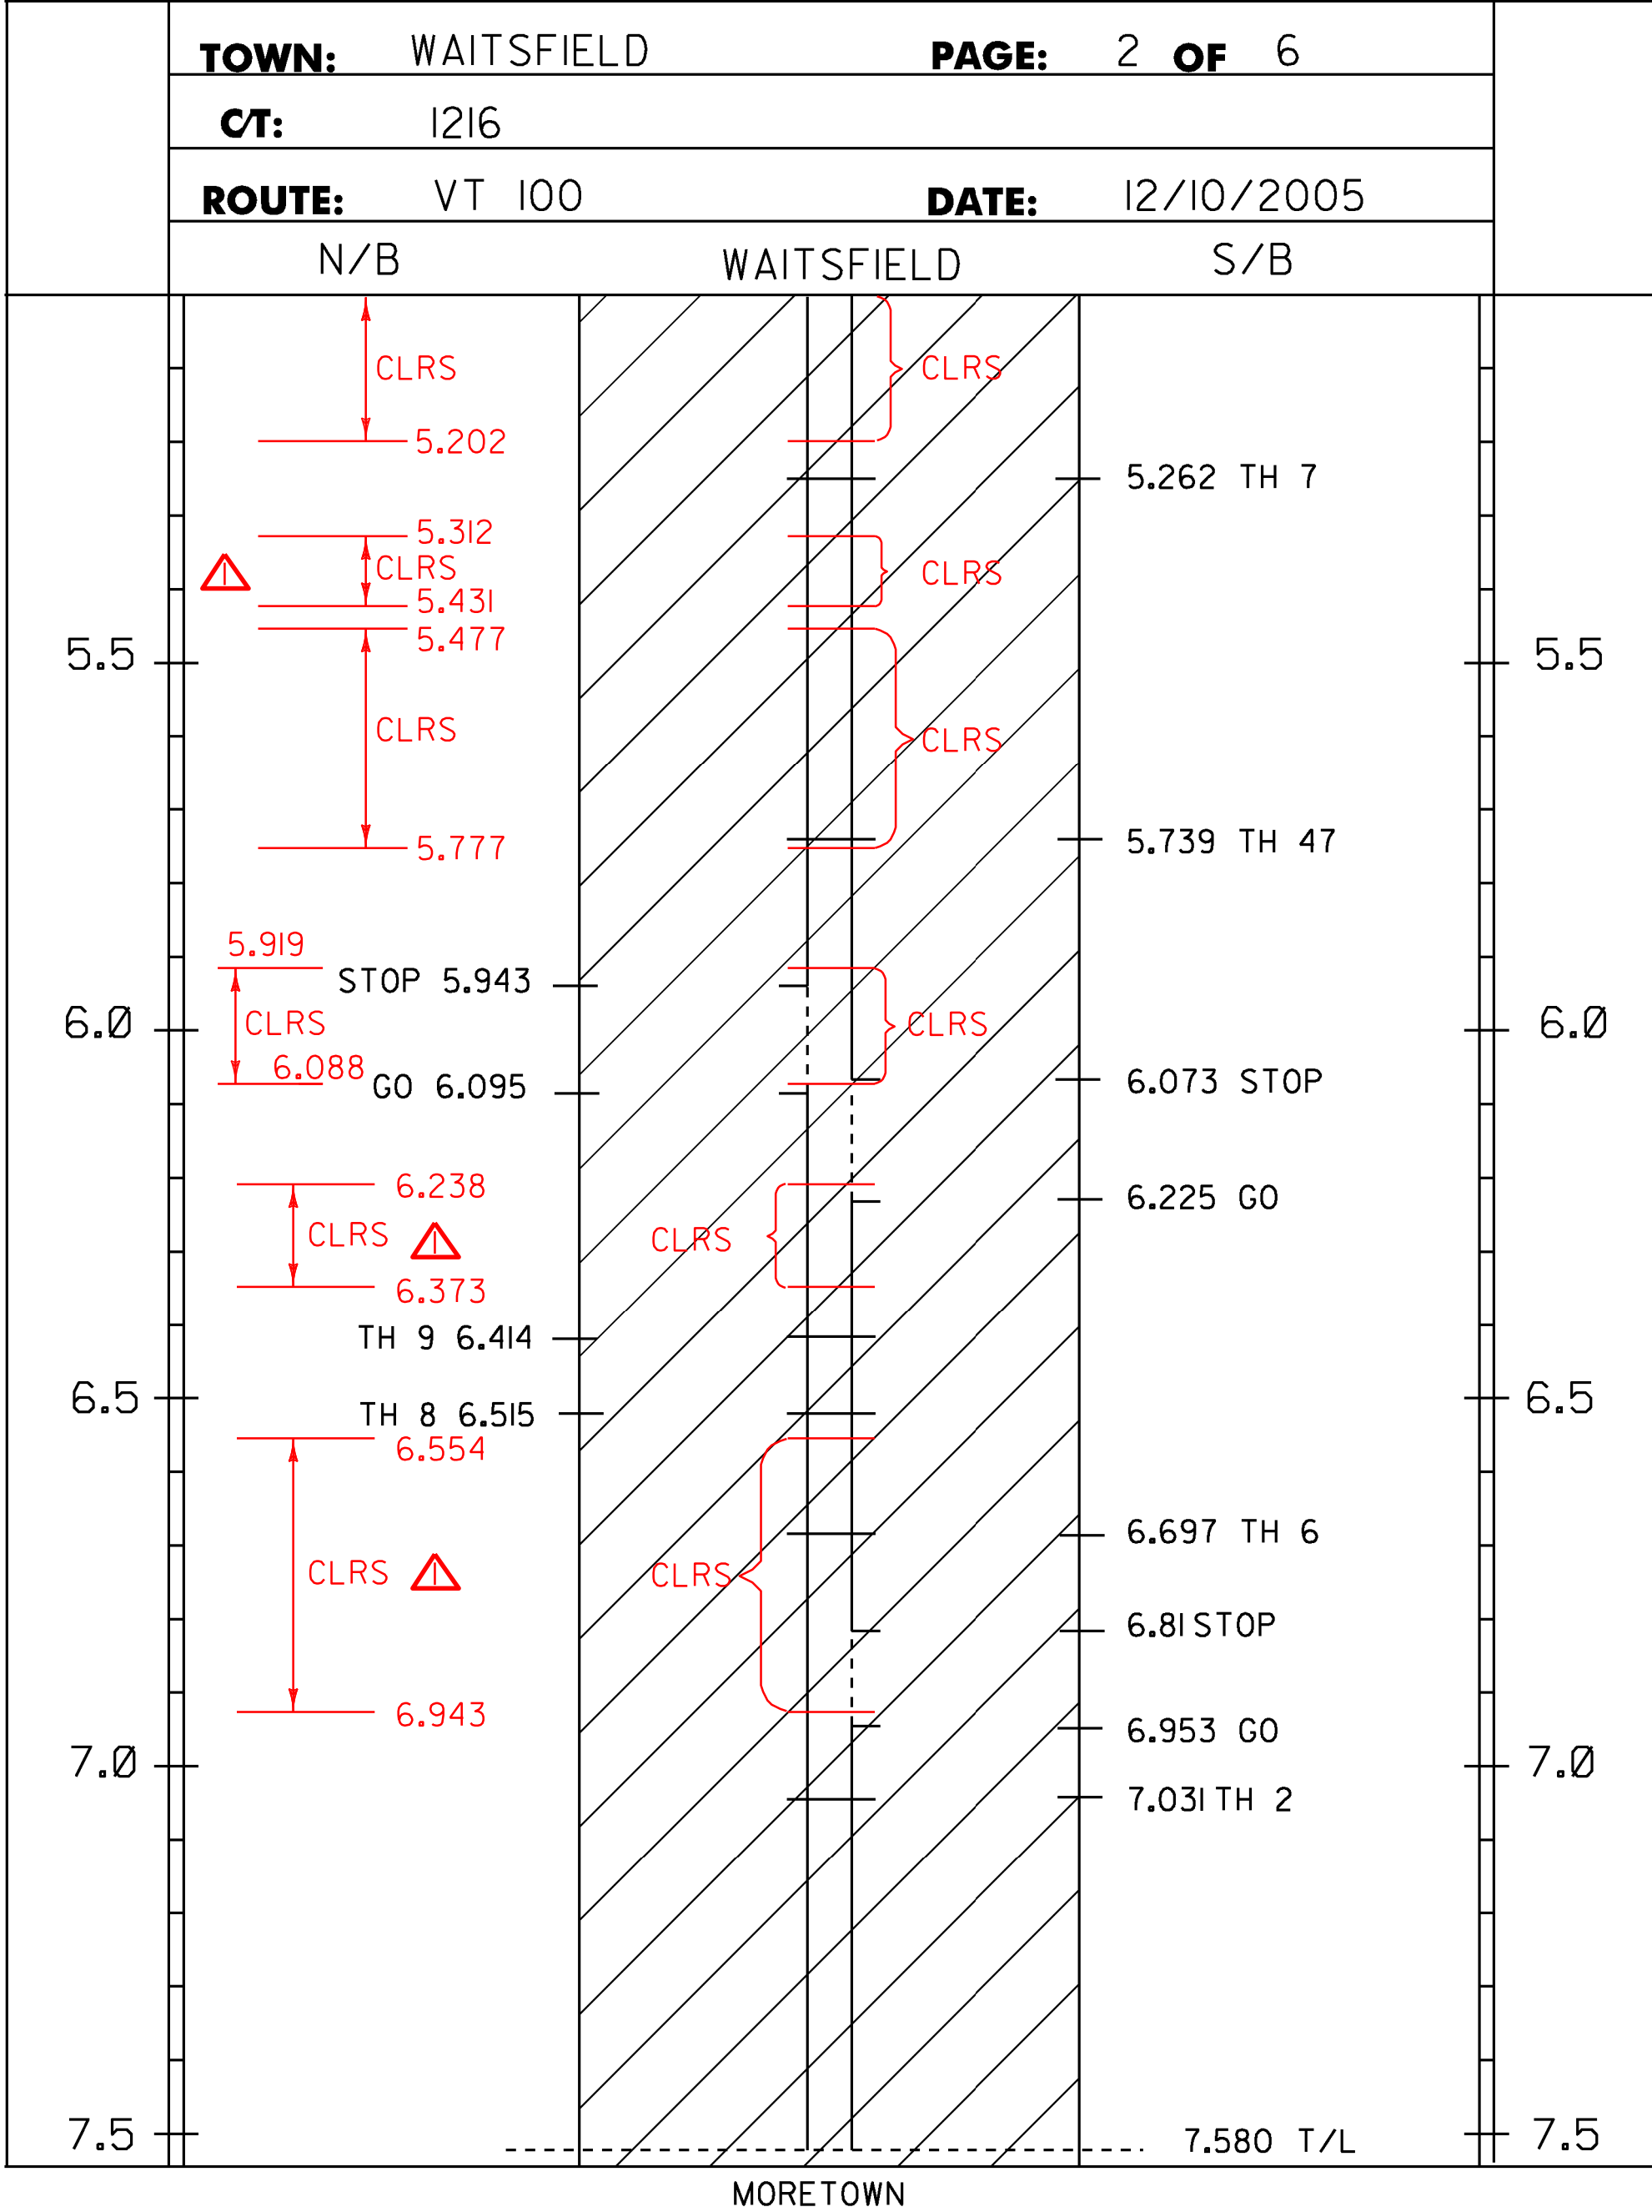

NOTE:
1. THIS SHEET TO BE USED FOR THE LAYOUT OF ALL CENTERLINE PAVEMENT MARKINGS.
THE RESIDENT ENGINEER MAY CONTACT KEITH SWEET, PAVEMENT MARKING SUPERVISOR
AT (802) 828-5573 FOR ASSISTANCE LAYING OUT THE CENTERLINE DURING CONSTRUCTION.

LEGEND
TWBH-THROUGHWAY BEGINS HERE
TWEH-THROUGHWAY ENDS HERE
SHB-STATE HIGHWAY BEGINS
SHE-STATE HIGHWAY ENDS
SL-SPEED LIMIT
C/4 TH- CLASS 4 TOWN HIGHWAY
T/L-TOWN LINE

NOT TO SCALE

PROJECT
LAYOUT
SHEET #10

KEY	DATE	BY	REVISION
△	10/21/15	CPP	REVISED CLRS LOCATIONS
PROJECT NAME: WAITFIELD-MORETOWN			
PROJECT NUMBER: STP SURF(39)			
FILE NAME: I3BI68\pi3BI68.dgn		PLOT DATE: 06-MAY-2014	
PROJECT LEADER: FOWLER		DRAWN BY: BULLOCK	
DESIGNED BY: BULLOCK		CHECKED BY: M. FOWLER	
IPARM FILE NAME: pi3bi68lay10.i		SHEET 17 OF 26	