


TYPICAL SECTIONS RAVINE

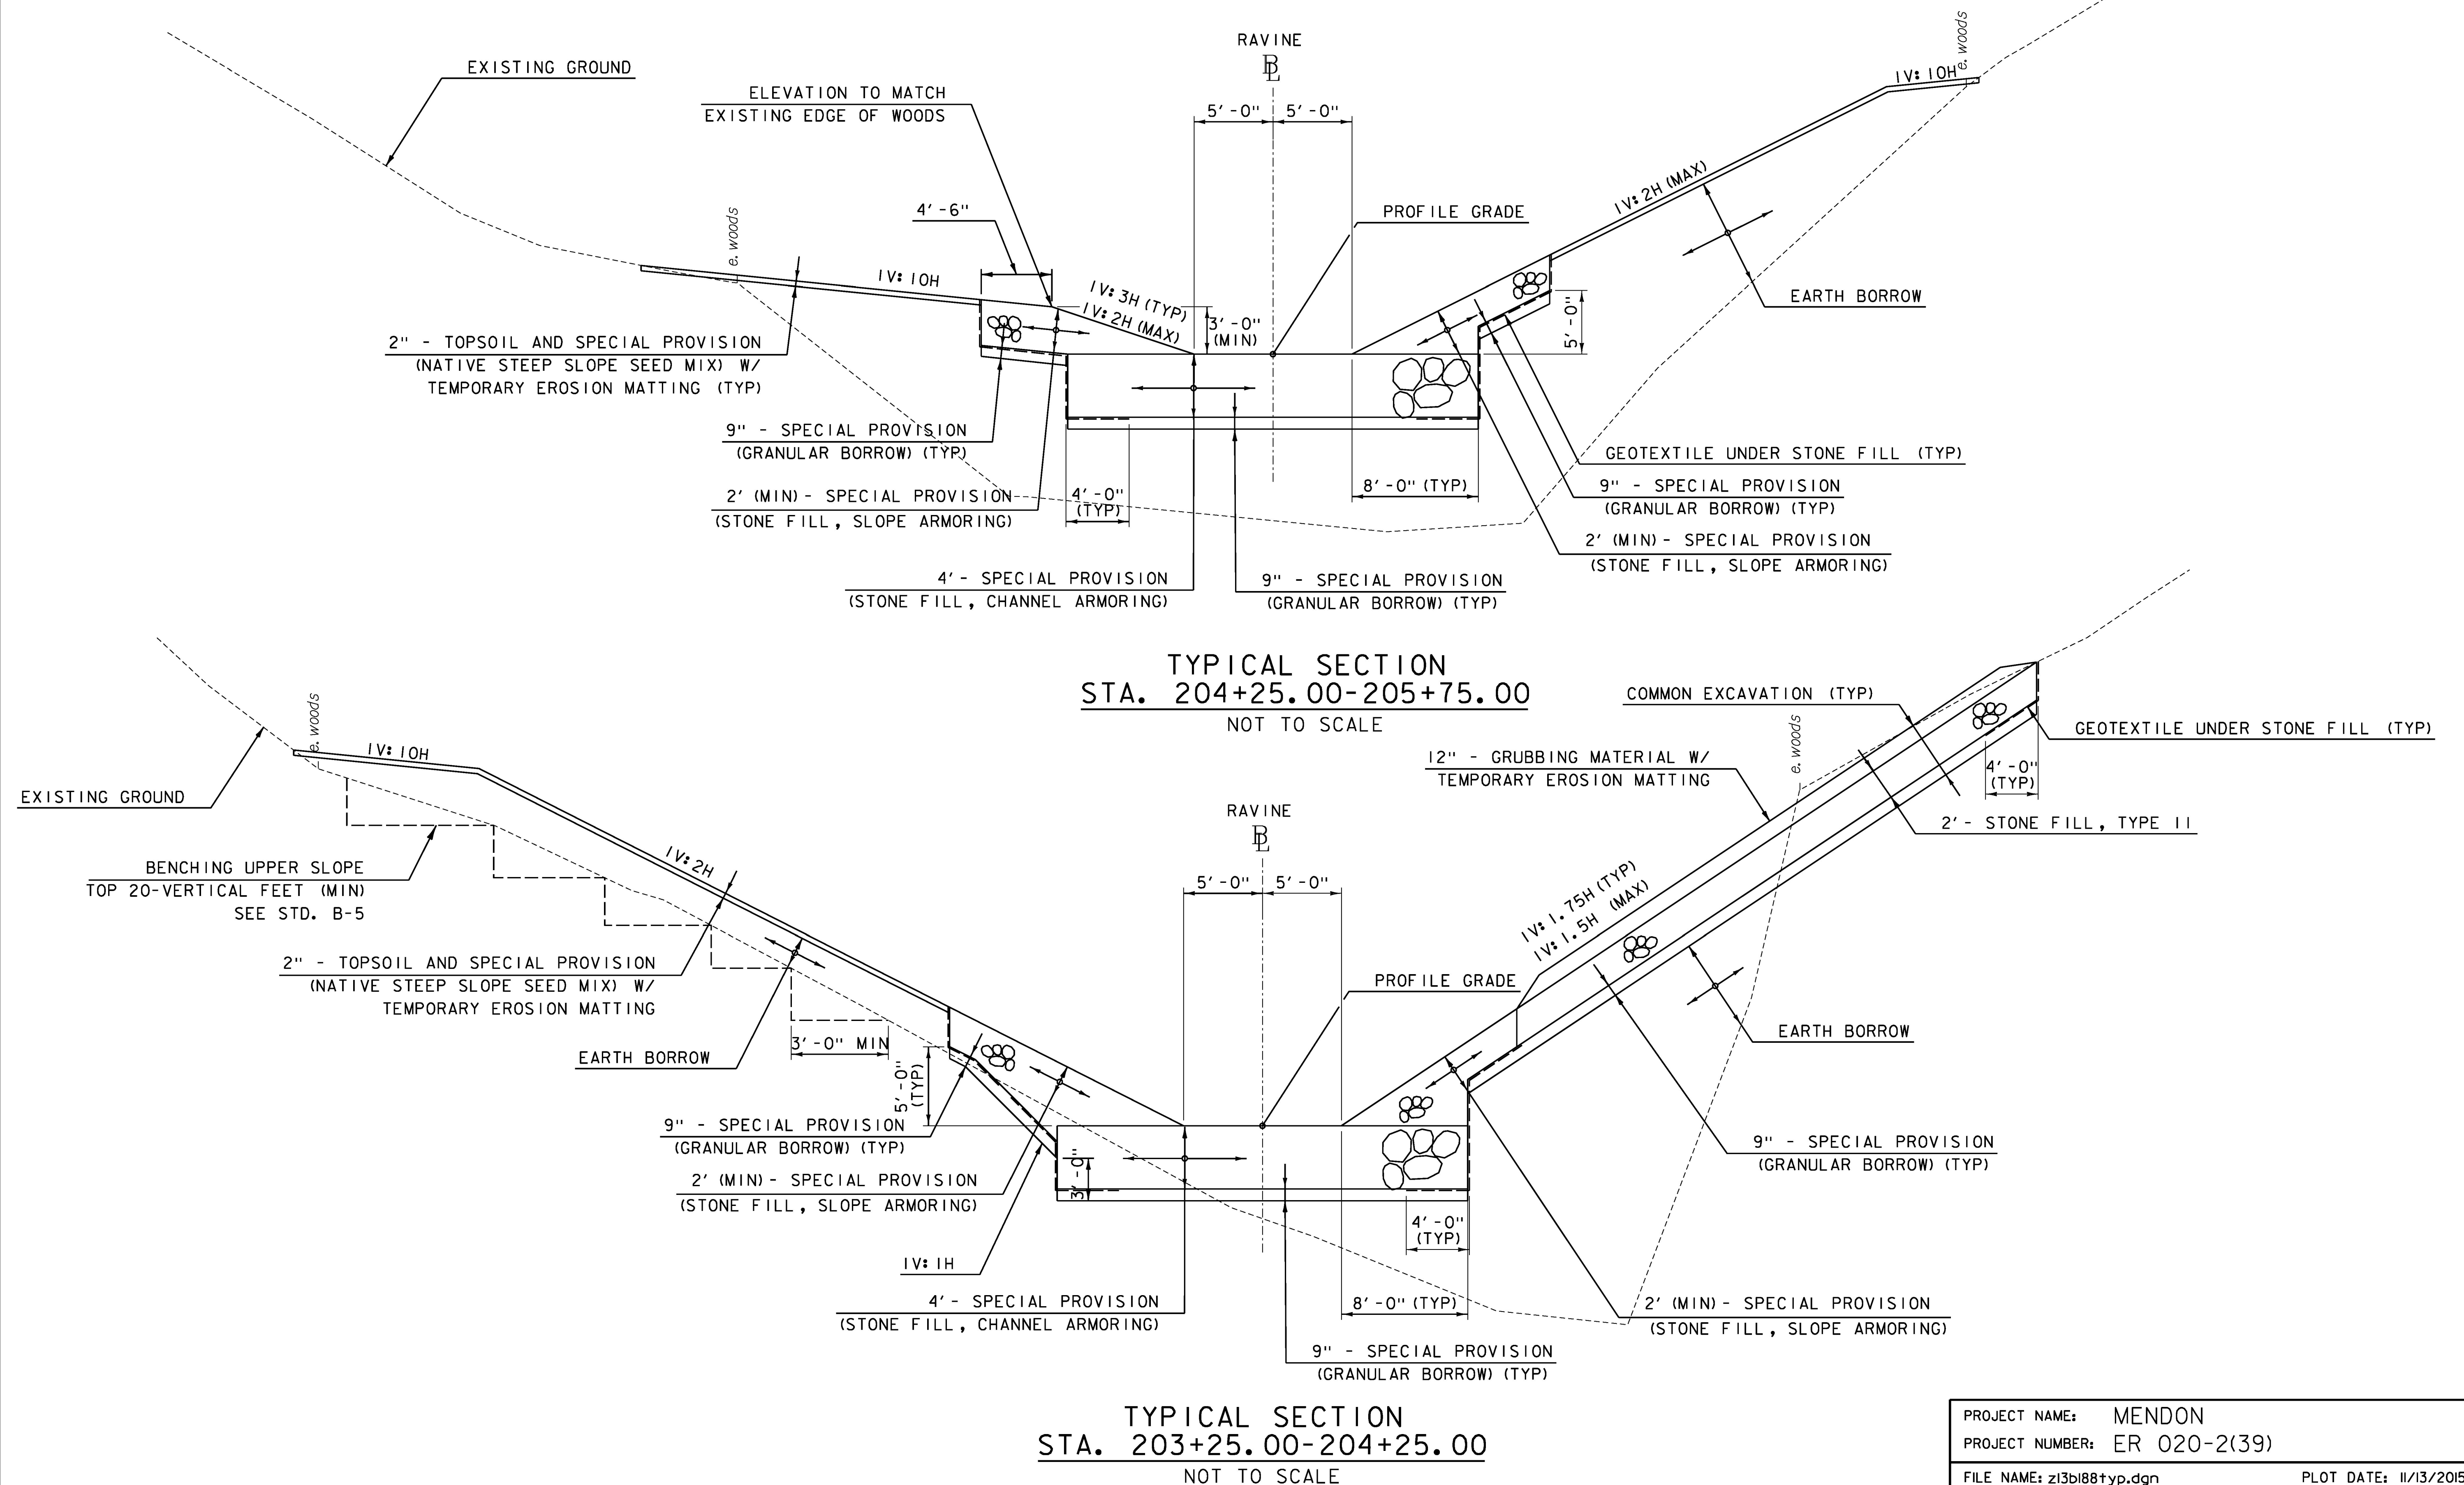

REFER TO SHEET 4 FOR PROJECT NOTES.

GREEN INTERNATIONAL AFFILIATES, INC.
CIVIL AND STRUCTURAL ENGINEERS

PROJECT NAME: MENDON
PROJECT NUMBER: ER 020-2(39)

FILE NAME: z13b188typ.dgn
PROJECT LEADER: E. ATKINS
DESIGNED BY: M. BRADLEY
TYPICAL SECTIONS SHEET 5

PLOT DATE: 11/13/2015
DRAWN BY: M. BRADLEY
CHECKED BY: E. ATKINS
SHEET 9 OF 72