
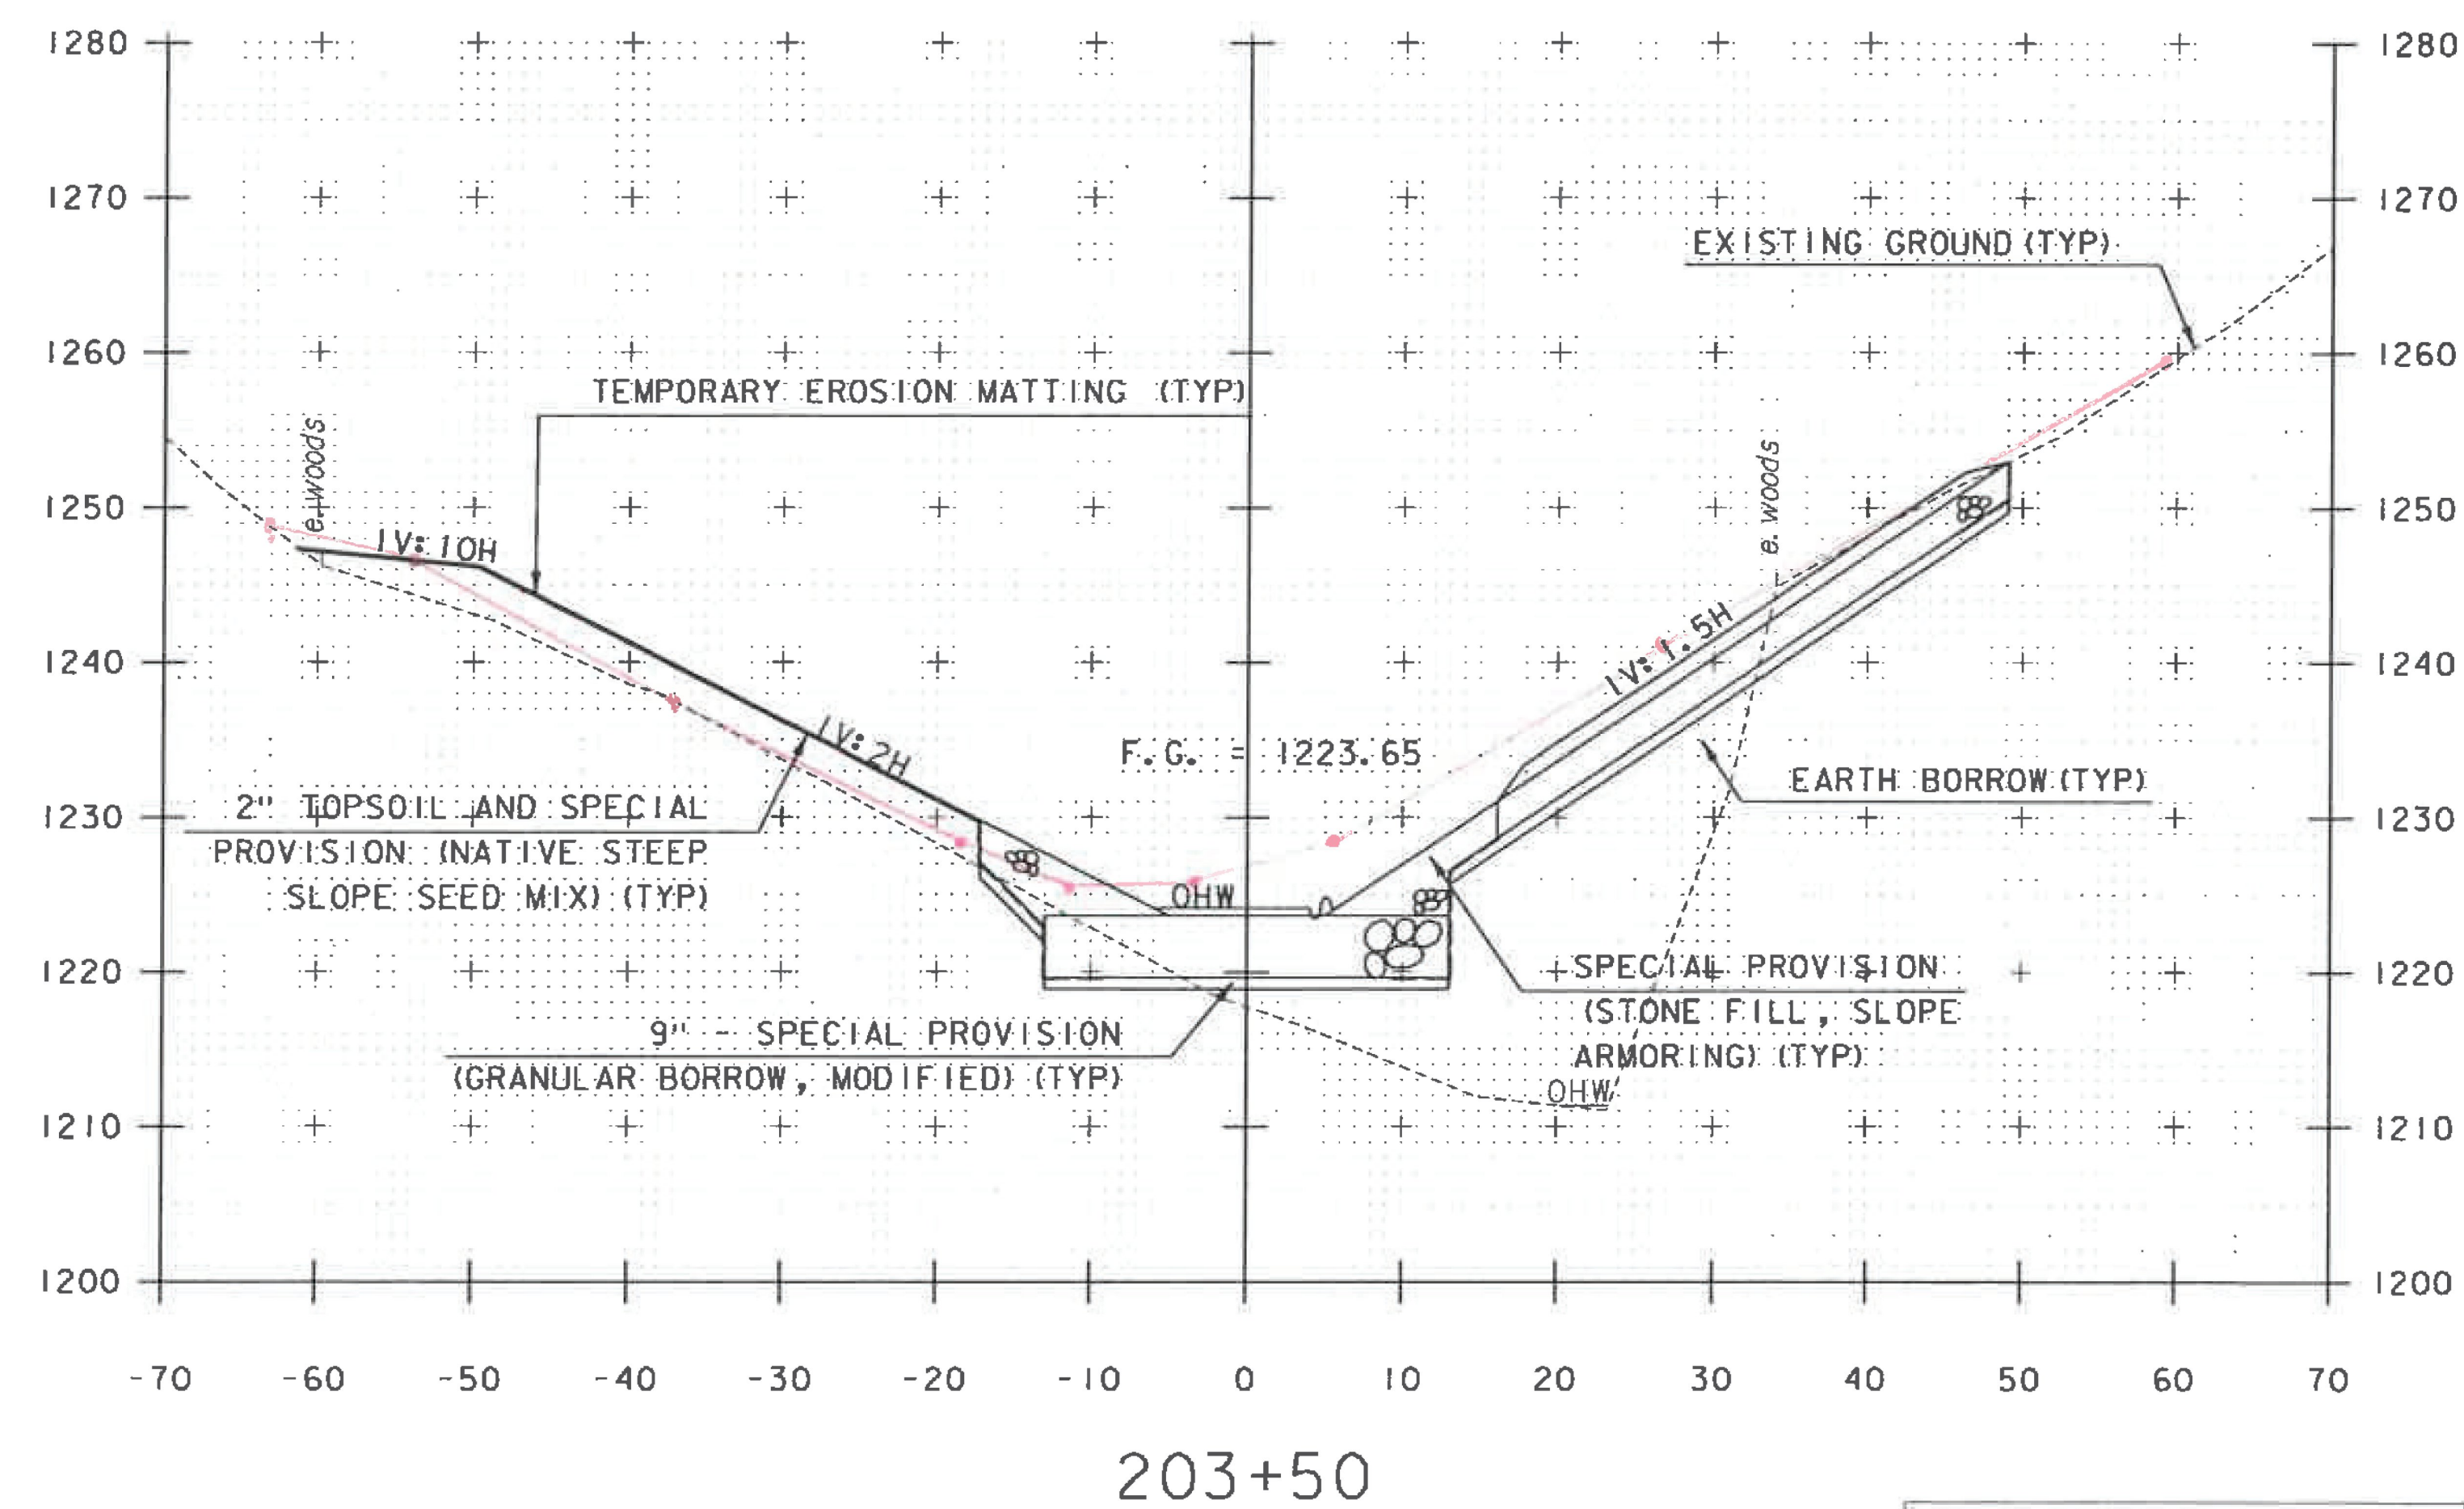


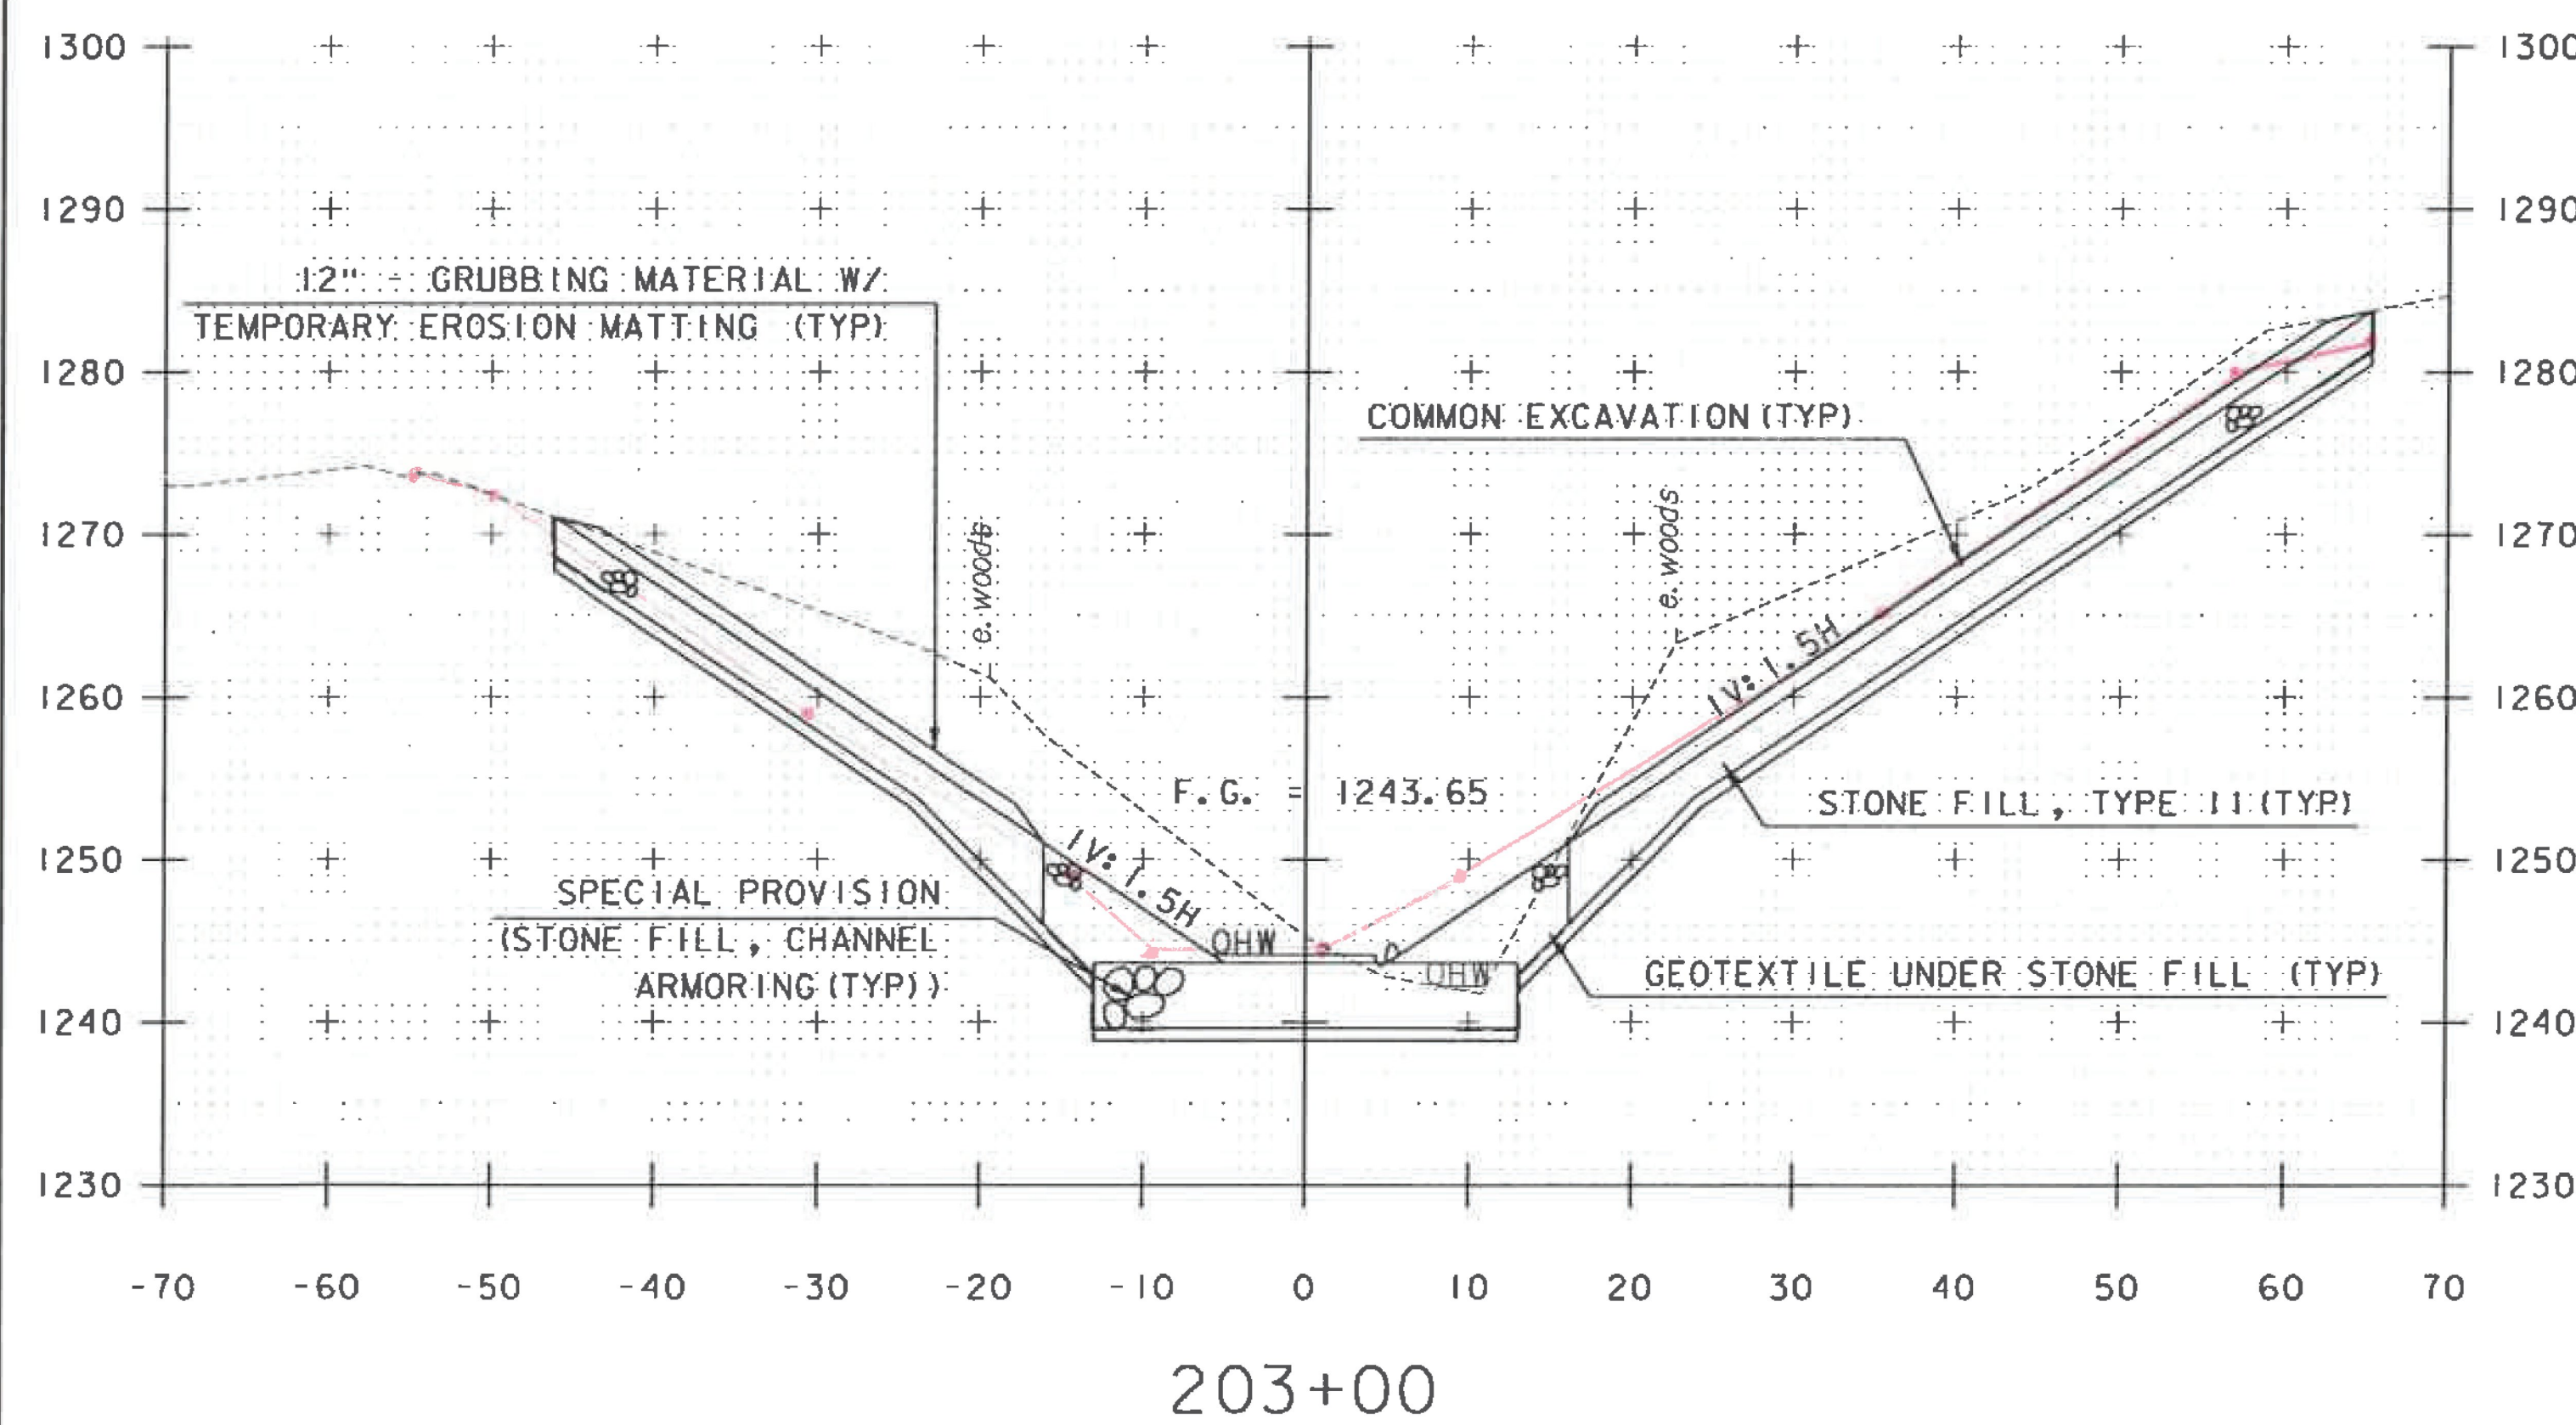

NOTE: STATIONS AND ELEVATIONS ARE IN FEET

GREEN INTERNATIONAL AFFILIATES, INC.
CIVIL AND STRUCTURAL ENGINEERS

PROJECT NAME: MENDON
PROJECT NUMBER: ER 020-2(39)
FILE NAME: z13b188xsl.dgn
PROJECT LEADER: E. ATKINS
DESIGNED BY: M. BRADLEY
CROSS SECTION SHEET 14

PLOT DATE: 11/13/2015
DRAWN BY: S. SALLA
CHECKED BY: E. ATKINS
SHEET 66 OF 72