




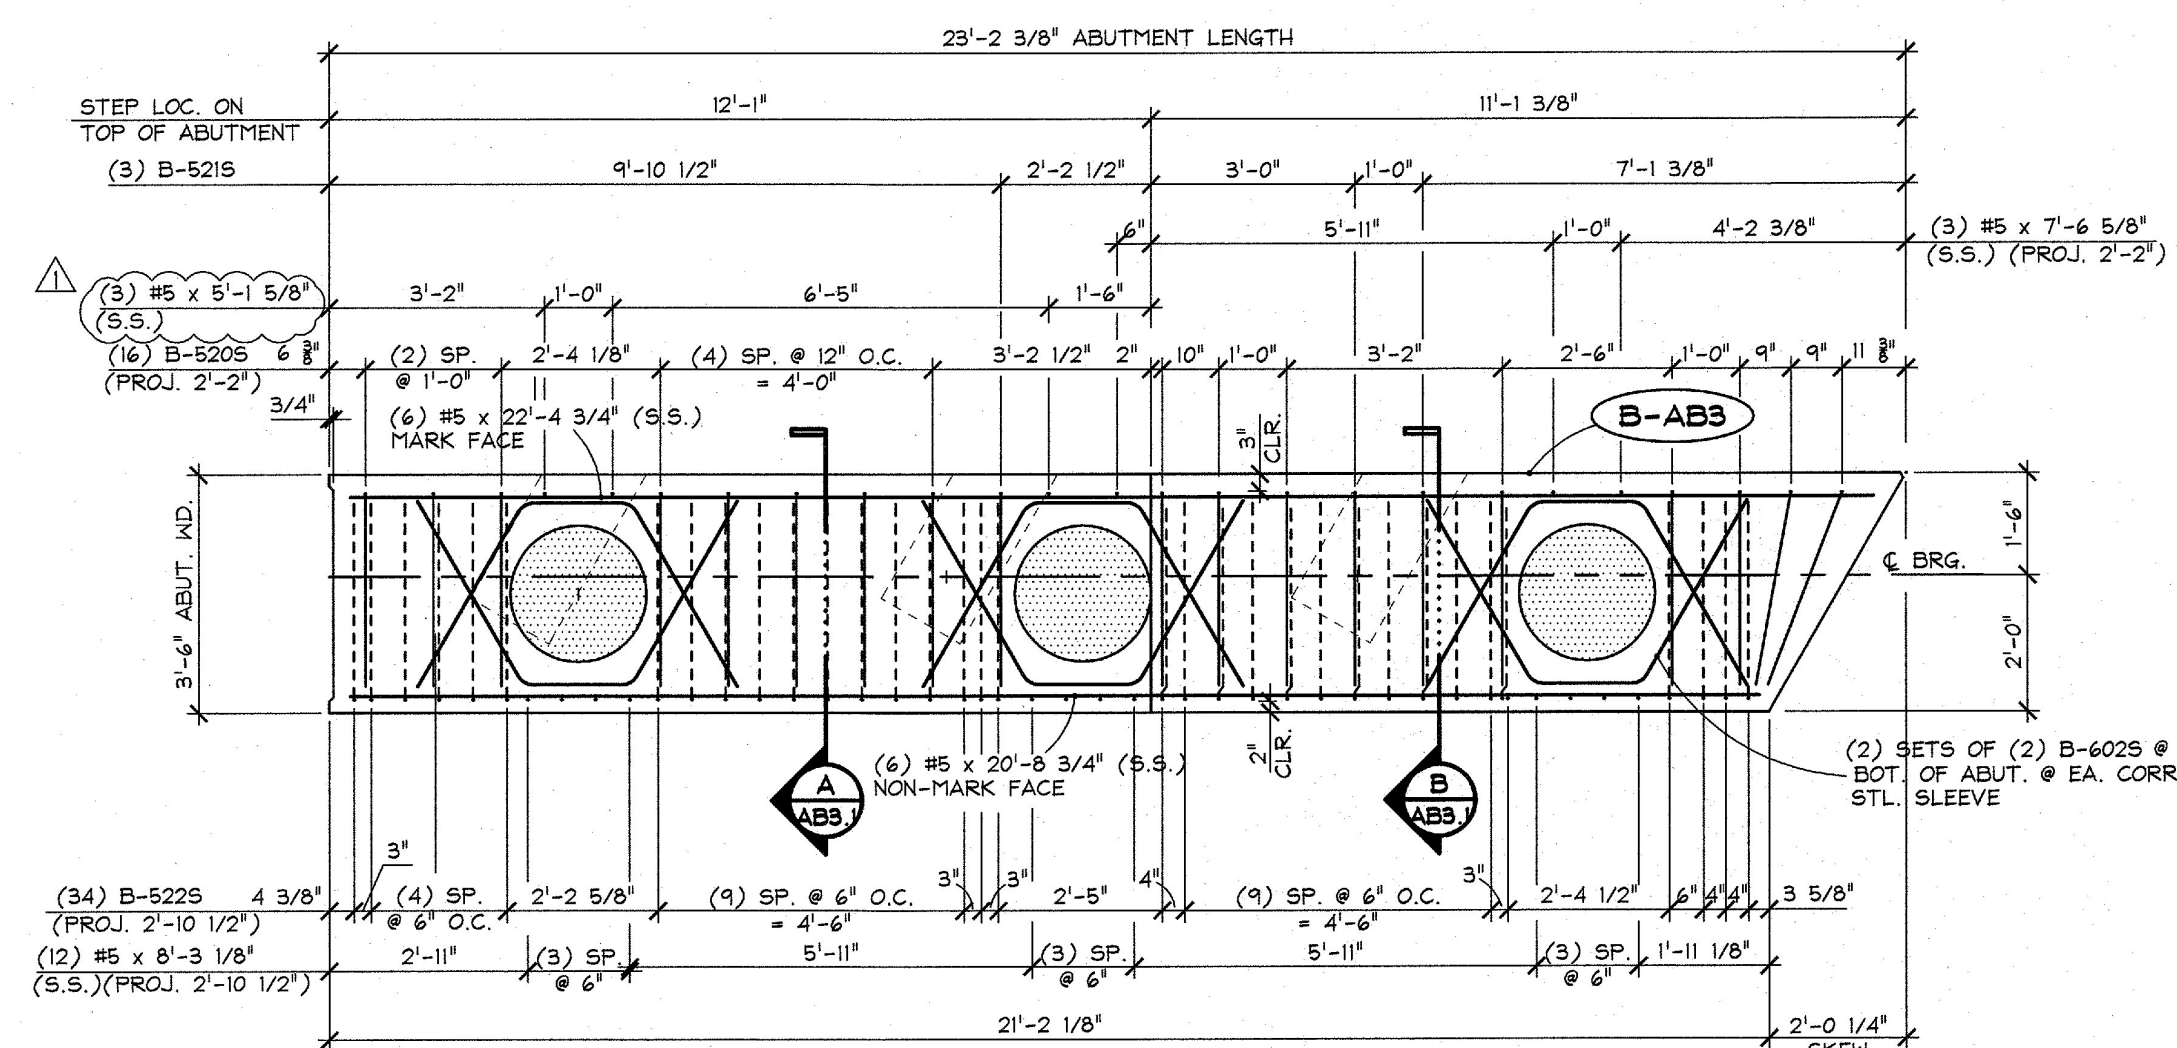


1 ABUTMENT PLAN VIEW IN FORM 'B-AB3'
AB3.1
3/8\" = 1'-0"

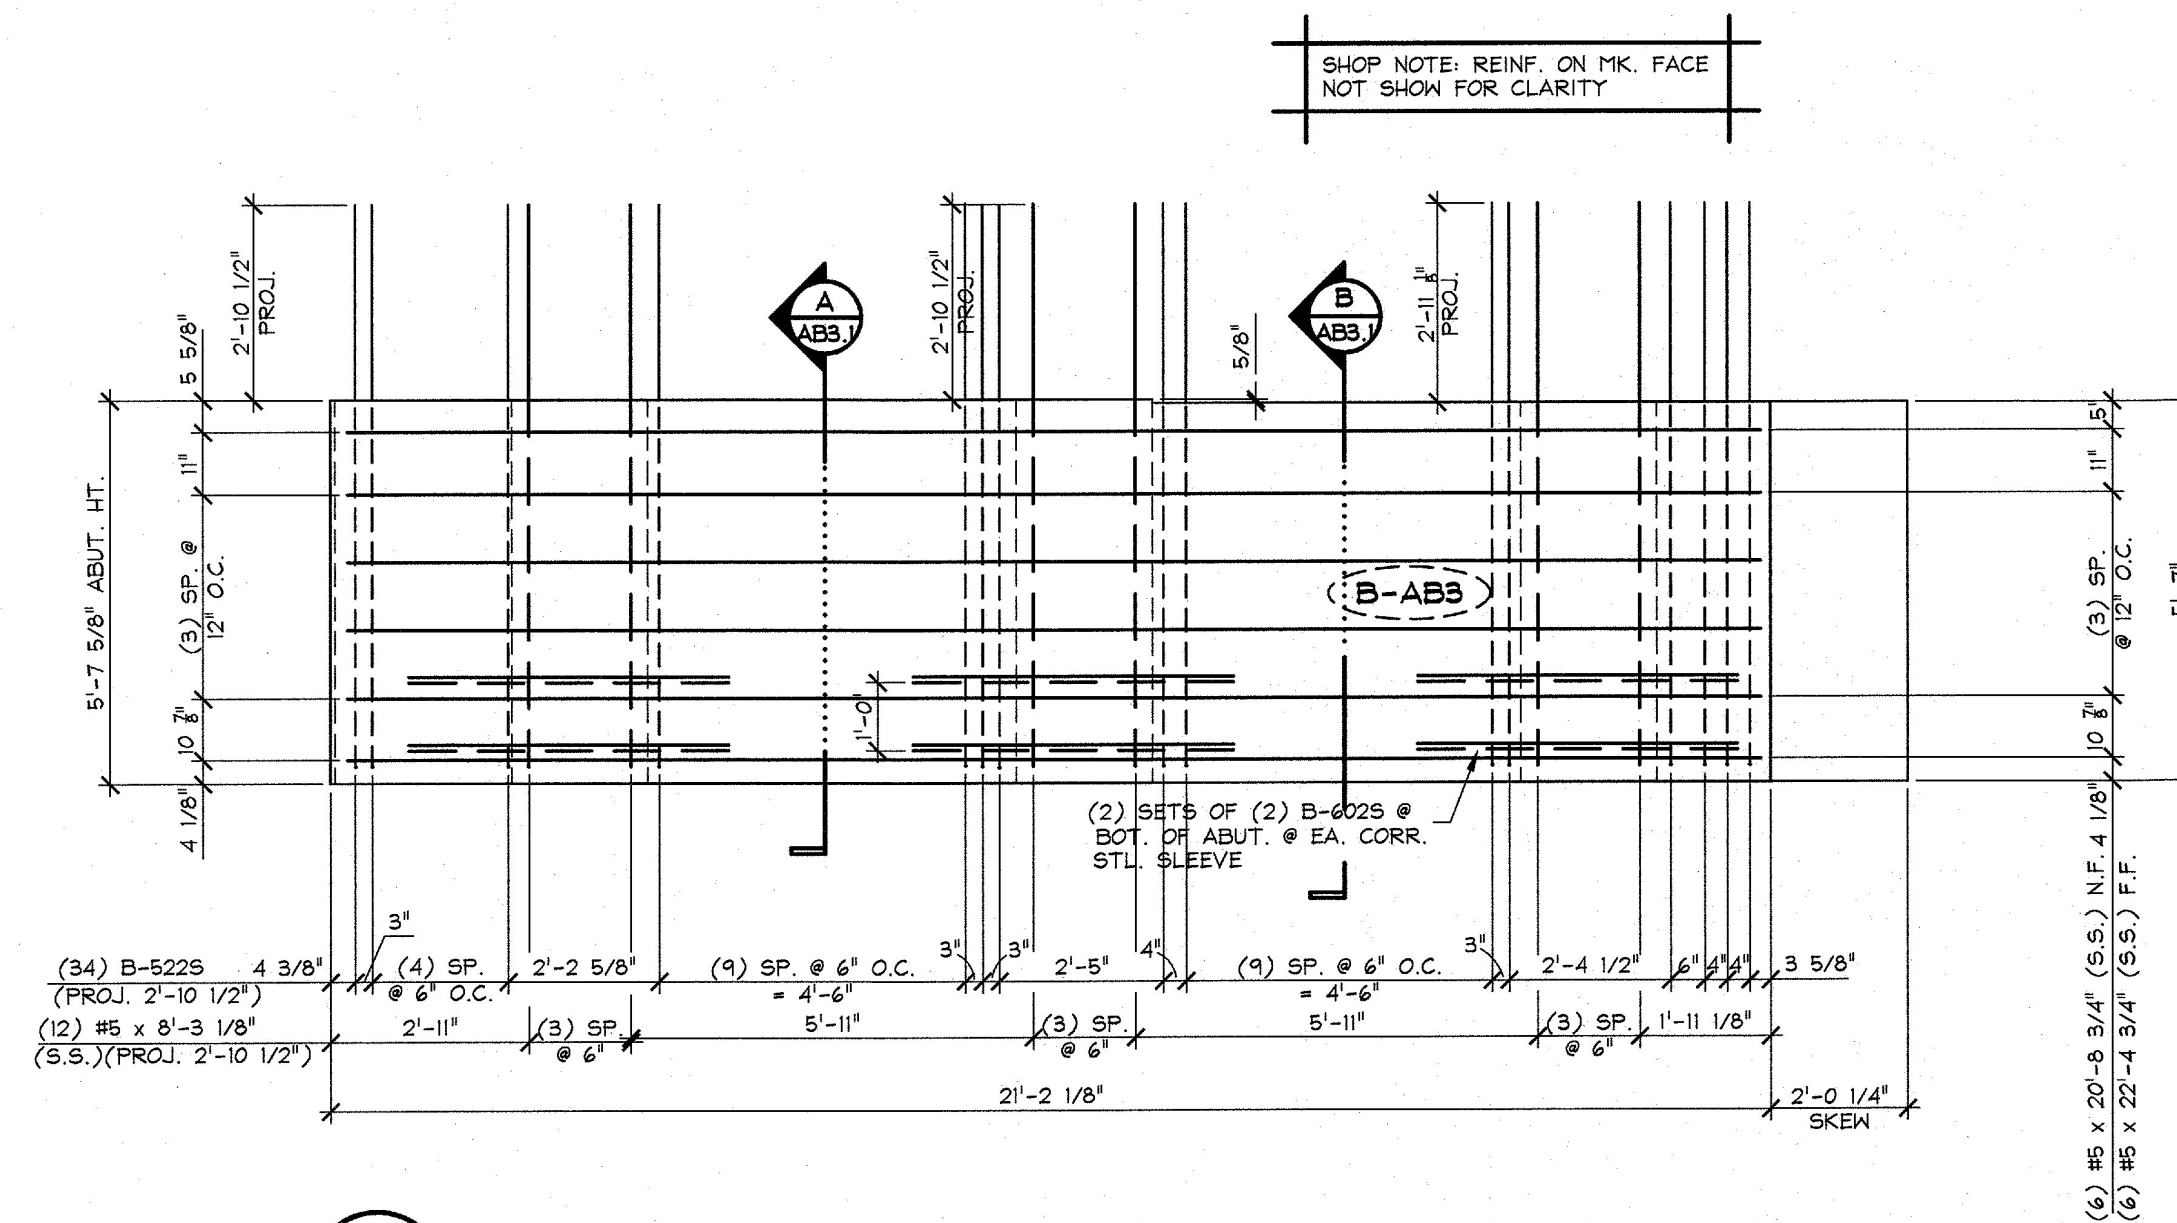

2 ABUTMENT REINF. ELEVATION - NON MARK FACE
AB3.1
3/8\" = 1'-0"

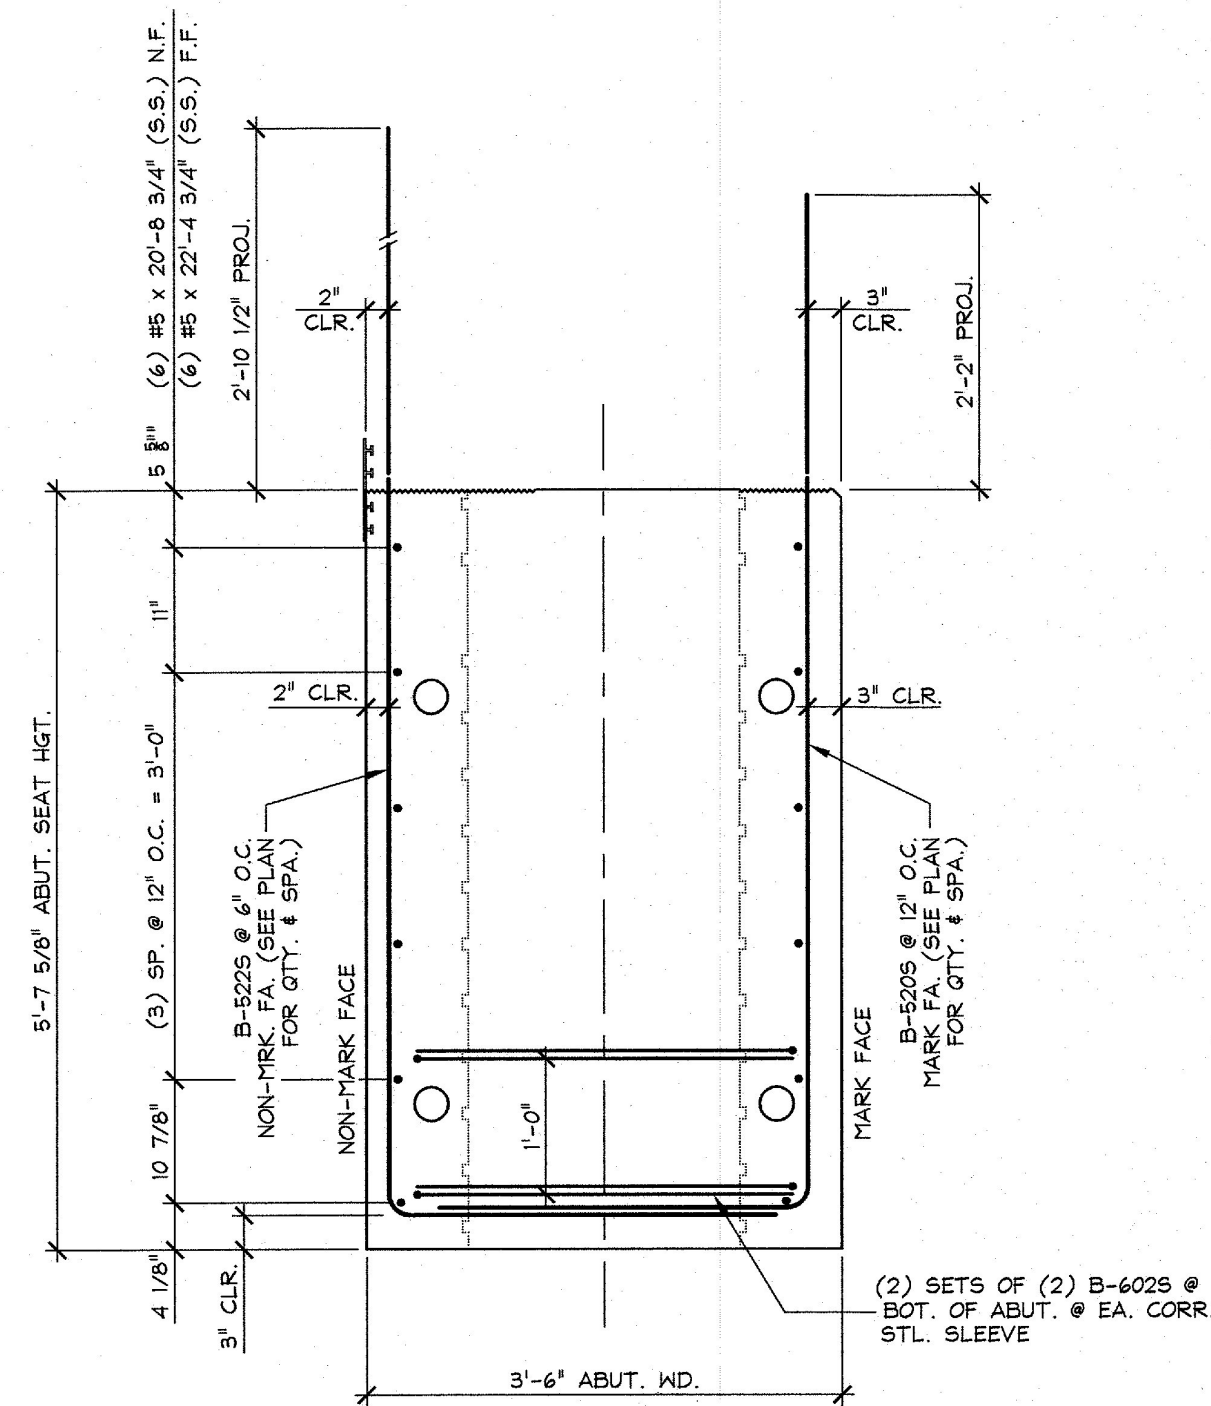

A REINFORCING SECTION
AB3.1
3/4\" = 1'-0"

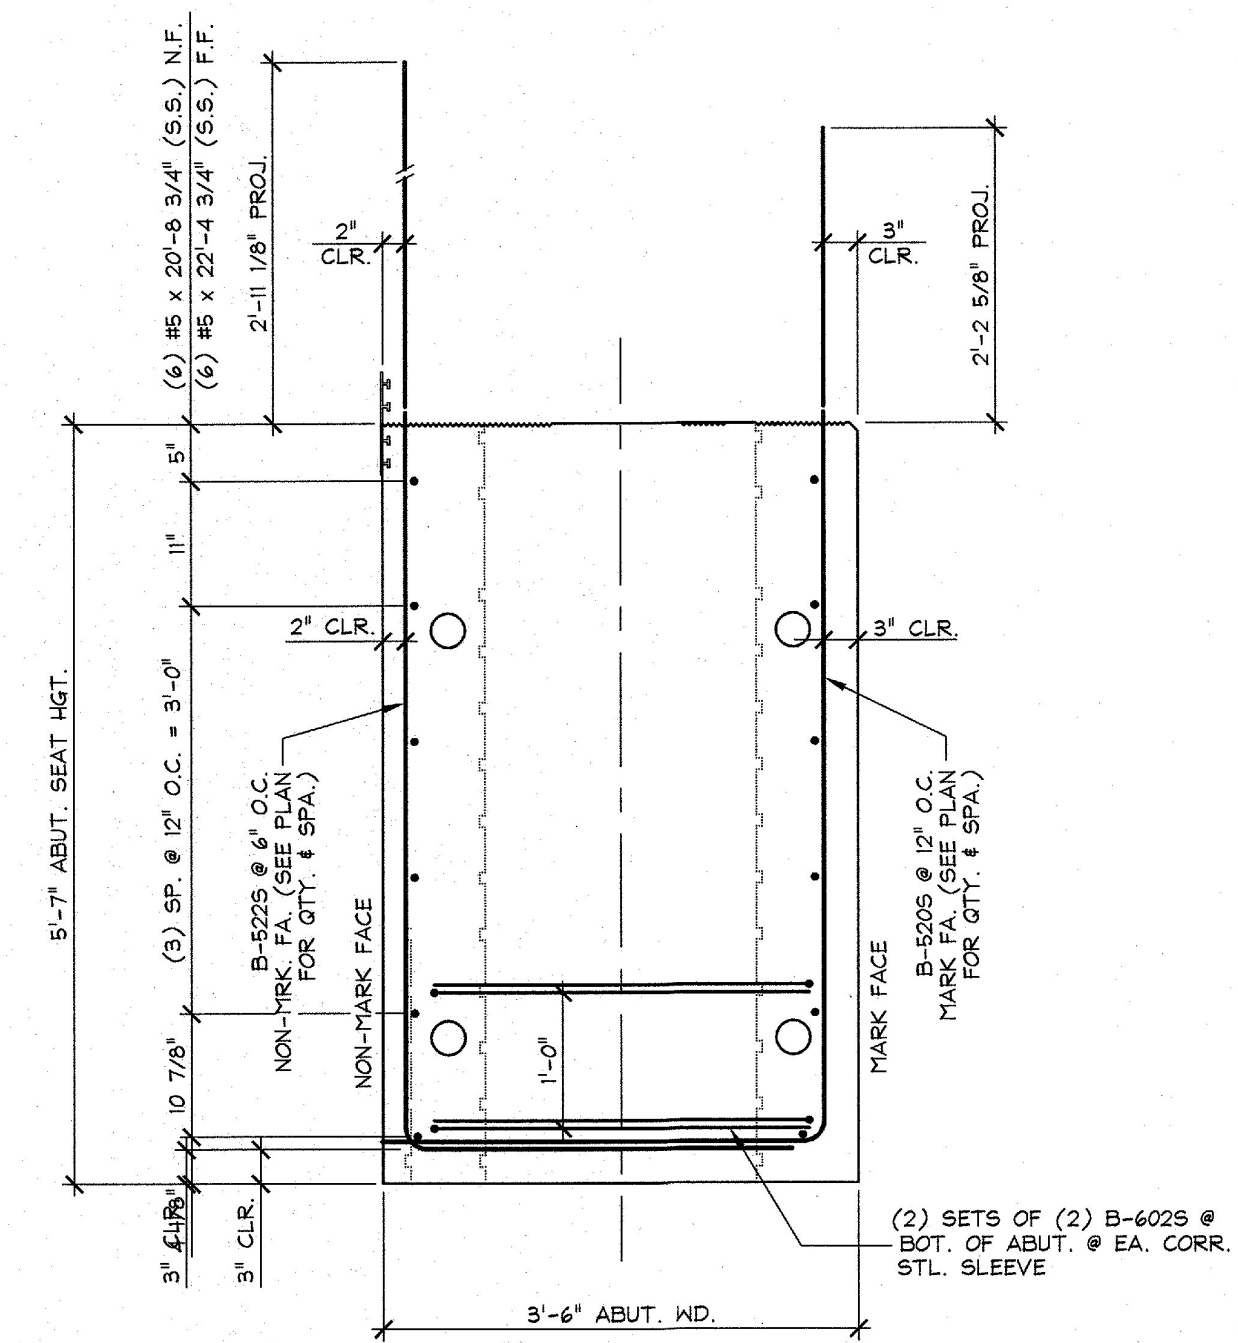

B REINFORCING SECTION
AB3.1
3/4\" = 1'-0"

MARK: B-AB3		QTY.: 1	
MATERIAL LIST / ABUTMENT			
ITEM	MARK	DESCRIPTION	QTY.
1	B-5205	#5 BENT BAR (STAINLESS STEEL)	16
2	B-5215	#5 BENT BAR (STAINLESS STEEL)	3
3	B-5225	#5 BENT BAR (STAINLESS STEEL)	34
4			
5			
6			
7			
8			
9			
10			
11	B-6025	#6 BENT BAR (STAINLESS STEEL)	12
12			
13		#5 x 5'-1 5/8" (STAINLESS STEEL)	1 
14		#5 x 8'-3 1/8" (STAINLESS STEEL)	12
15		#5 x 7'-6 5/8" (STAINLESS STEEL)	3
16			
17			
18			
19			
20		#5 x 20'-8 3/4" (STAINLESS STEEL)	6
21		#5 x 22'-4 3/4" (STAINLESS STEEL)	6
22			

Vermont Agency of Transportation

RECEIVED

CK'D BY OK'D BY G. ROY

March 14, 2017

RESUBMIT NO Approved
BY C. CARLSON DATE 03/15/2017

2/24/17 REVISED AS PER ENGINEERS COMM. T.D.

APPROVAL STAMP:

J.P. CARRARA & SONS INC.

Precast & Prestress Manufacturer

2464 GAGE ST., MIDDLEBURY, VERMONT 05753 Phone: (802) 398-6361 Fax: (802) 398-9010

STATE OF VERMONT AGENCY OF TRANSPORTATION
COUNTY OF ORANGE

TOWN OF BRADFORD
VT 25B (RURAL MAJOR COLLECTOR)
BRIDGE NO.: 1 PROJECT NO.: BF 0191 (29)

PRECAST ABUTMENT 'B-AB3'
REINFORCING DETAILS

A.L. ST. ONGE
CONTRACTOR
MONTGOMERY, VERMONT

DATE: DEC. 21, 2016

SCALE: NOTED

CHKD: DFTM: T.D.

JOB NO: 23506-016

DWG. NO: AB3.1