

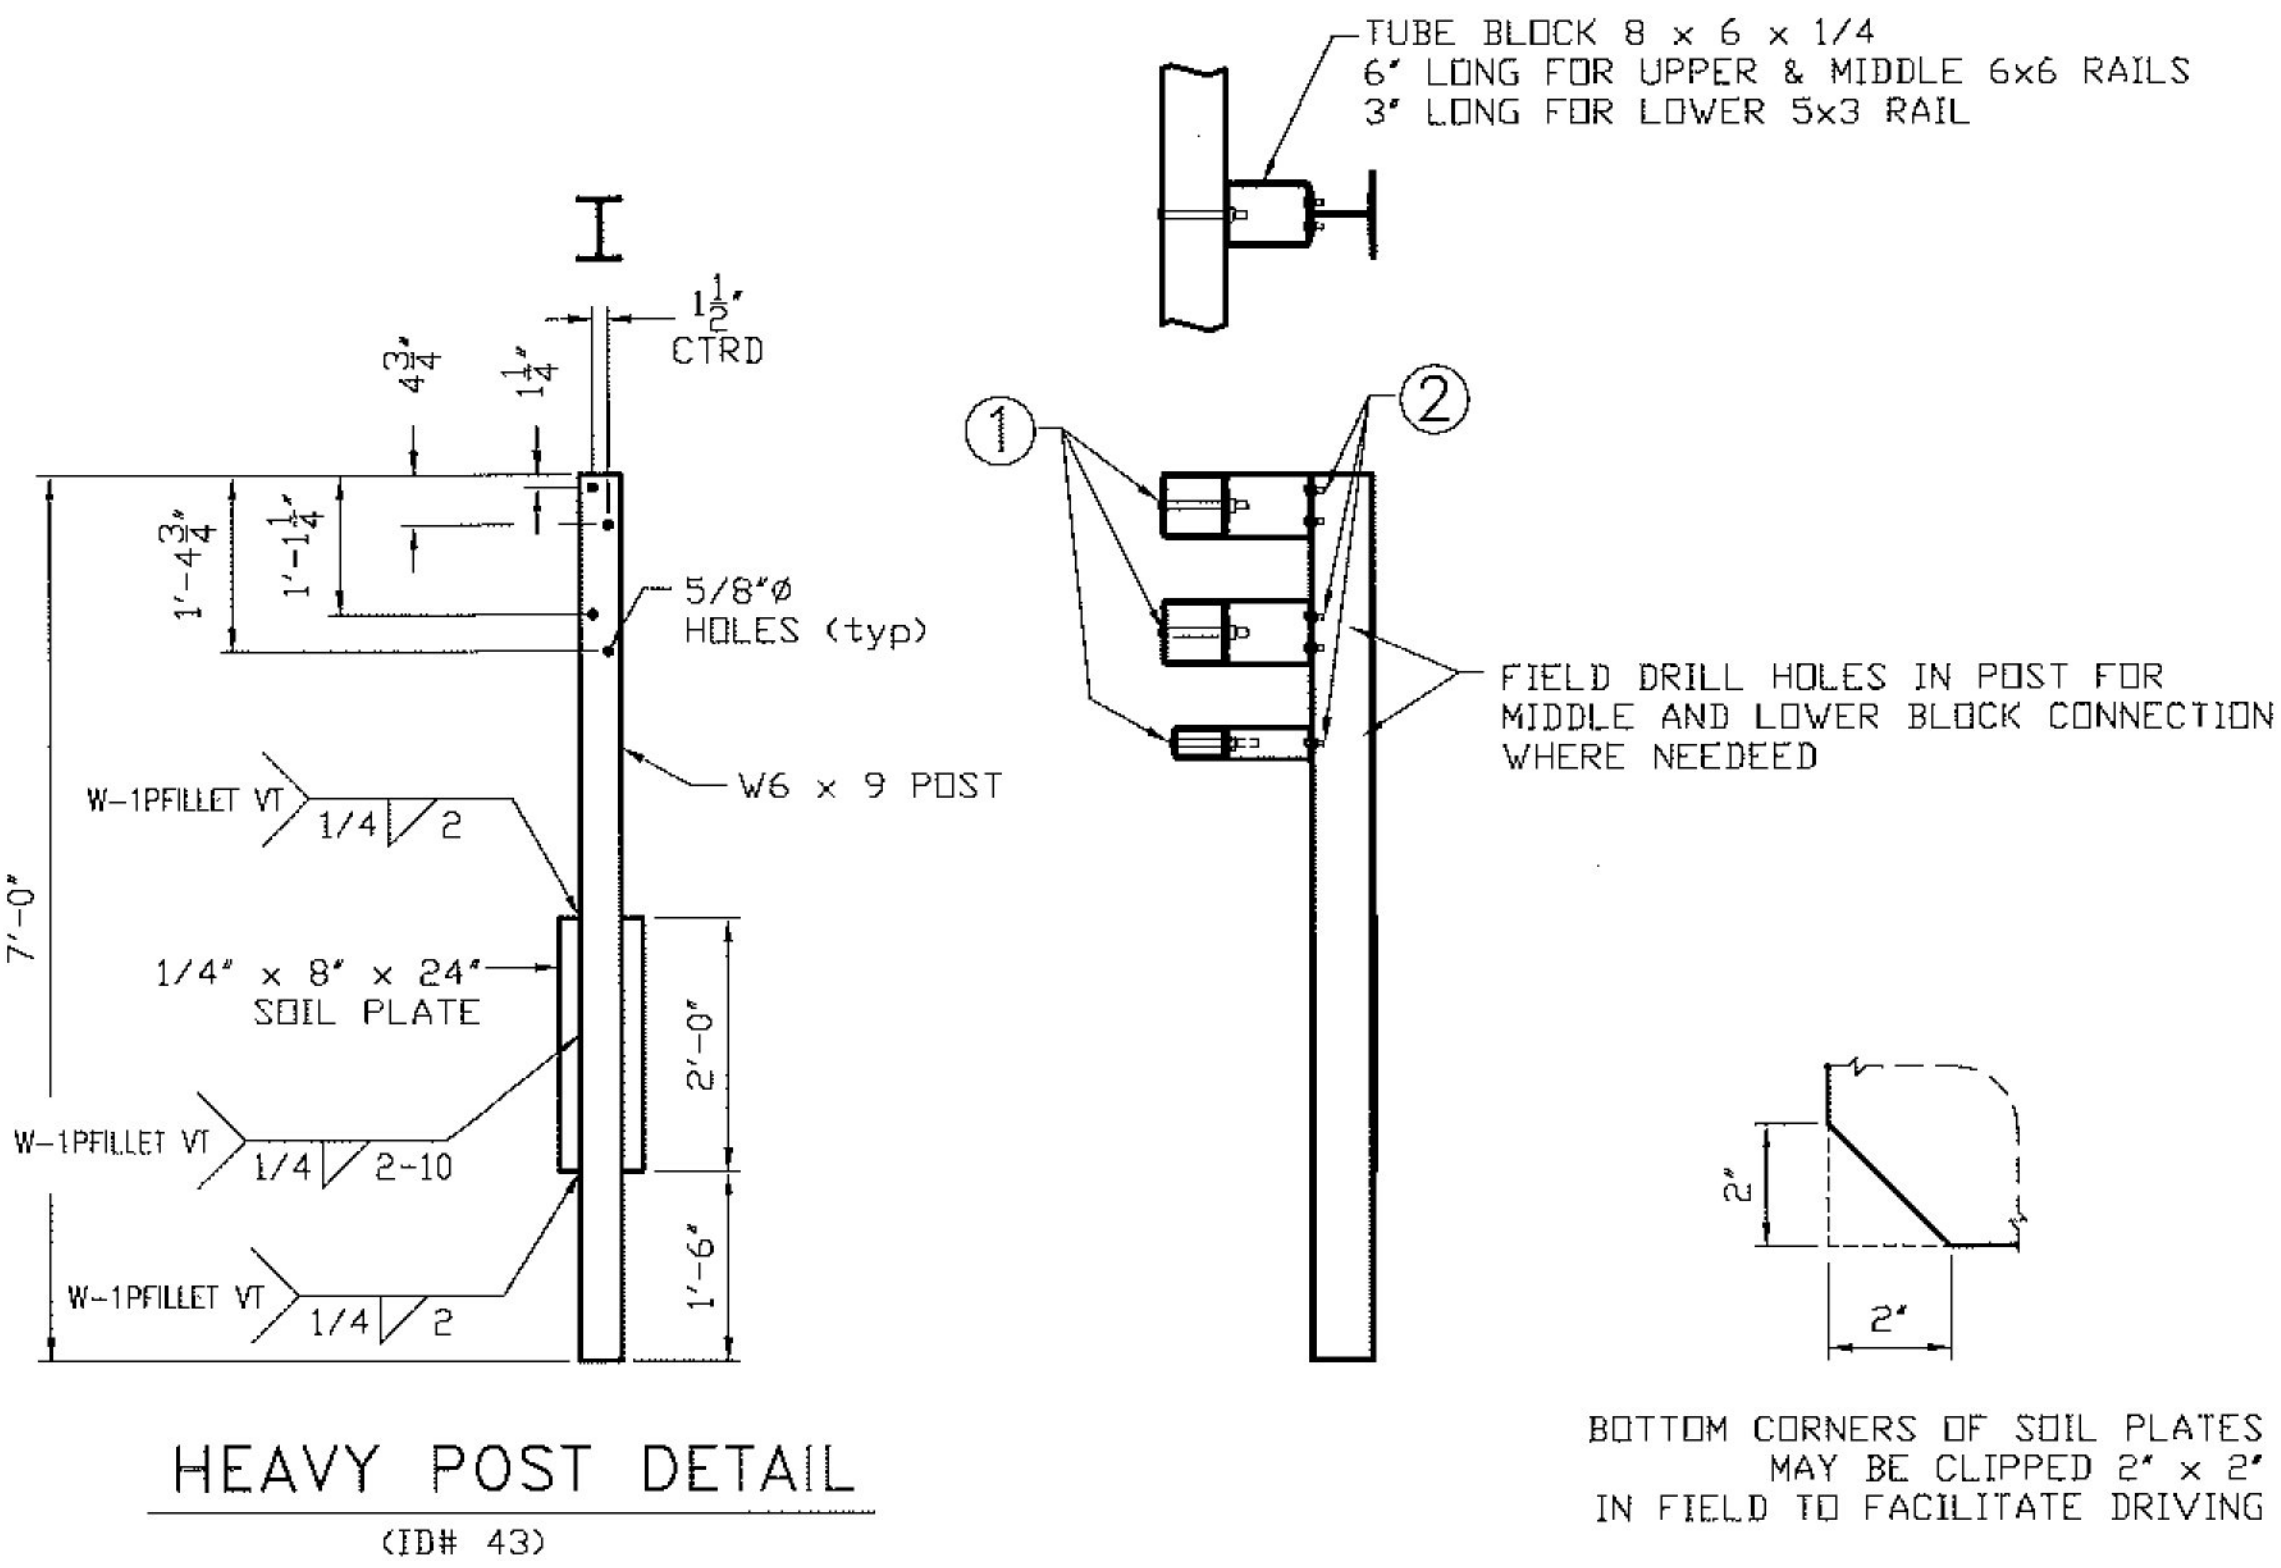
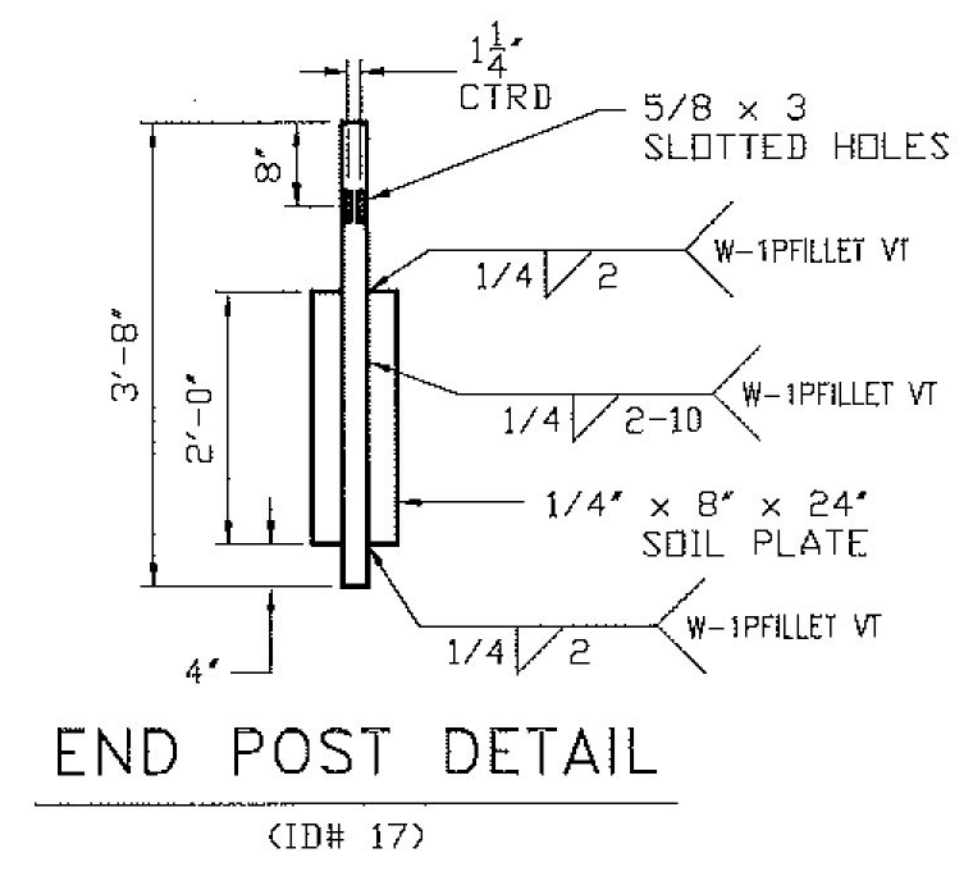
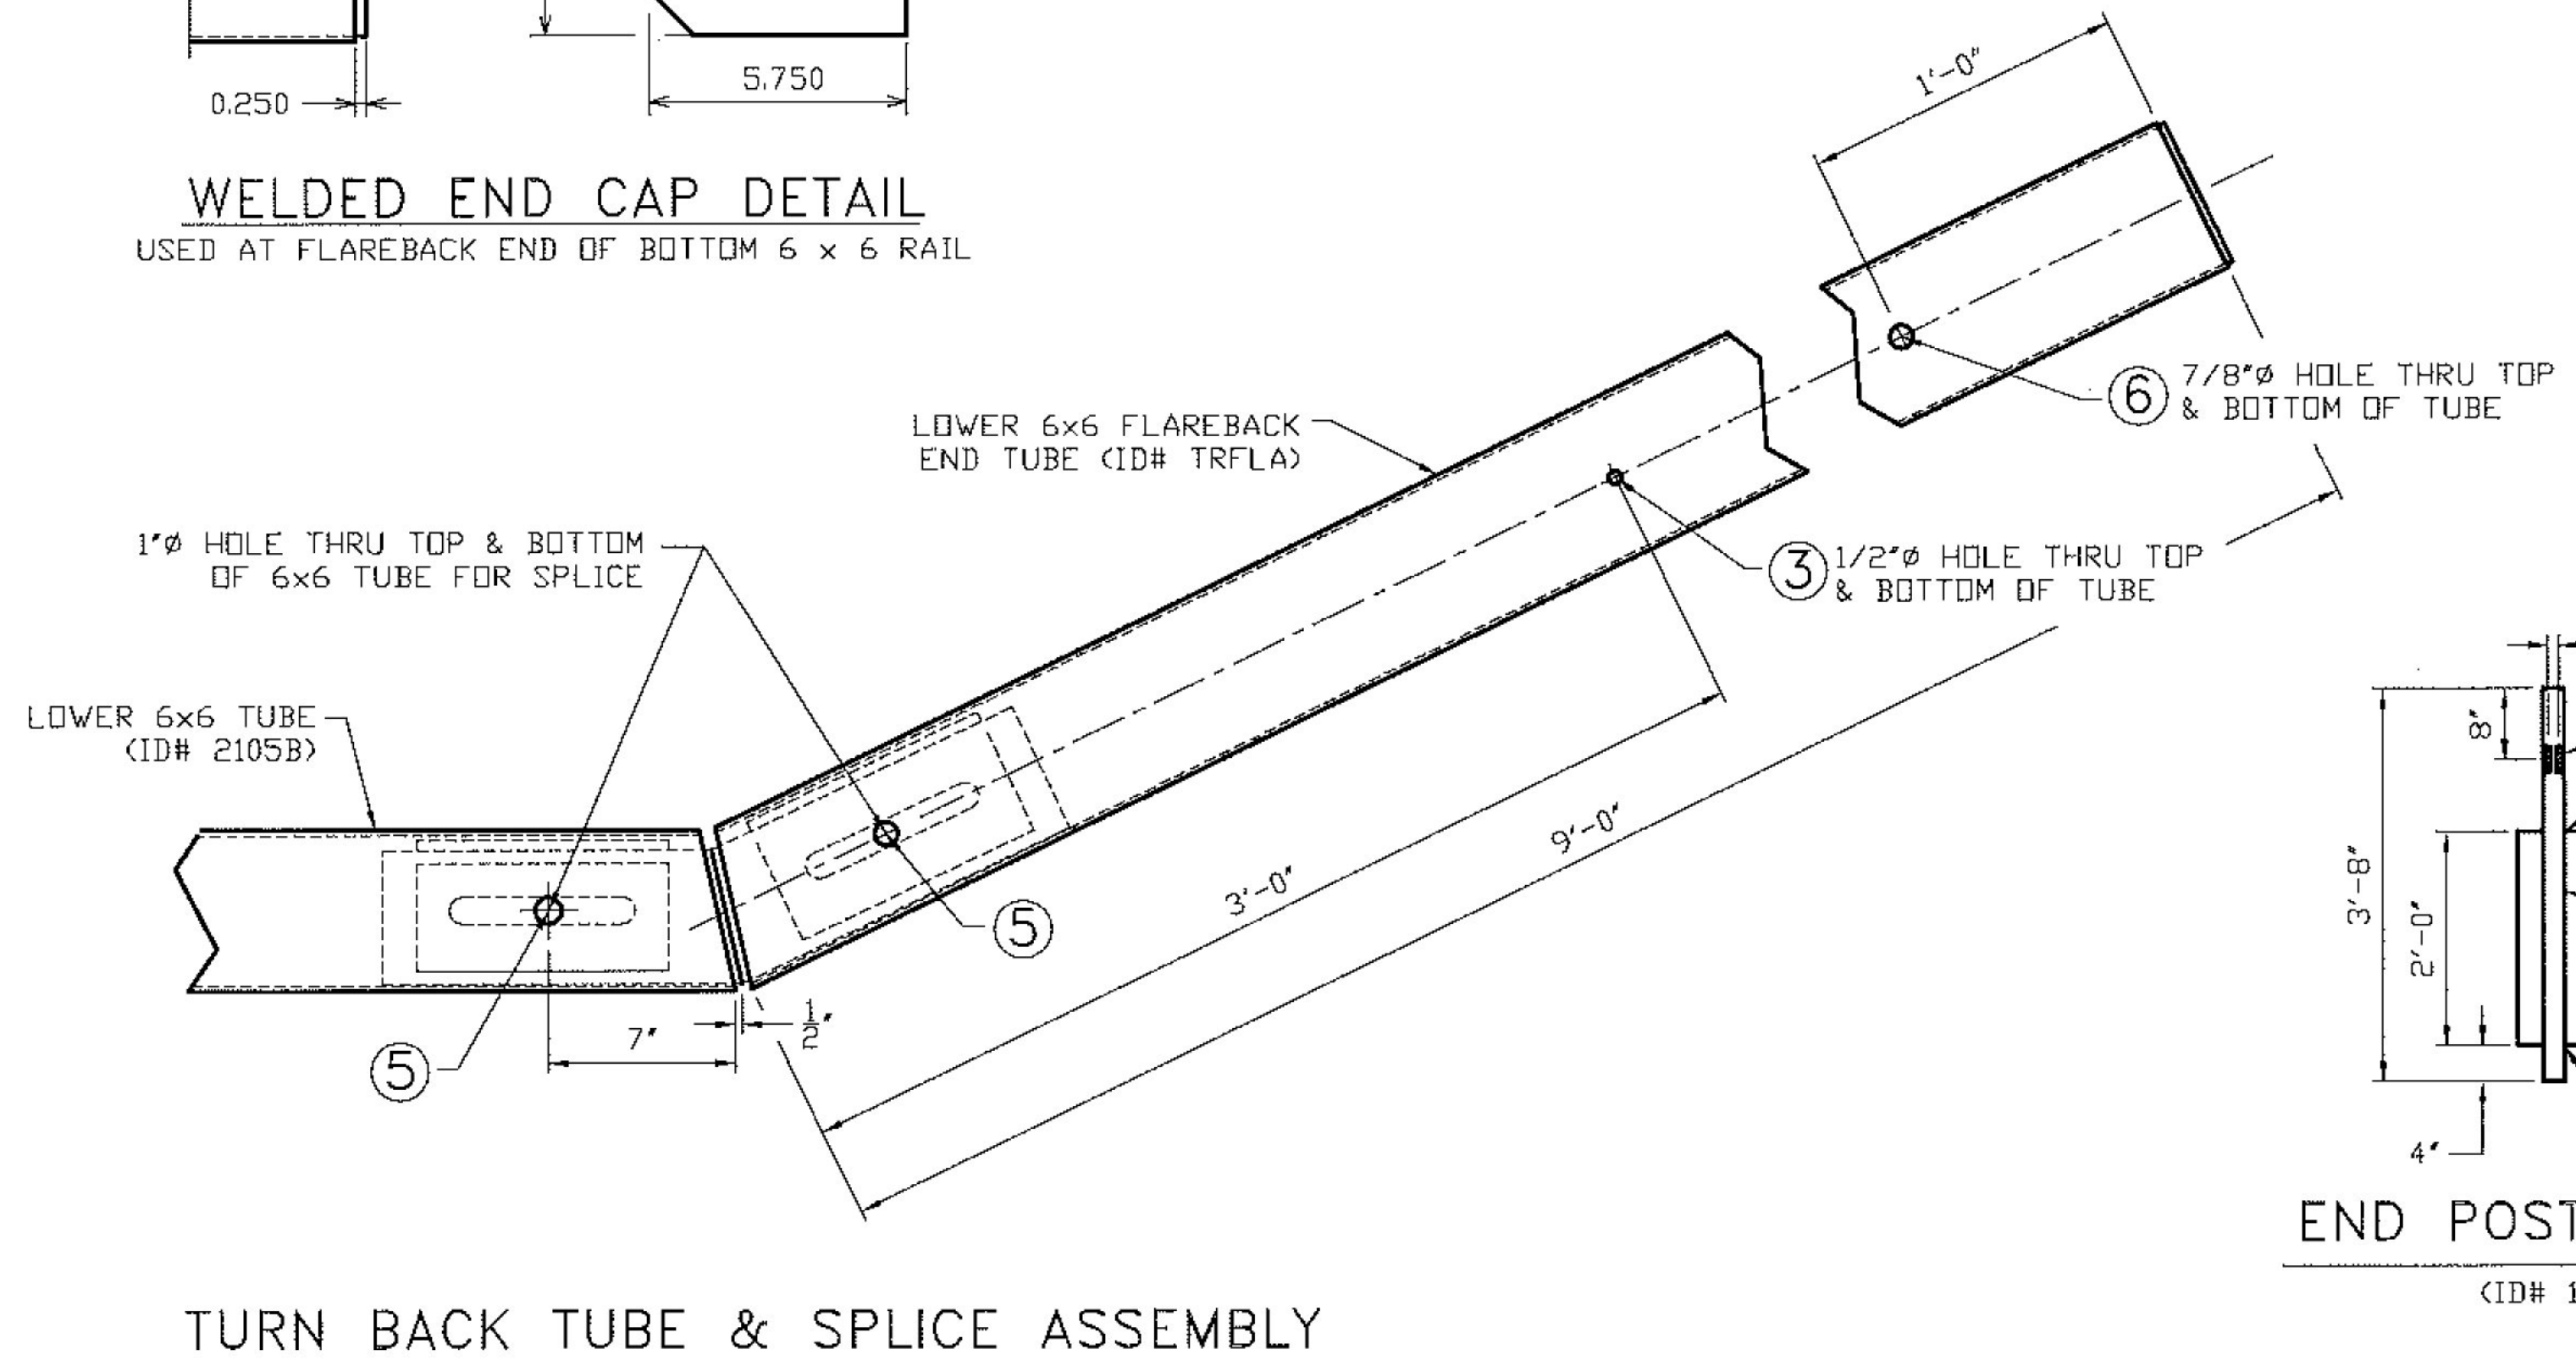
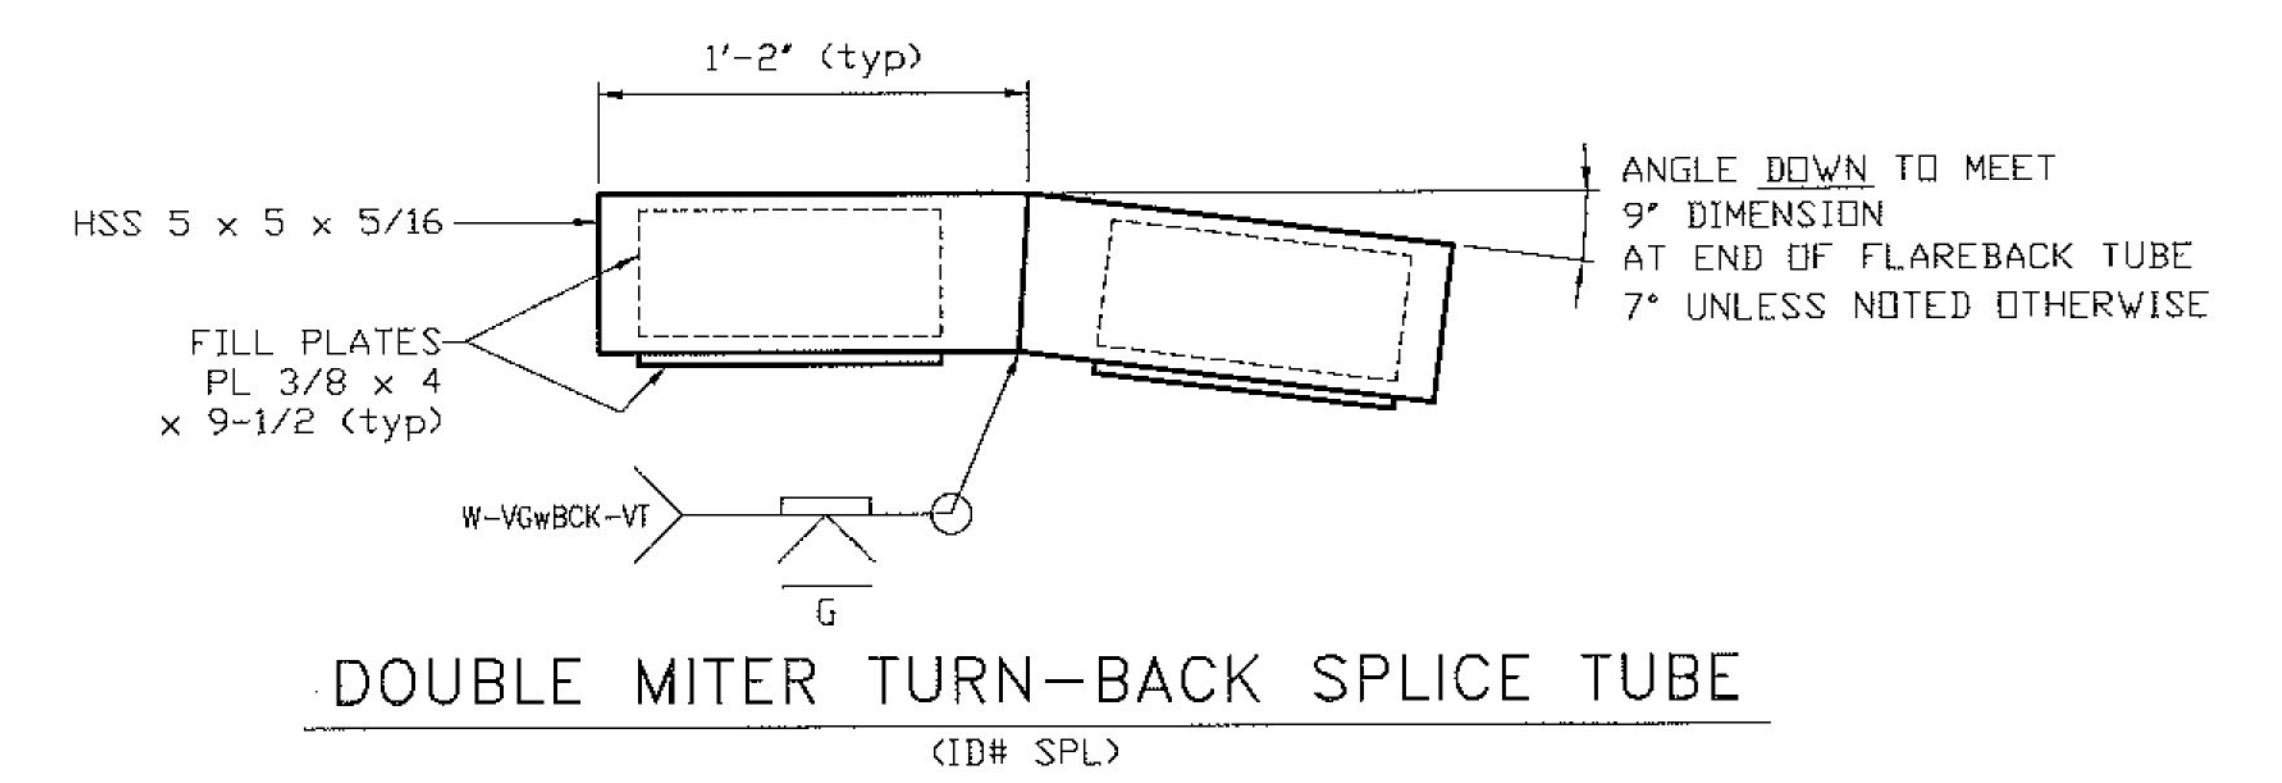
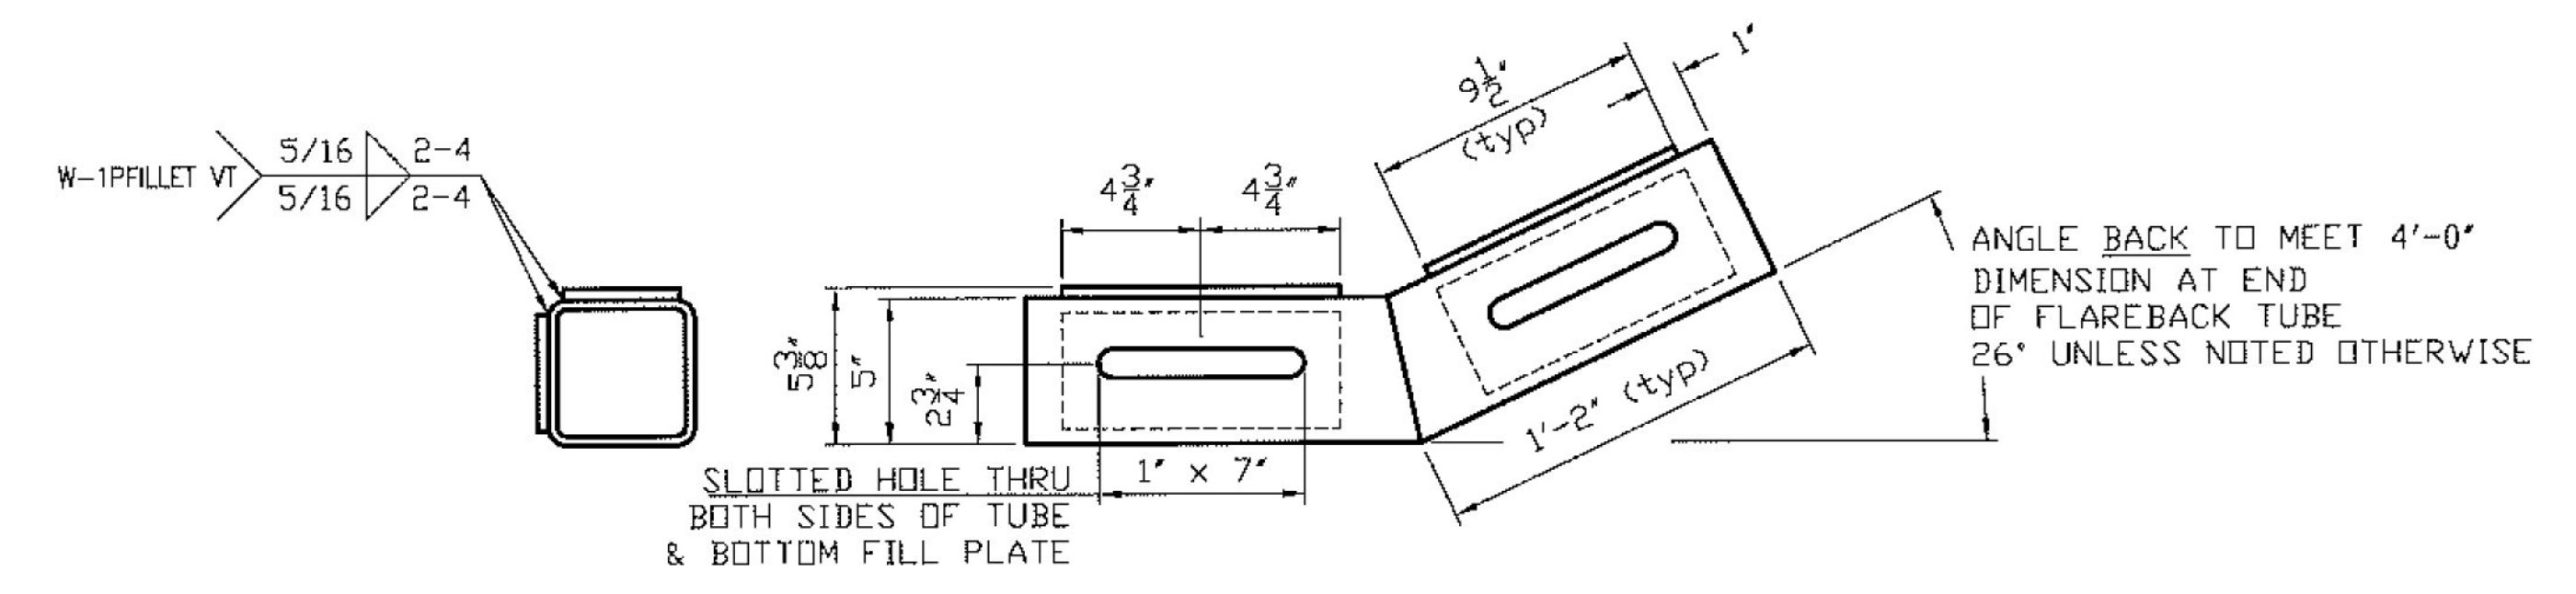
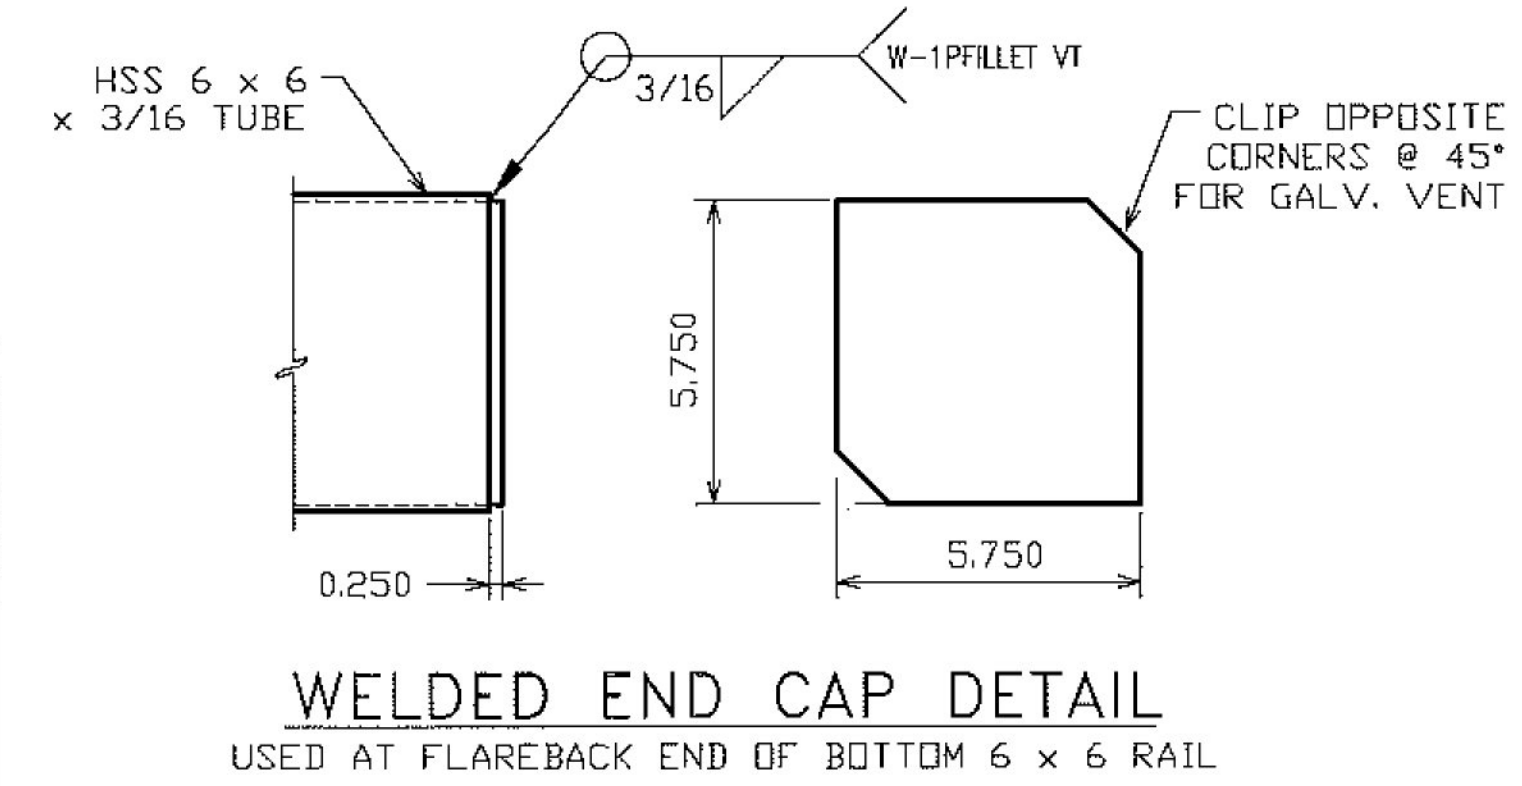


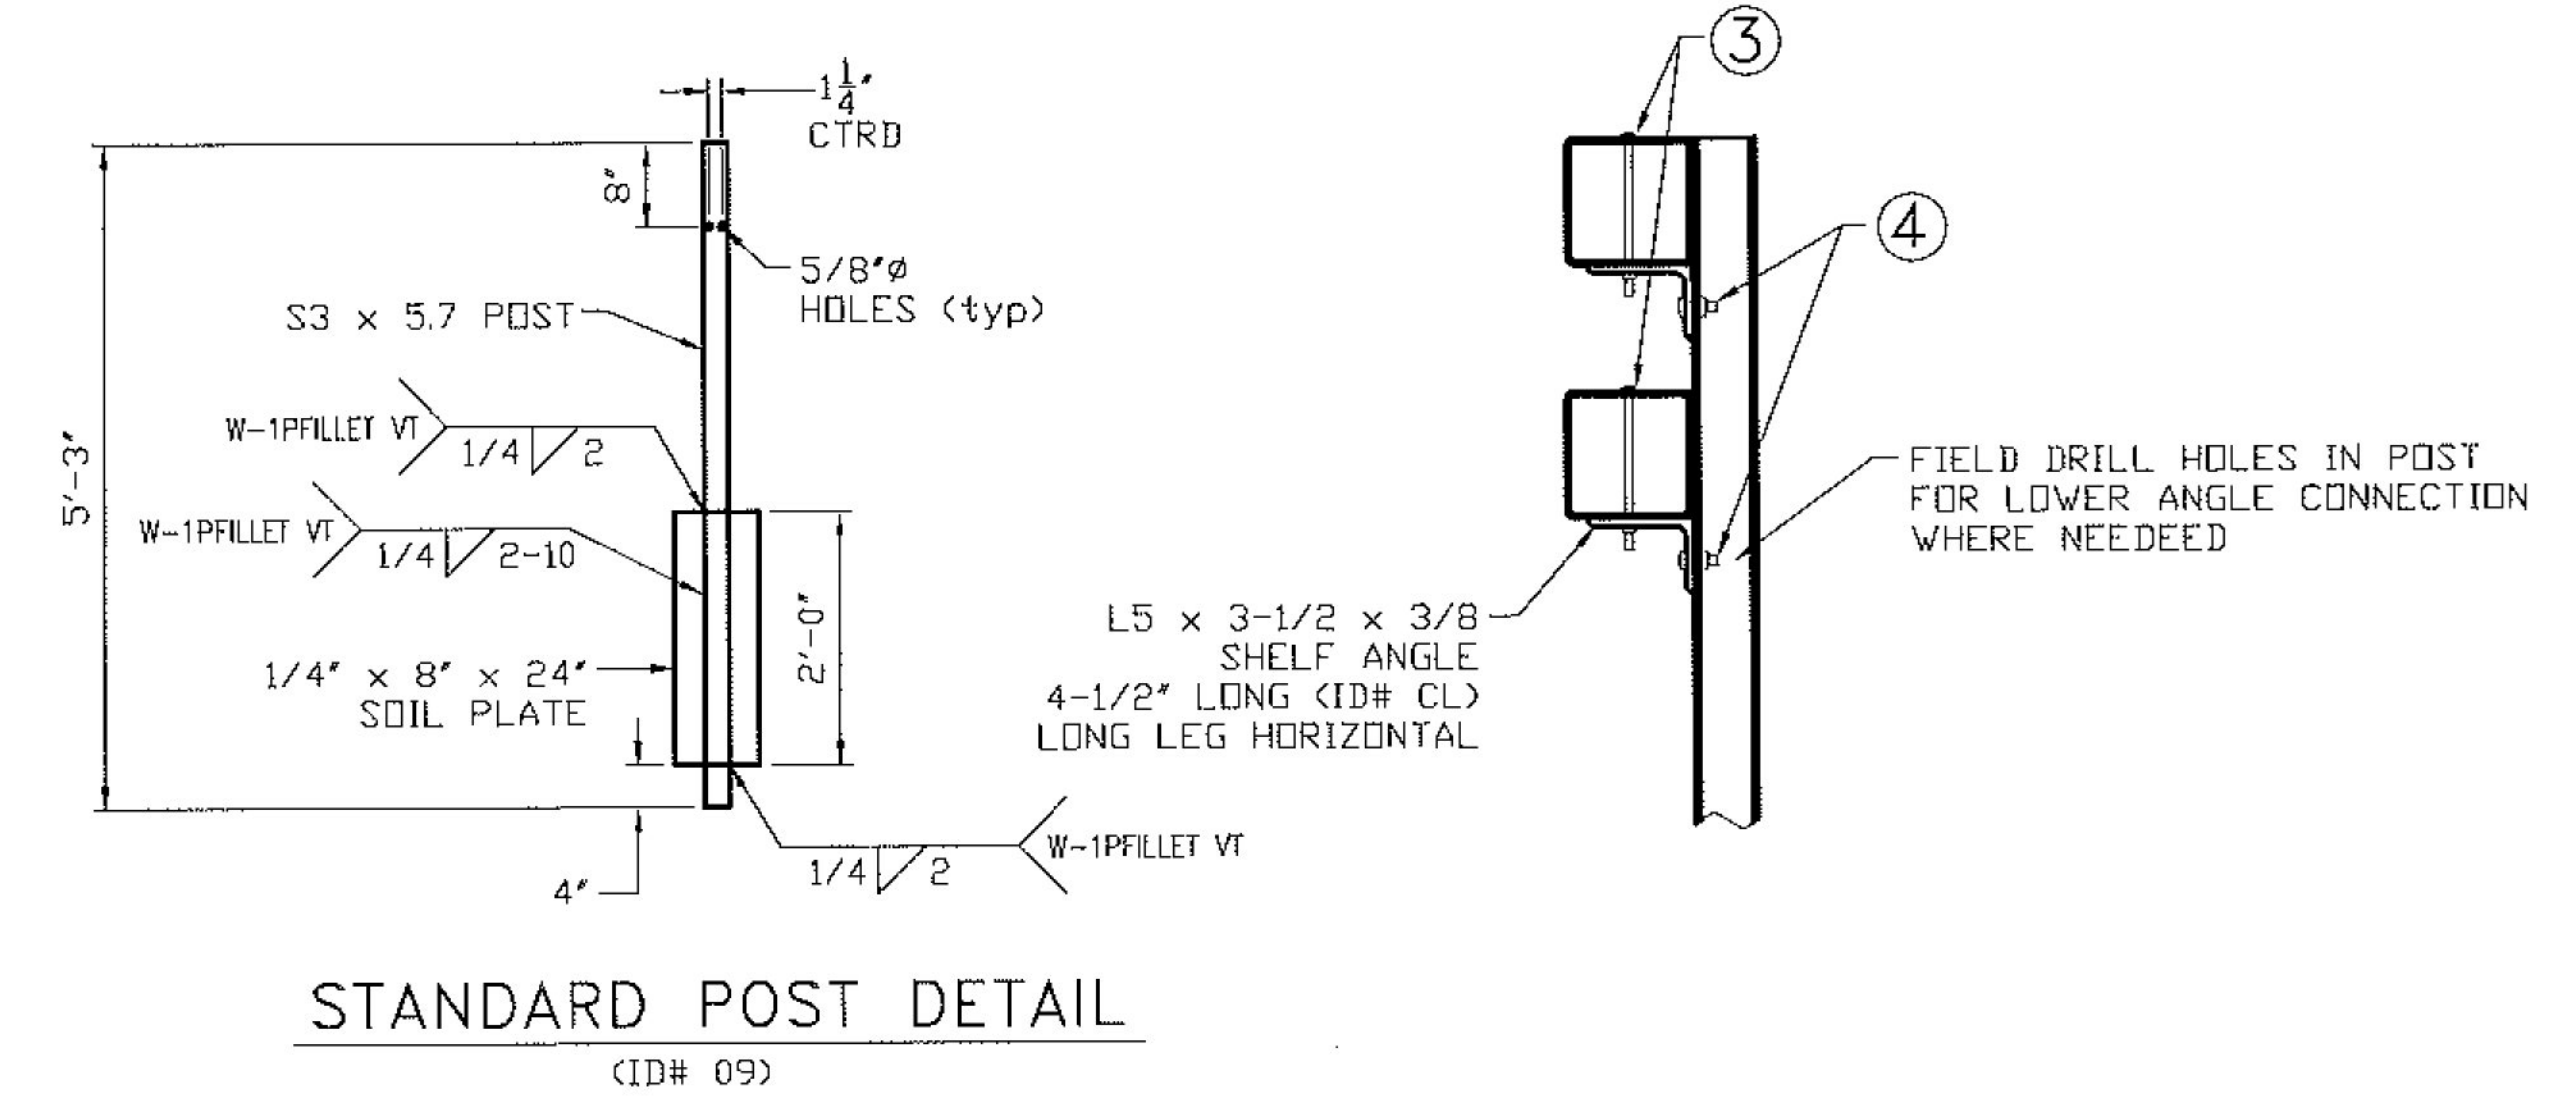

REFER TO VADT STD G-16 FOR TYPICAL BOX BEAM COMPONENT AND CONNECTION DETAILS NOT SHOWN HERE

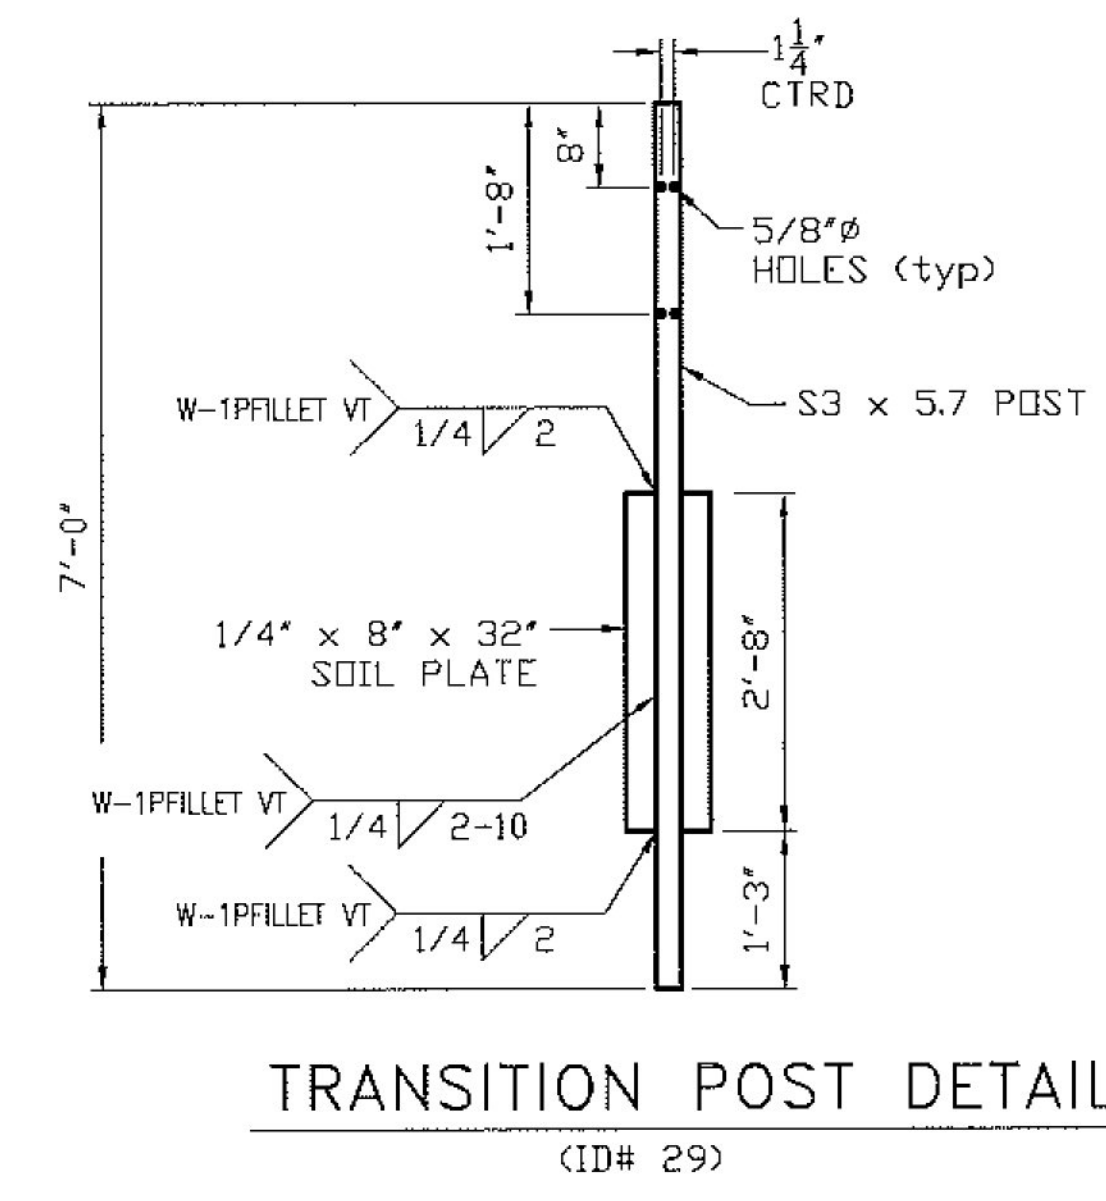

Vermont Agency of Transportation

RECEIVED

CK'D BY G. ROY OK'D BY S. FAGAN

February 17, 2017

RESUBMIT NO Approved

BY C. CARLSON DATE 02/24/2017

HIGHWAY SAFETY CORP

GLASTONBURY, CT
860-633-9445

ITEM 525.335 BRIDGE RAIL, GALVANIZED, 3 RAIL BOX BEAM
ITEM 621.725 GUARDRAIL APPROACH, GALVANIZED, 3 RAIL BOX BEAM
RT. VT 25B BRIDGE NO. 1 OVER WAITS RIVER
TOWN OF BRADFORD ORANGE COUNTY, VT
BF 0191 (29)

GENERAL CONTRACTOR

SUB CONTRACTOR VT REC.

DRAWN PAR CHECKED DATE 01-24-17 SCALE NONE SIZE D

CERTIFIED FABRICATOR

HSC JOB NO. 2155

SHEET NO. 6 of 6