

STATE OF VERMONT
AGENCY OF TRANSPORTATION



PROPOSED IMPROVEMENT
BRIDGE PROJECT


TOWN OF RICHMOND
COUNTY OF CHITTENDEN

ROUTE NO : US ROUTE 2, RURAL MAJOR COLLECTOR. BRIDGE #32

PROJECT LOCATION: 4.2 MILES EAST OF THE JUNCTION OF US ROUTE 2 AND VT ROUTE 117

PROJECT DESCRIPTION: REPLACEMENT OF THE EXISTING BRIDGE 32 INCLUDING APPROACH WORK


LENGTH OF STRUCTURE: 28.73 FEET
LENGTH OF ROADWAY: 321.27 FEET
LENGTH OF PROJECT: 350.00 FEET

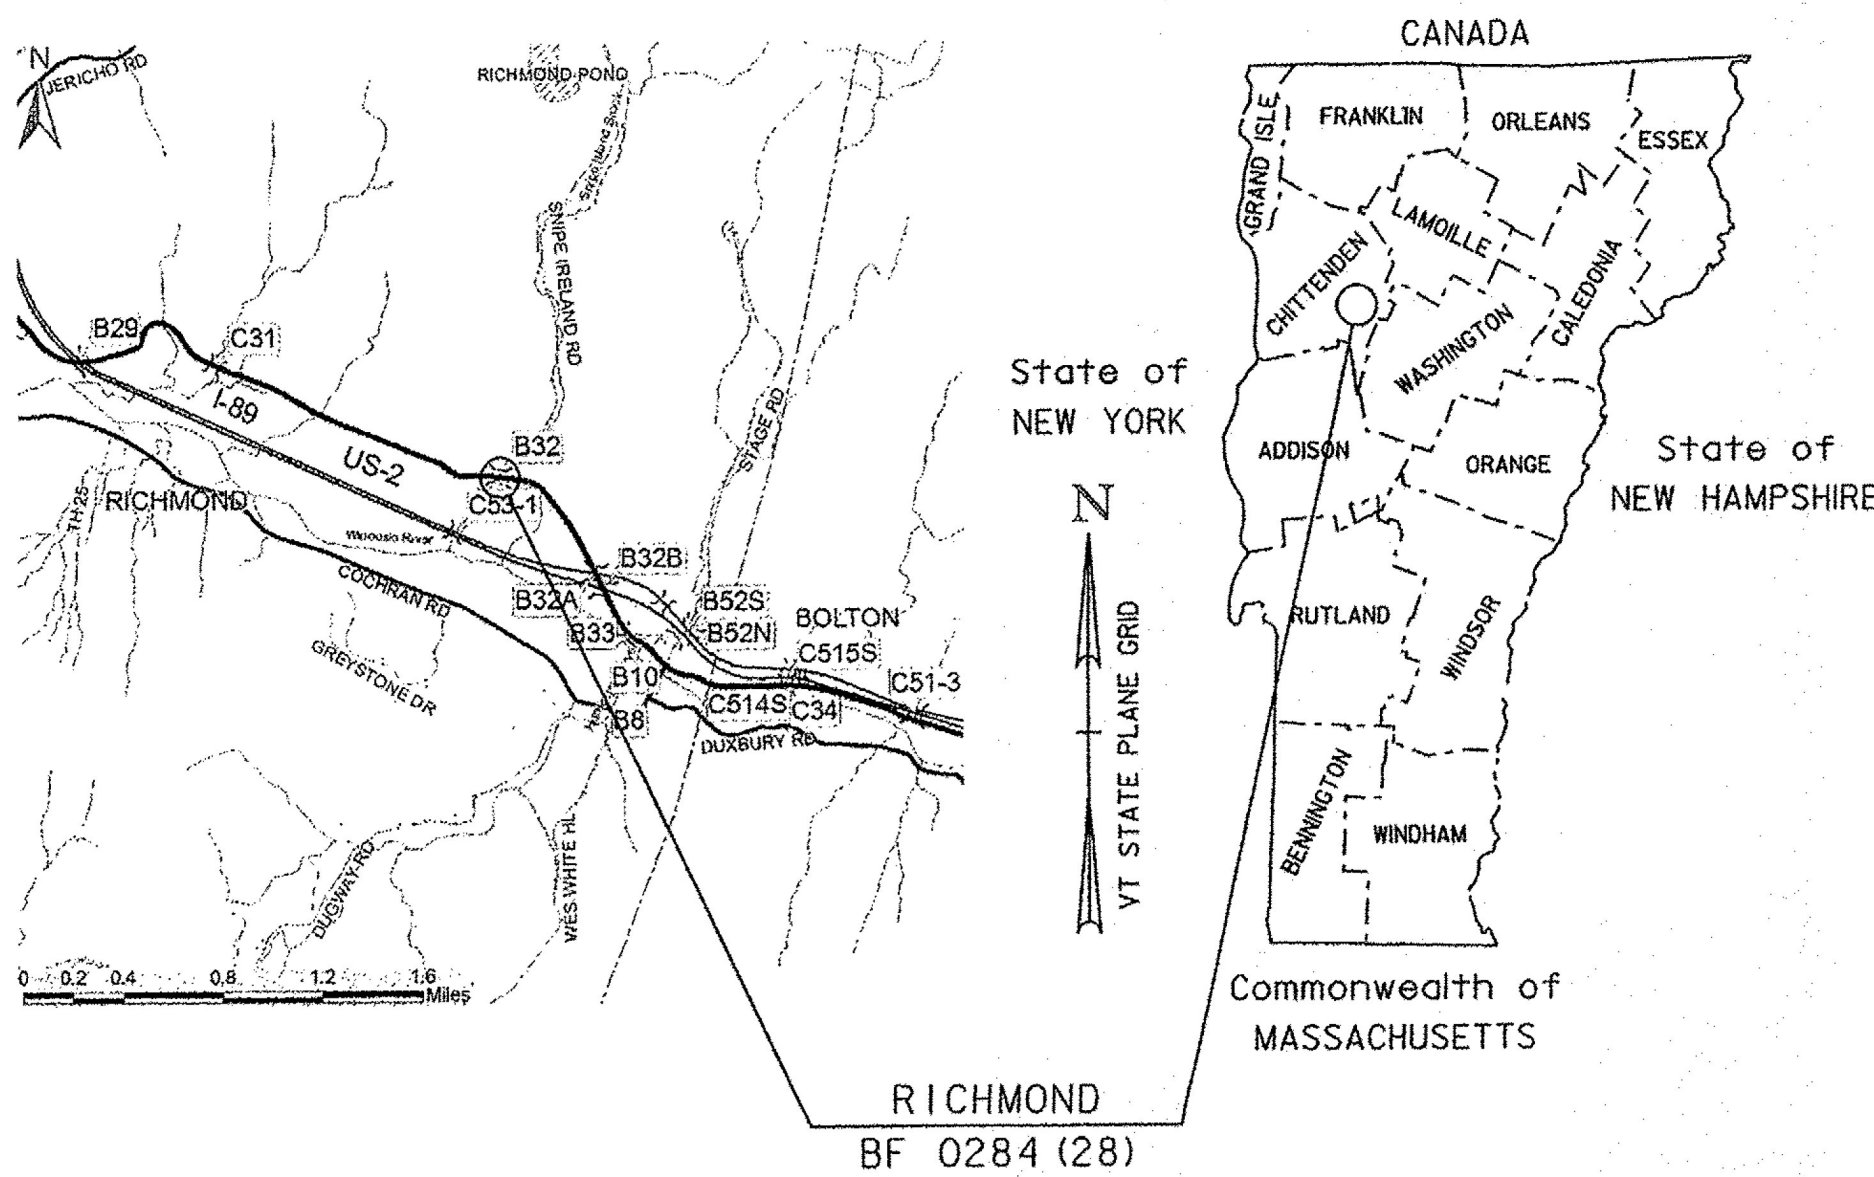

RECORD PLANS	
CONTRACTOR:	G.W. TATRO CONSTRUCTION, INC. - JEFFERSONVILLE, VT
RESIDENT ENGINEER:	PHIL HARRINGTON
CONSTRUCTION BEGAN:	MAY 10, 2017
CONSTRUCTION COMPLETE:	OCTOBER 21, 2017
RECORD PLANS BY:	PHIL HARRINGTON & AARON WEAVER
I HEREBY CERTIFY THAT ALL THE CONSTRUCTION REQUIRED BY THIS SET OF DRAWINGS HAS BEEN ACCOMPLISHED AS INDICATED HEREIN.	
BY <i>Phil Harrington</i>	RESIDENT ENGINEER
DATE <i>11/5/18</i>	
NOTE: Any further information concerning final quantities, amounts or other details relative to this project may be found at Central Files in the electronic archives.	

CONSTRUCTION IS TO BE CARRIED ON IN ACCORDANCE WITH THESE PLANS AND THE STANDARD SPECIFICATIONS FOR CONSTRUCTION DATED 2011, AS APPROVED BY THE FEDERAL HIGHWAY ADMINISTRATION ON JULY 20, 2011 FOR USE ON THIS PROJECT, INCLUDING ALL SUBSEQUENT REVISIONS AND SUCH REVISED SPECIFICATIONS AND SPECIAL PROVISIONS AS ARE INCORPORATED IN THESE PLANS.

QUALITY ASSURANCE PROGRAM : LEVEL 2	
SURVEYED BY :	L. ORVIS
SURVEYED DATE :	06/12/2013
DATUM	
VERTICAL	NAVD88
HORIZONTAL	NAD 83 (2011)

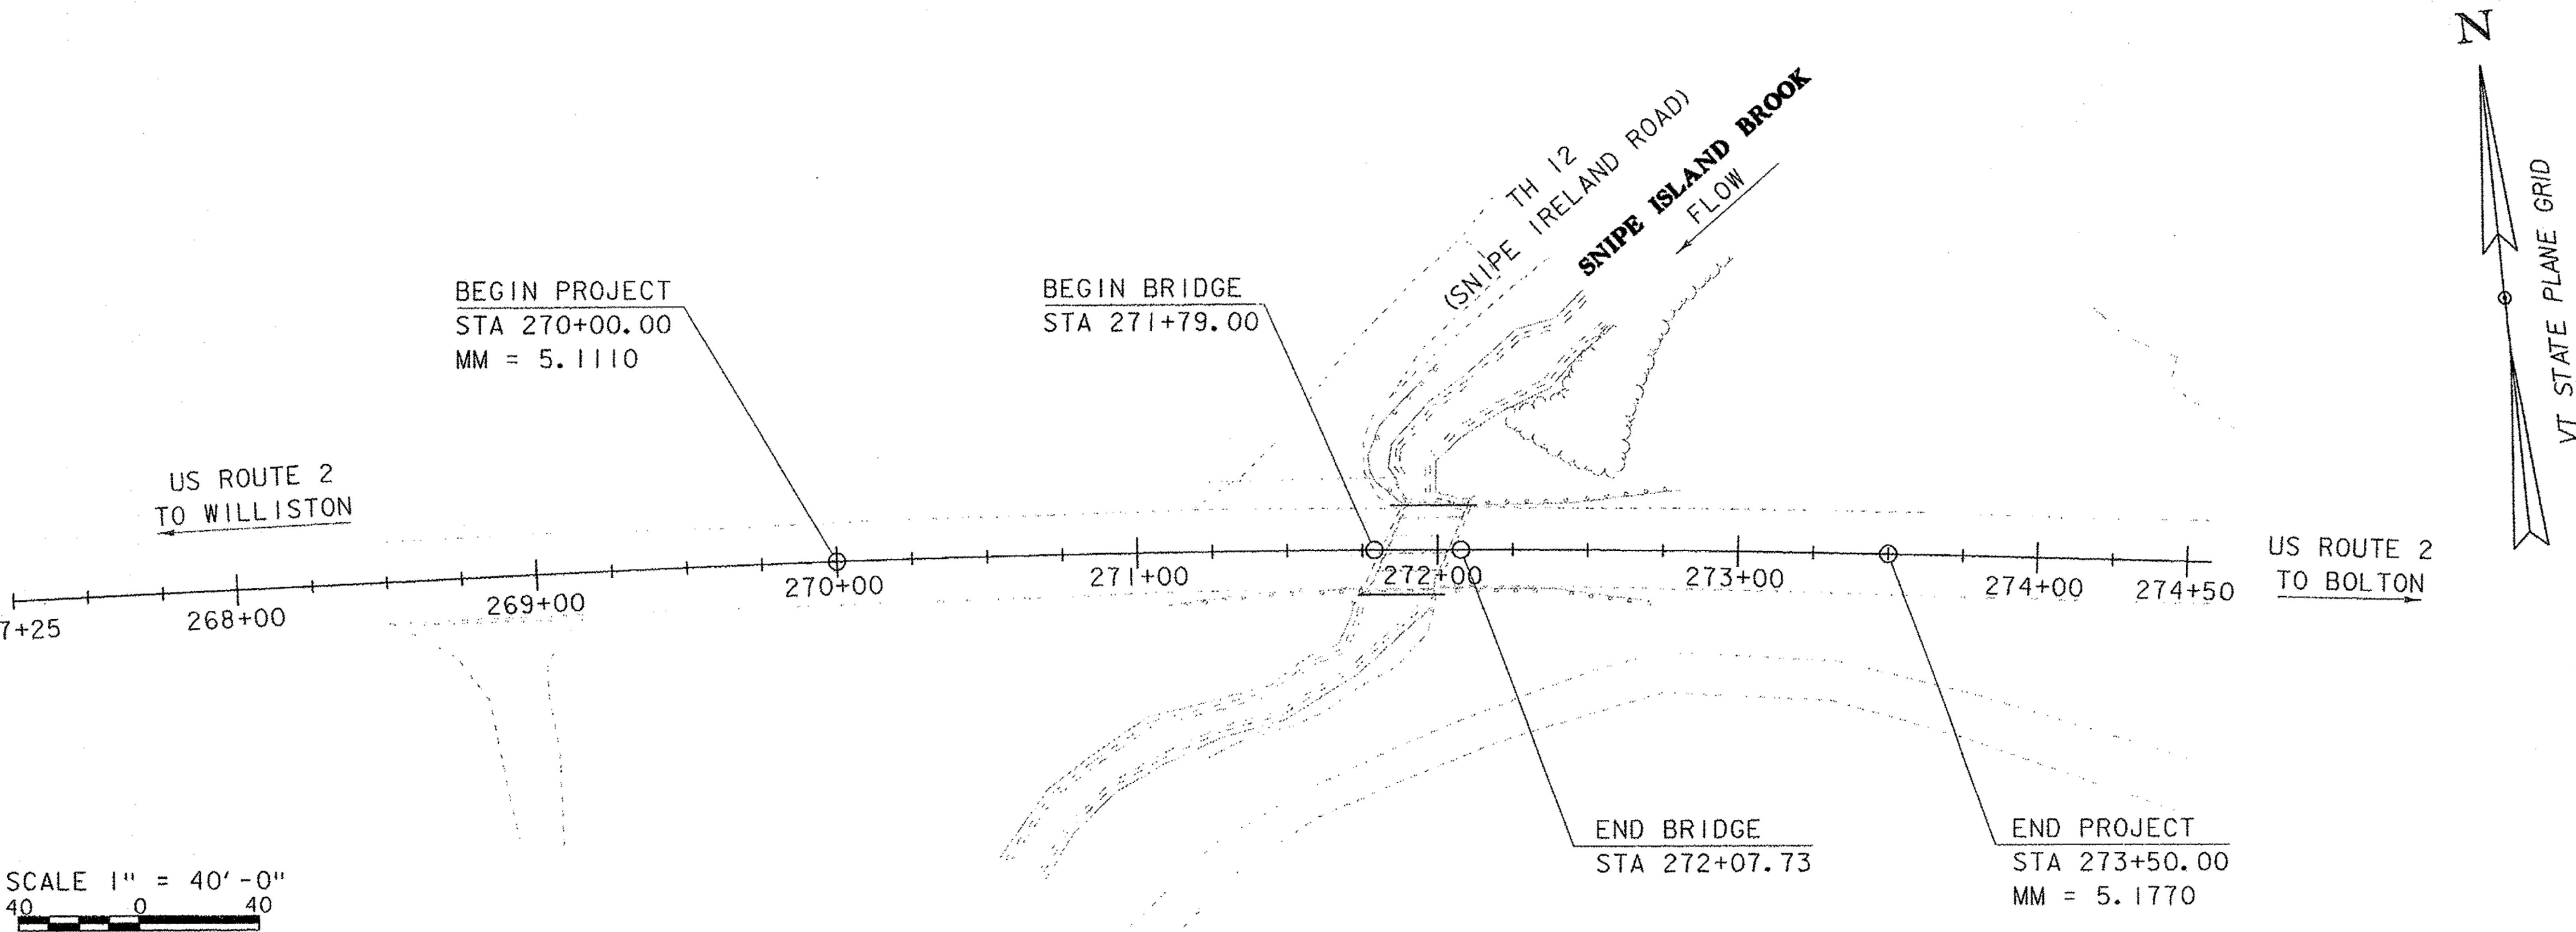

DIRECTOR OF PROJECT DELIVERY	
APPROVED <i>[Signature]</i>	DATE <i>9/8/2018</i>
PROJECT MANAGER : R. S. YOUNG	
PROJECT NAME : RICHMOND	
PROJECT NUMBER : BF 0284 (28)	
SHEET 1 OF 54 SHEETS	