




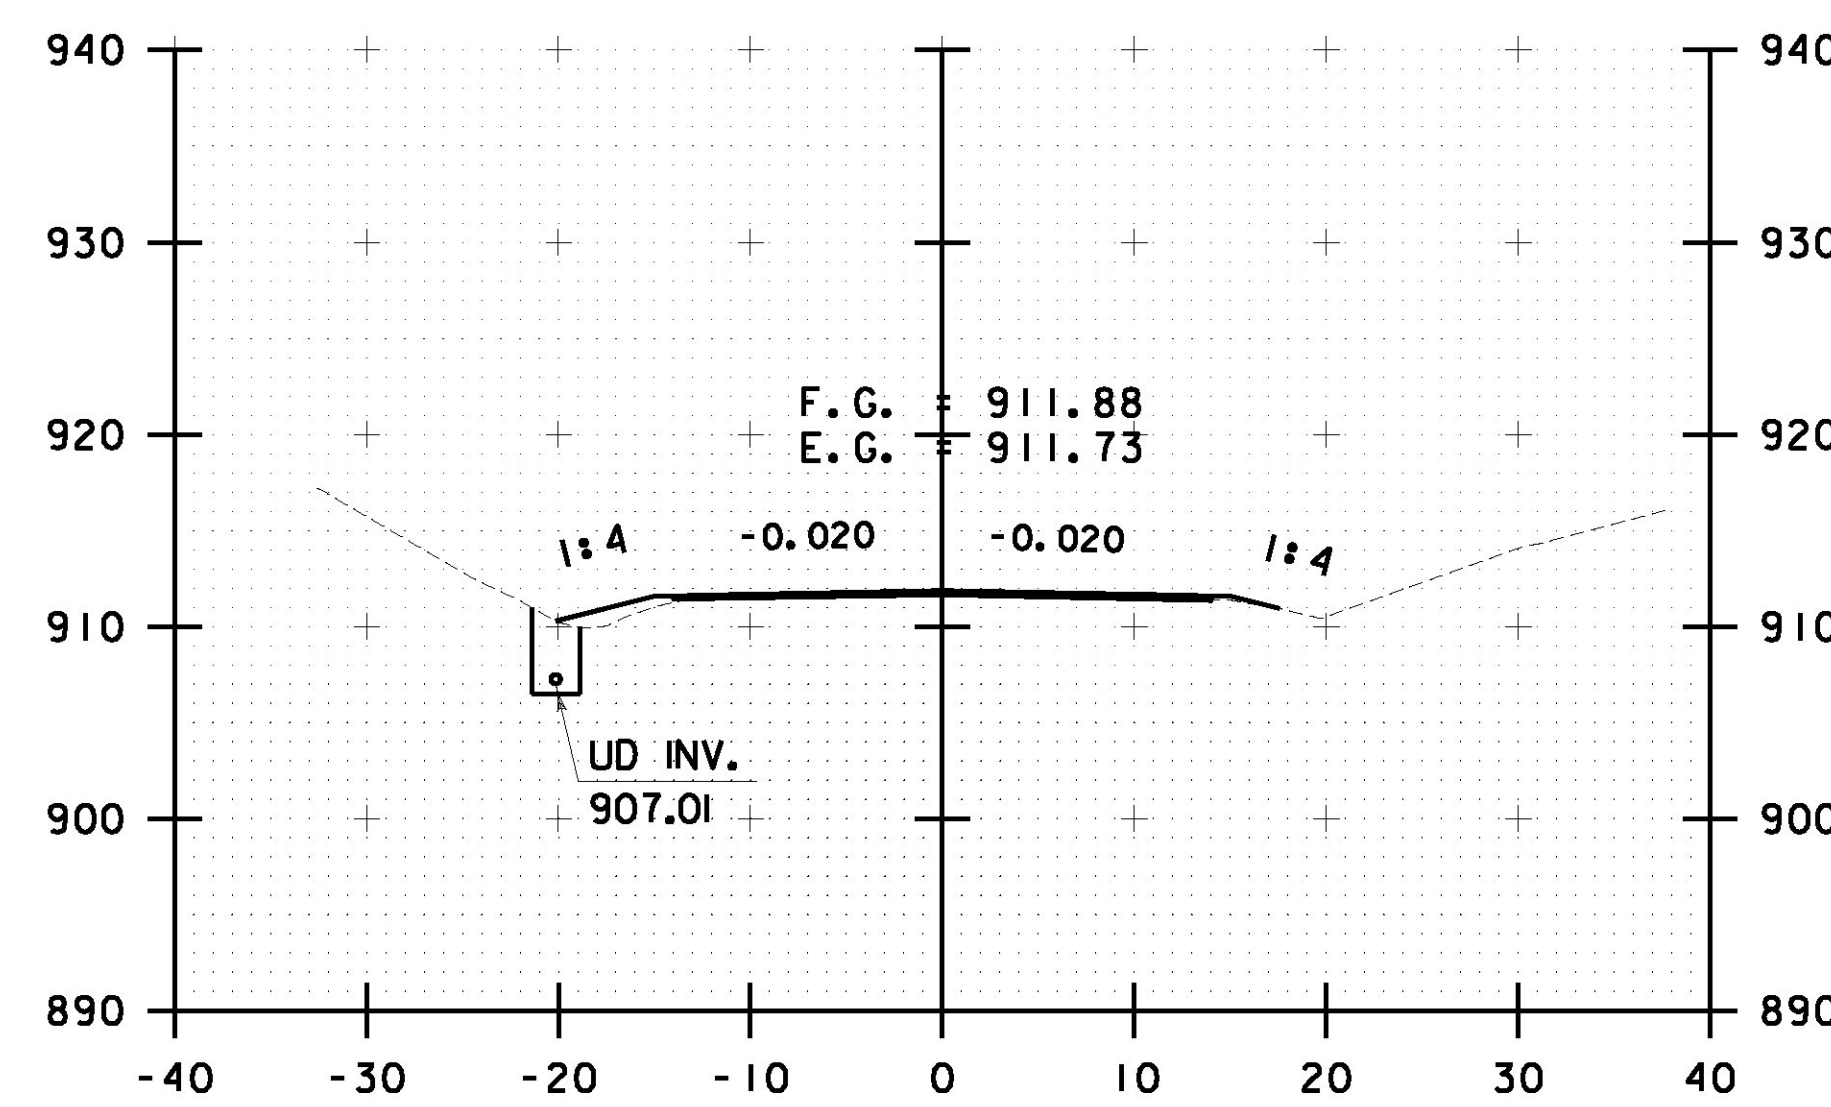


R 396+00.00

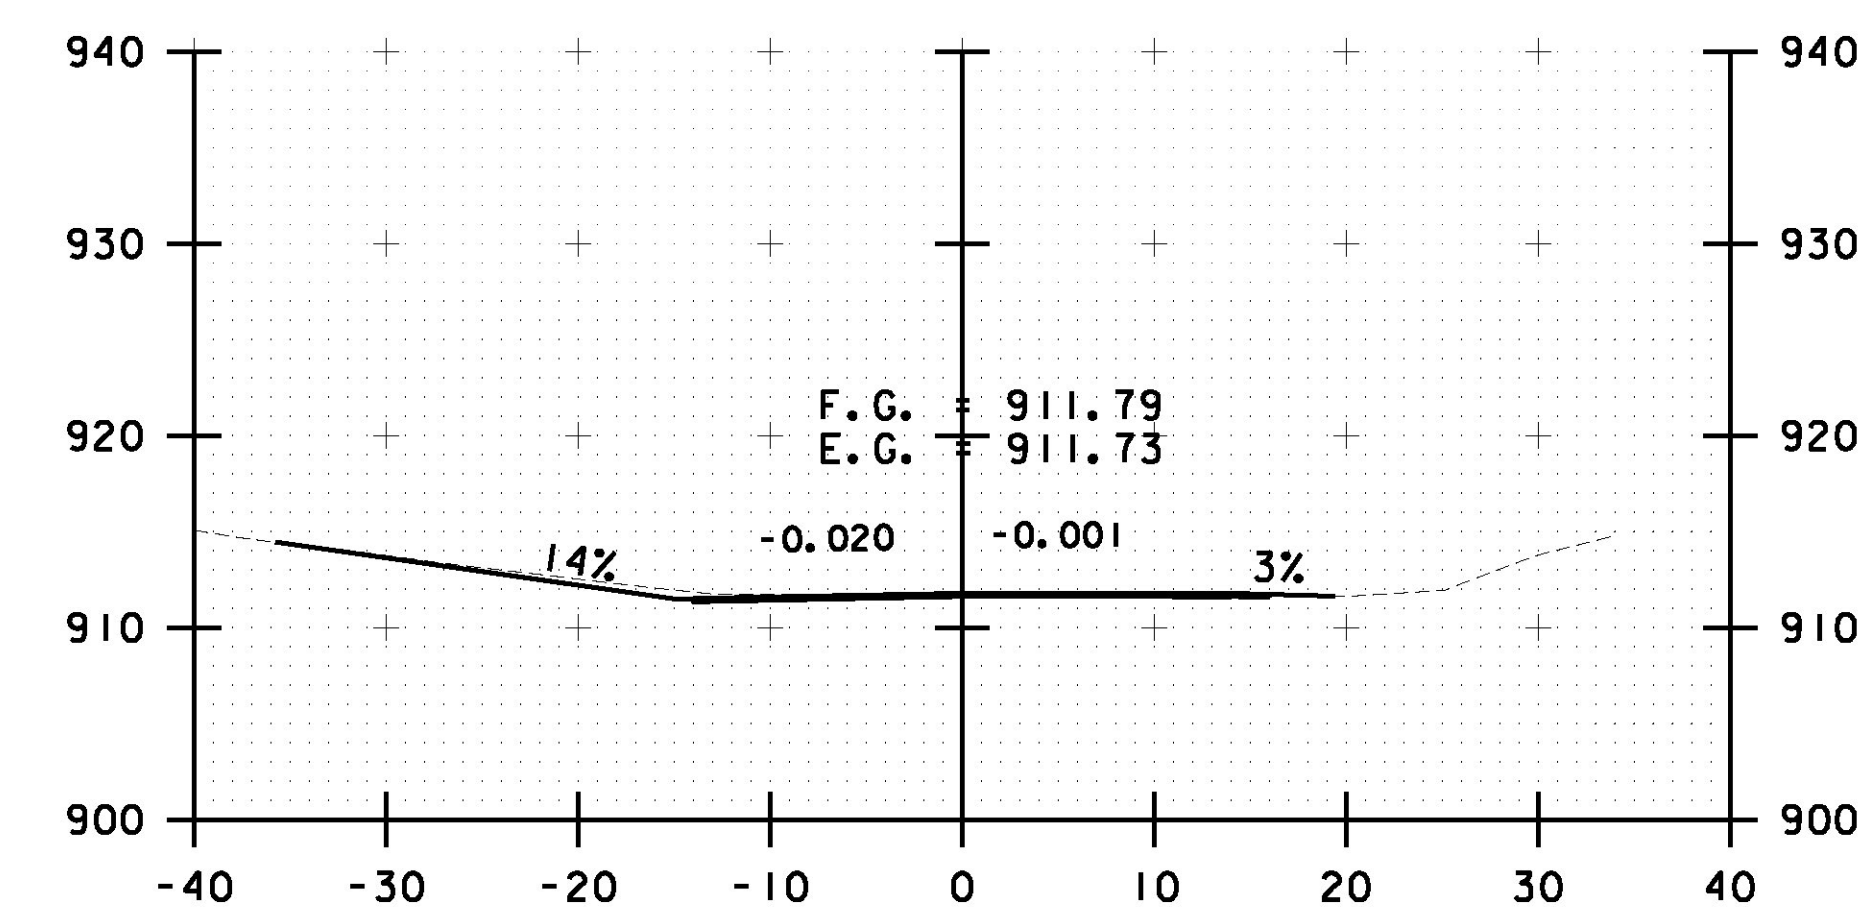


R 397+00.00

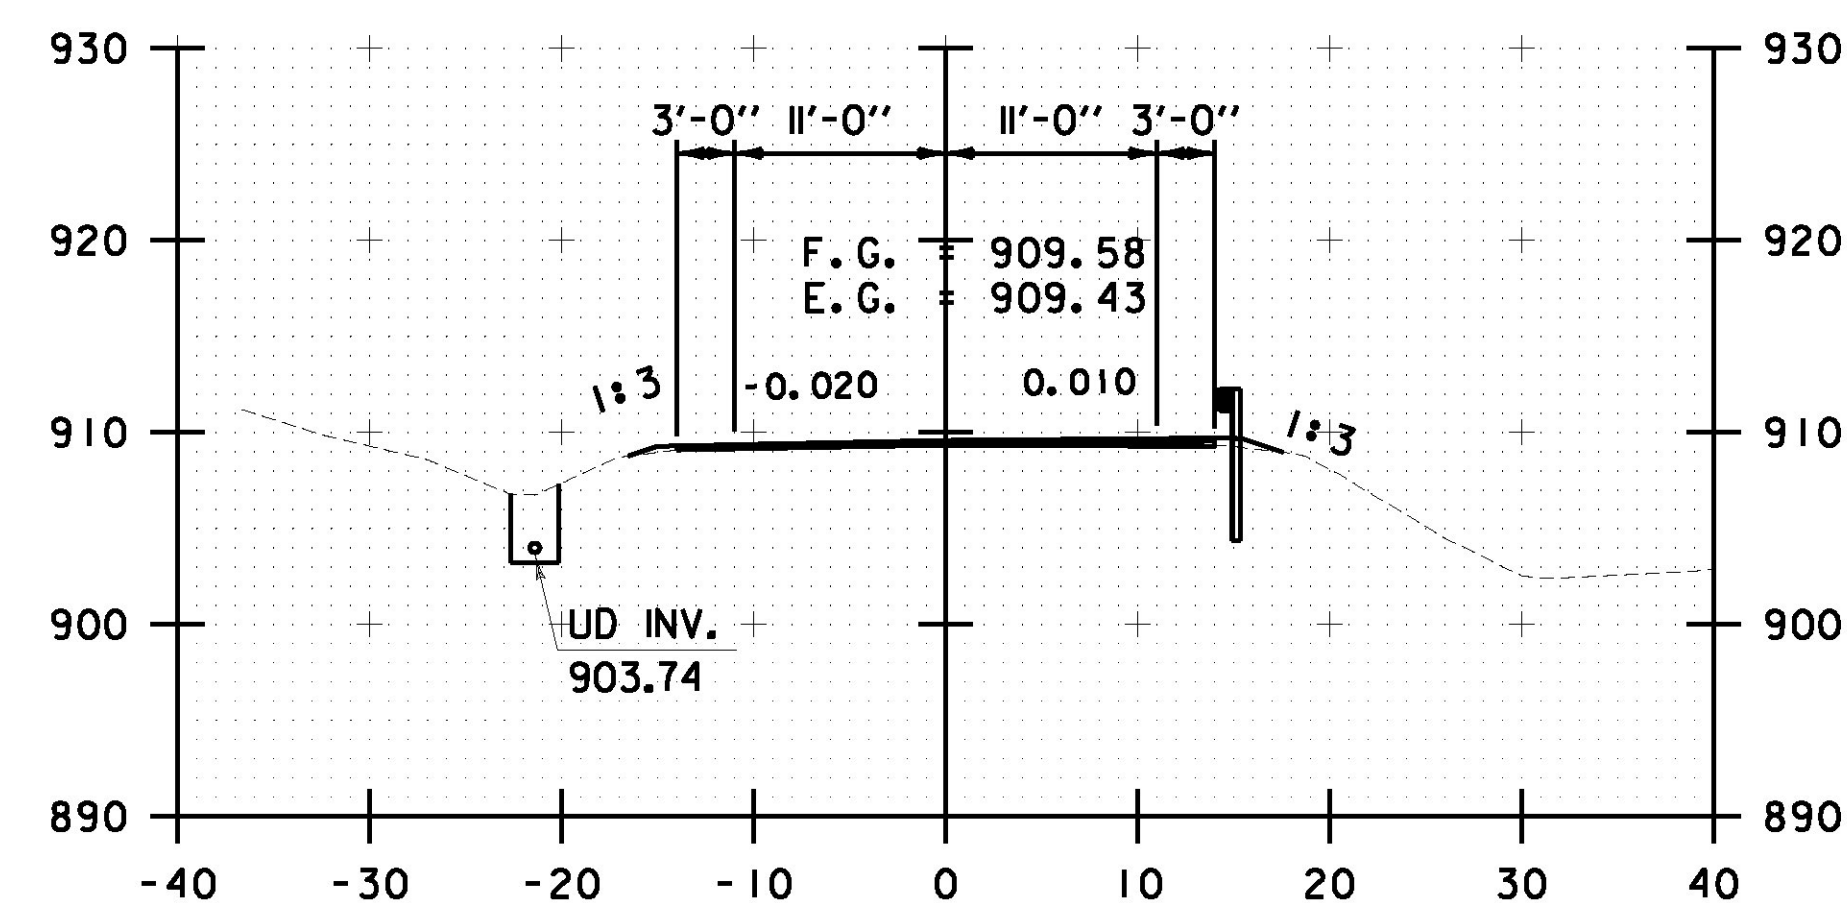

R 395+00.00

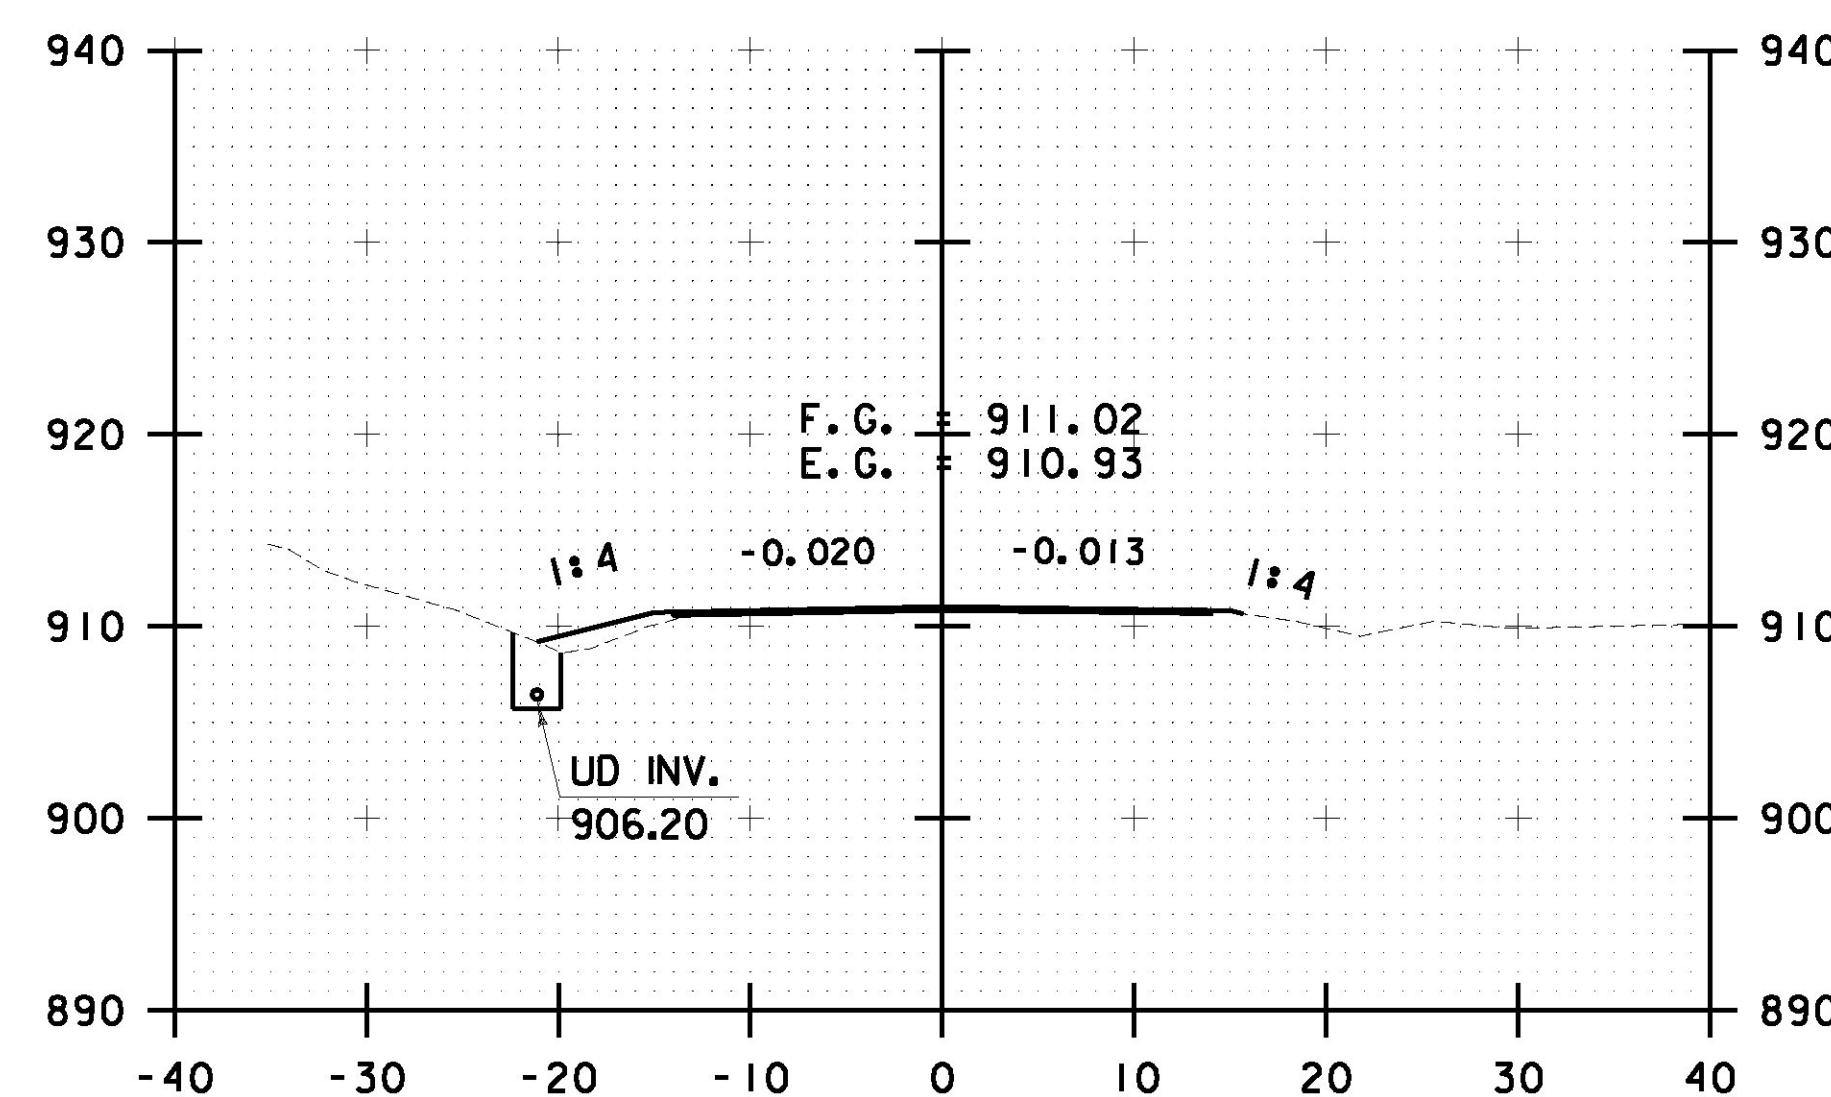

R 395+50.00

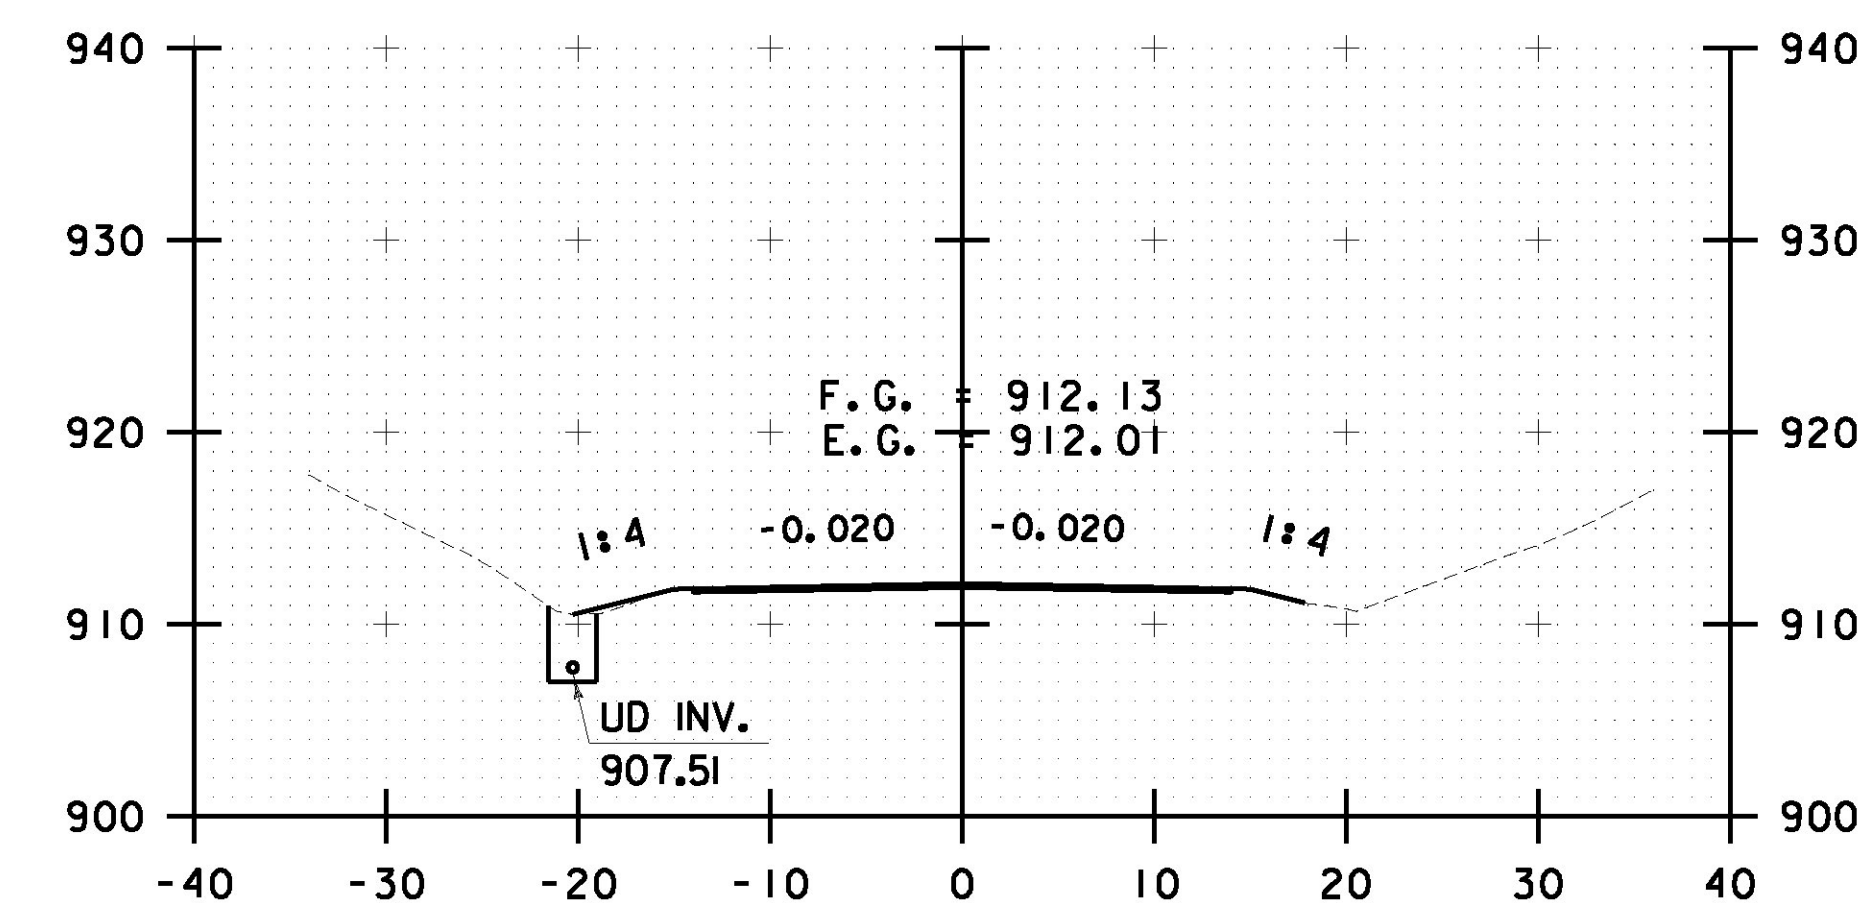

R 396+50.00

10 0 10
SCALE IN FEET

CHA

PROJECT NAME: ROCHESTER
PROJECT NUMBER: ER STP 0162(21)

FILE NAME: z13cl76xc.dgn
PROJECT LEADER: D. GOZALKOWSKI
DESIGNED BY: J. OLSEN
ROCHESTER CROSS SECTION SHEET #136

PLOT DATE: 1/12/2017
DRAWN BY: J. HEALD
CHECKED BY: J. SHIELDS
SHEET 325 OF 360