



REMOVAL OF EXISTING BRIDGE RAILING
STA. 284+97.6 TO 285+22.6, LT
STA. 285+16.0 TO 285+41.0, RT

BRIDGE RAILING REPAIR, TYPE II
STA. 284+97.6 TO 285+22.6, LT
STA. 285+16.0 TO 285+41.0, RT

RAPID SETTING CONCRETE REPAIR MATERIAL WITH COARSE AGGREGATE
STA. 285+06.8 TO 285+31.8

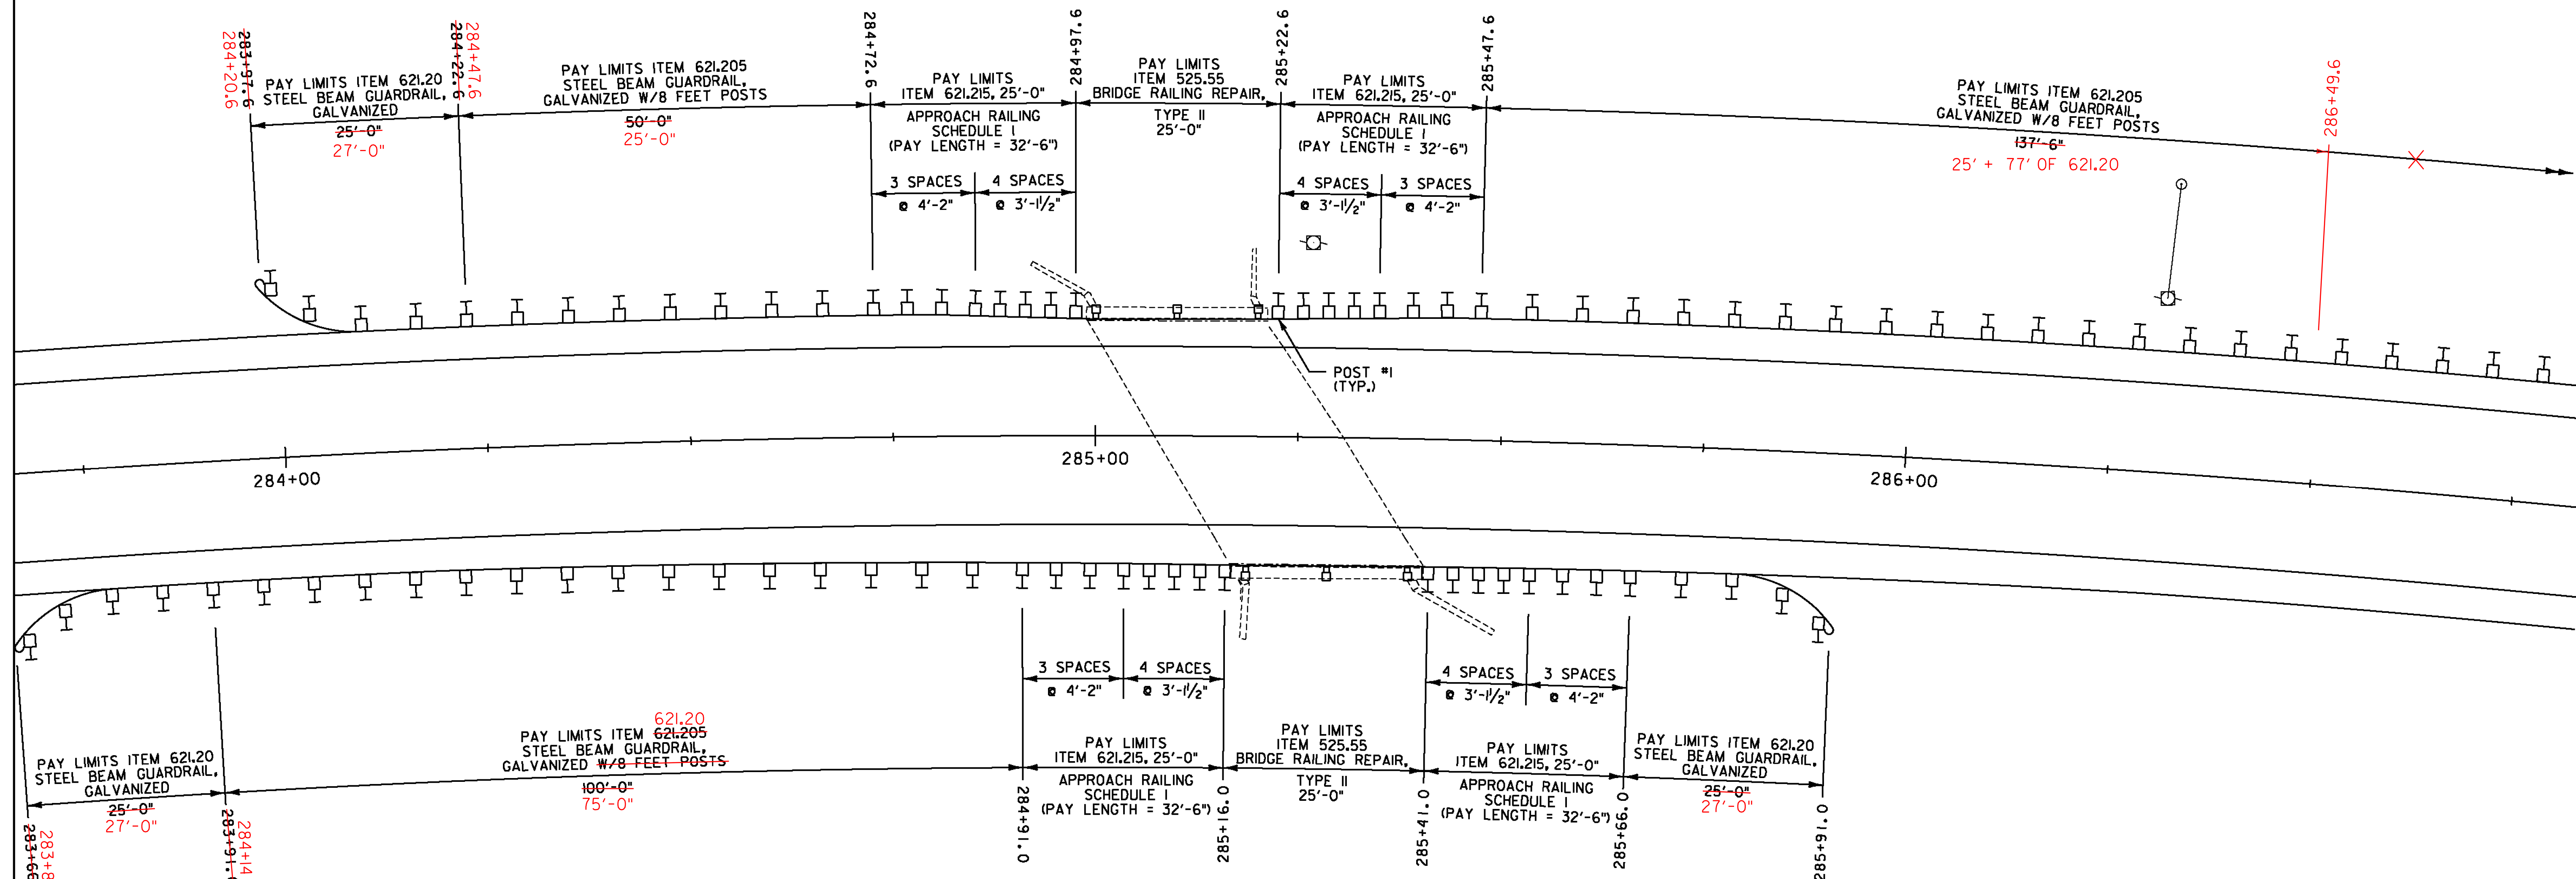

BR 9 BRAINTREE MM 5.401 = STA. 285+17

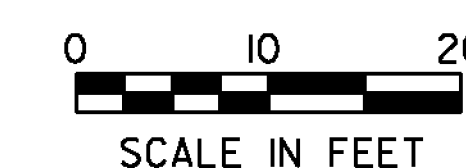

PROJECT NAME: RANDOLPH-ROXBURY
PROJECT NUMBER: ER STP 0187(II)

FILE NAME: z13cl82frm.dgn
PROJECT LEADER: M. FOISY
DESIGNED BY: I. MAYNARD
GUARDRAIL DETAIL SHEET 5

PLOT DATE: 11/17/2014
DRAWN BY: I. MAYNARD
CHECKED BY: M. FOISY
SHEET 15 OF 545