


REMOVAL OF EXISTING BRIDGE RAILING
STA. 328+43.4 TO 328+68.4, RT
STA. 328+61.6 TO 328+86.6, LT

BRIDGE RAILING REPAIR, TYPE II
STA. 328+43.4 TO 328+68.4, RT
STA. 328+61.6 TO 328+86.6, LT

RAPID SETTING CONCRETE REPAIR MATERIAL WITH COARSE AGGREGATE
STA. 328+52.5 TO 328+77.5

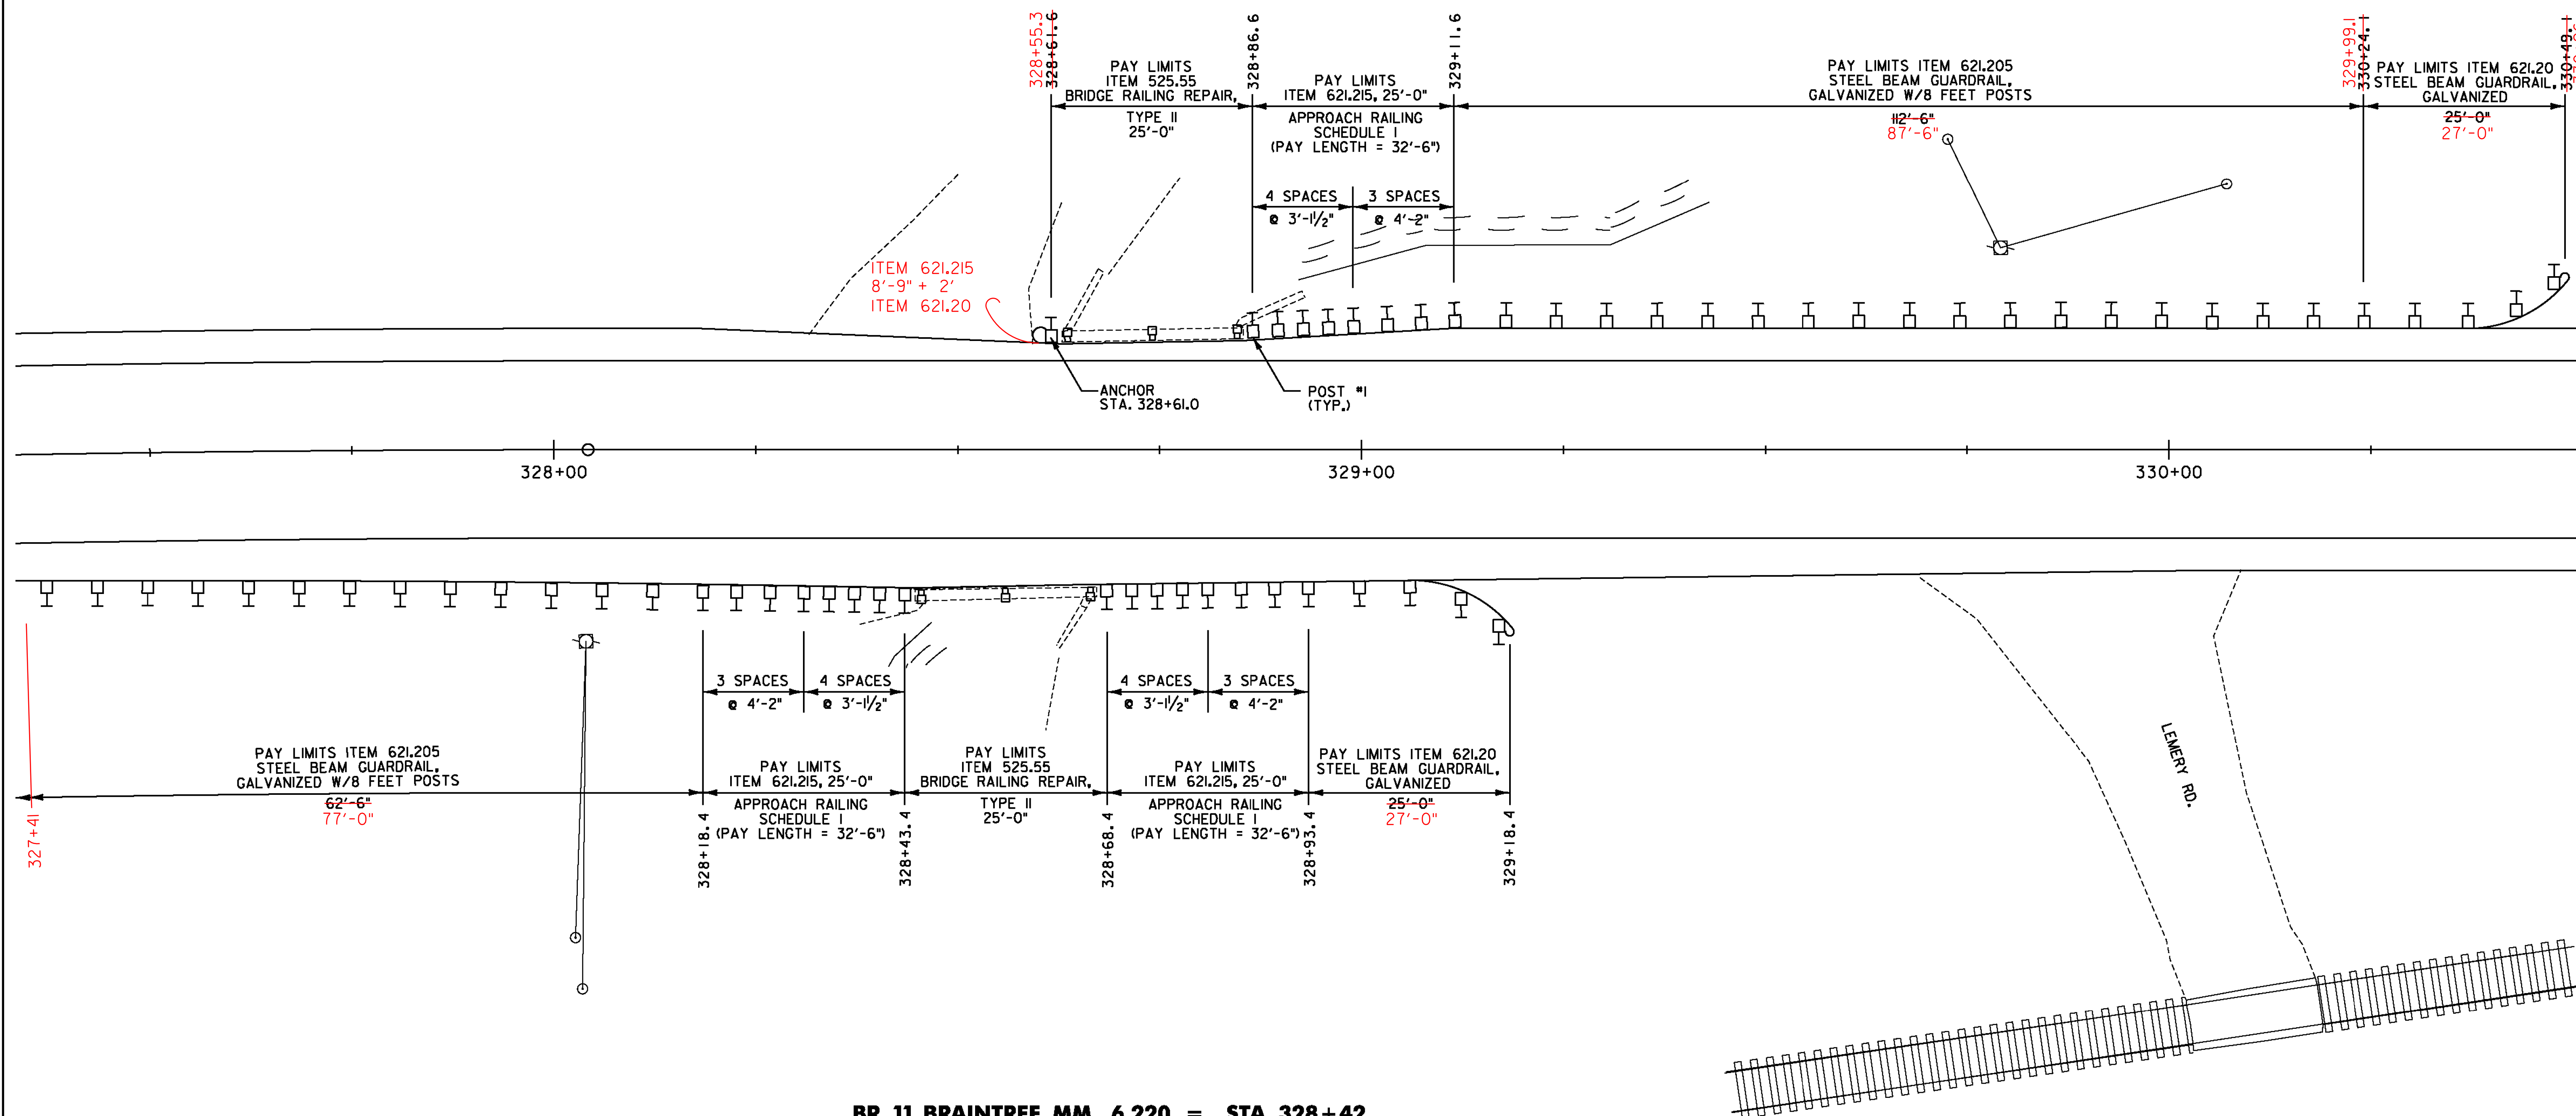

BR 11 BRAINTREE MM 6.220 = STA. 328+42

0 10 20
SCALE IN FEET



PROJECT NAME: RANDOLPH-ROXBURY
PROJECT NUMBER: ER STP 0187(II)

FILE NAME: z13cl82frm.dgn
PROJECT LEADER: M. FOISY
DESIGNED BY: I. MAYNARD
GUARDRAIL DETAIL SHEET 7

PLOT DATE: 11/17/2014
DRAWN BY: I. MAYNARD
CHECKED BY: M. FOISY
SHEET 17 OF 545