
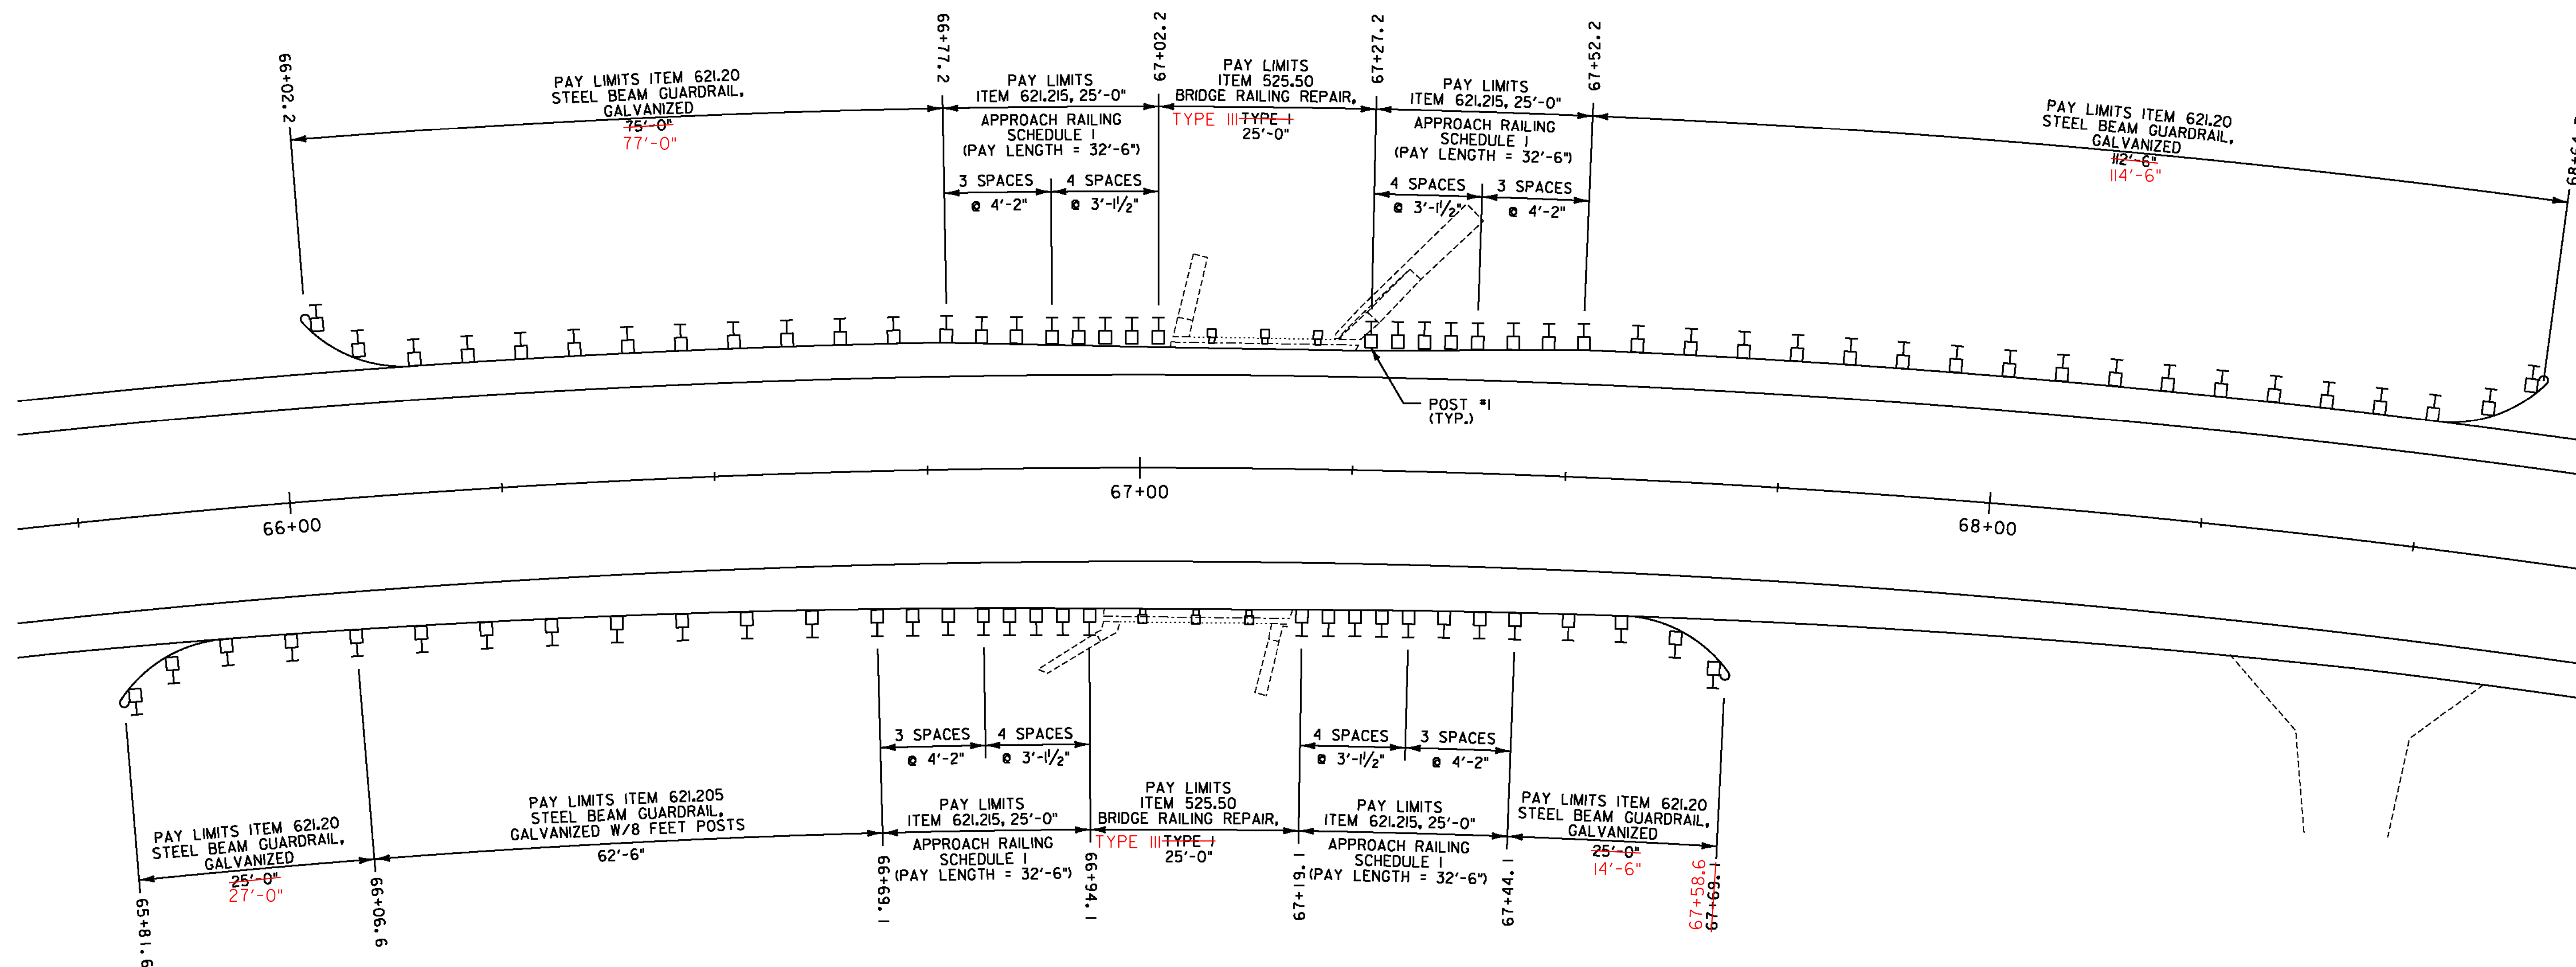


REMOVAL OF EXISTING BRIDGE RAILING
STA. 66+94.1 TO 67+19.1, RT
STA. 67+02.2 TO 67+27.2, LT

BRIDGE RAILING REPAIR, TYPE I
STA. 66+94.1 TO 67+19.1, RT
STA. 67+02.2 TO 67+27.2, LT

RAPID SETTING CONCRETE REPAIR MATERIAL WITH COARSE AGGREGATE
STA. 66+98.2 TO 67+23.2

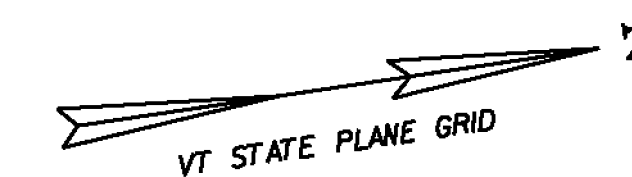

BR 14 GRANVILLE MM 1.271 = STA. 67+11

0 10 20
SCALE IN FEET



PROJECT NAME: RANDOLPH-ROXBURY
PROJECT NUMBER: ER STP 0187(II)

FILE NAME: z13cl82frm.dgn
PROJECT LEADER: M. FOISY
DESIGNED BY: I. MAYNARD
GUARDRAIL DETAIL SHEET 9

PLOT DATE: 11/17/2014
DRAWN BY: I. MAYNARD
CHECKED BY: M. FOISY
SHEET 19 OF 545