


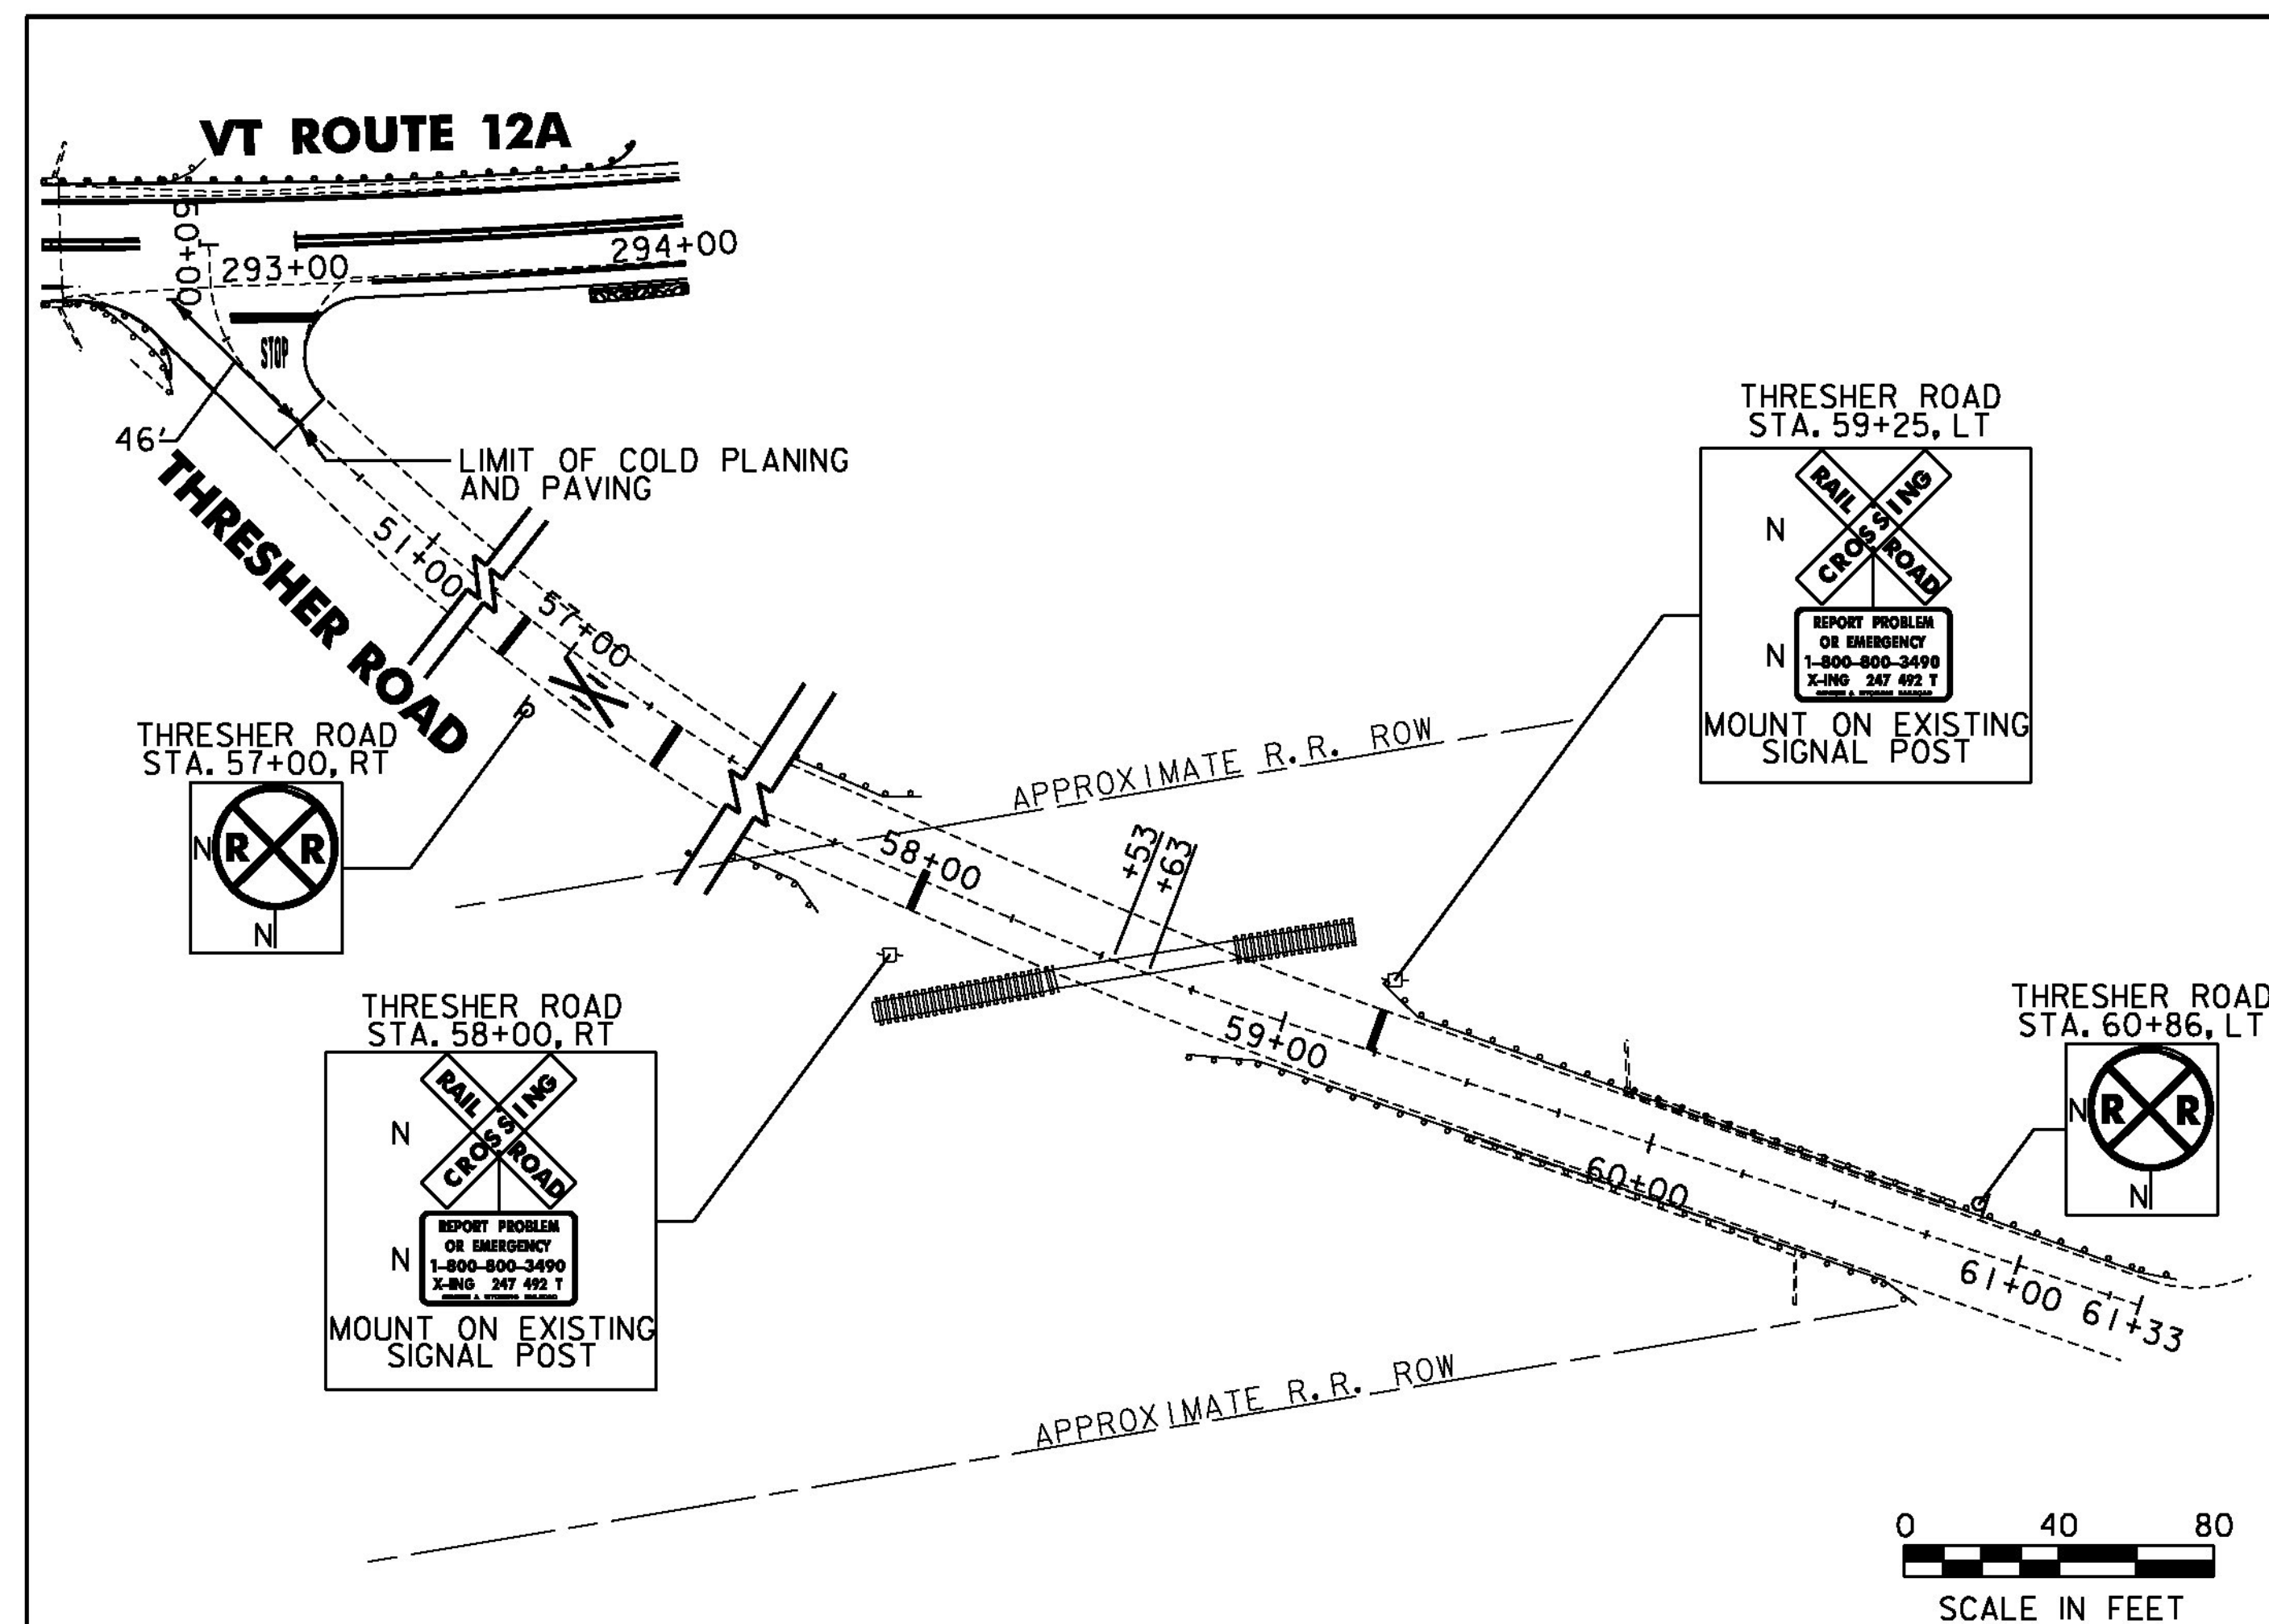


THRESHER ROAD RAILROAD CROSSING #247-492T DETAIL BRAINTREE STA. 292+51, RT

DURABLE 24 INCH STOP BAR, THERMOPLASTIC
DURABLE 24 INCH STOP BAR, POLYUREA
TEMPORARY 24 INCH STOP BAR, PAINT
THRESHER ROAD STA. 59+23, LT (11 LF)


DURABLE RAILROAD CROSSING SYMBOL, THERMOPLASTIC
DURABLE RAILROAD CROSSING SYMBOL, POLYUREA
TEMPORARY RAILROAD CROSSING SYMBOL, PAINT
THRESHER ROAD STA. 57+00, LT

REV	DESCRIPTION	DATE
1	NOTE CLARIFICATION	1-16-2015

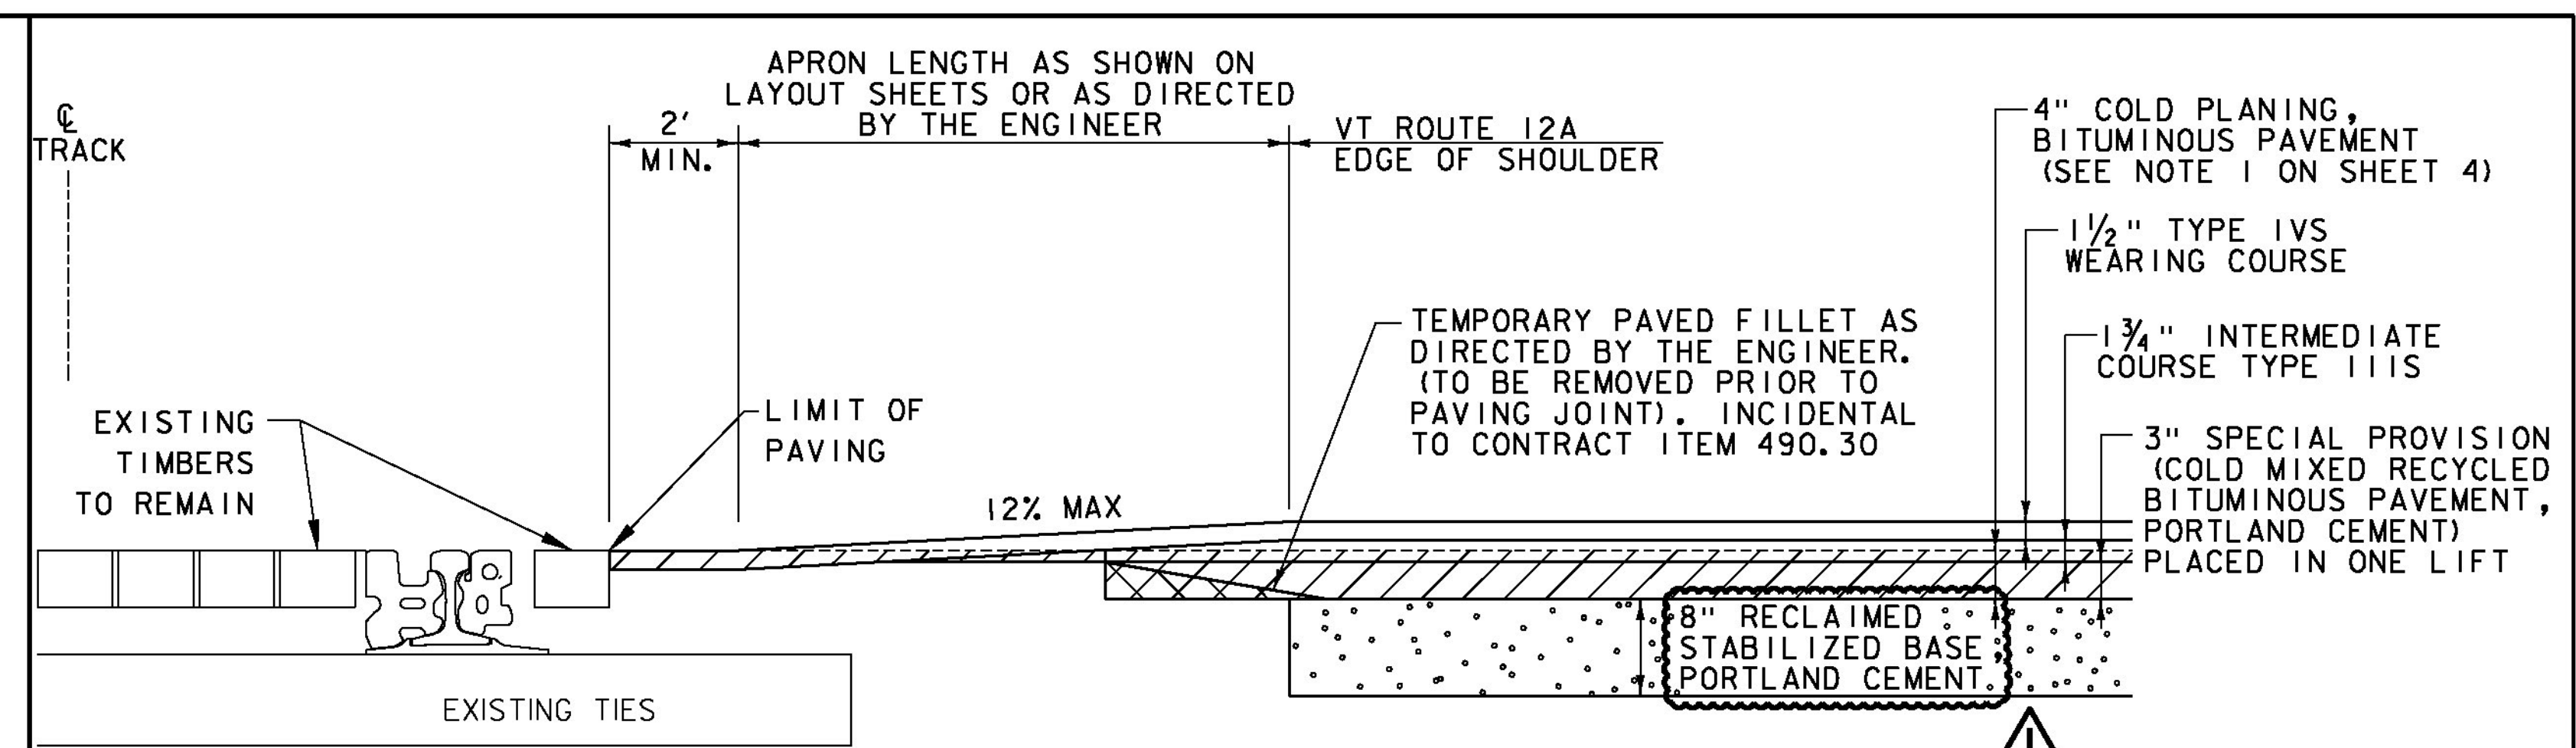


SIDE ROAD RAILROAD APPROACH CROSSING DETAIL

LOCATIONS:
LEMERY ROAD BRAINTREE STA. 329+84, RT
HANDLY ROAD GRANVILLE STA. 9+13, RT

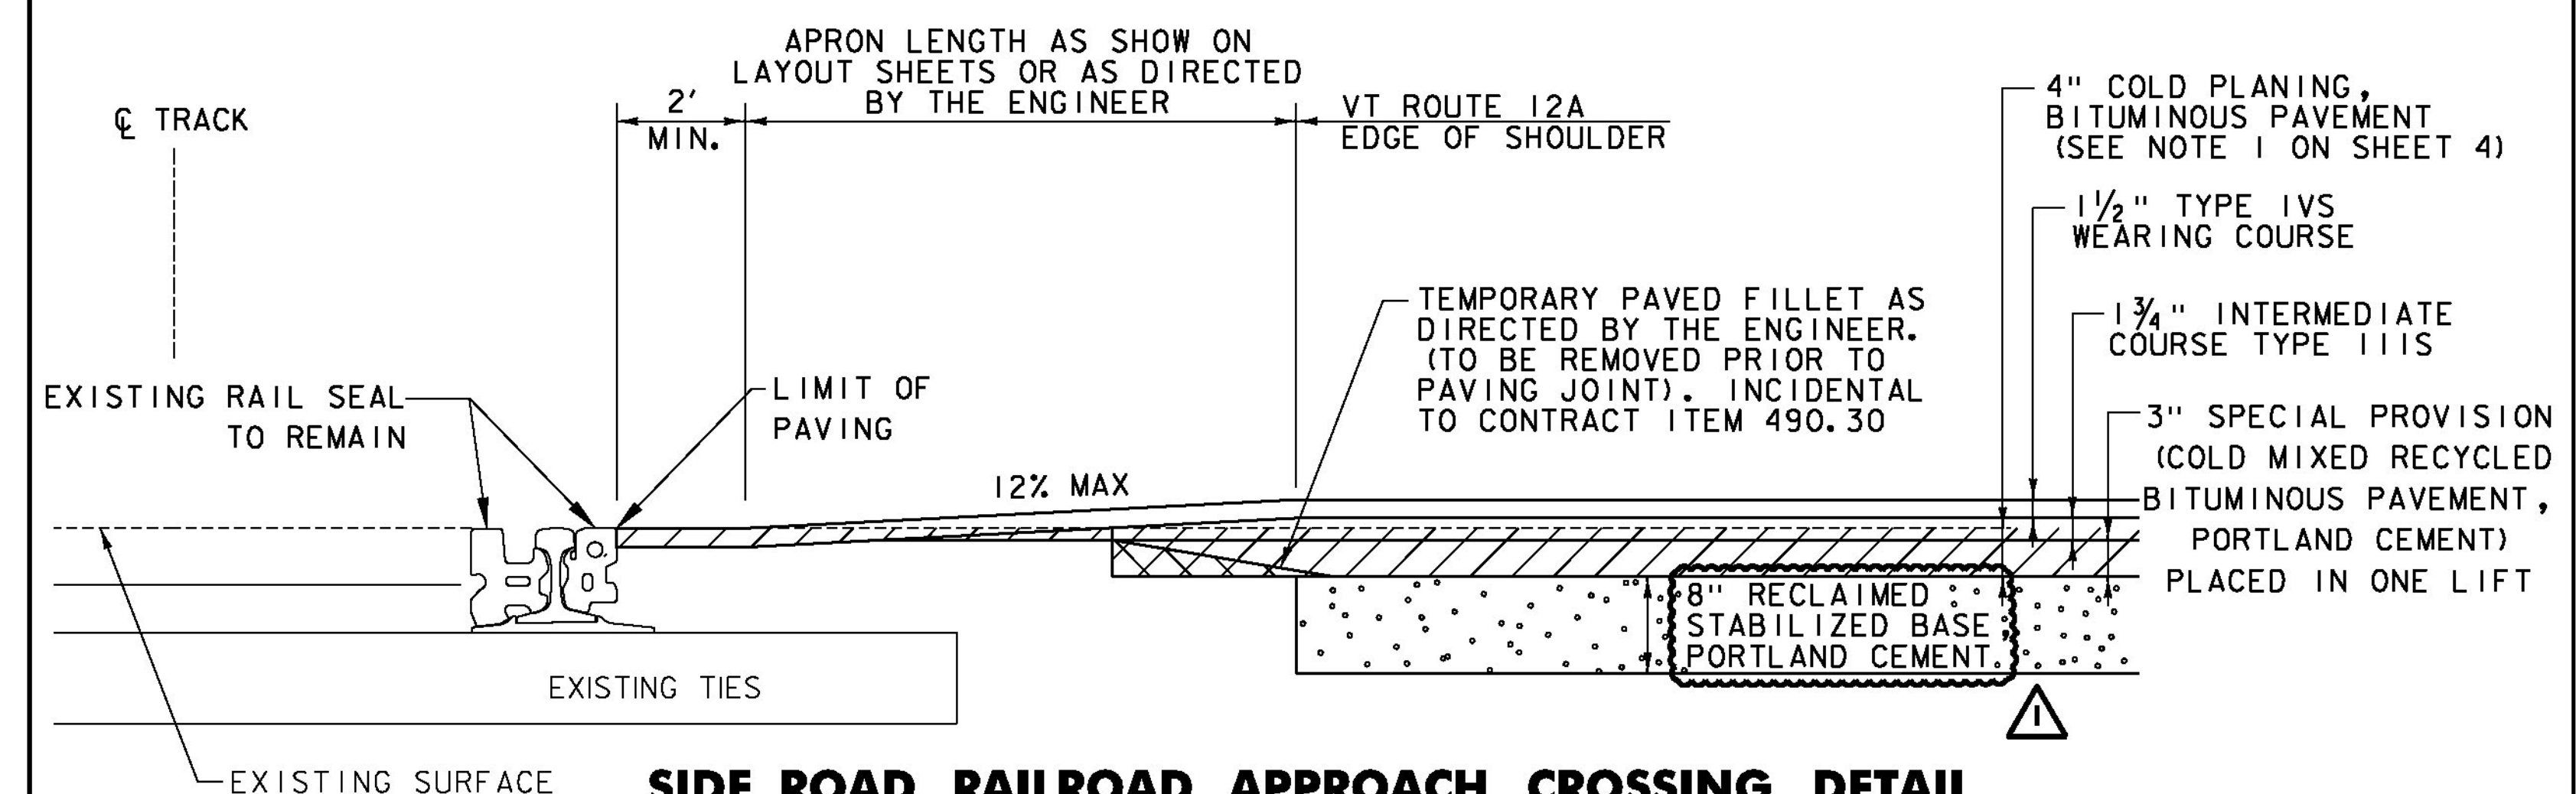


SIDE ROAD RAILROAD APPROACH CROSSING DETAIL


LOCATIONS:
MOBILE ACRES ROAD BRAINTREE STA. 36+85, LT
RIFORD BROOK ROAD BRAINTREE STA. 65+15, LT
THRESHER ROAD BRAINTREE STA. 292+51, RT

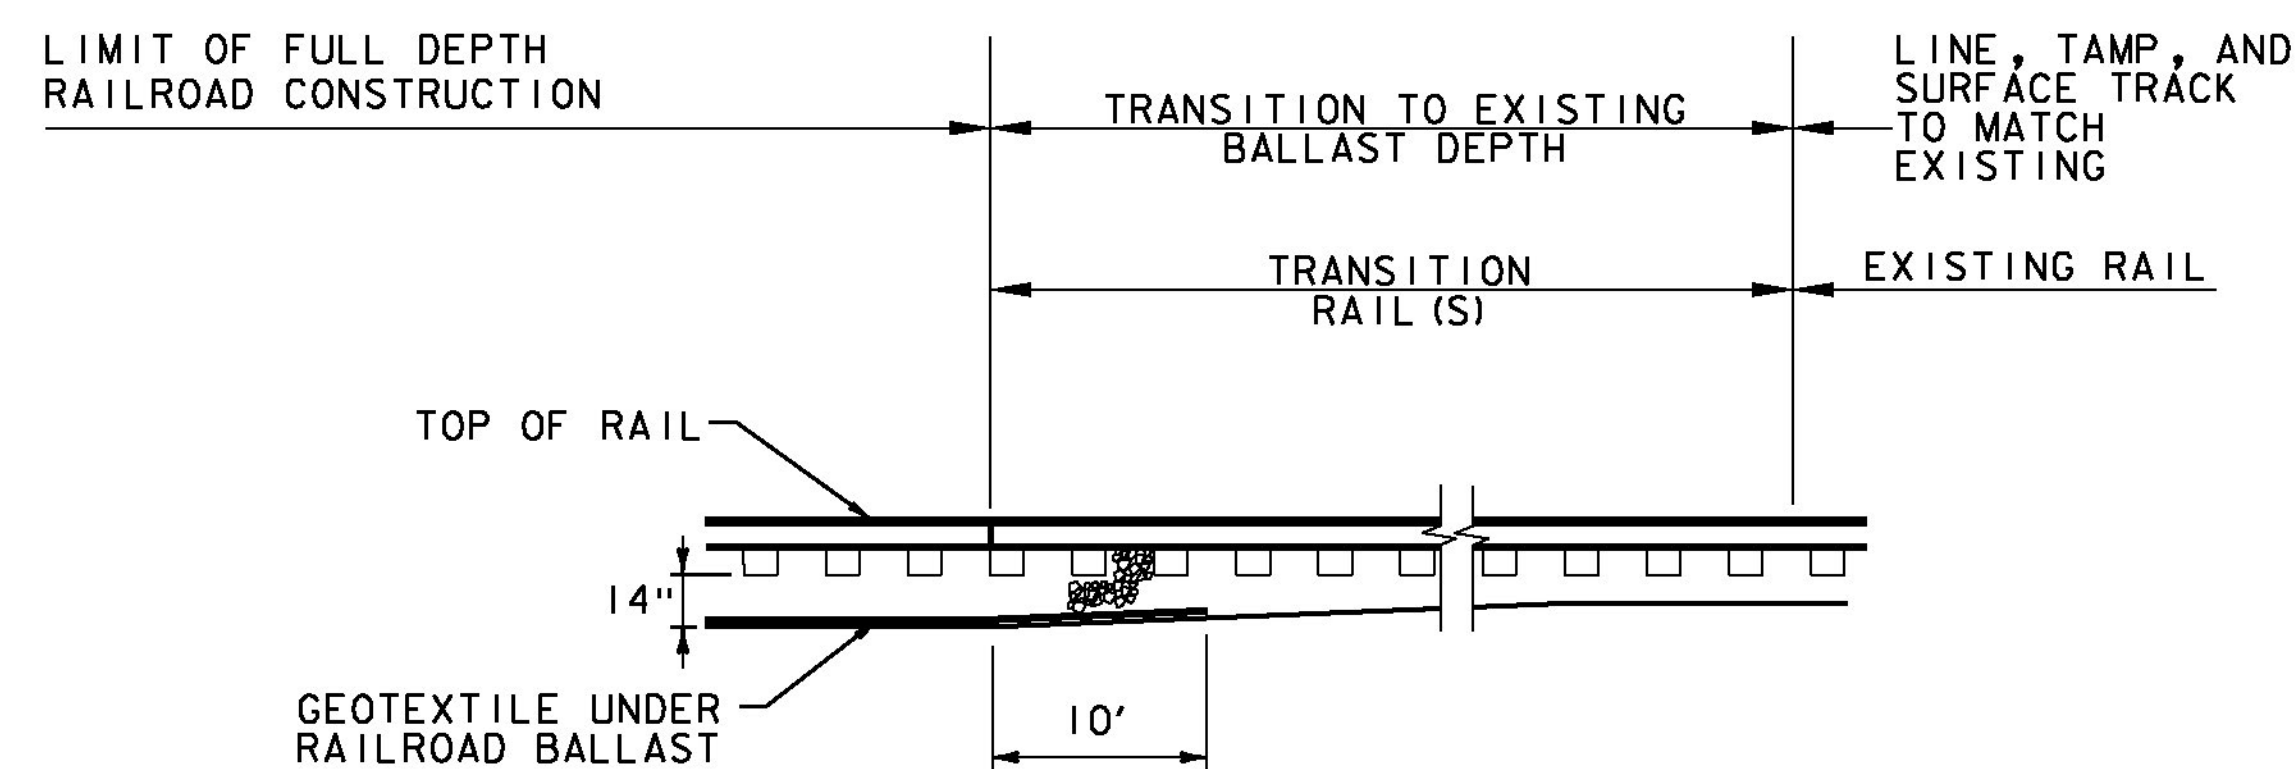

TYPICAL BALLAST TRANSITION

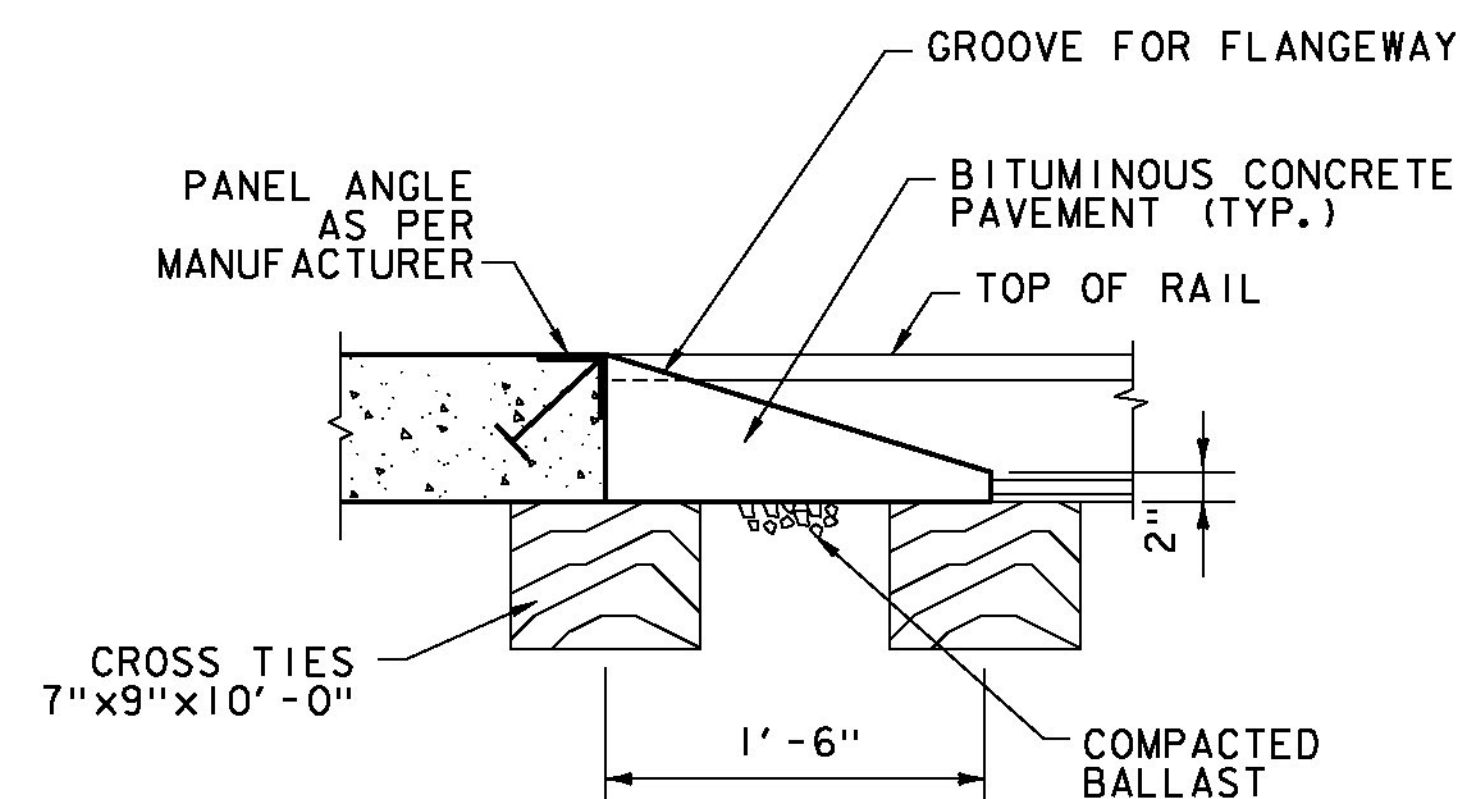

PANEL END SIDE VIEW

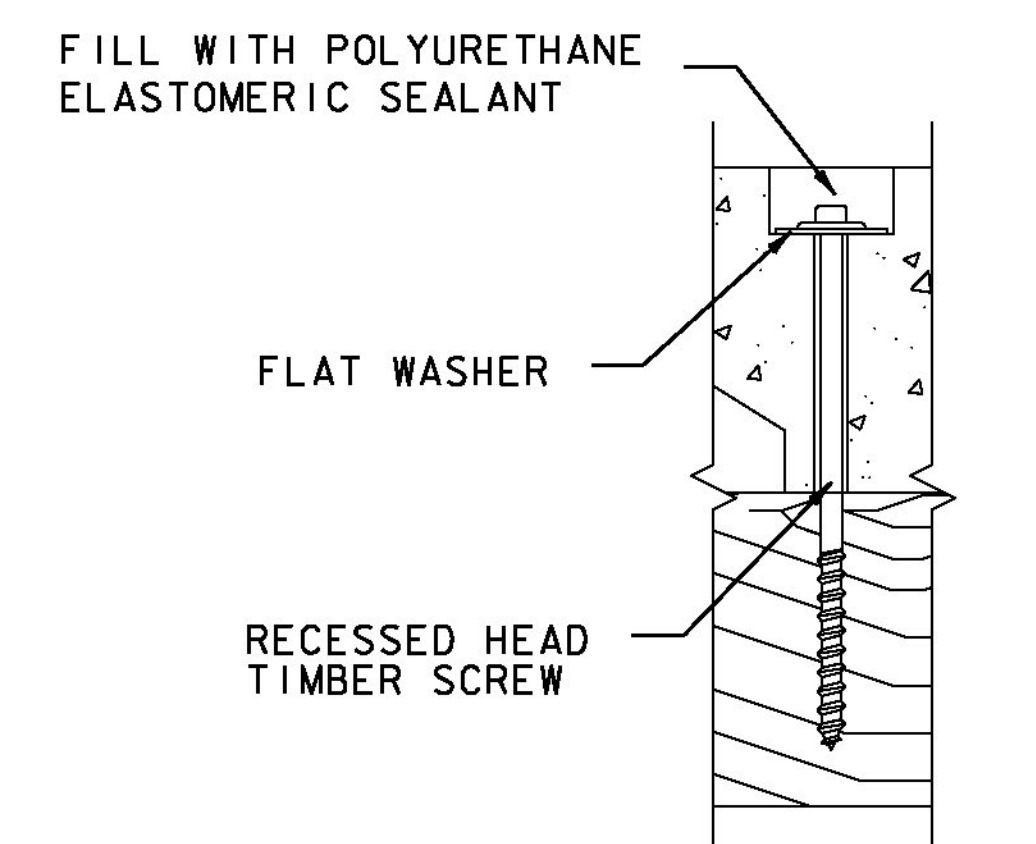

SCREW DETAIL

PROJECT NAME: RANDOLPH-ROXBURY	FILE NAME: z13cl82frm.dgn	PLOT DATE: 1/16/2015
PROJECT NUMBER: ER STP 0187(II)	PROJECT LEADER: M. FOISY	DRAWN BY: I. MAYNARD
	DESIGNED BY: I. MAYNARD	CHECKED BY: M. FOISY
	RAILROAD CROSSING DETAIL SHEET 4	SHEET 26 OF 545

