
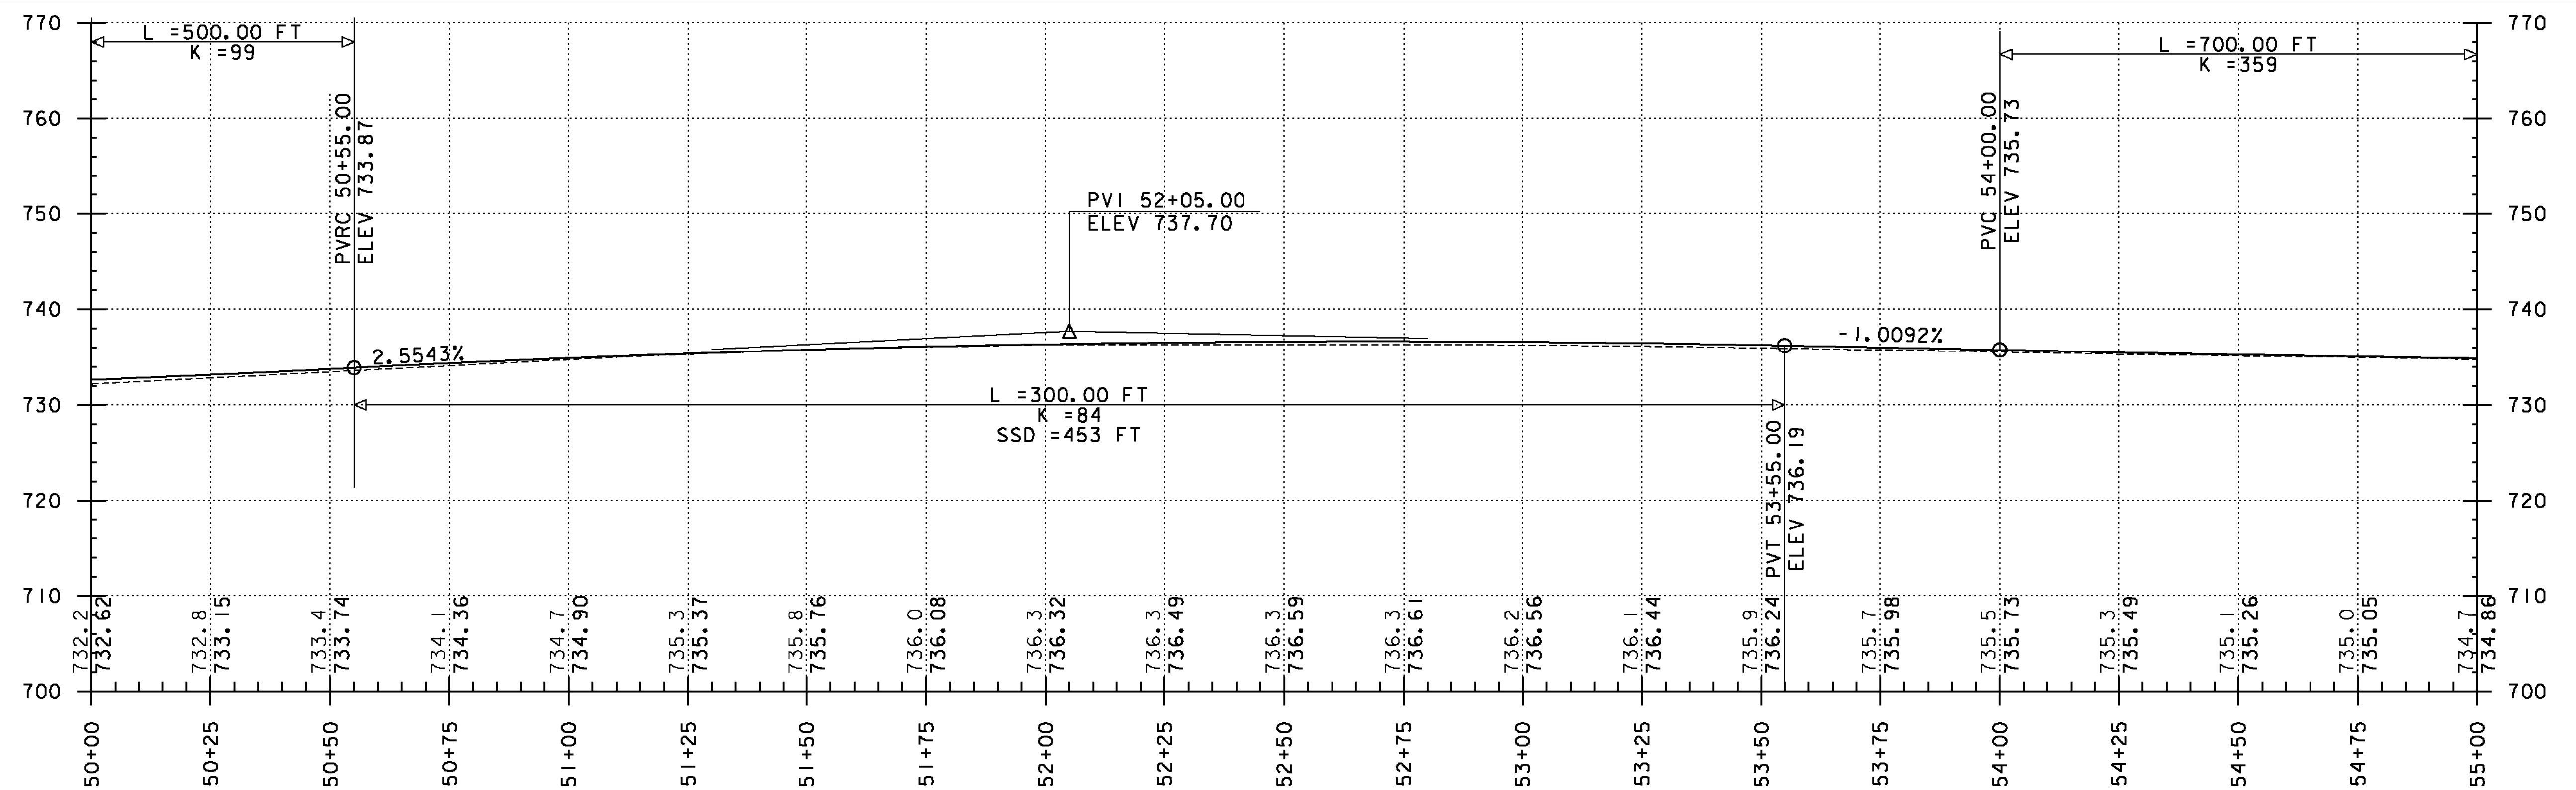


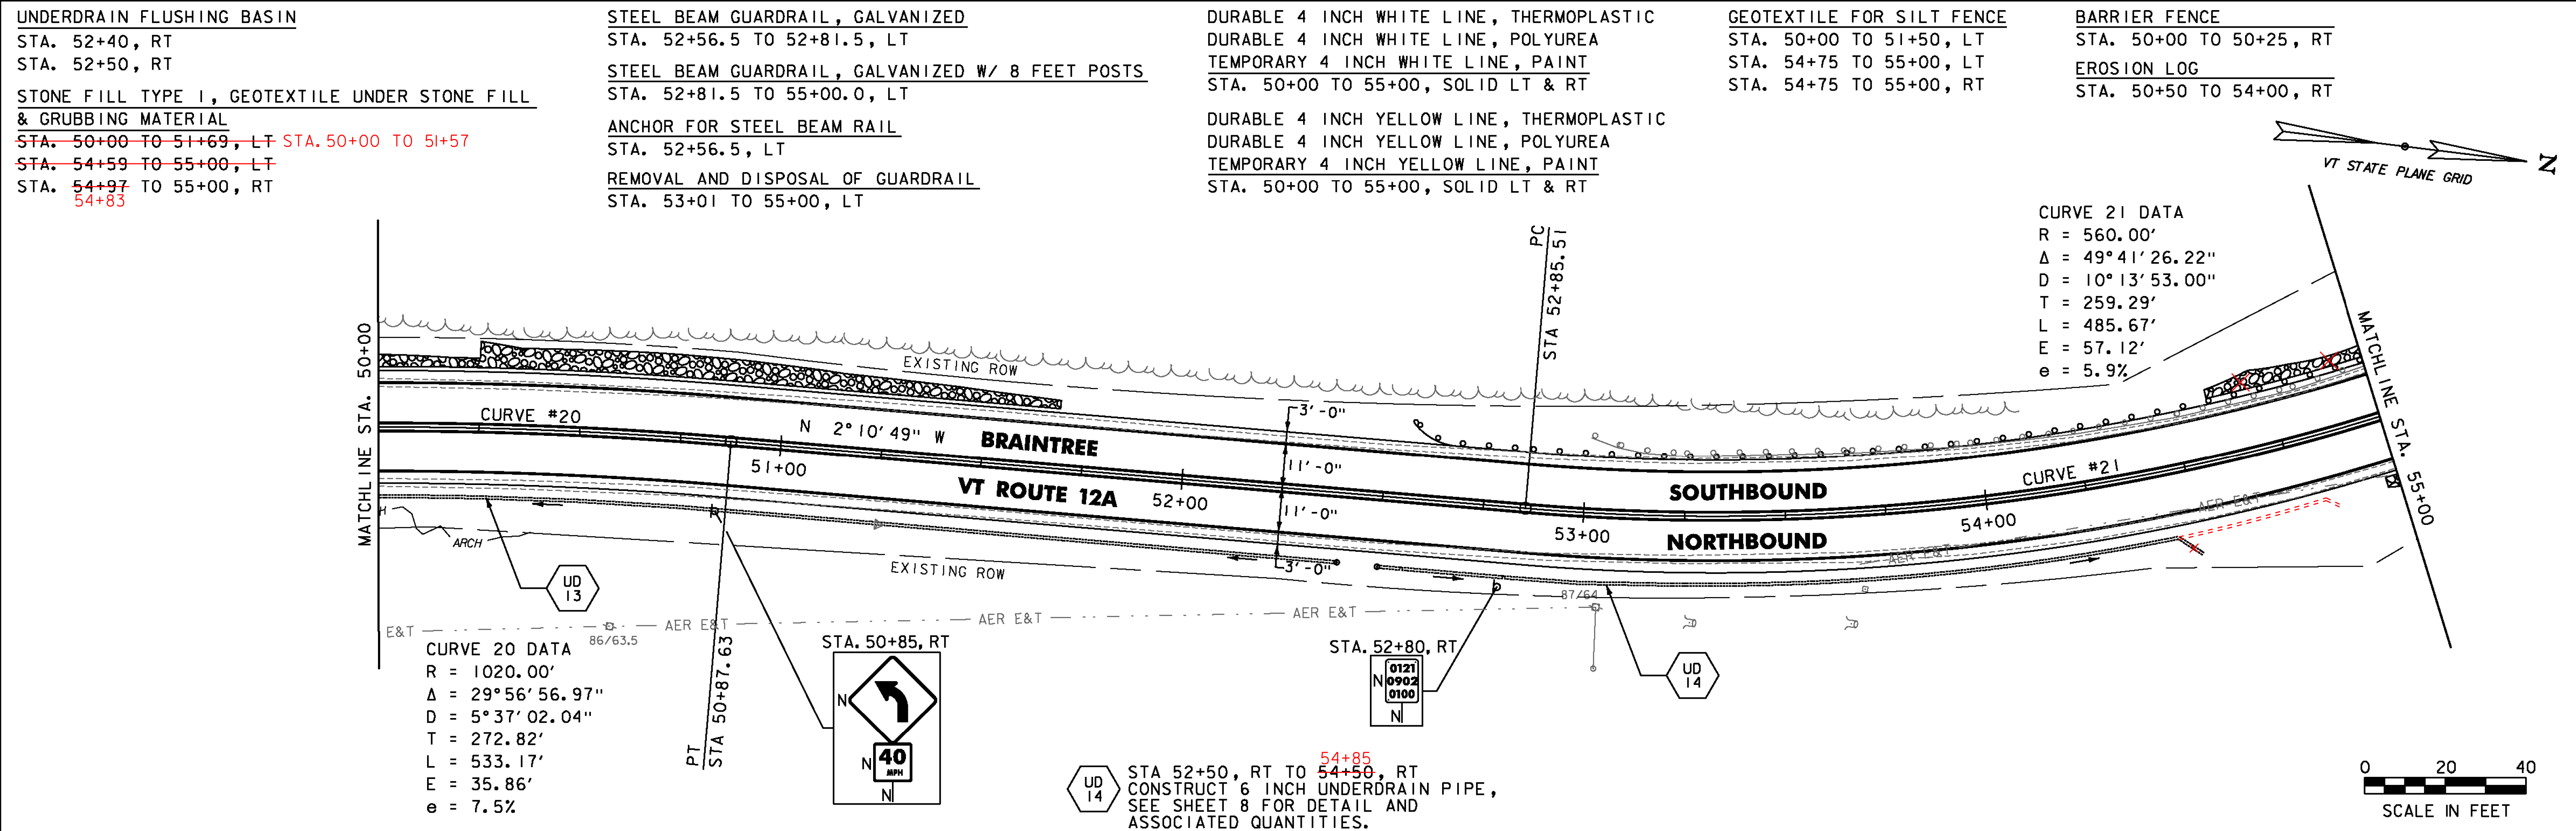

PROJECT NAME: RANDOLPH-ROXBURY
PROJECT NUMBER: ER STP 0187(III)

FILE NAME: z13cl82bdr.dgn
PROJECT LEADER: M. FOISY
DESIGNED BY: I. MAYNARD
PLAN & PROFILE SHEET 20

PLOT DATE: 11/17/2014
DRAWN BY: G. BURMEIER
CHECKED BY: M. FOISY
SHEET 61 OF 545