

SOLID ROCK EXCAVATION

~~STA. 75+15 TO 75+45, RT~~ ~~STA. 75+80 TO 75+50, RT~~
~~STA. 77+25 TO 80+00, RT~~ ~~STA. 76+75 TO 79+25, RT~~

UNDERDRAIN FLUSHING BASIN

STA. 79+30, RT

CURVE 23 DATA
R = 2450.00'
 $\Delta = 13^\circ 58' 15.68''$
D = $2^\circ 20' 18.97''$
T = 300.19'
L = 597.41'
E = 18.32'
e = 4.3%

~~STONE FILL TYPE 1, GEOTEXTILE UNDER STONE FILL~~
~~& GRUBBING MATERIAL~~

~~STA. 79+66 TO 80+00, LT~~

STEEL BEAM GUARDRAIL, GALVANIZED W/ 8 FEET POSTS

STA. 75+00.0 TO 80+00.0, LT

REMOVAL AND DISPOSAL OF GUARDRAIL

STA. 75+00 TO 80+00, LT

DURABLE 4 INCH WHITE LINE, THERMOPLASTIC

DURABLE 4 INCH WHITE LINE, POLYUREA

TEMPORARY 4 INCH WHITE LINE, PAINT

STA. 75+00 TO 80+00, SOLID LT & RT

STEEL BEAM GUARDRAIL

STA. 79+47.9 TO 80+00 LT

DURABLE 4 INCH YELLOW LINE, THERMOPLASTIC





DURABLE 4 INCH YELLOW LINE, POLYUREA

TEMPORARY 4 INCH YELLOW LINE, PAINT

STA. 75+00 TO 80+00, SOLID LT & RT

EROSION LOG

STA. 75+00 TO 80+00, RT

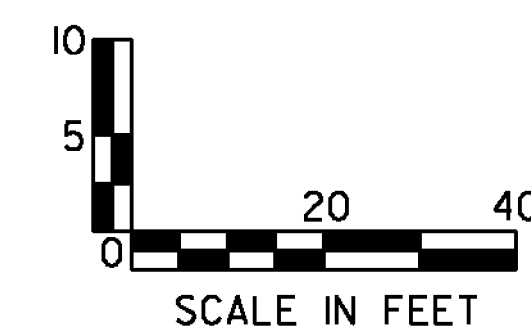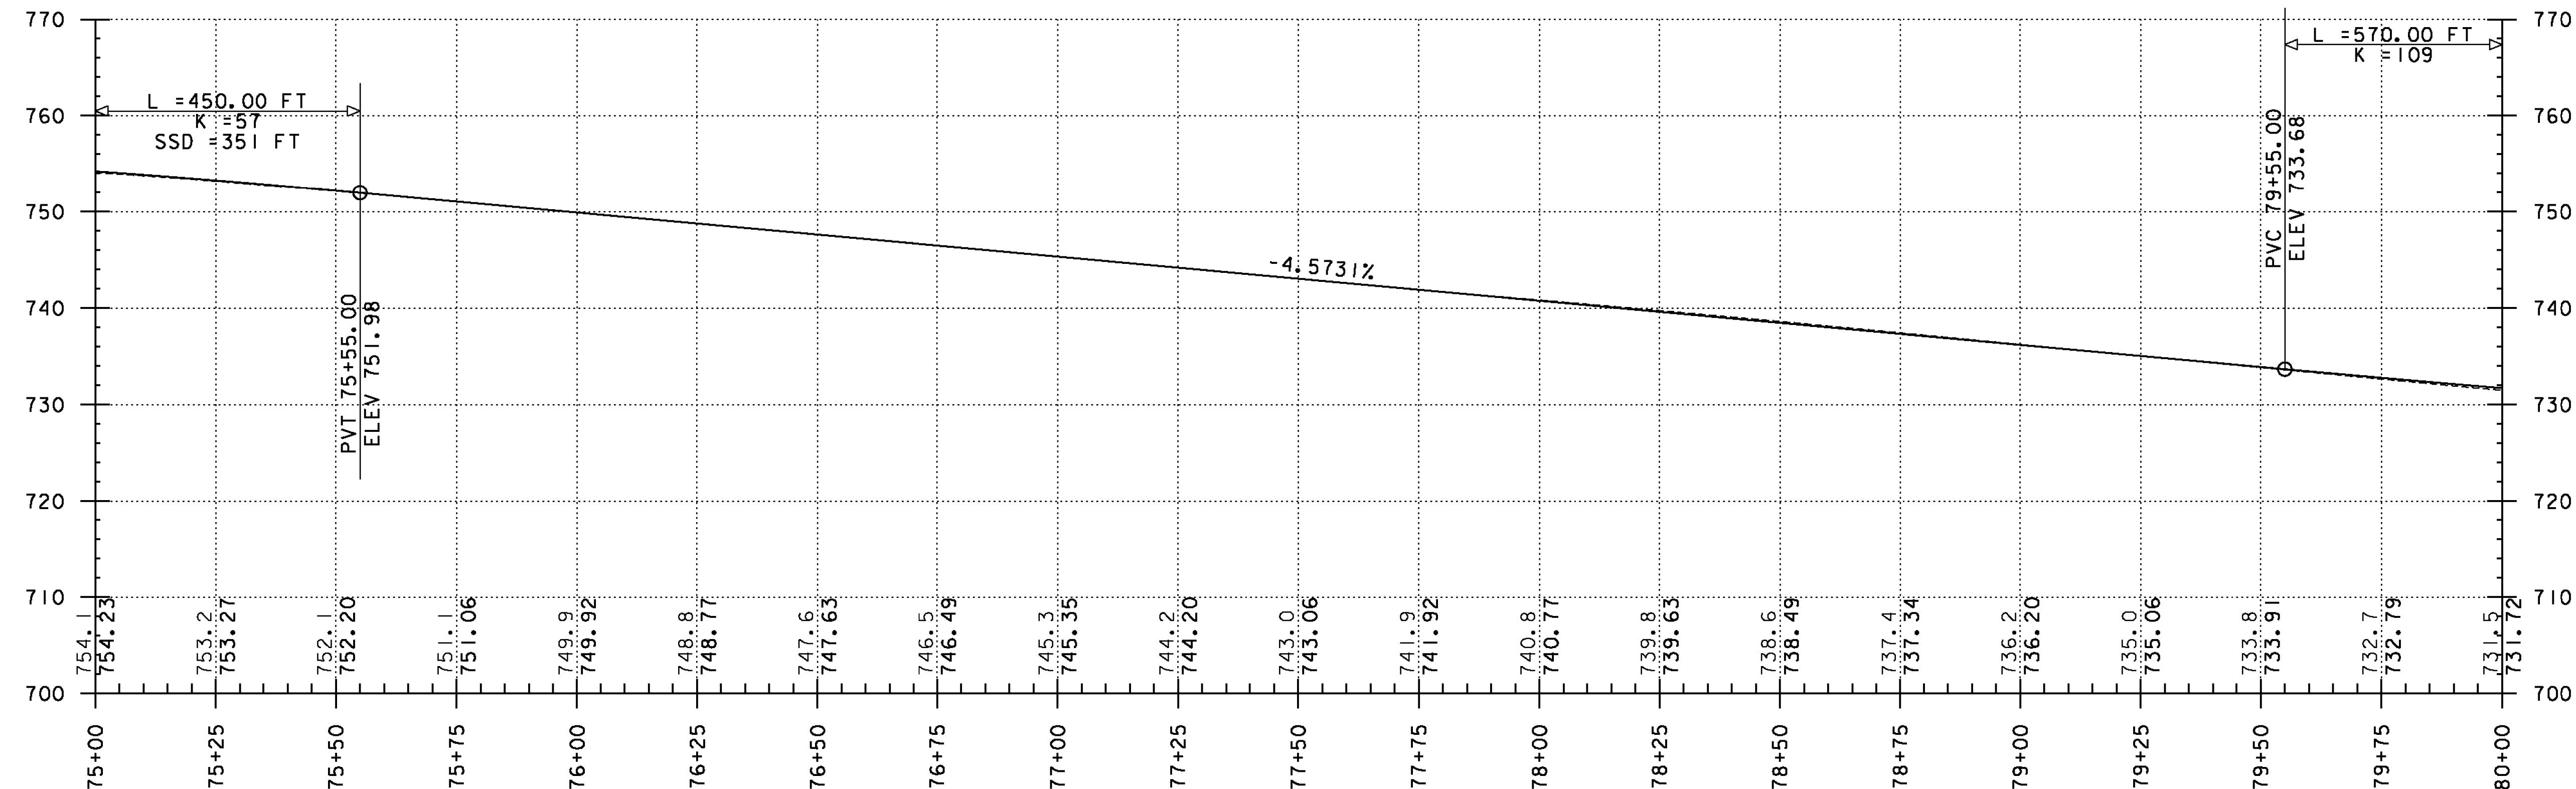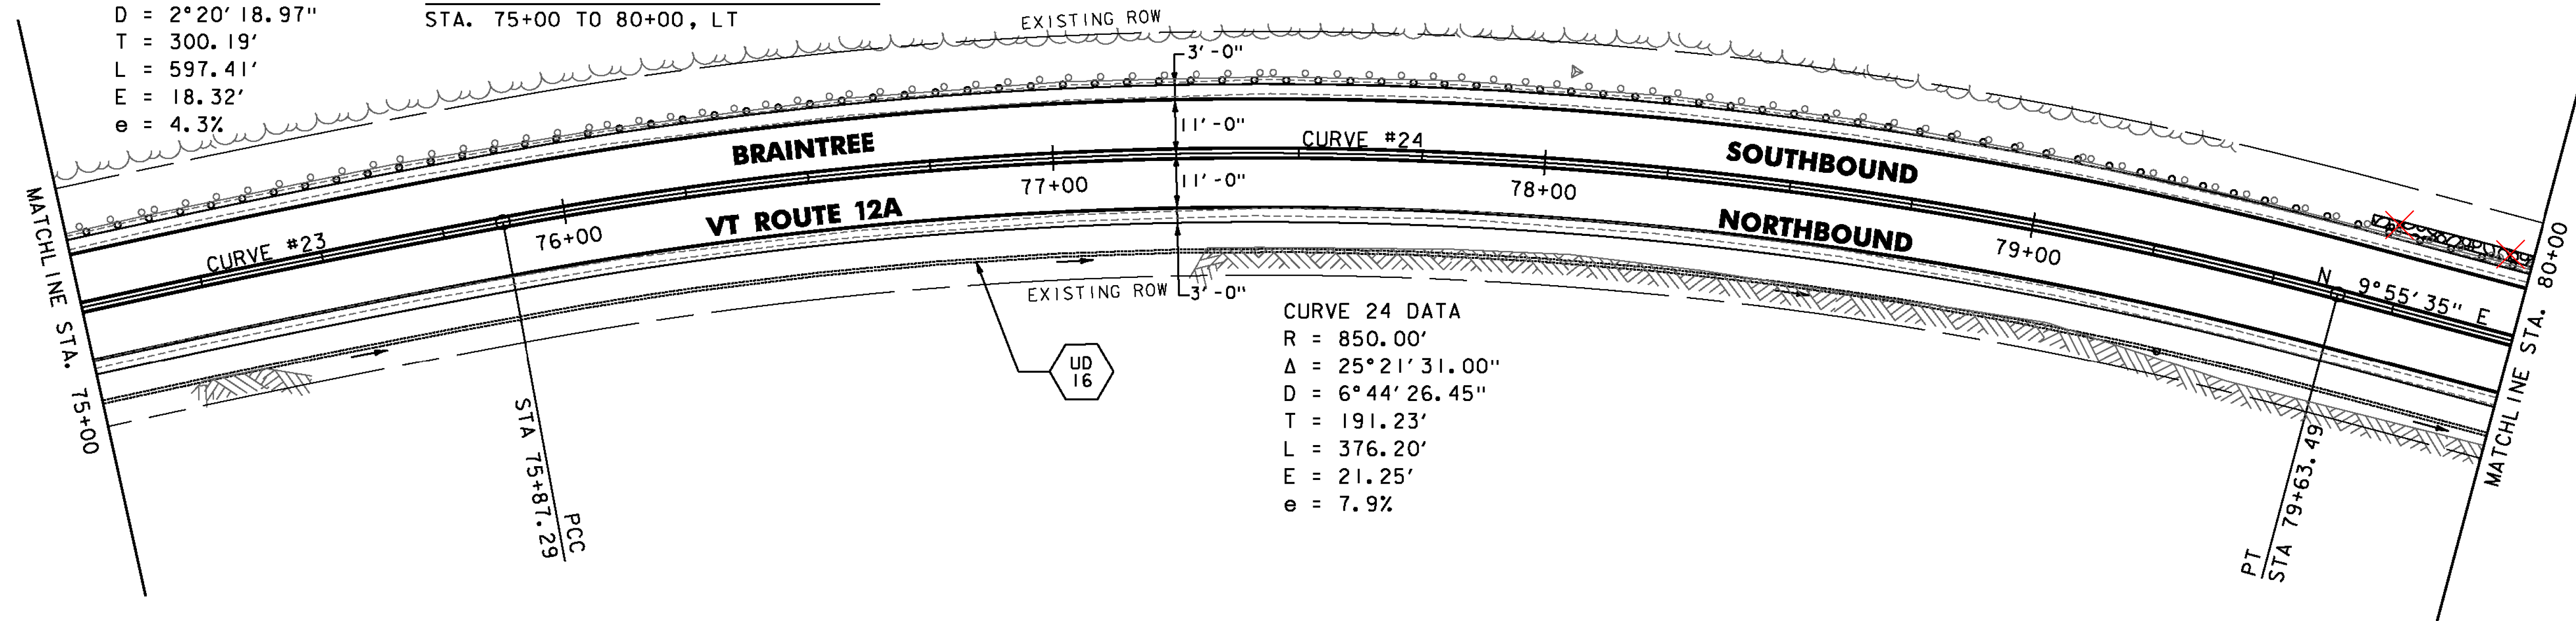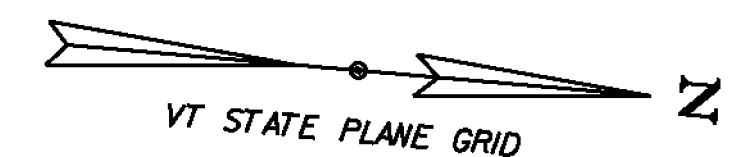

PROJECT NAME: RANDOLPH-ROXBURY
PROJECT NUMBER: ER STP 0187(III)

FILE NAME: z13cl82bdr.dgn
PROJECT LEADER: M. FOISY
DESIGNED BY: I. MAYNARD
PLAN & PROFILE SHEET 25

PLOT DATE: 11/17/2014
DRAWN BY: G. BURGMEIER
CHECKED BY: M. FOISY
SHEET 66 OF 545