
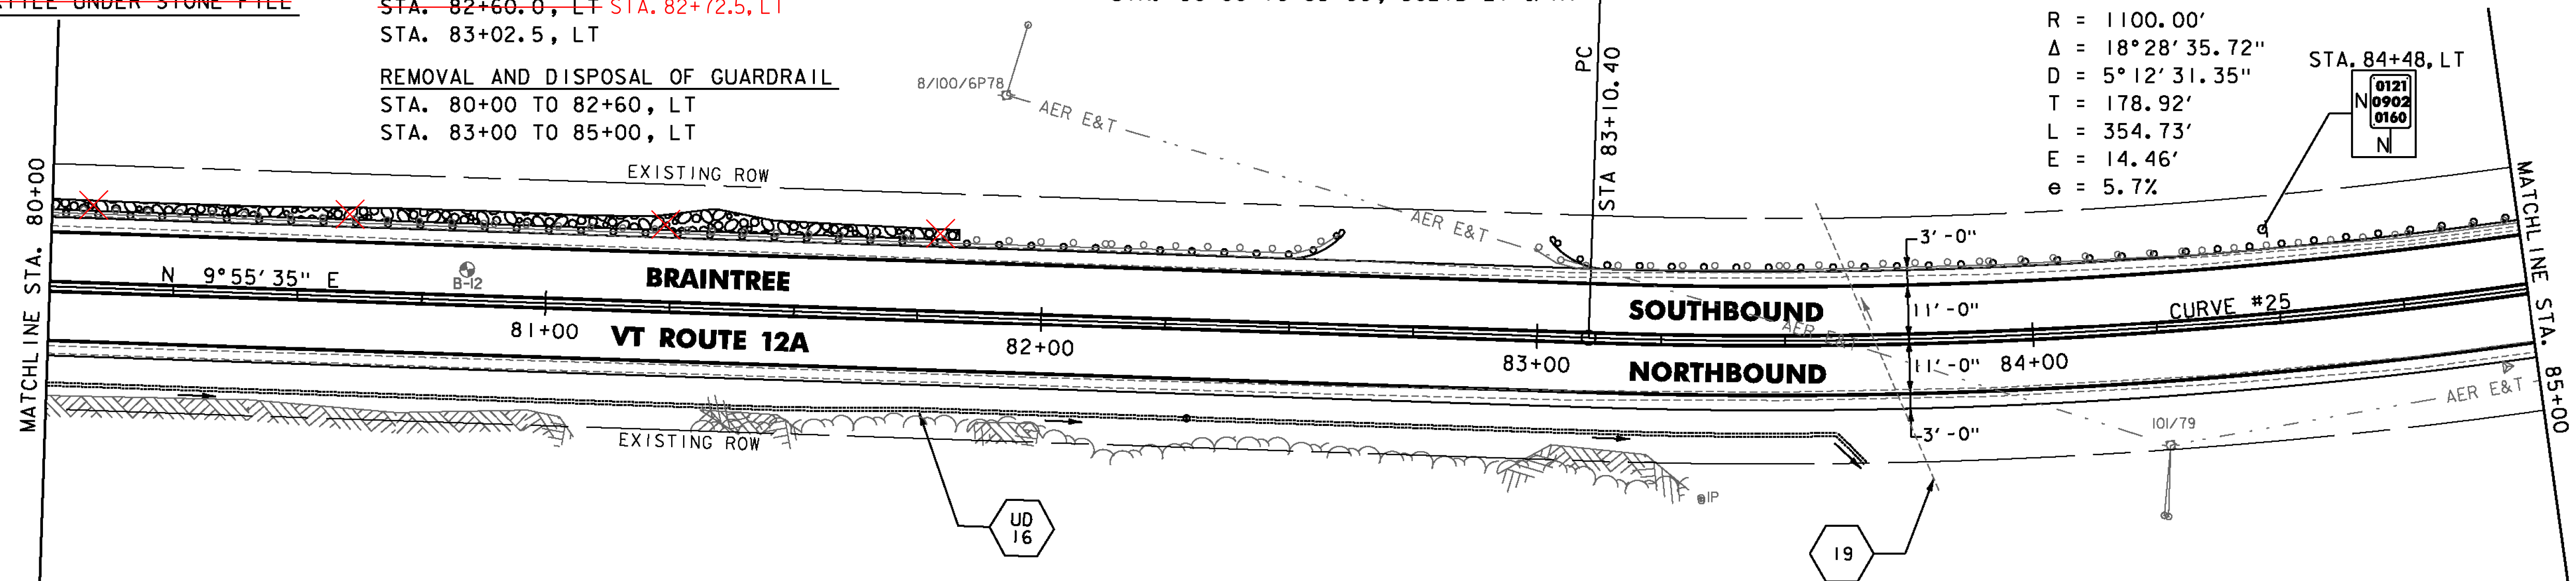


~~SOLID ROCK EXCAVATION~~  
~~STA. 80+00 TO 81+10, RT~~  
~~STA. 81+30 TO 81+55, RT~~  
~~STA. 81+85 TO 82+00, RT~~  
~~STA. 82+90 TO 83+30, RT~~  
~~UNDERDRAIN FLUSHING BASIN~~  
~~STA. 82+30, RT~~  
~~STONE FILL TYPE I, GEOTEXTILE UNDER STONE FILL~~  
~~& GRUBBING MATERIAL~~  
~~STA. 80+00 TO 81+83, LT~~

STEEL BEAM GUARDRAIL, GALVANIZED  
~~STA. 82+10.0 TO 82+60.0, LT~~ STA. 80+00 TO 82+72.5, LT  
~~STA. 83+02.5 TO 83+27.5, LT~~ STA. 83+02.5 TO 83+15.0, LT  
  
STEEL BEAM GUARDRAIL, GALVANIZED W/ 8 FEET POSTS  
~~STA. 80+00.0 TO 82+10.0, LT~~ STA. 83+15.0 TO 85+00.0, LT  
~~STA. 83+27.5 TO 85+00.0, LT~~  
  
ANCHOR FOR STEEL BEAM RAIL  
~~STA. 82+60.0, LT~~ STA. 82+72.5, LT  
STA. 83+02.5, LT  
  
REMOVAL AND DISPOSAL OF GUARDRAIL  
STA. 80+00 TO 82+60, LT  
STA. 83+00 TO 85+00, LT




DURABLE 4 INCH WHITE LINE, THERMOPLASTIC  
DURABLE 4 INCH WHITE LINE, POLYUREA  
TEMPORARY 4 INCH WHITE LINE, PAINT  
STA. 80+00 TO 85+00, SOLID LT & RT  
  
DURABLE 4 INCH YELLOW LINE, THERMOPLASTIC  
DURABLE 4 INCH YELLOW LINE, POLYUREA  
TEMPORARY 4 INCH YELLOW LINE, PAINT  
STA. 80+00 TO 85+00, SOLID LT & RT

EROSION LOG  
STA. 80+00 TO 83+50, RT

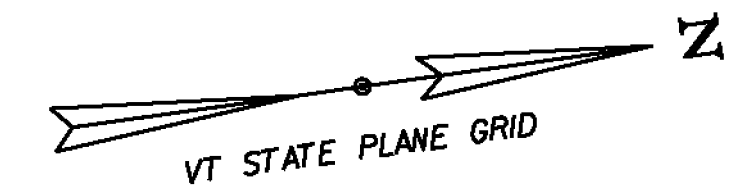

| SOIL BORING DATA |             |     |          |
|------------------|-------------|-----|----------|
| BORING#          | DEPTH (FT.) | PCC | COMMENTS |
| B-12             | 5.0'        | NO  |          |

NOTE:  
1. REFER TO SHEET 27 OF 545  
FOR CULVERT INFORMATION.

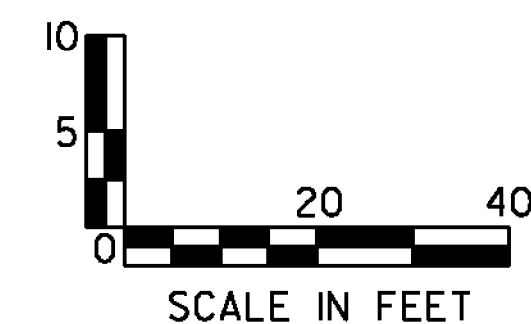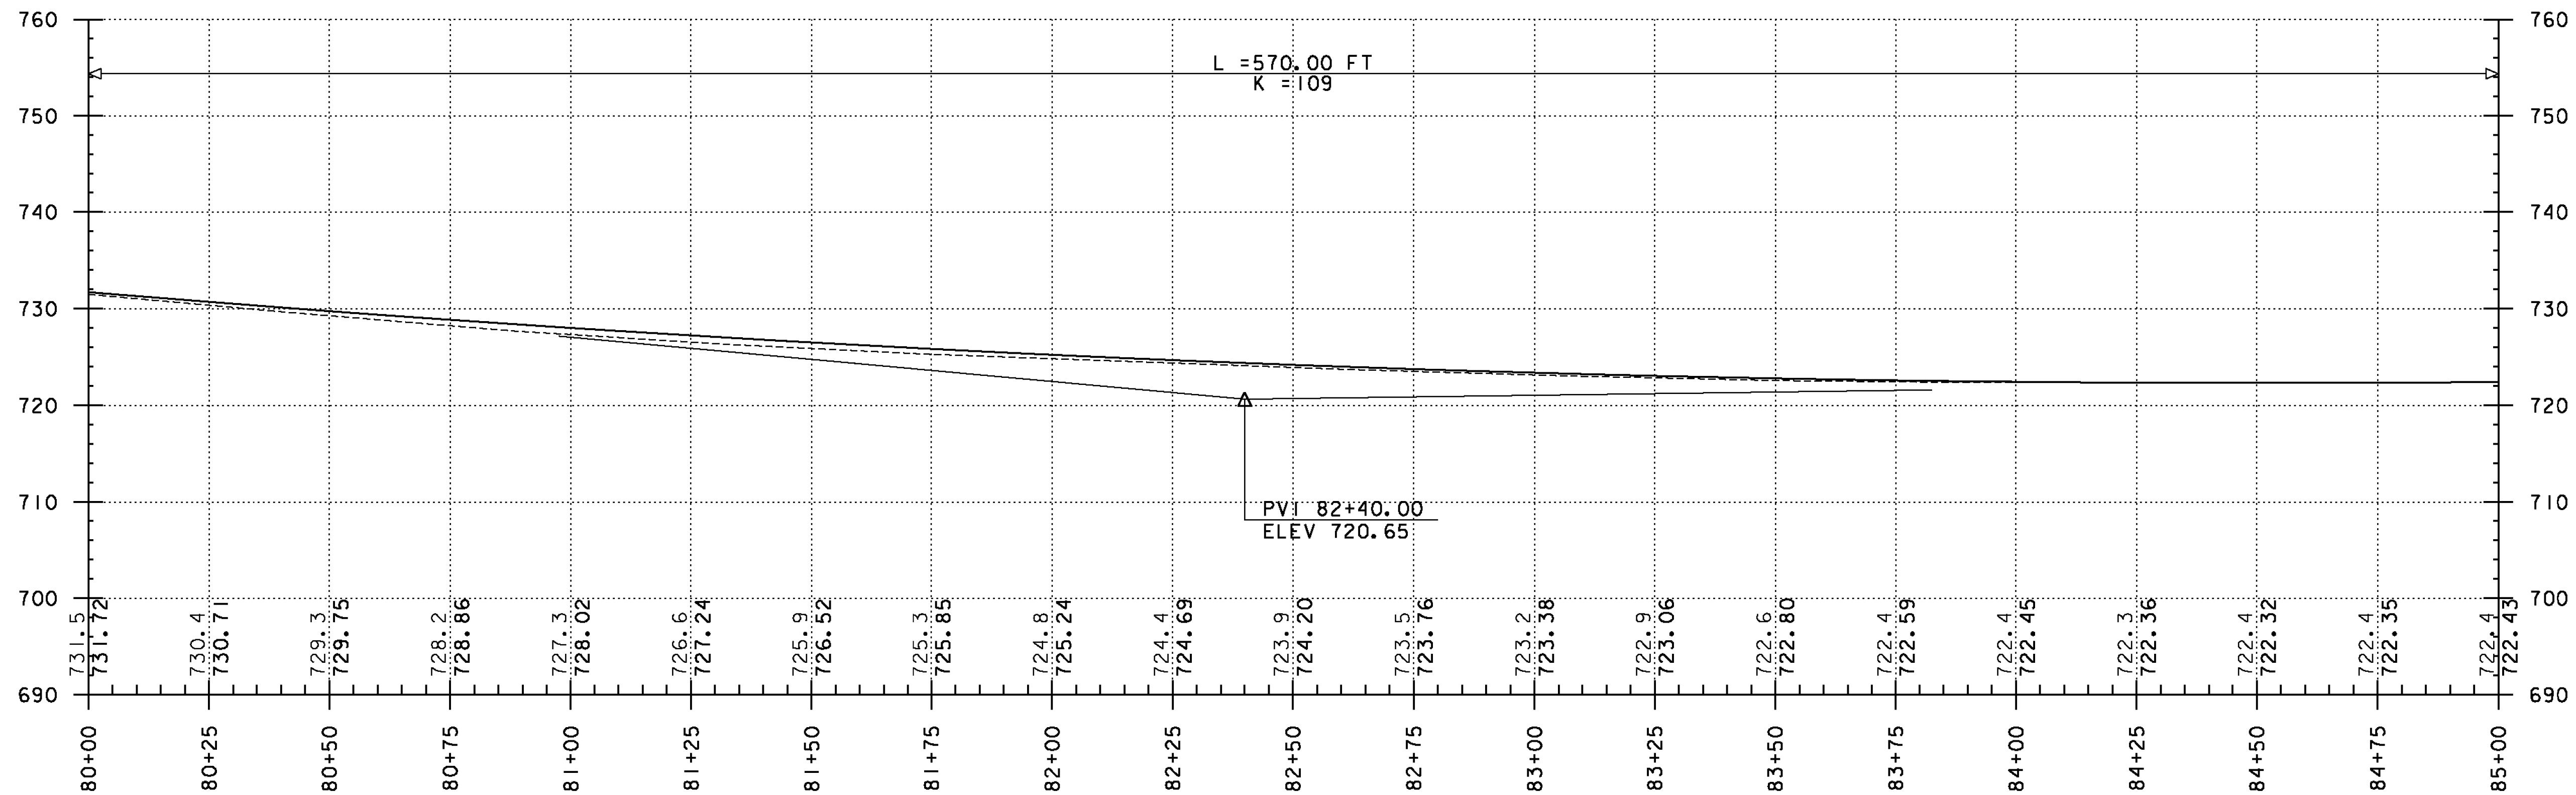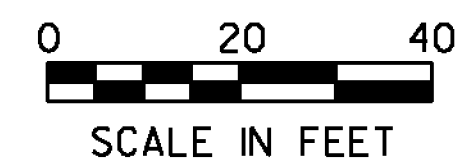

PROJECT NAME: RANDOLPH-ROXBURY  
PROJECT NUMBER: ER STP 0187(III)  
  
FILE NAME: z13cl82bdr.dgn  
PROJECT LEADER: M. FOISY  
DESIGNED BY: I. MAYNARD  
**PLAN & PROFILE SHEET 26**  
  
PLOT DATE: 11/17/2014  
DRAWN BY: G. BURGMEIER  
CHECKED BY: M. FOISY  
SHEET 67 OF 545