

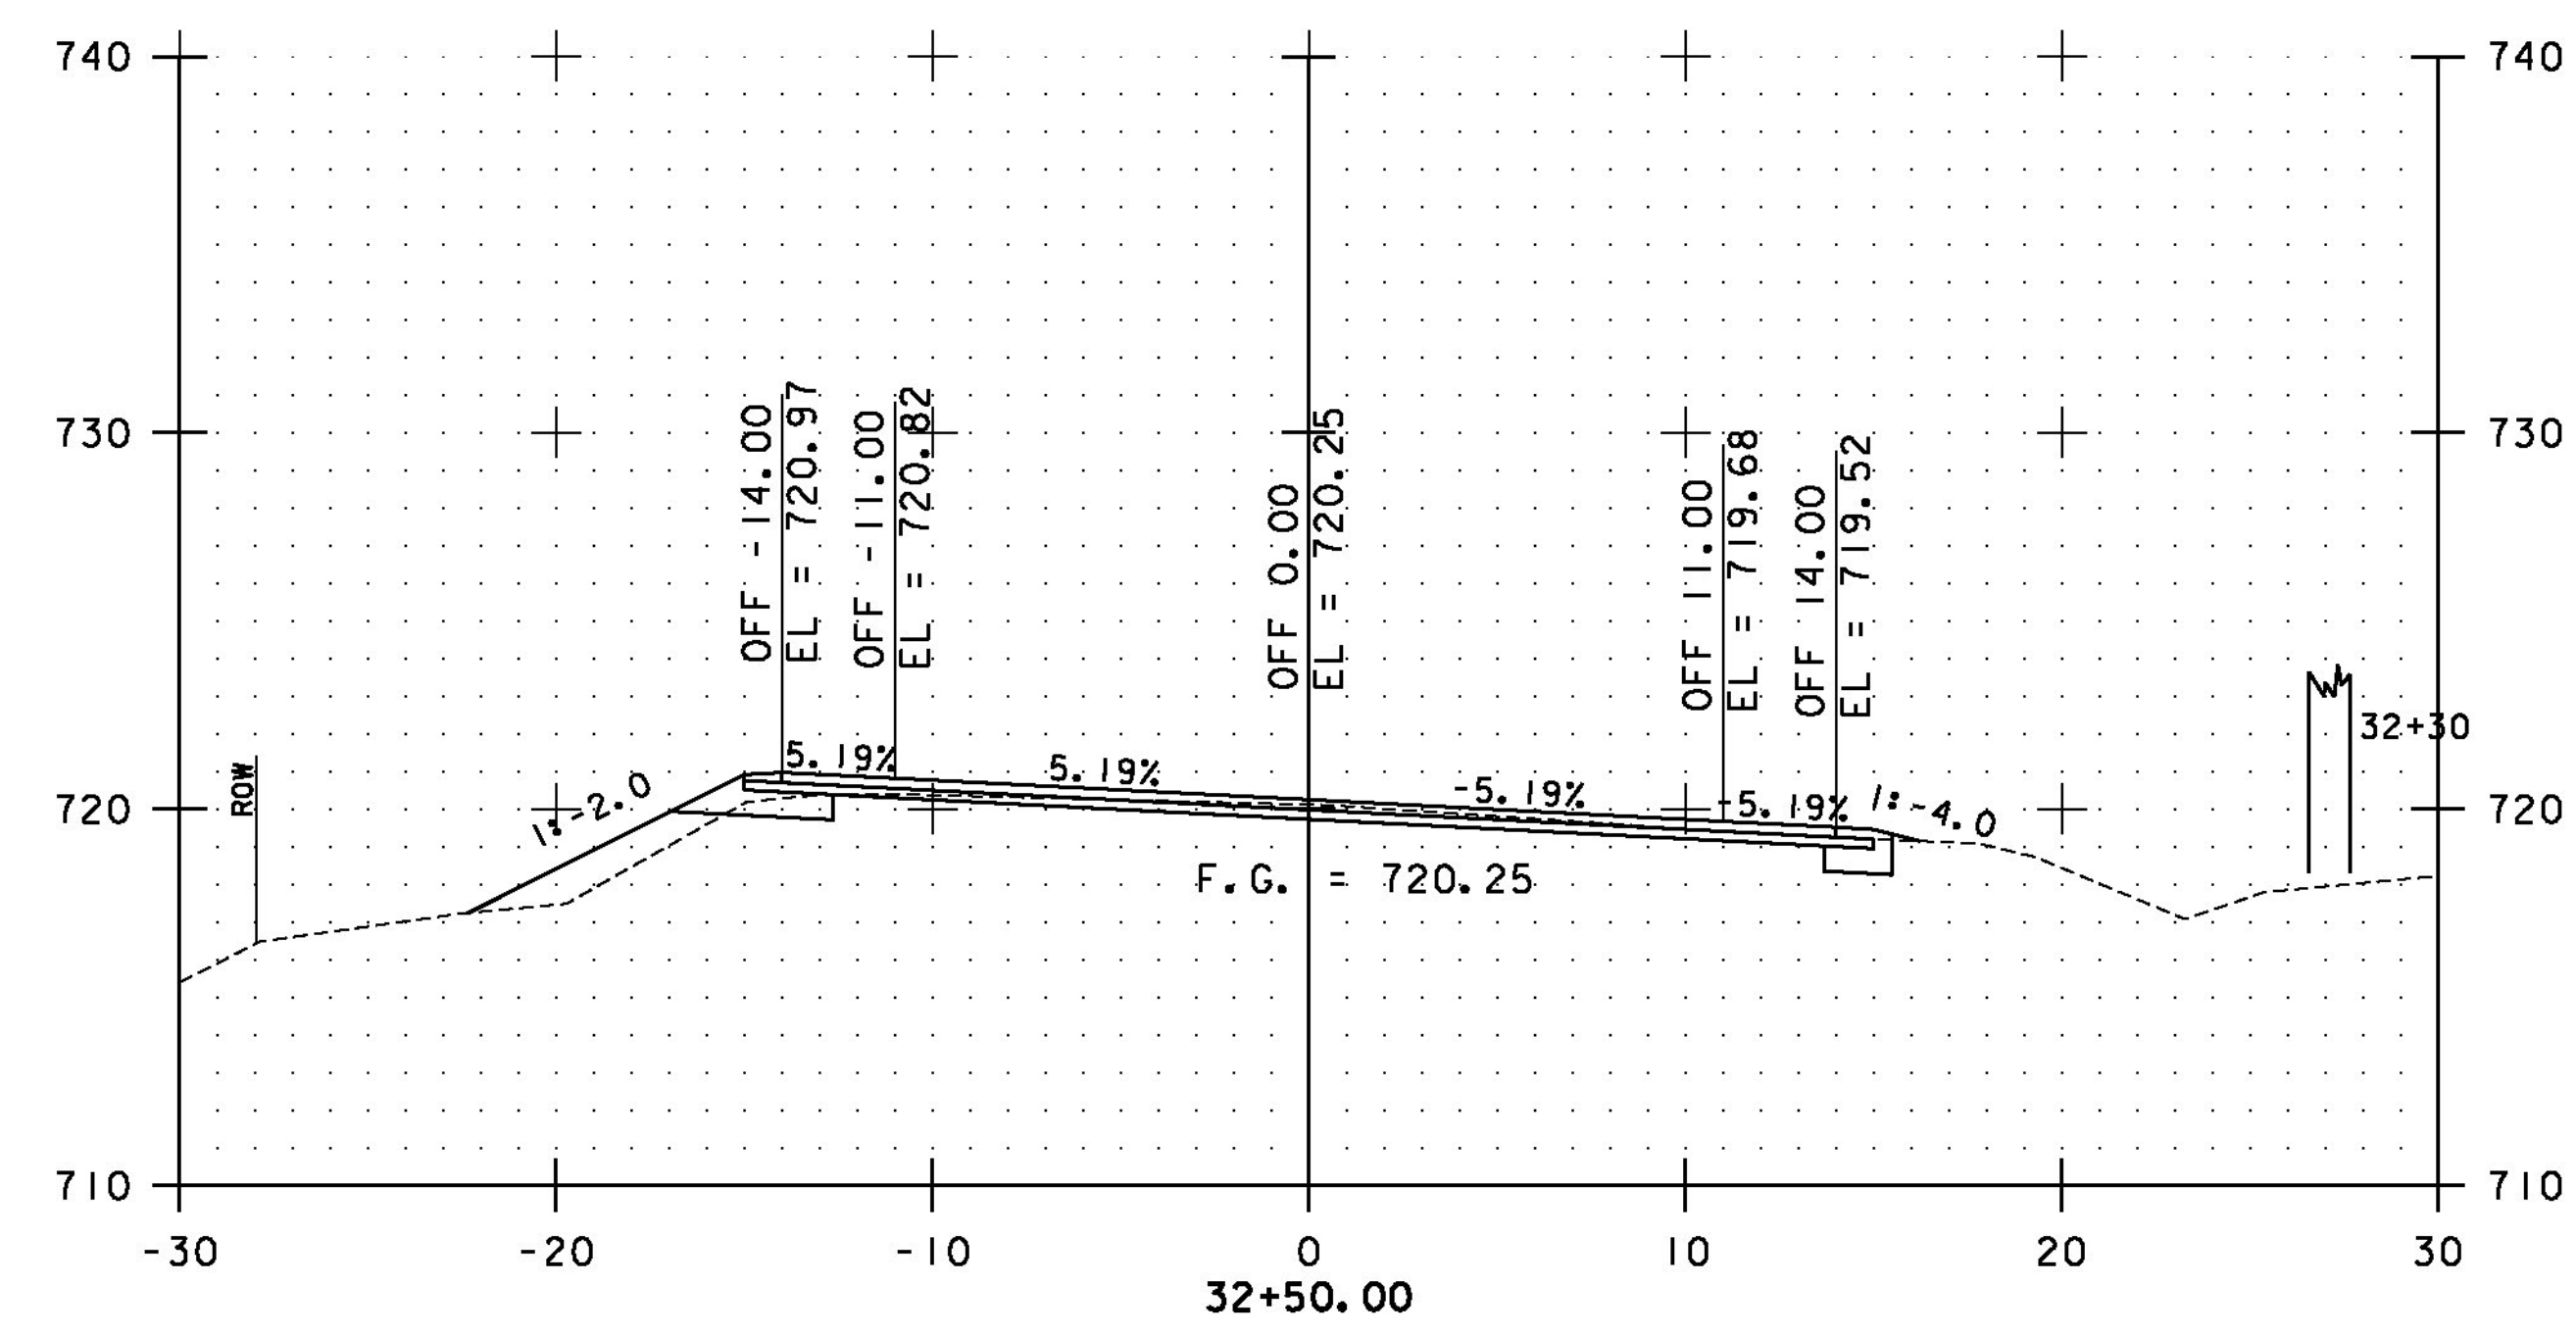
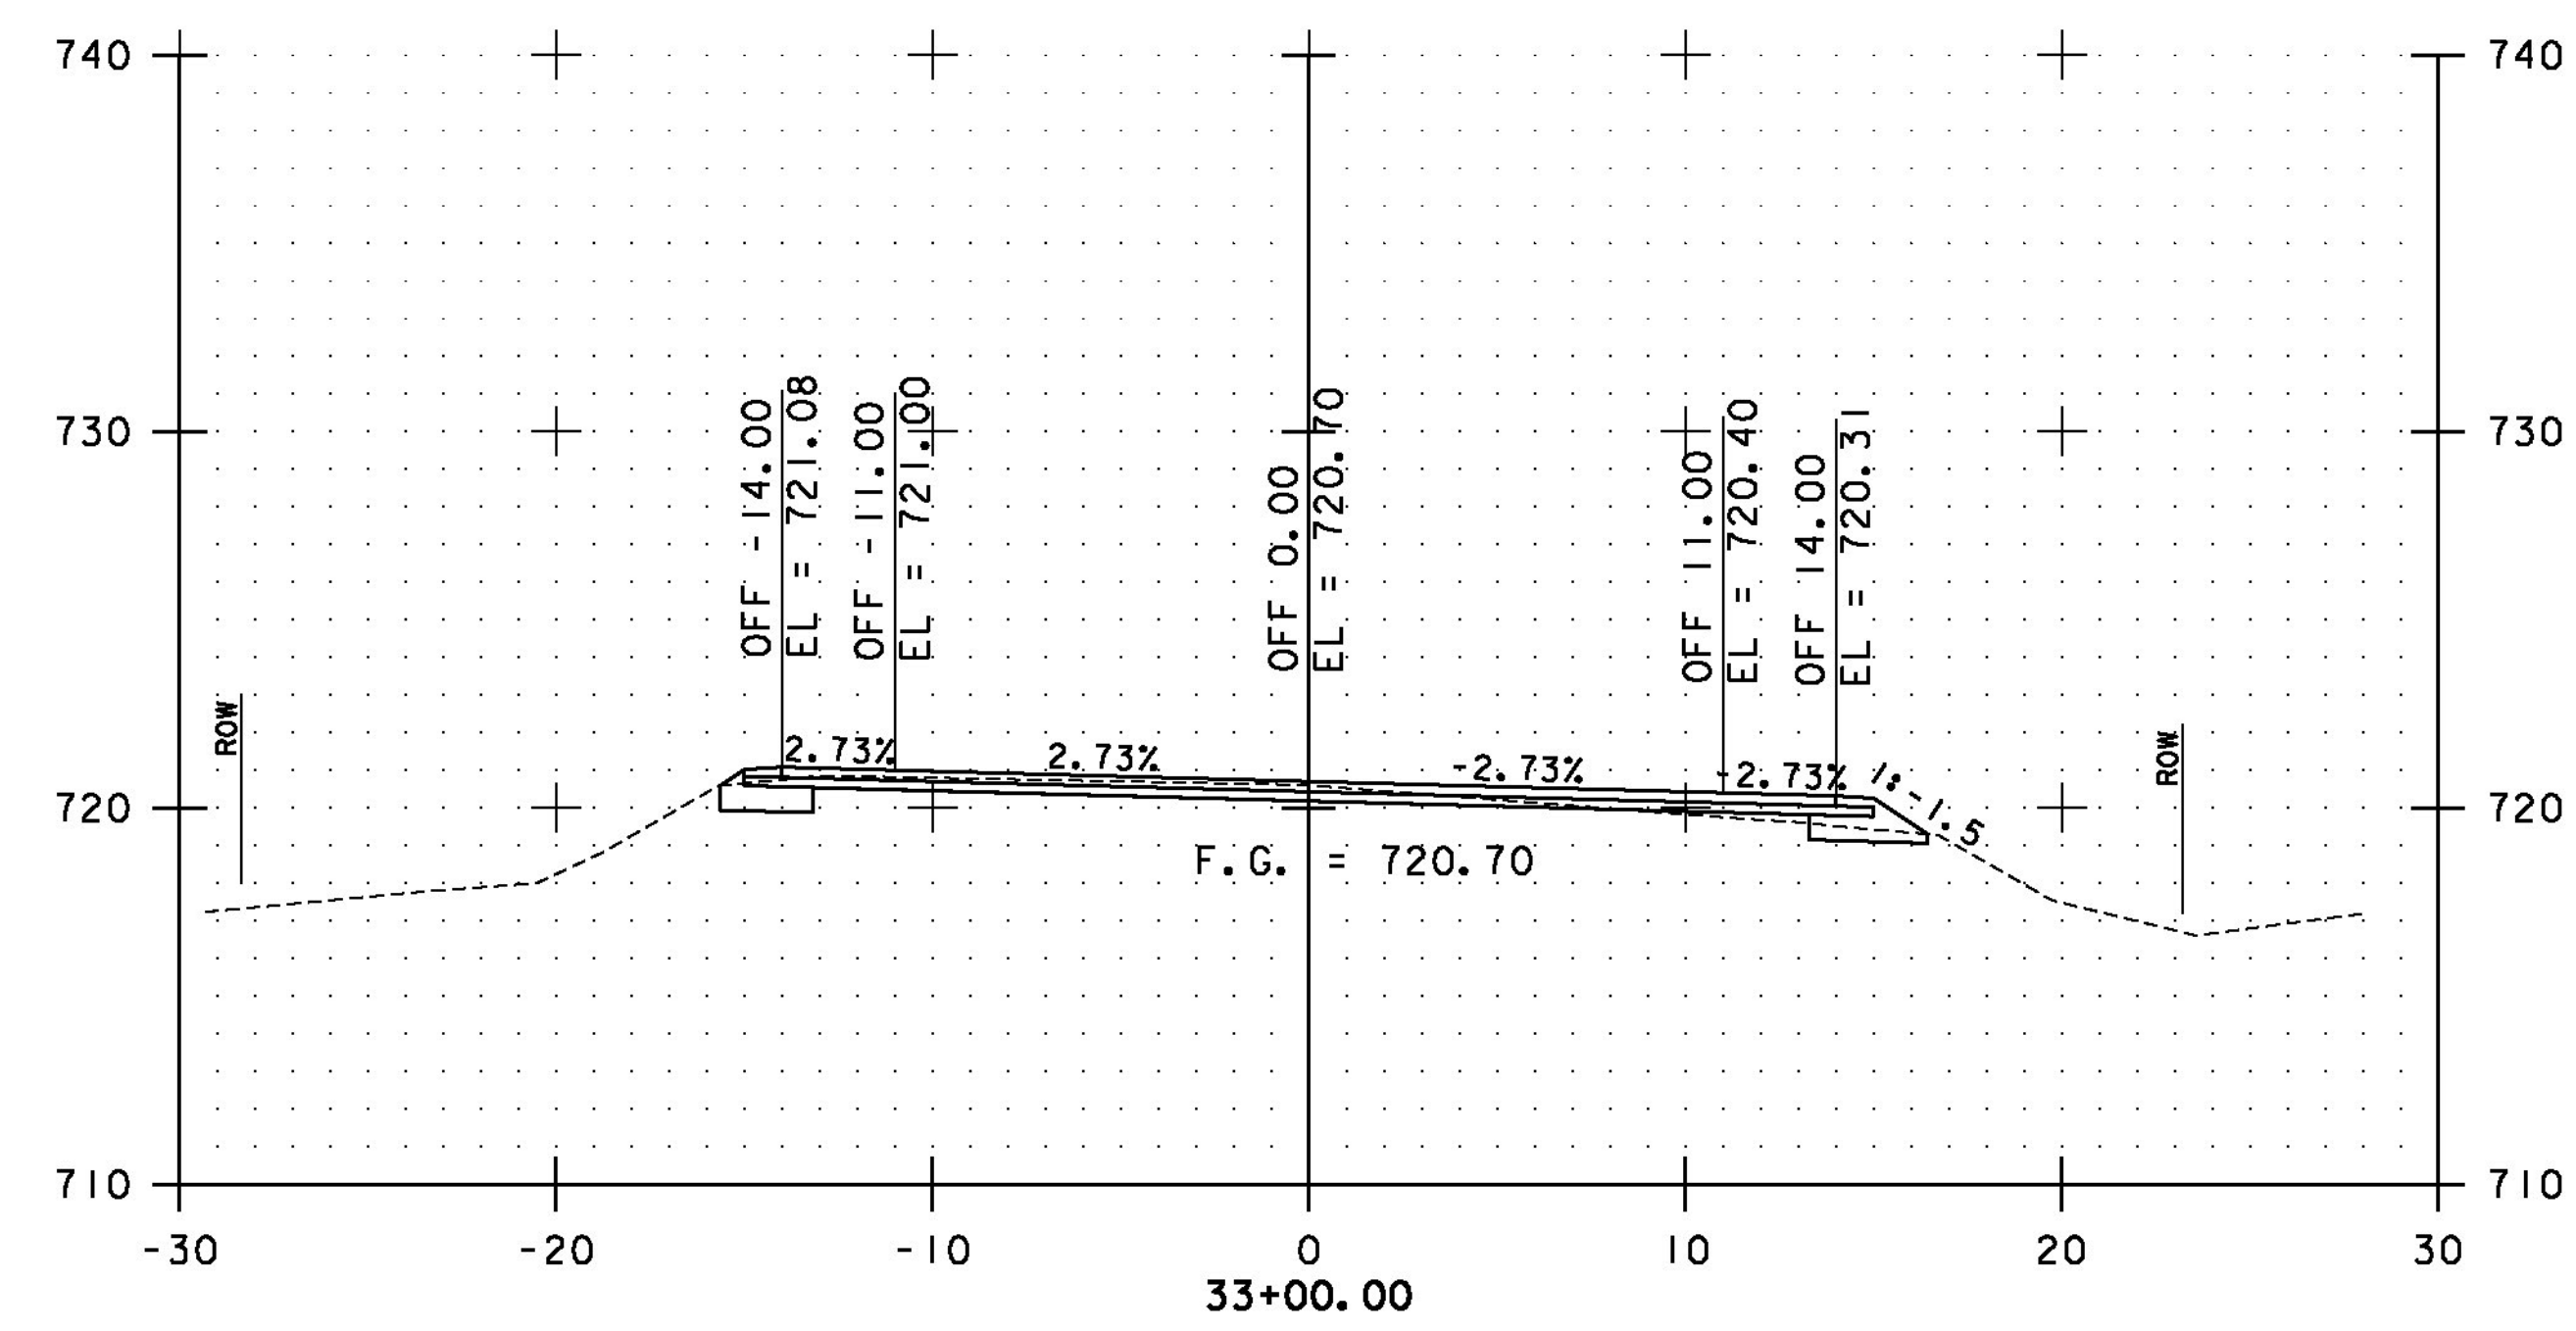


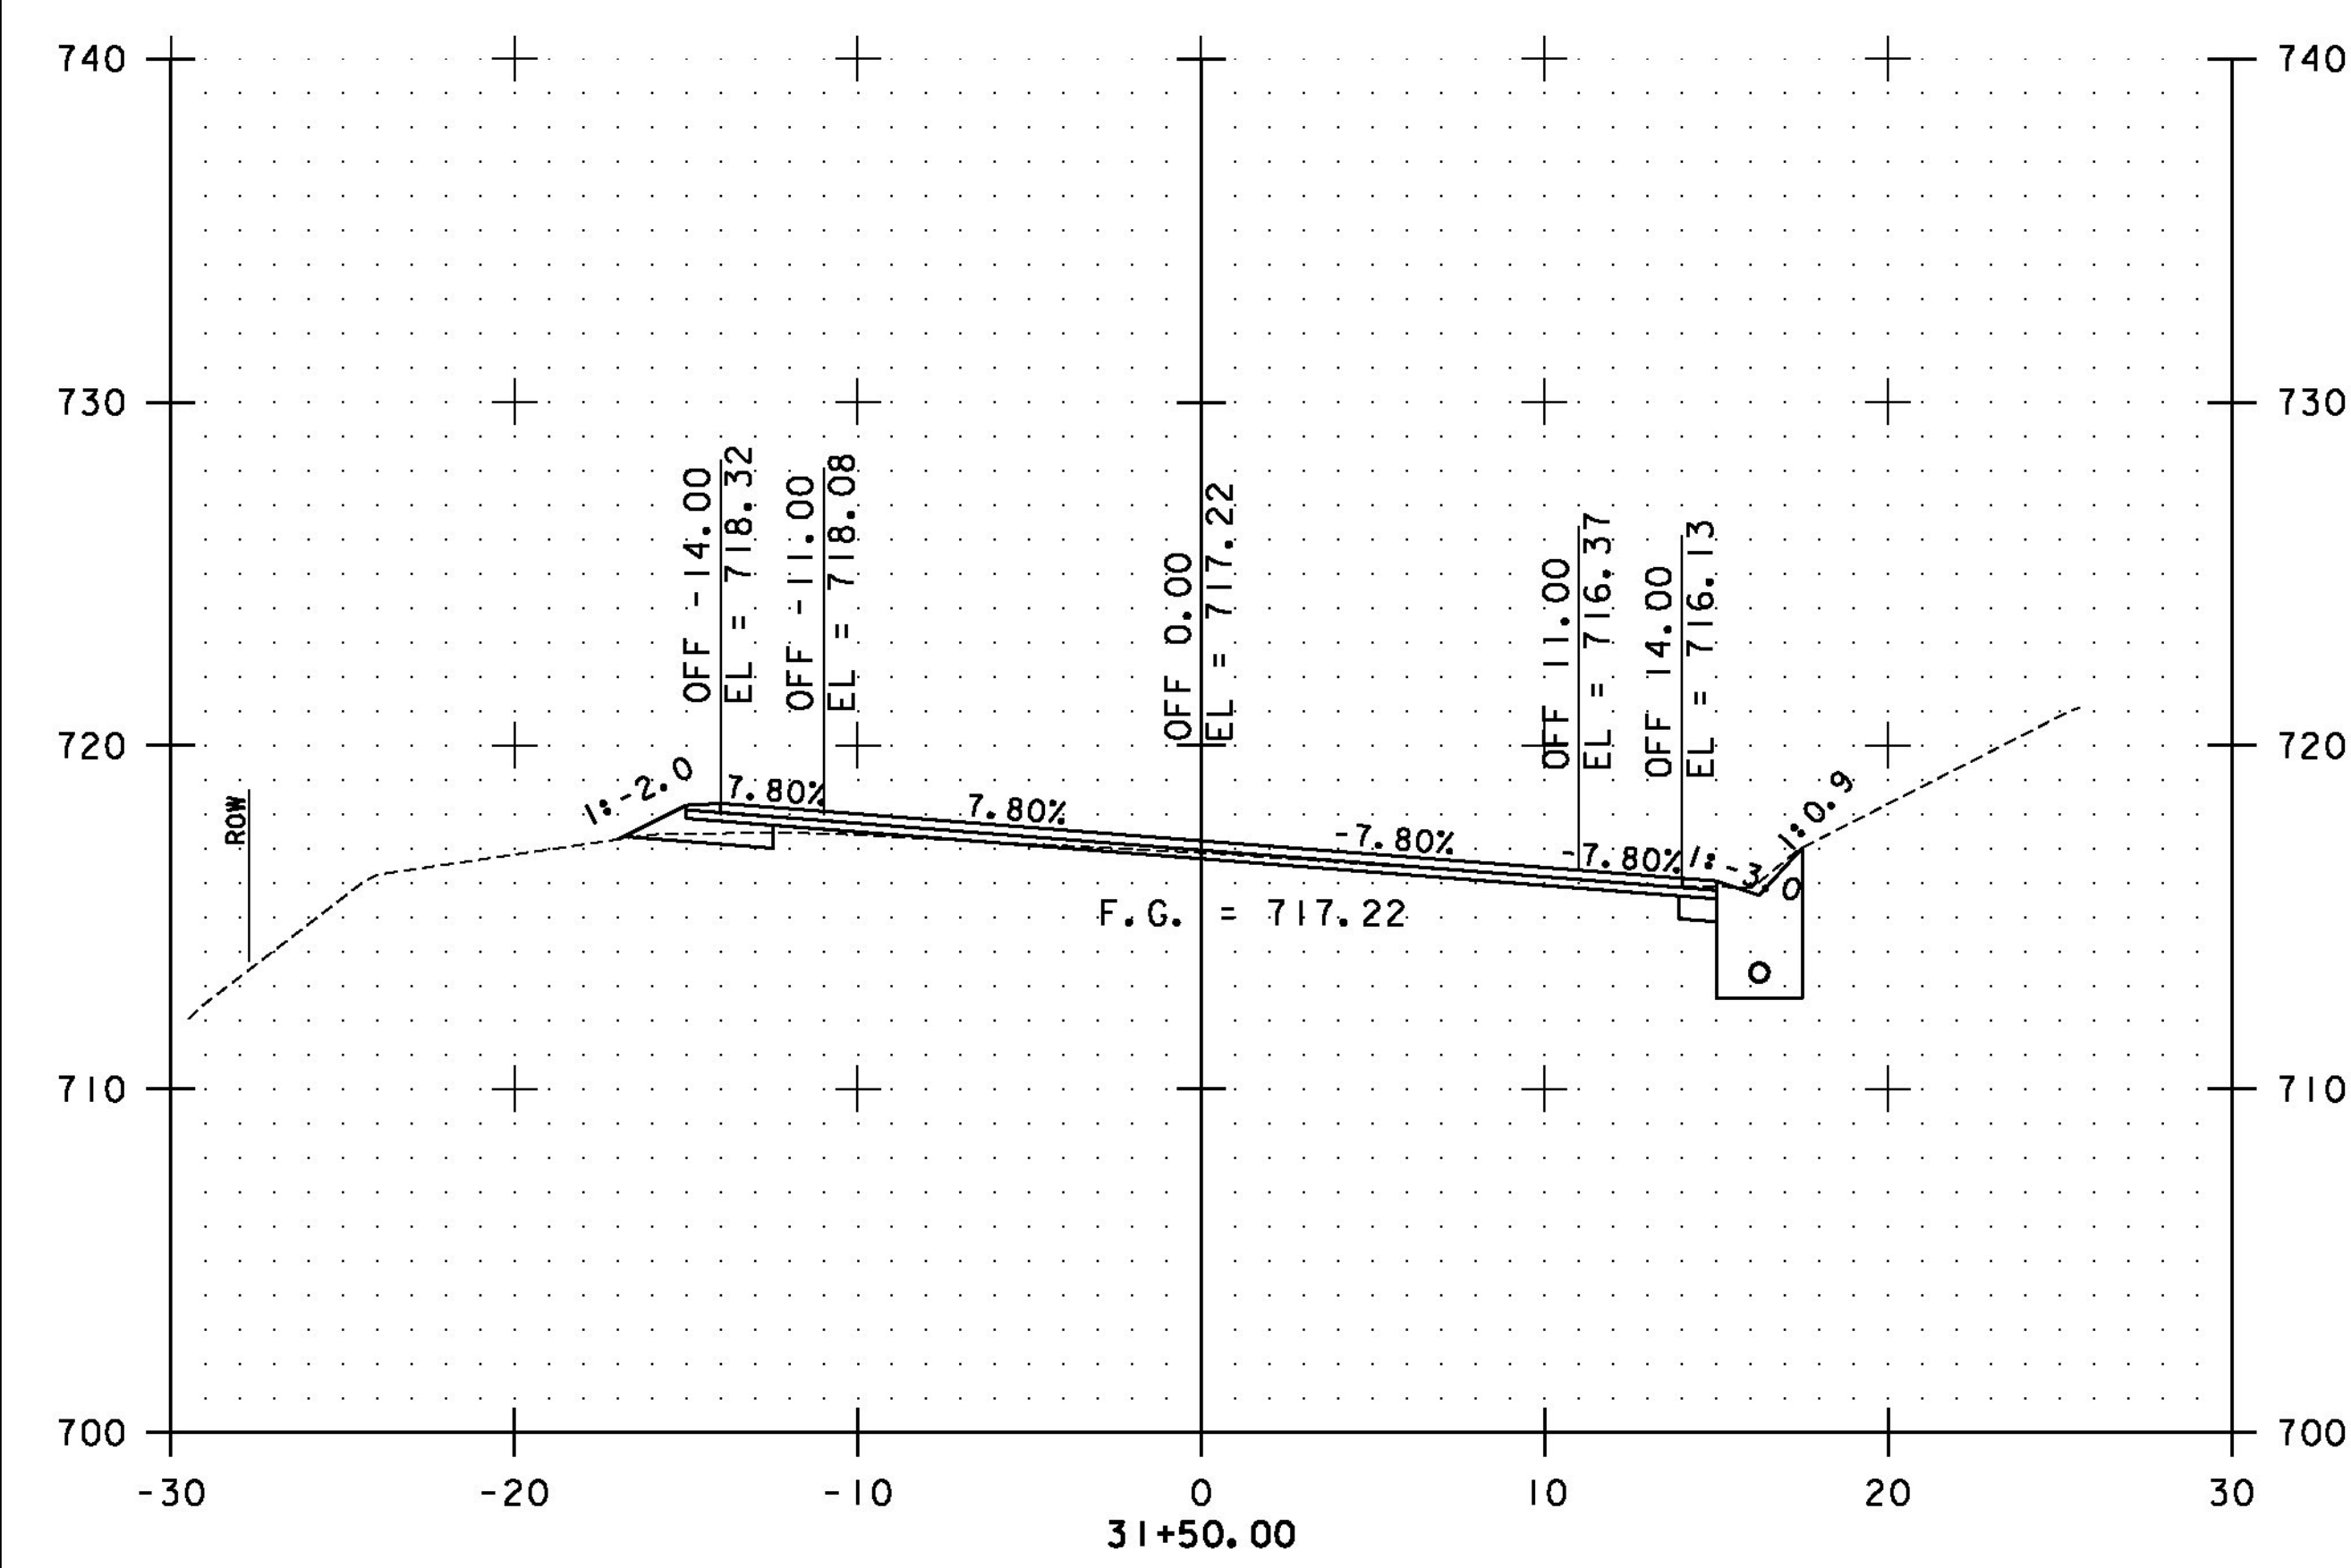

STA. 31+50 TO STA. 33+00

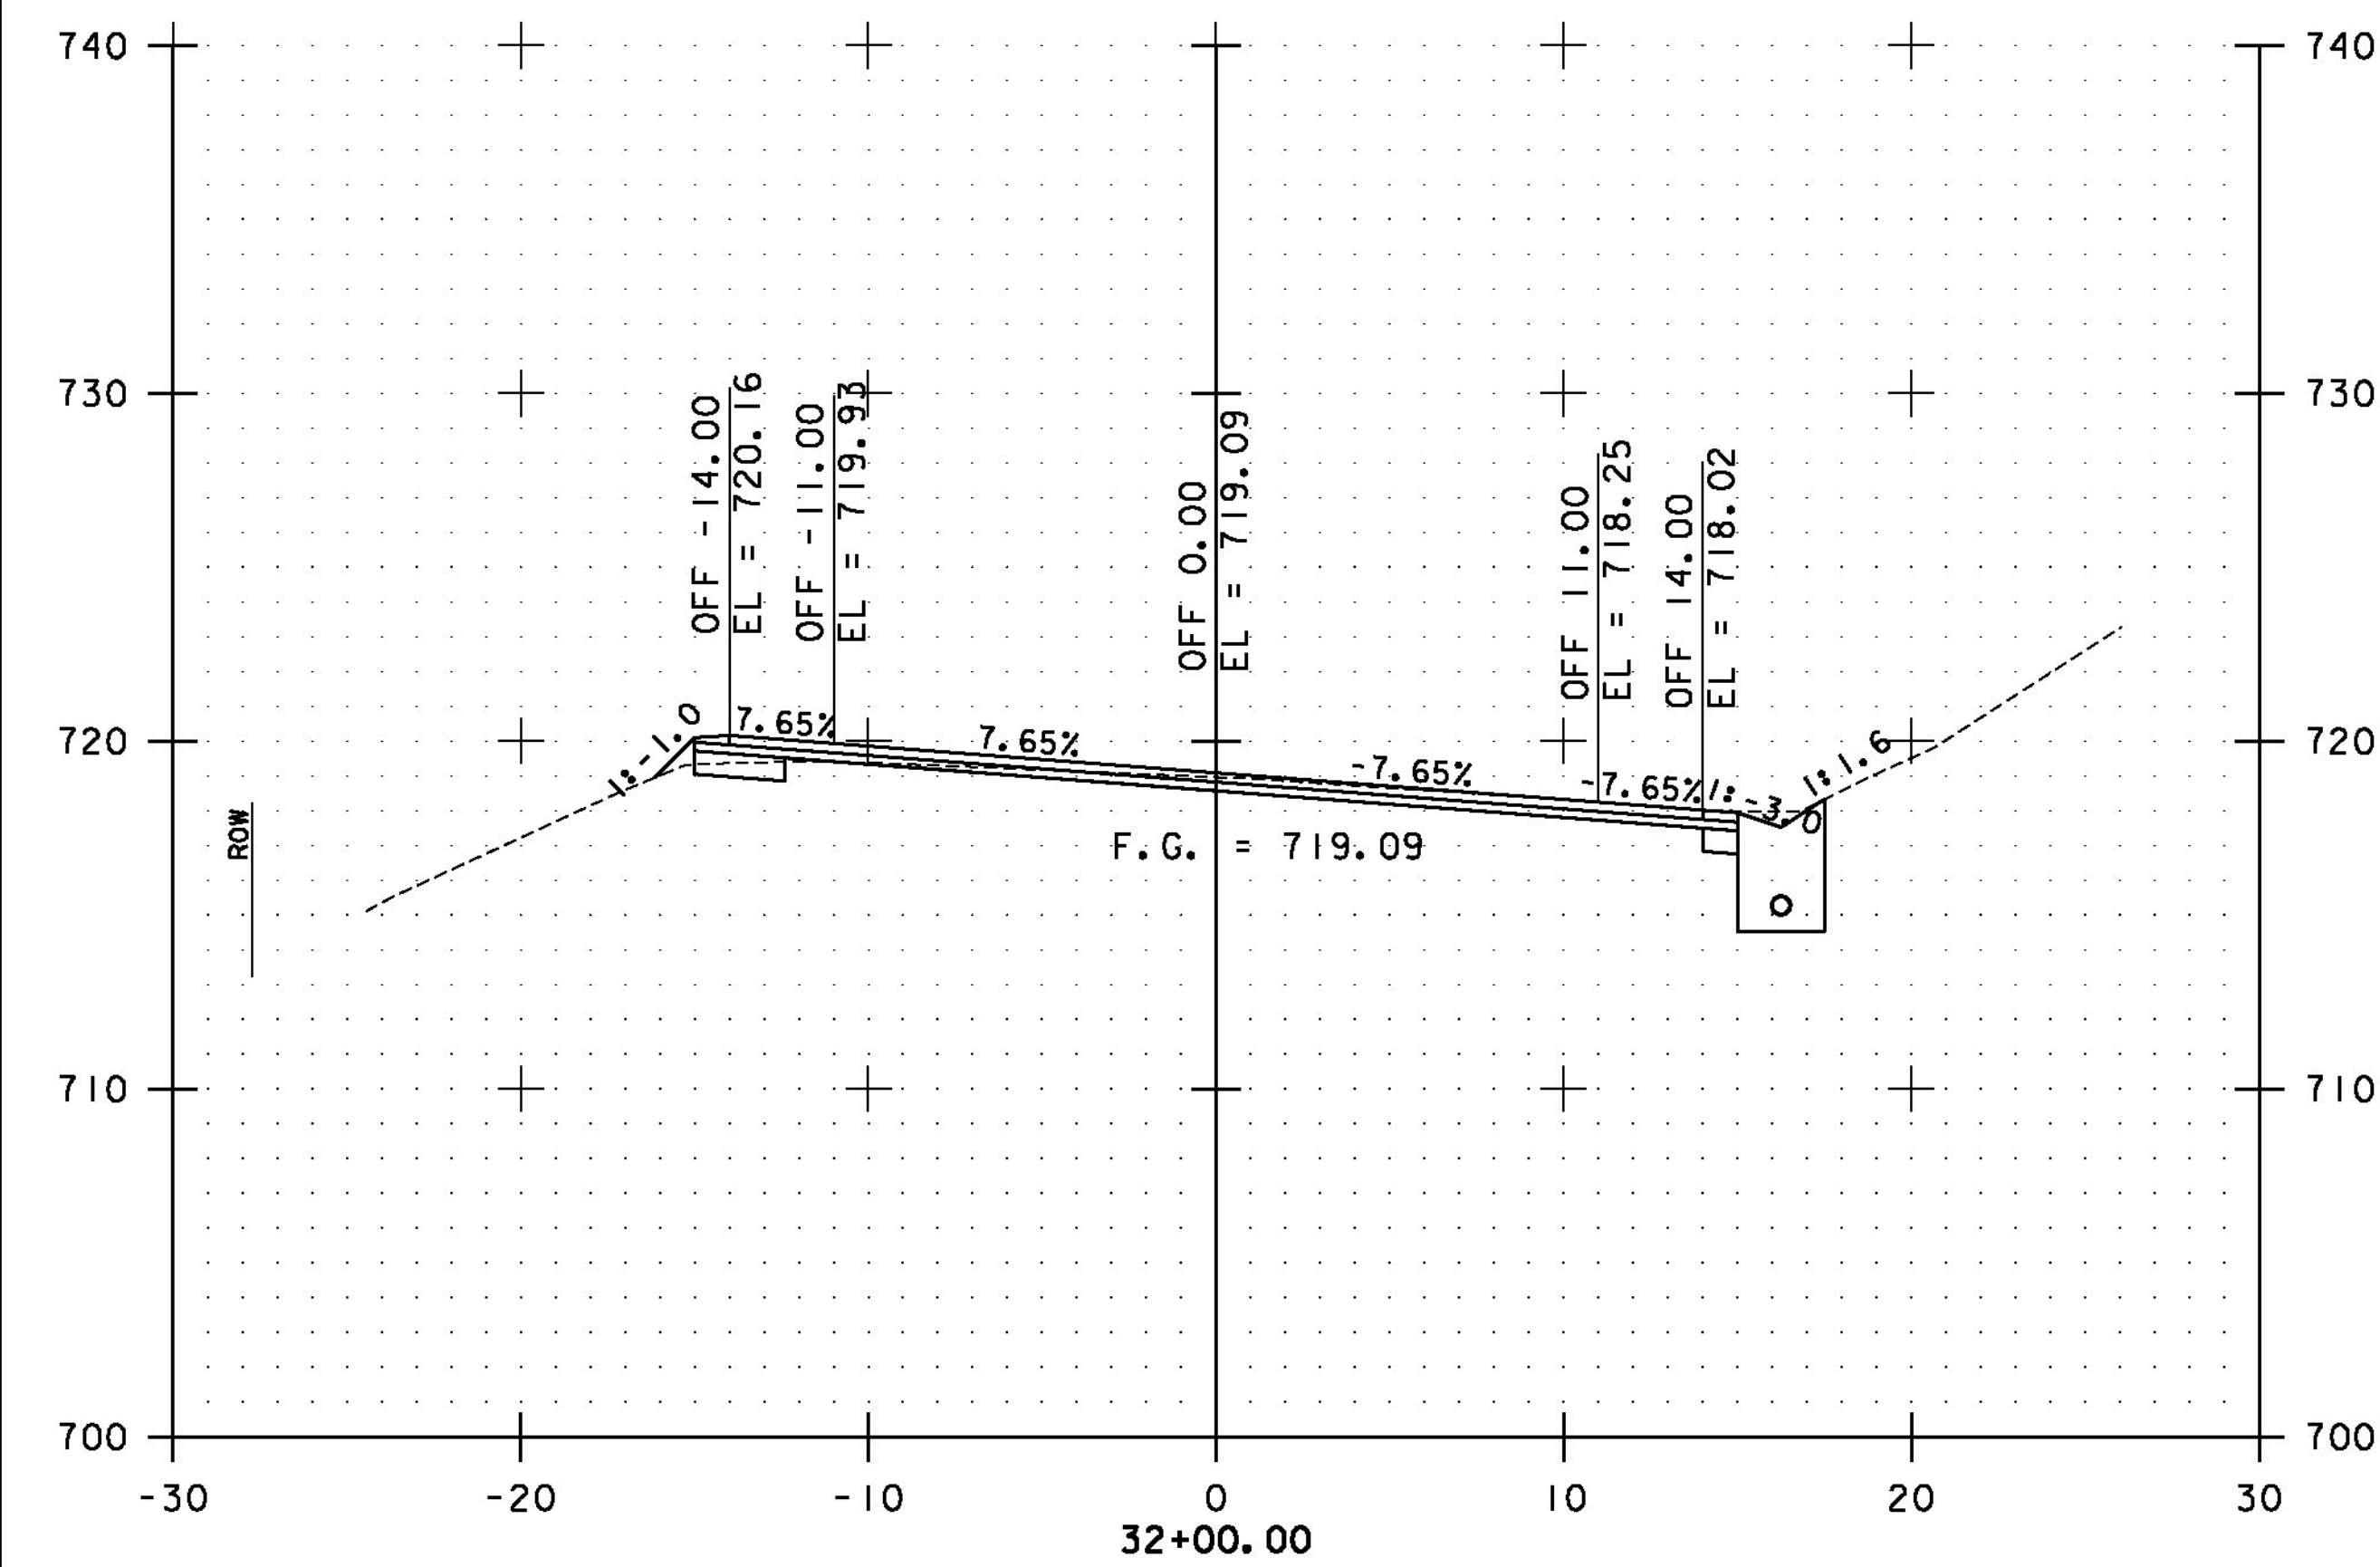

|                                   |                        |
|-----------------------------------|------------------------|
| PROJECT NAME: RANDOLPH-ROXBURY    |                        |
| PROJECT NUMBER: ER STP 0187(II)   |                        |
| FILE NAME: z13ci82xs.dgn          | PLOT DATE: 11/17/2014  |
| PROJECT LEADER: M. FOISY          | DRAWN BY: G. BURGMEIER |
| DESIGNED BY: I. MAYNARD           | CHECKED BY: M. FOISY   |
| BRAintree CROSS SECTIONS SHEET 15 |                        |
| SHEET 244 OF 545                  |                        |