

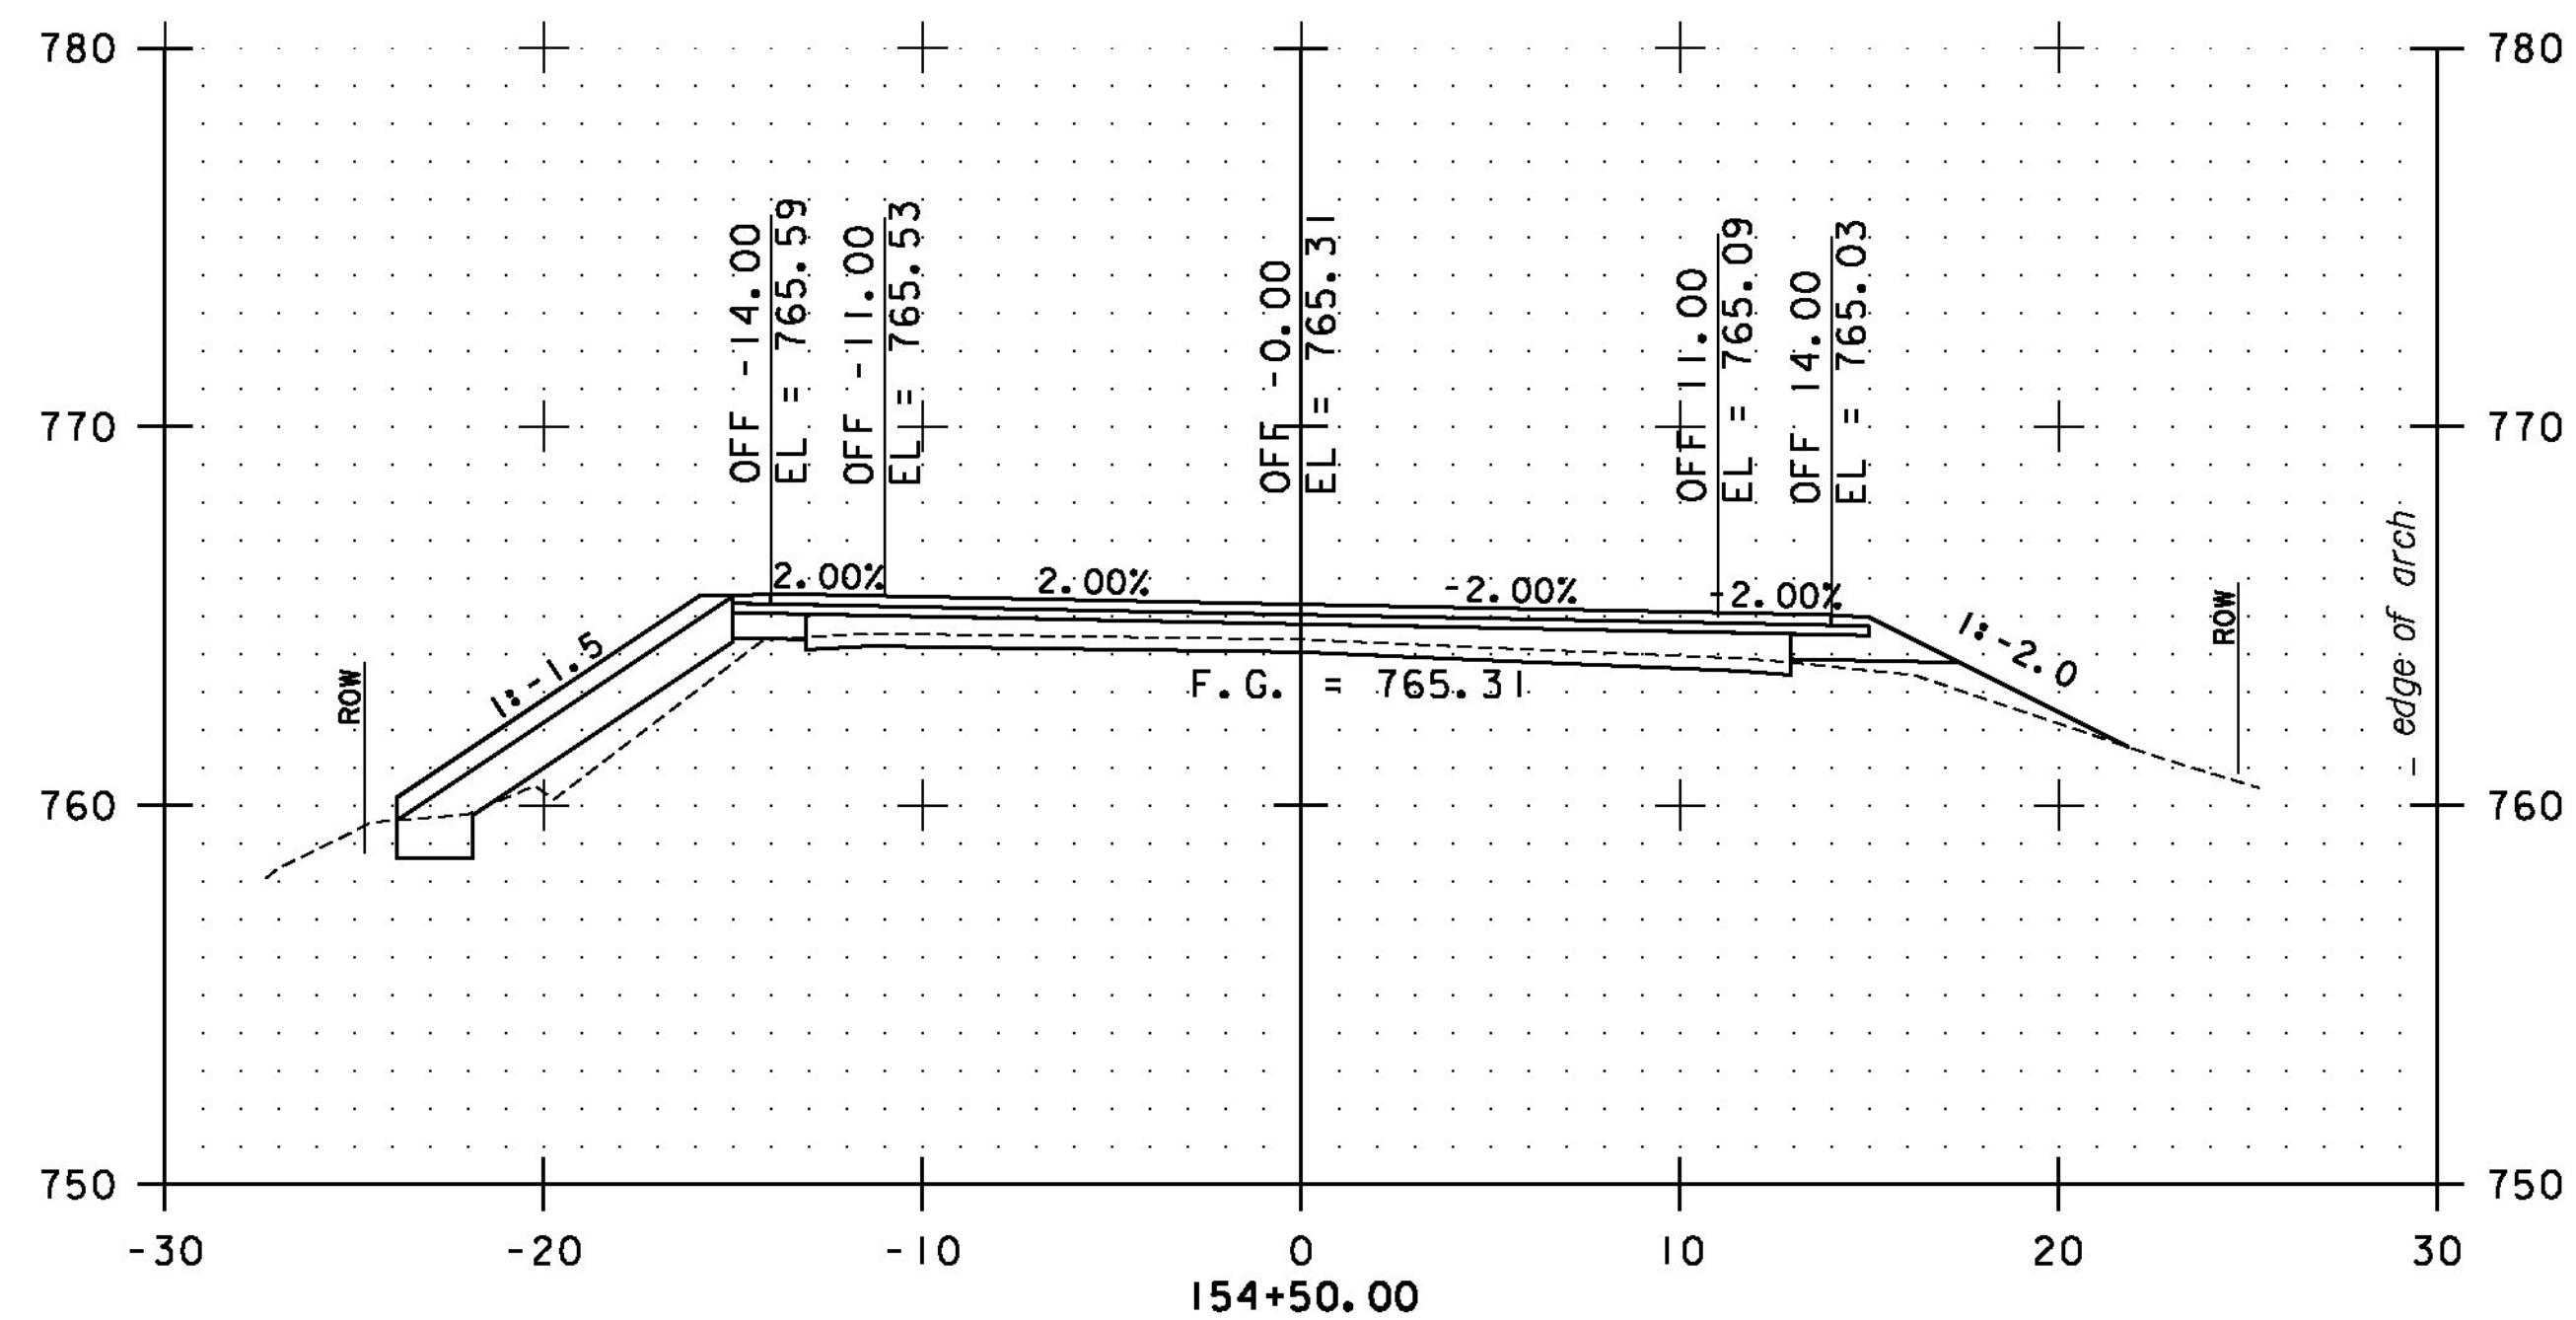
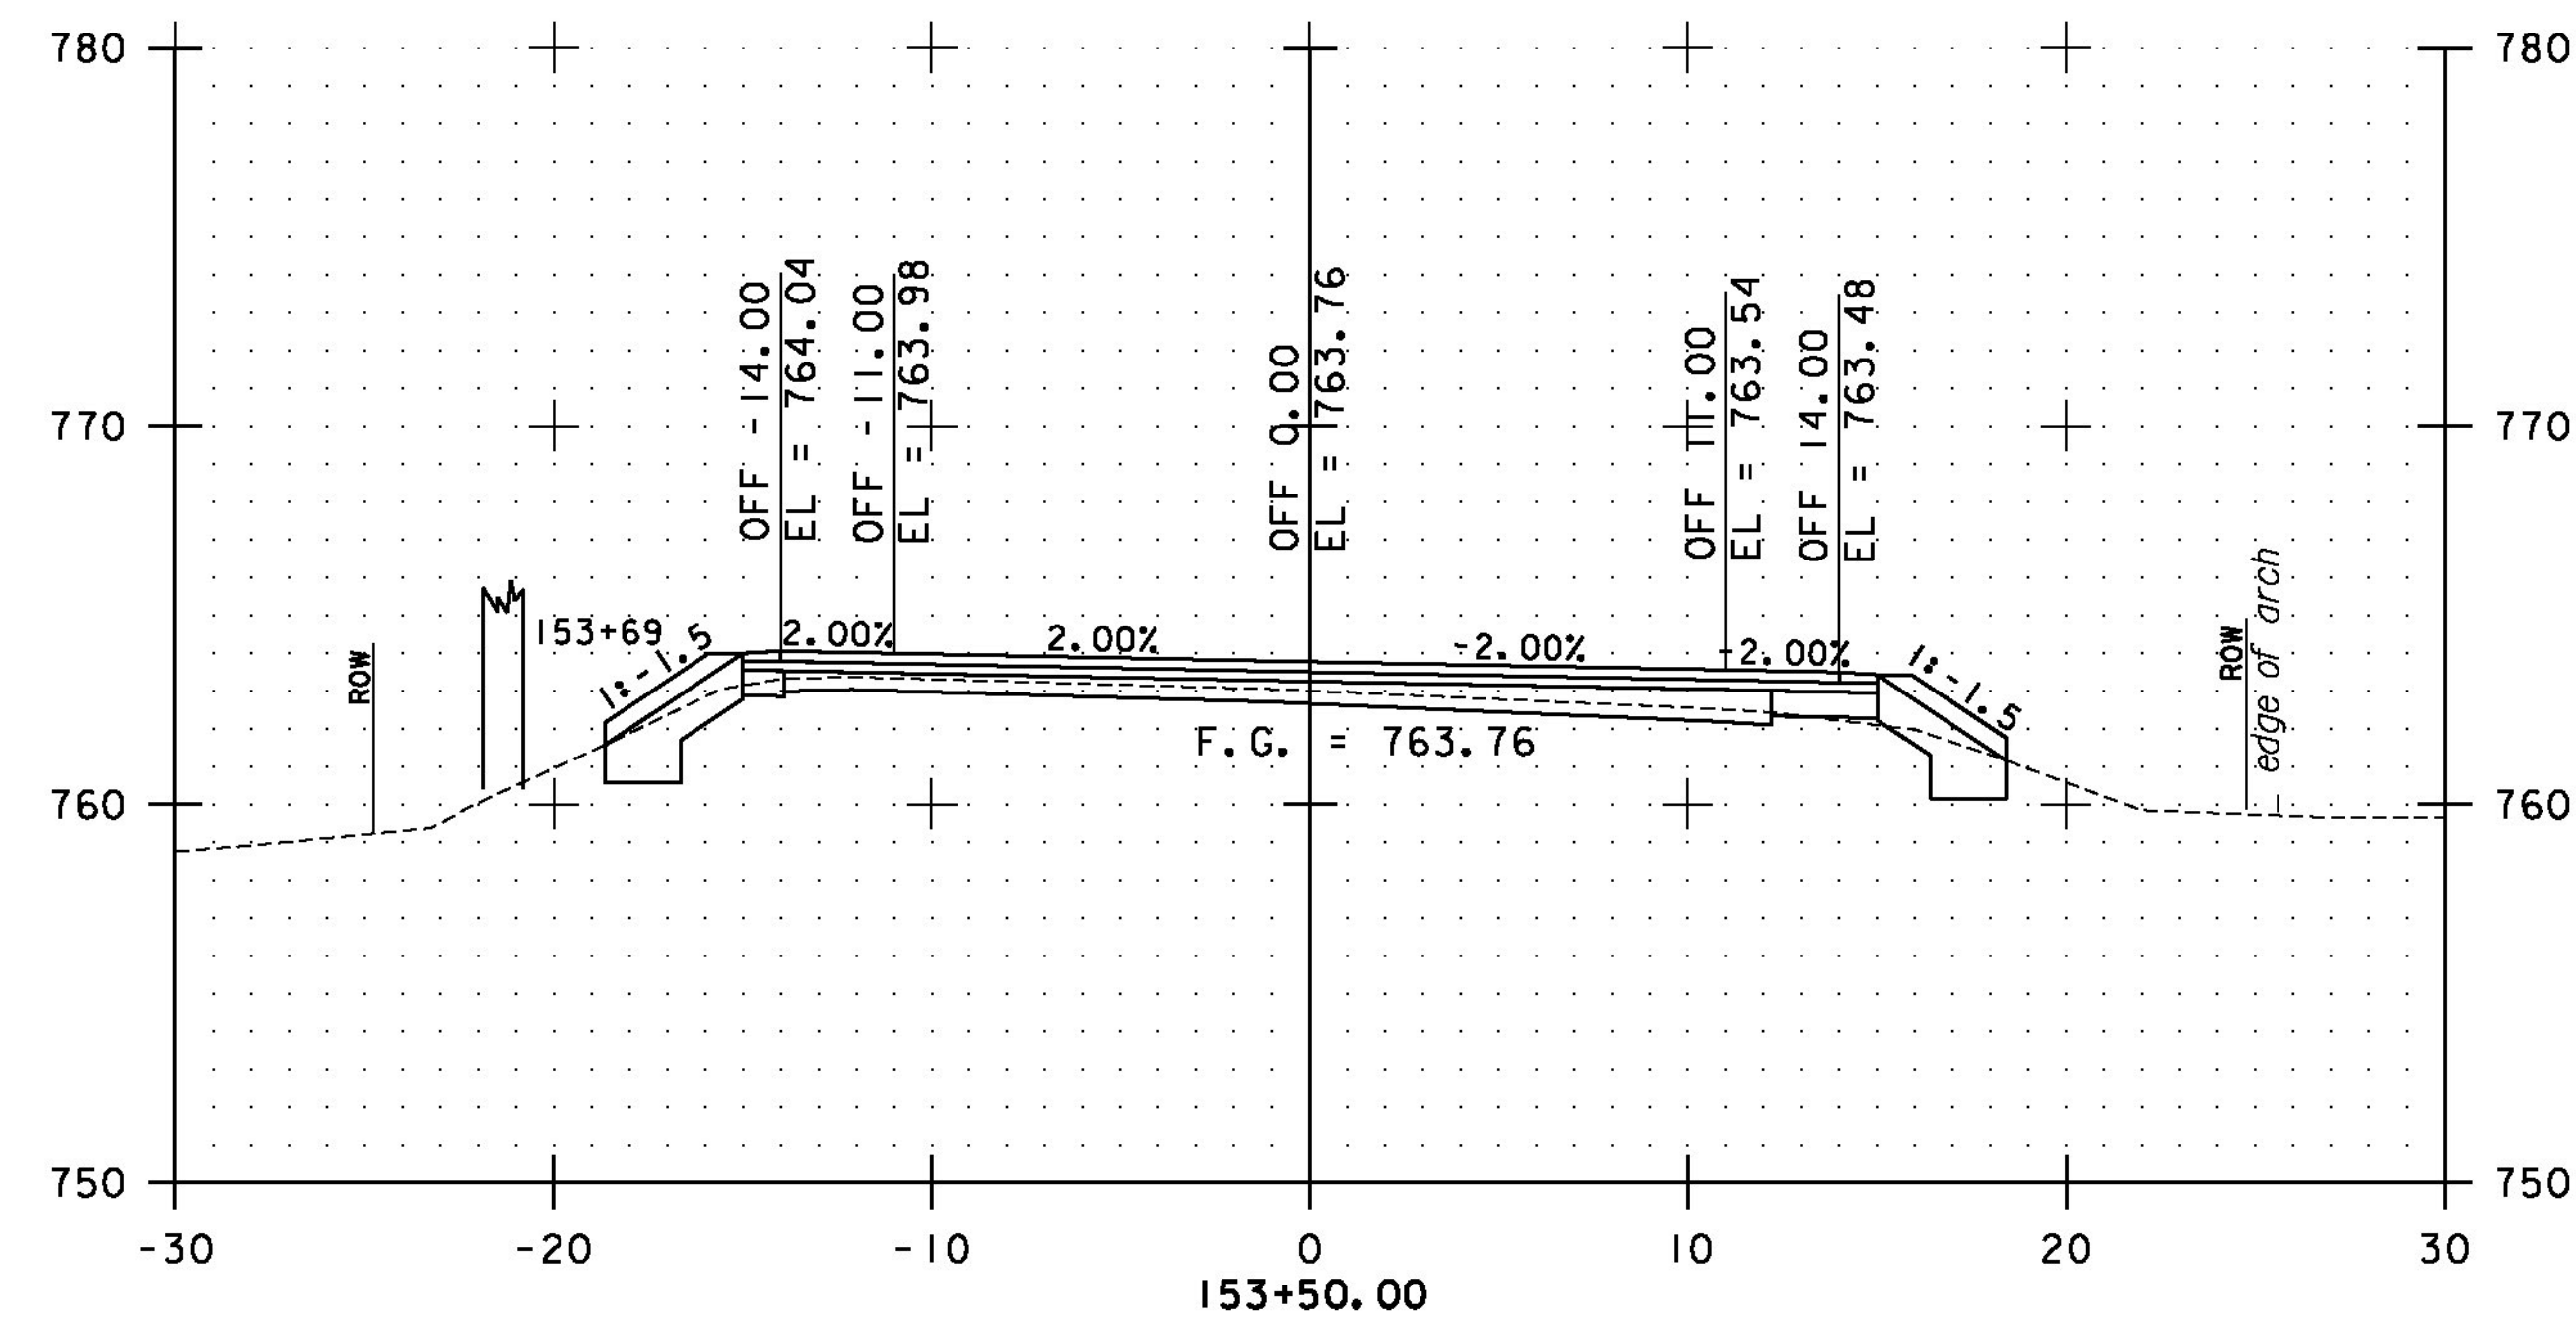


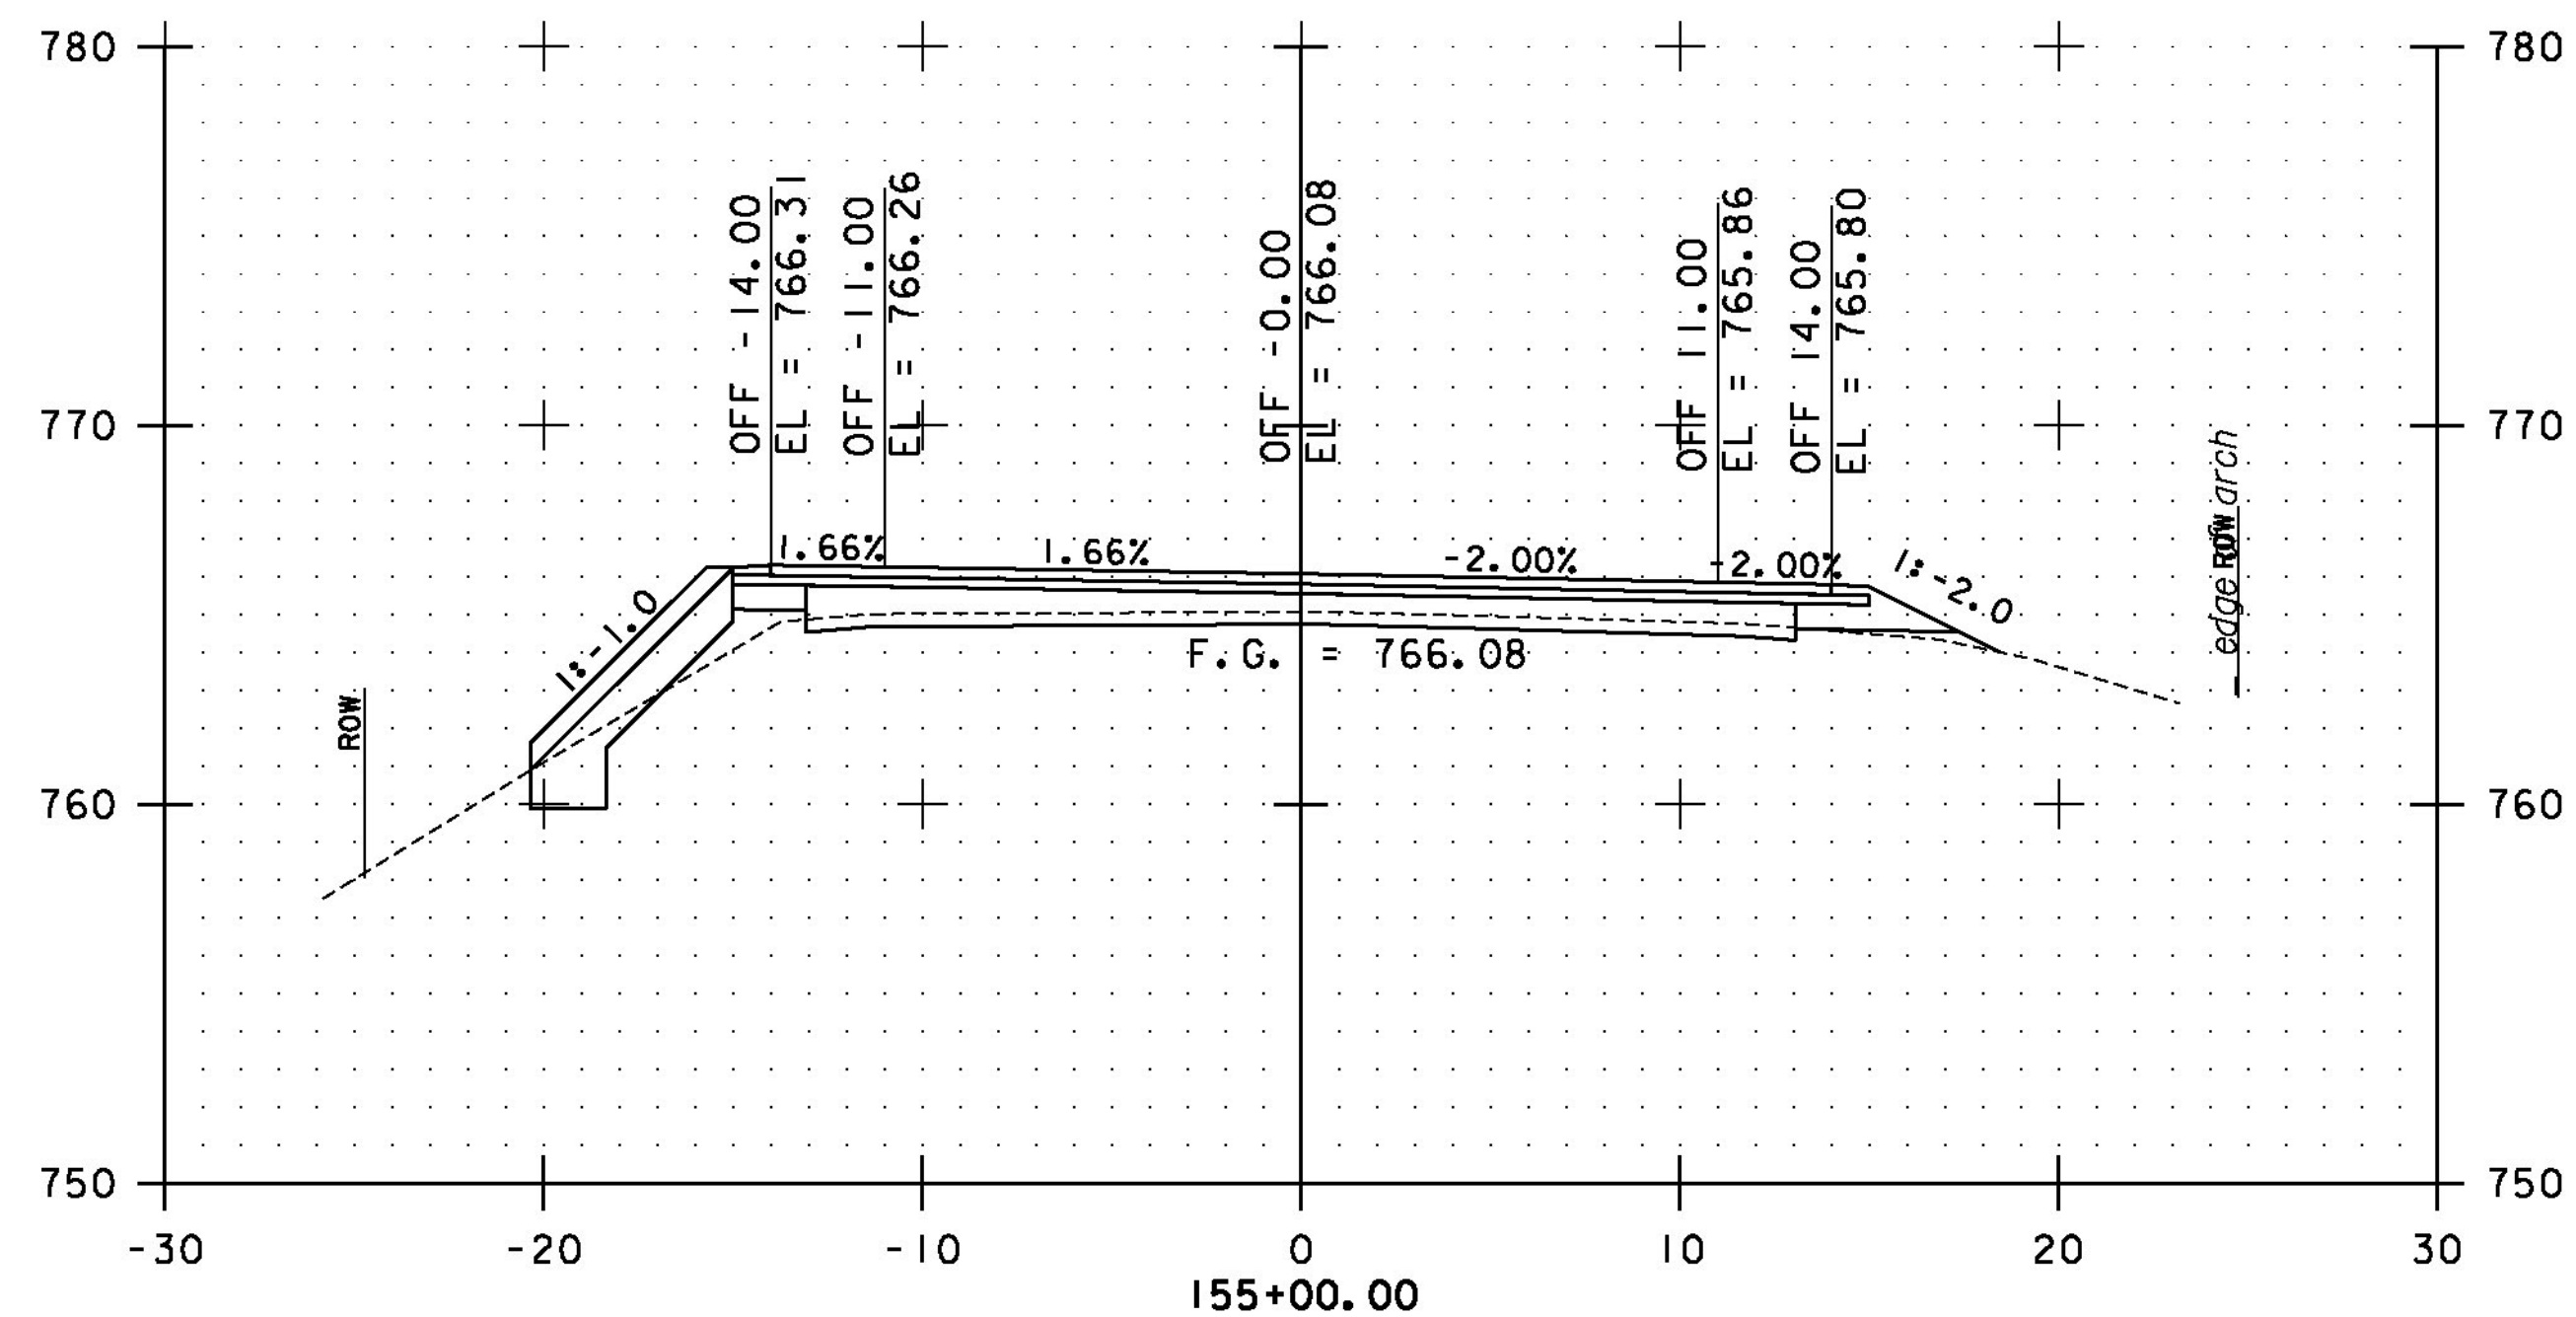

STA. 153+50 TO STA. 155+00

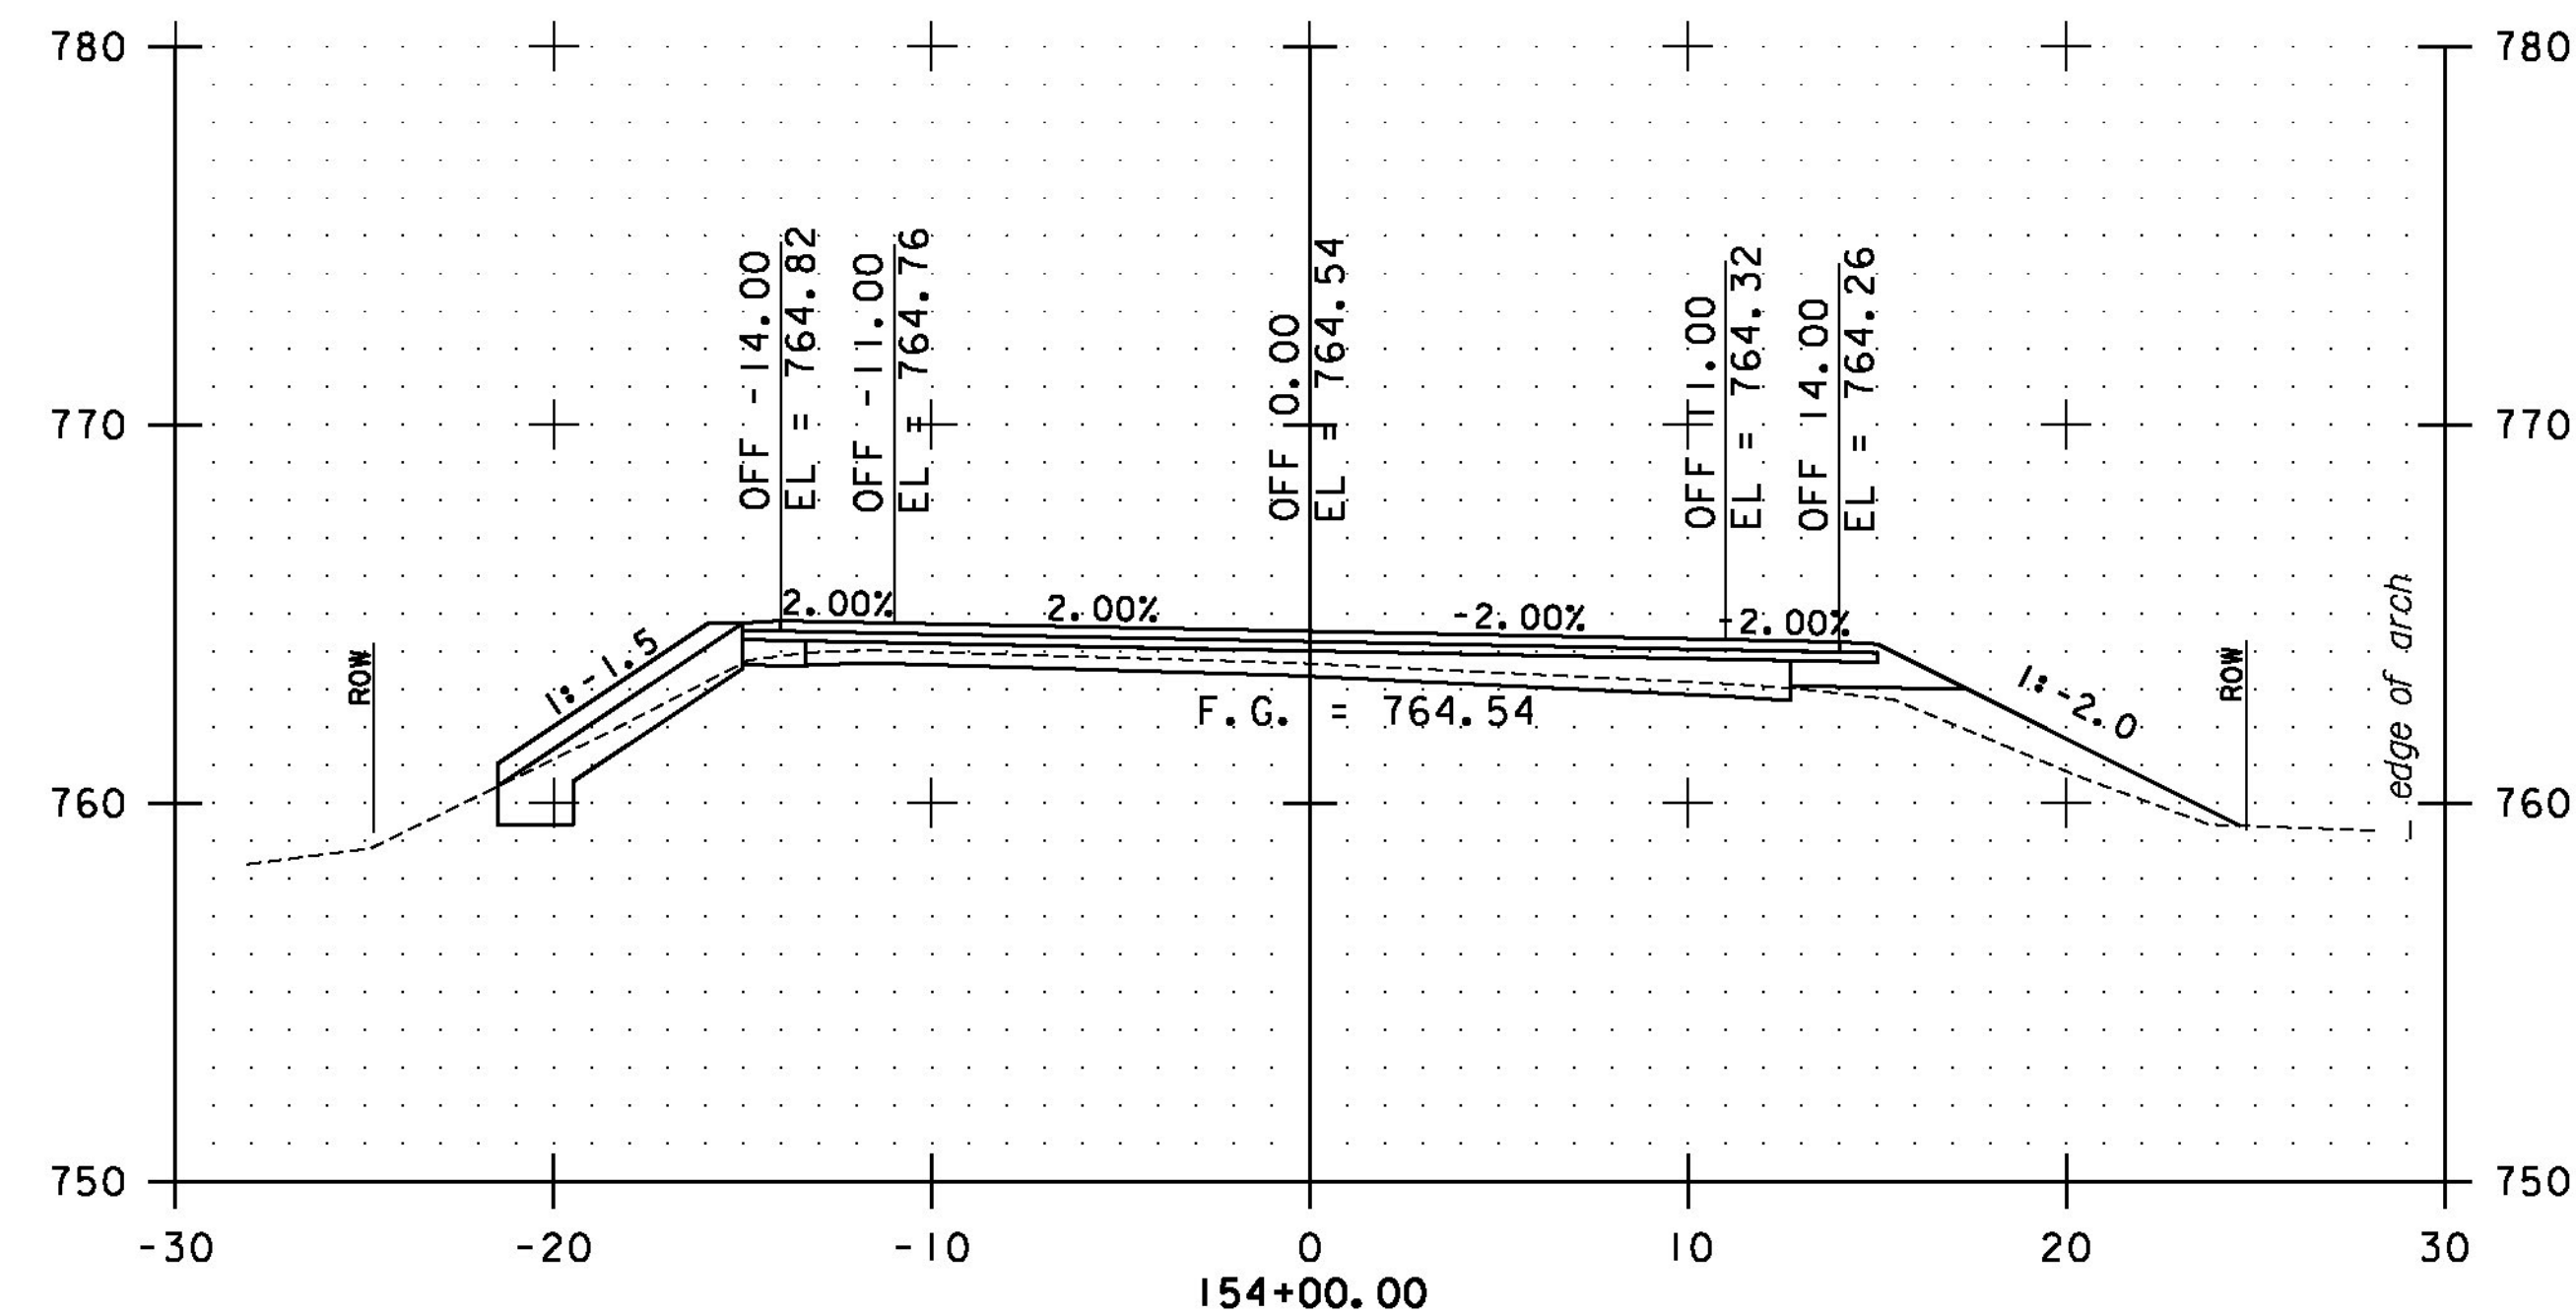

PROJECT NAME: RANDOLPH-ROXBURY	
PROJECT NUMBER: ER STP 0187(II)	
FILE NAME: z13ci82xs.dgn	PLOT DATE: 11/17/2014
PROJECT LEADER: M. FOISY	DRAWN BY: G. BURGMEIER
DESIGNED BY: I. MAYNARD	CHECKED BY: M. FOISY
BRAintree CROSS SECTIONS SHEET 74	
SHEET 303 OF 545	