

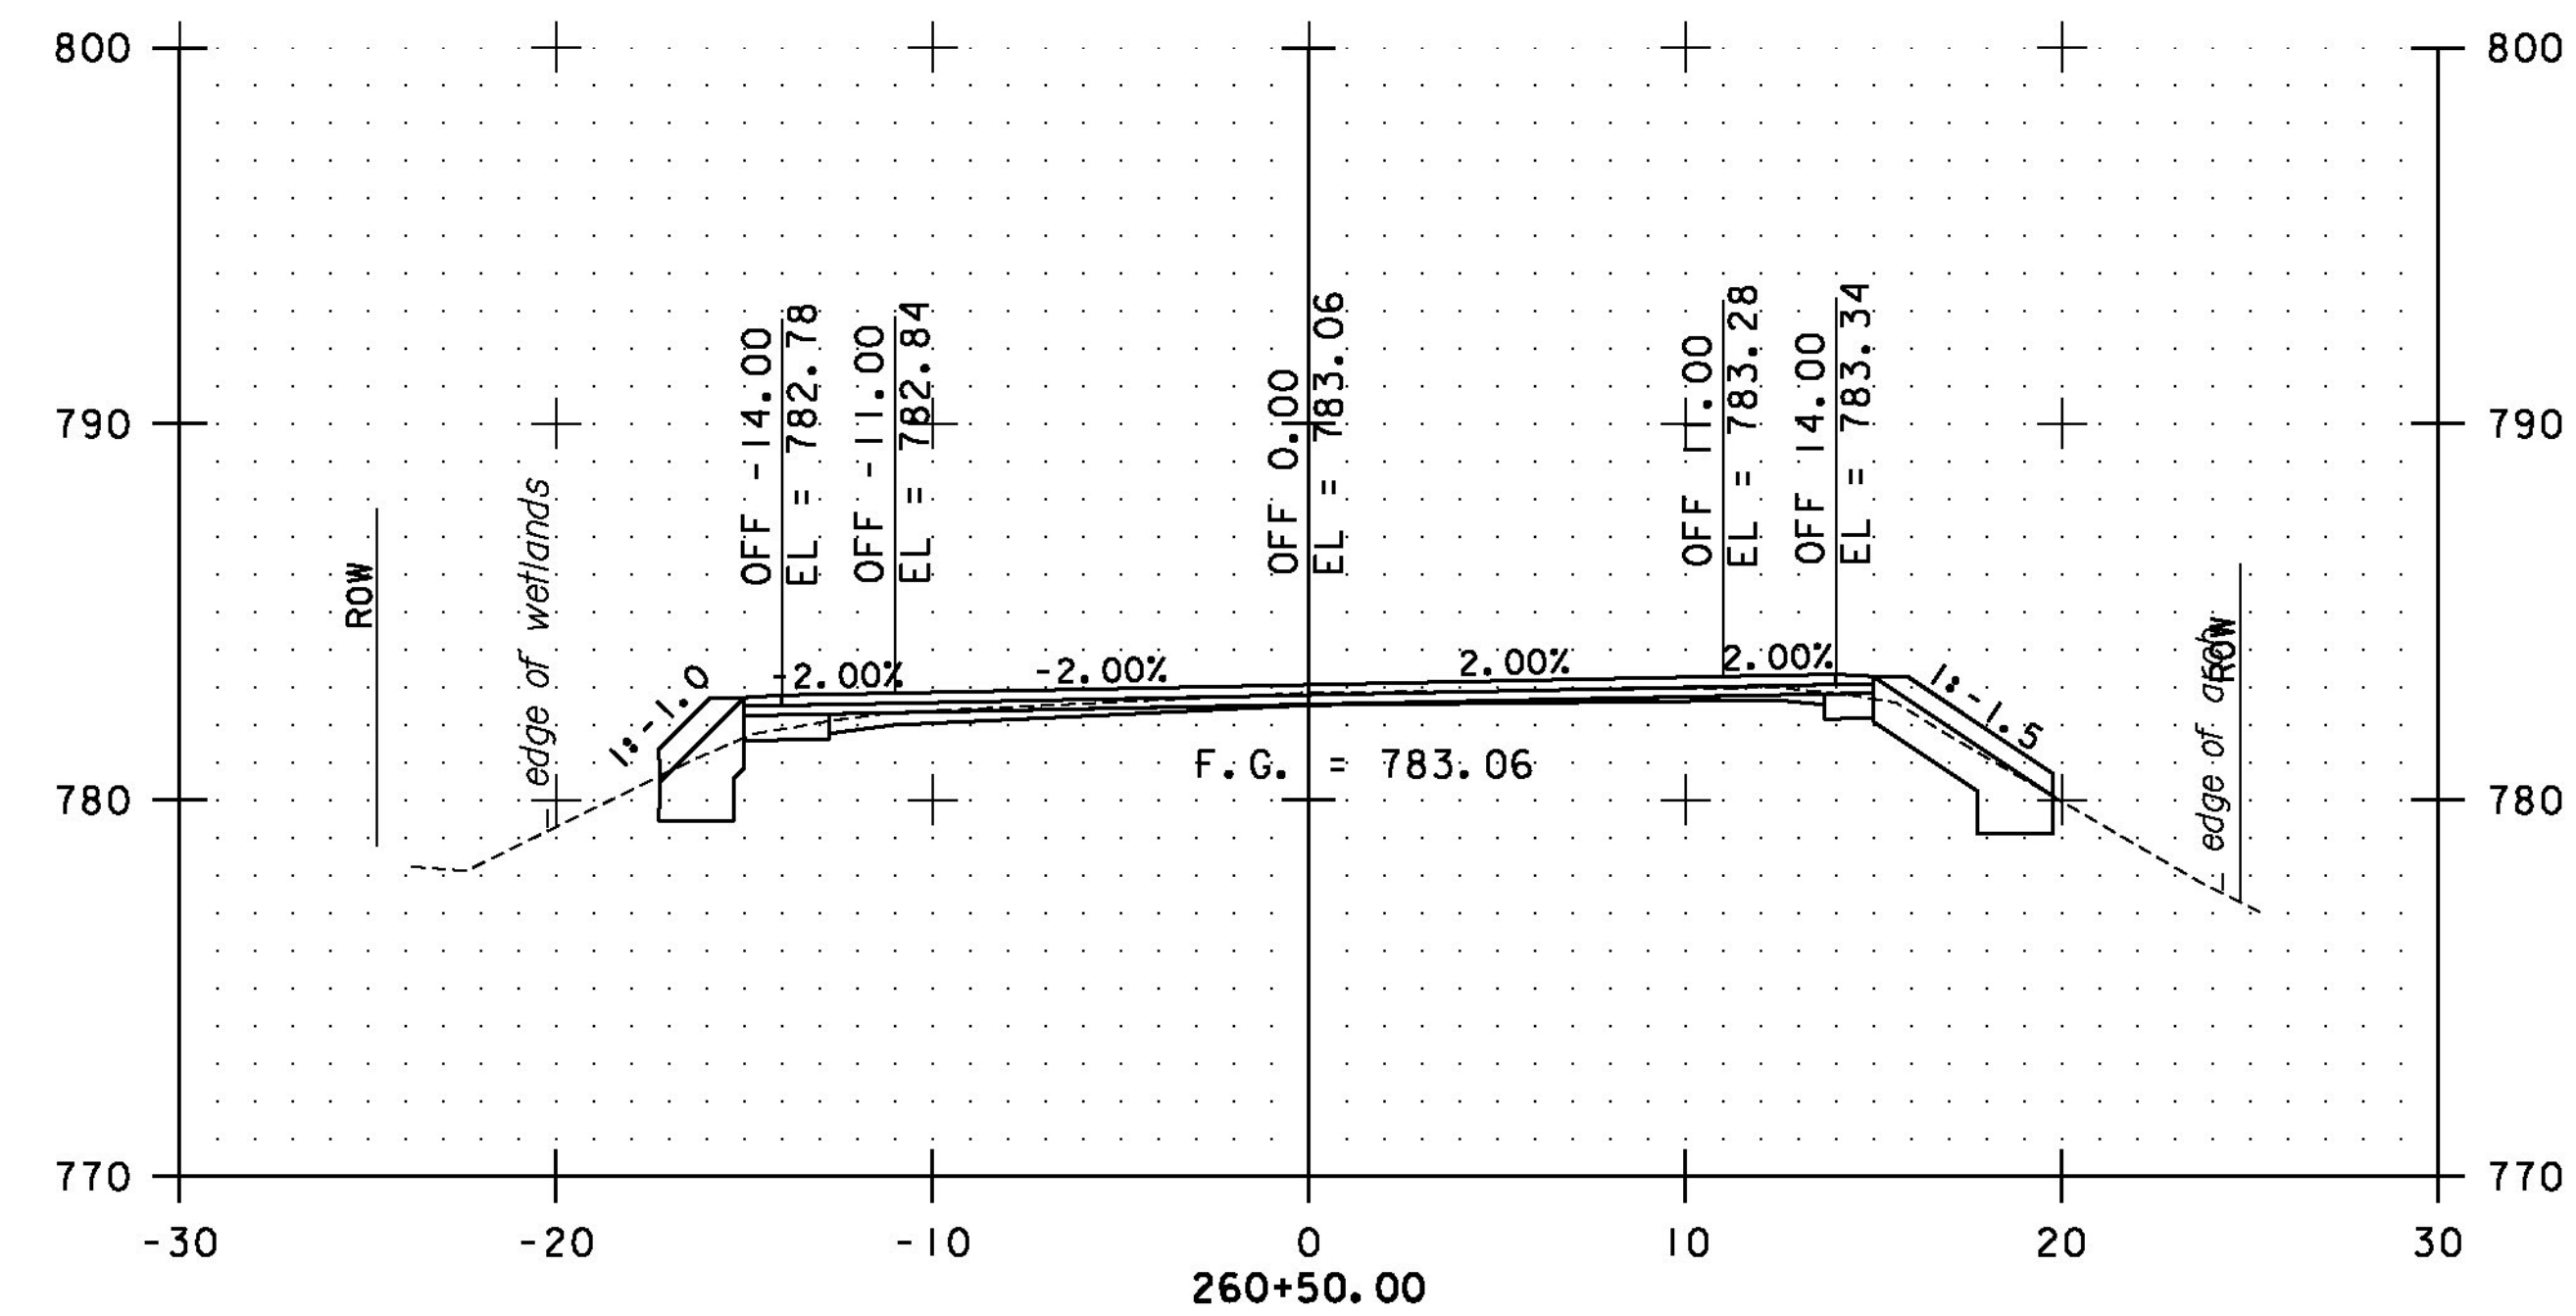
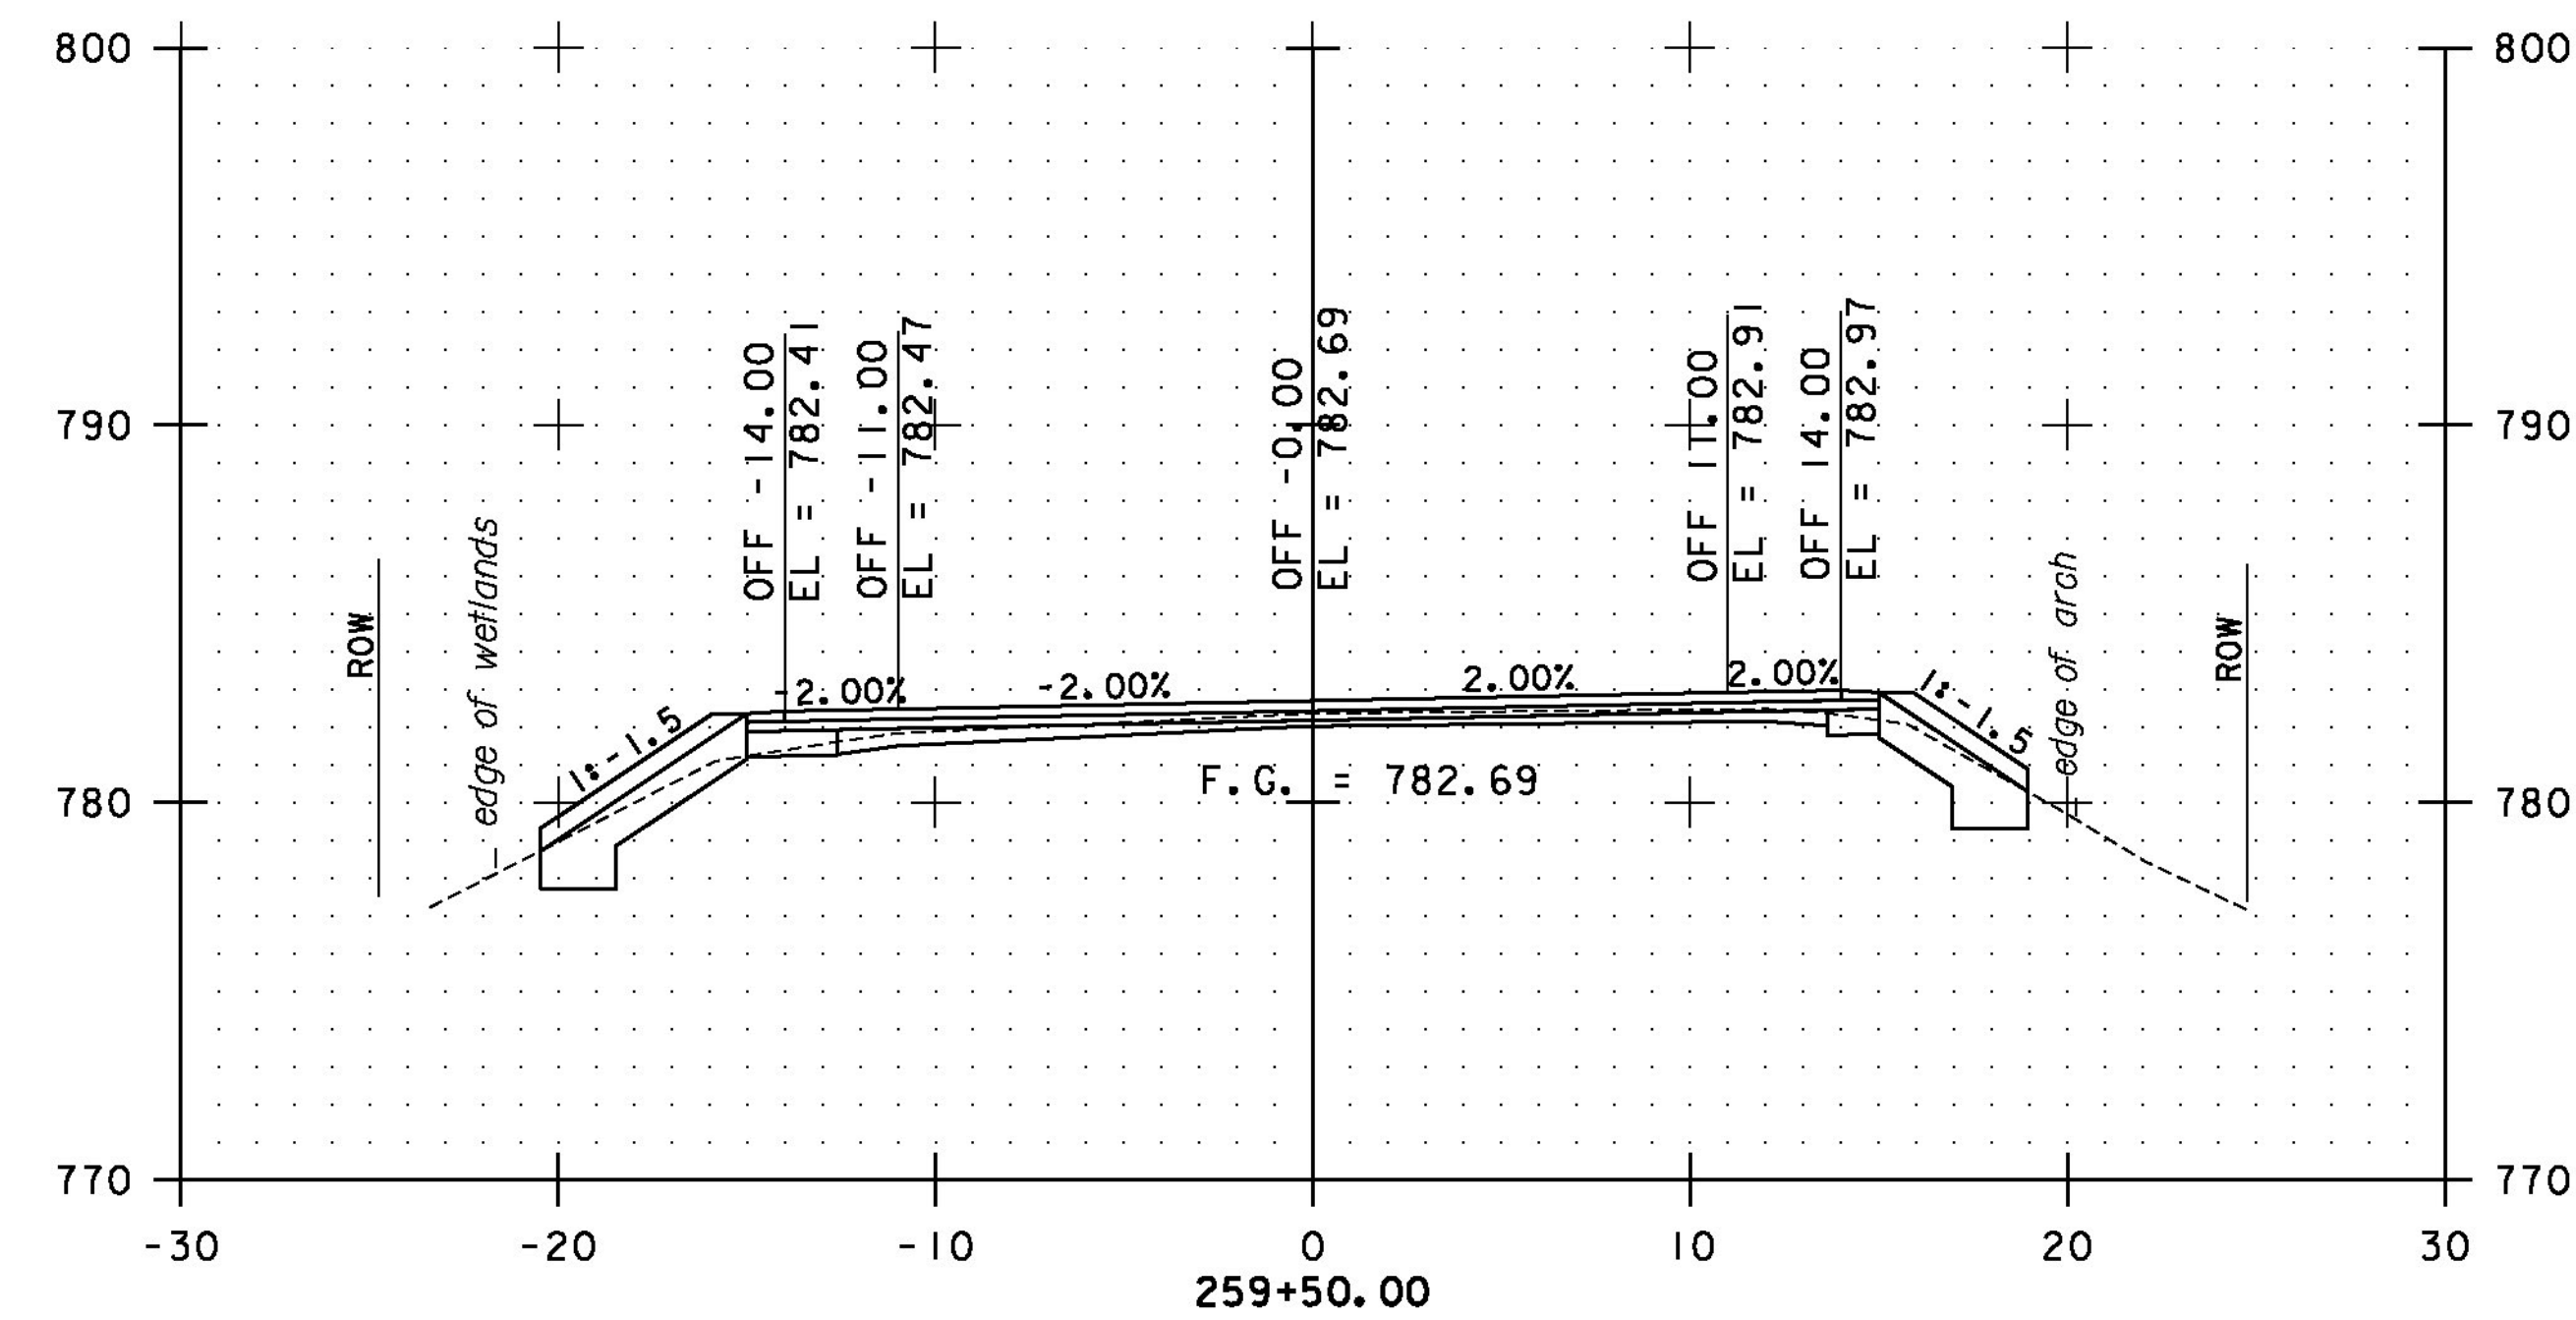


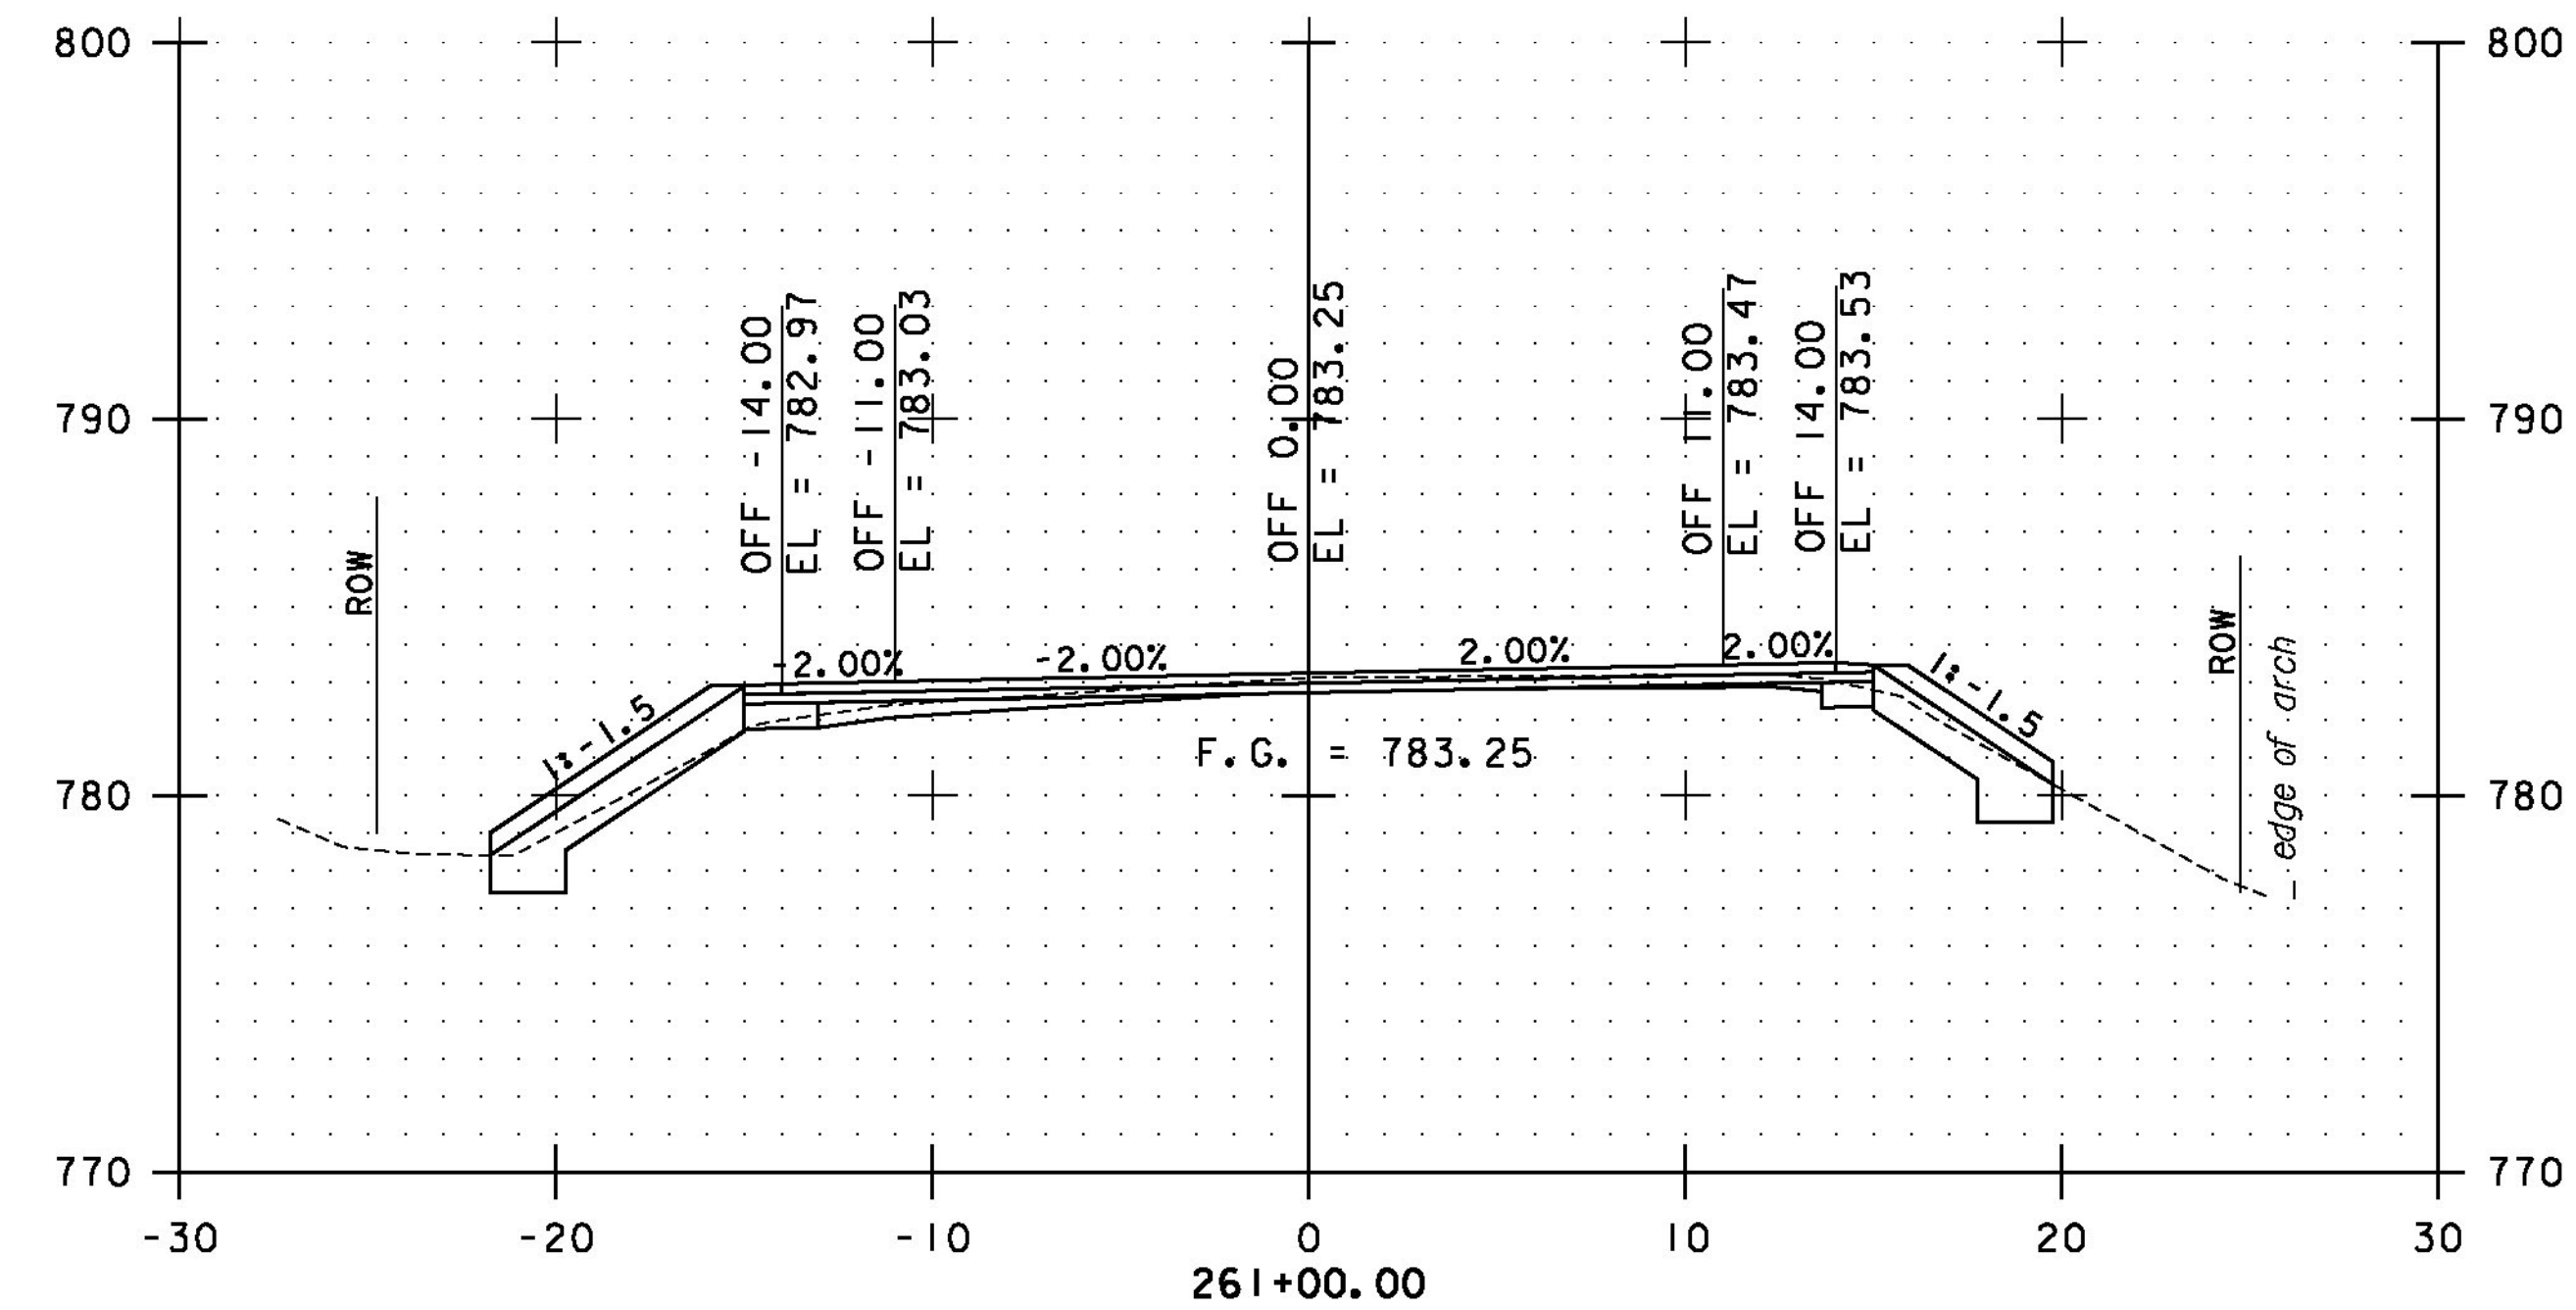

STA. 259+50 TO STA. 261+00

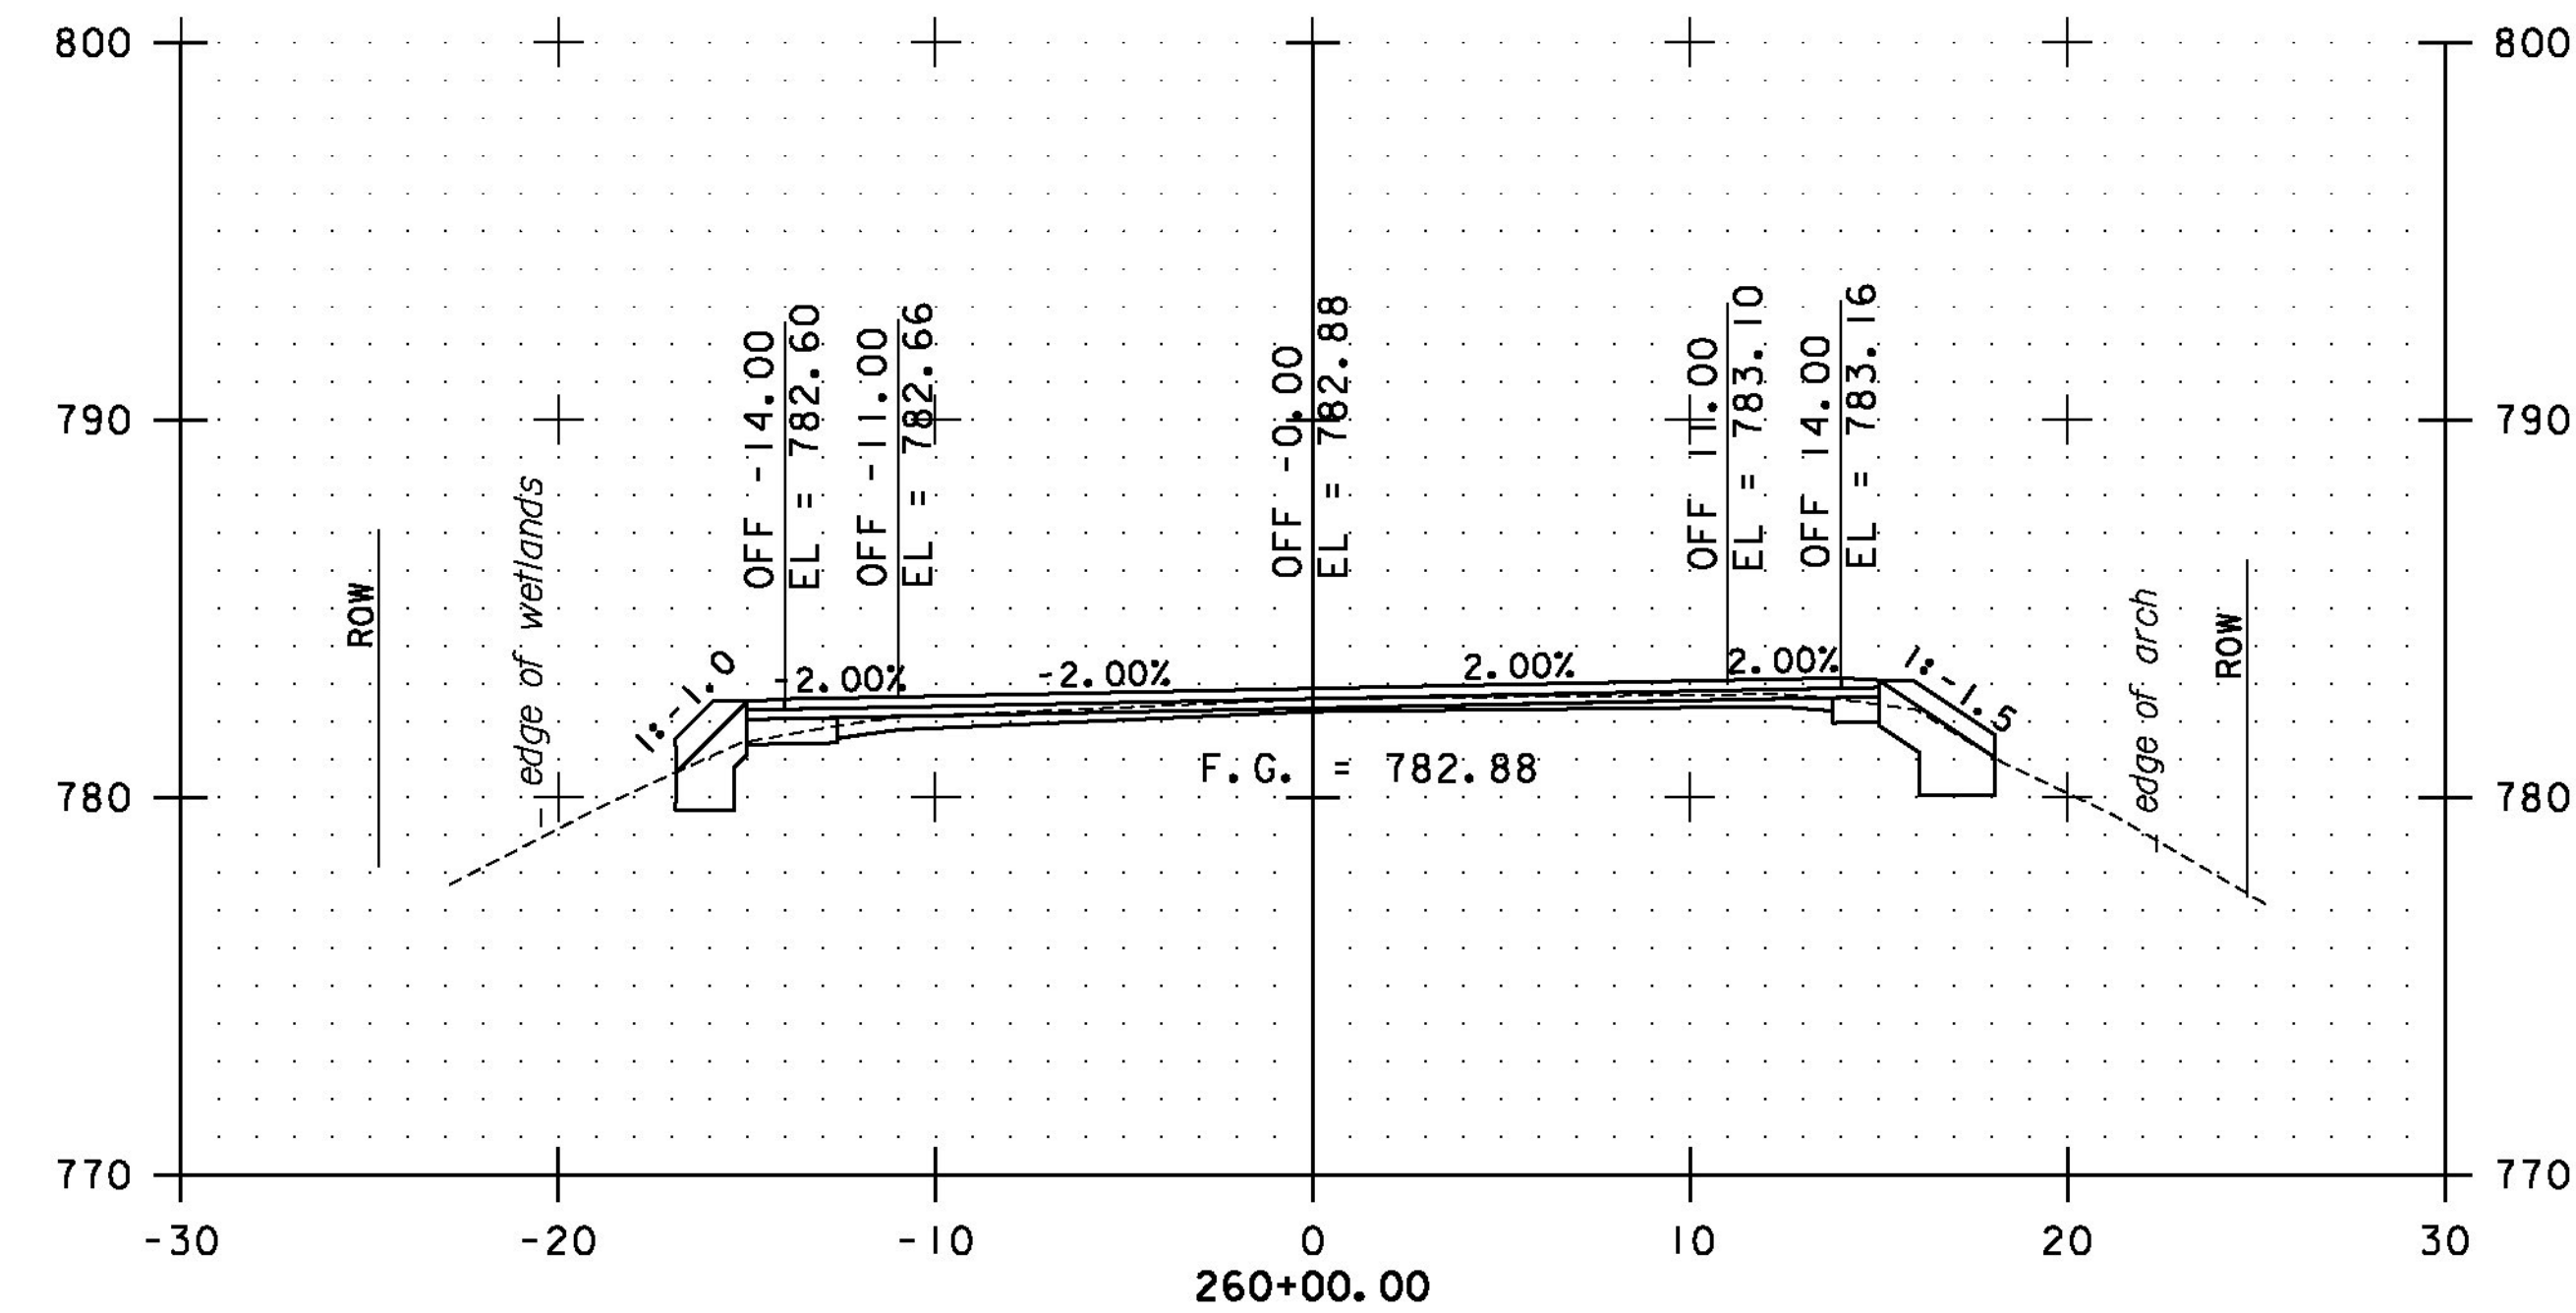

PROJECT NAME: RANDOLPH-ROXBURY	
PROJECT NUMBER: ER STP 0187(II)	
FILE NAME: z13ci82xs.dgn	PLOT DATE: 11/17/2014
PROJECT LEADER: M. FOISY	DRAWN BY: G. BURGMEIER
DESIGNED BY: I. MAYNARD	CHECKED BY: M. FOISY
BRAintree CROSS SECTIONS SHEET 119	
SHEET 348 OF 545	