

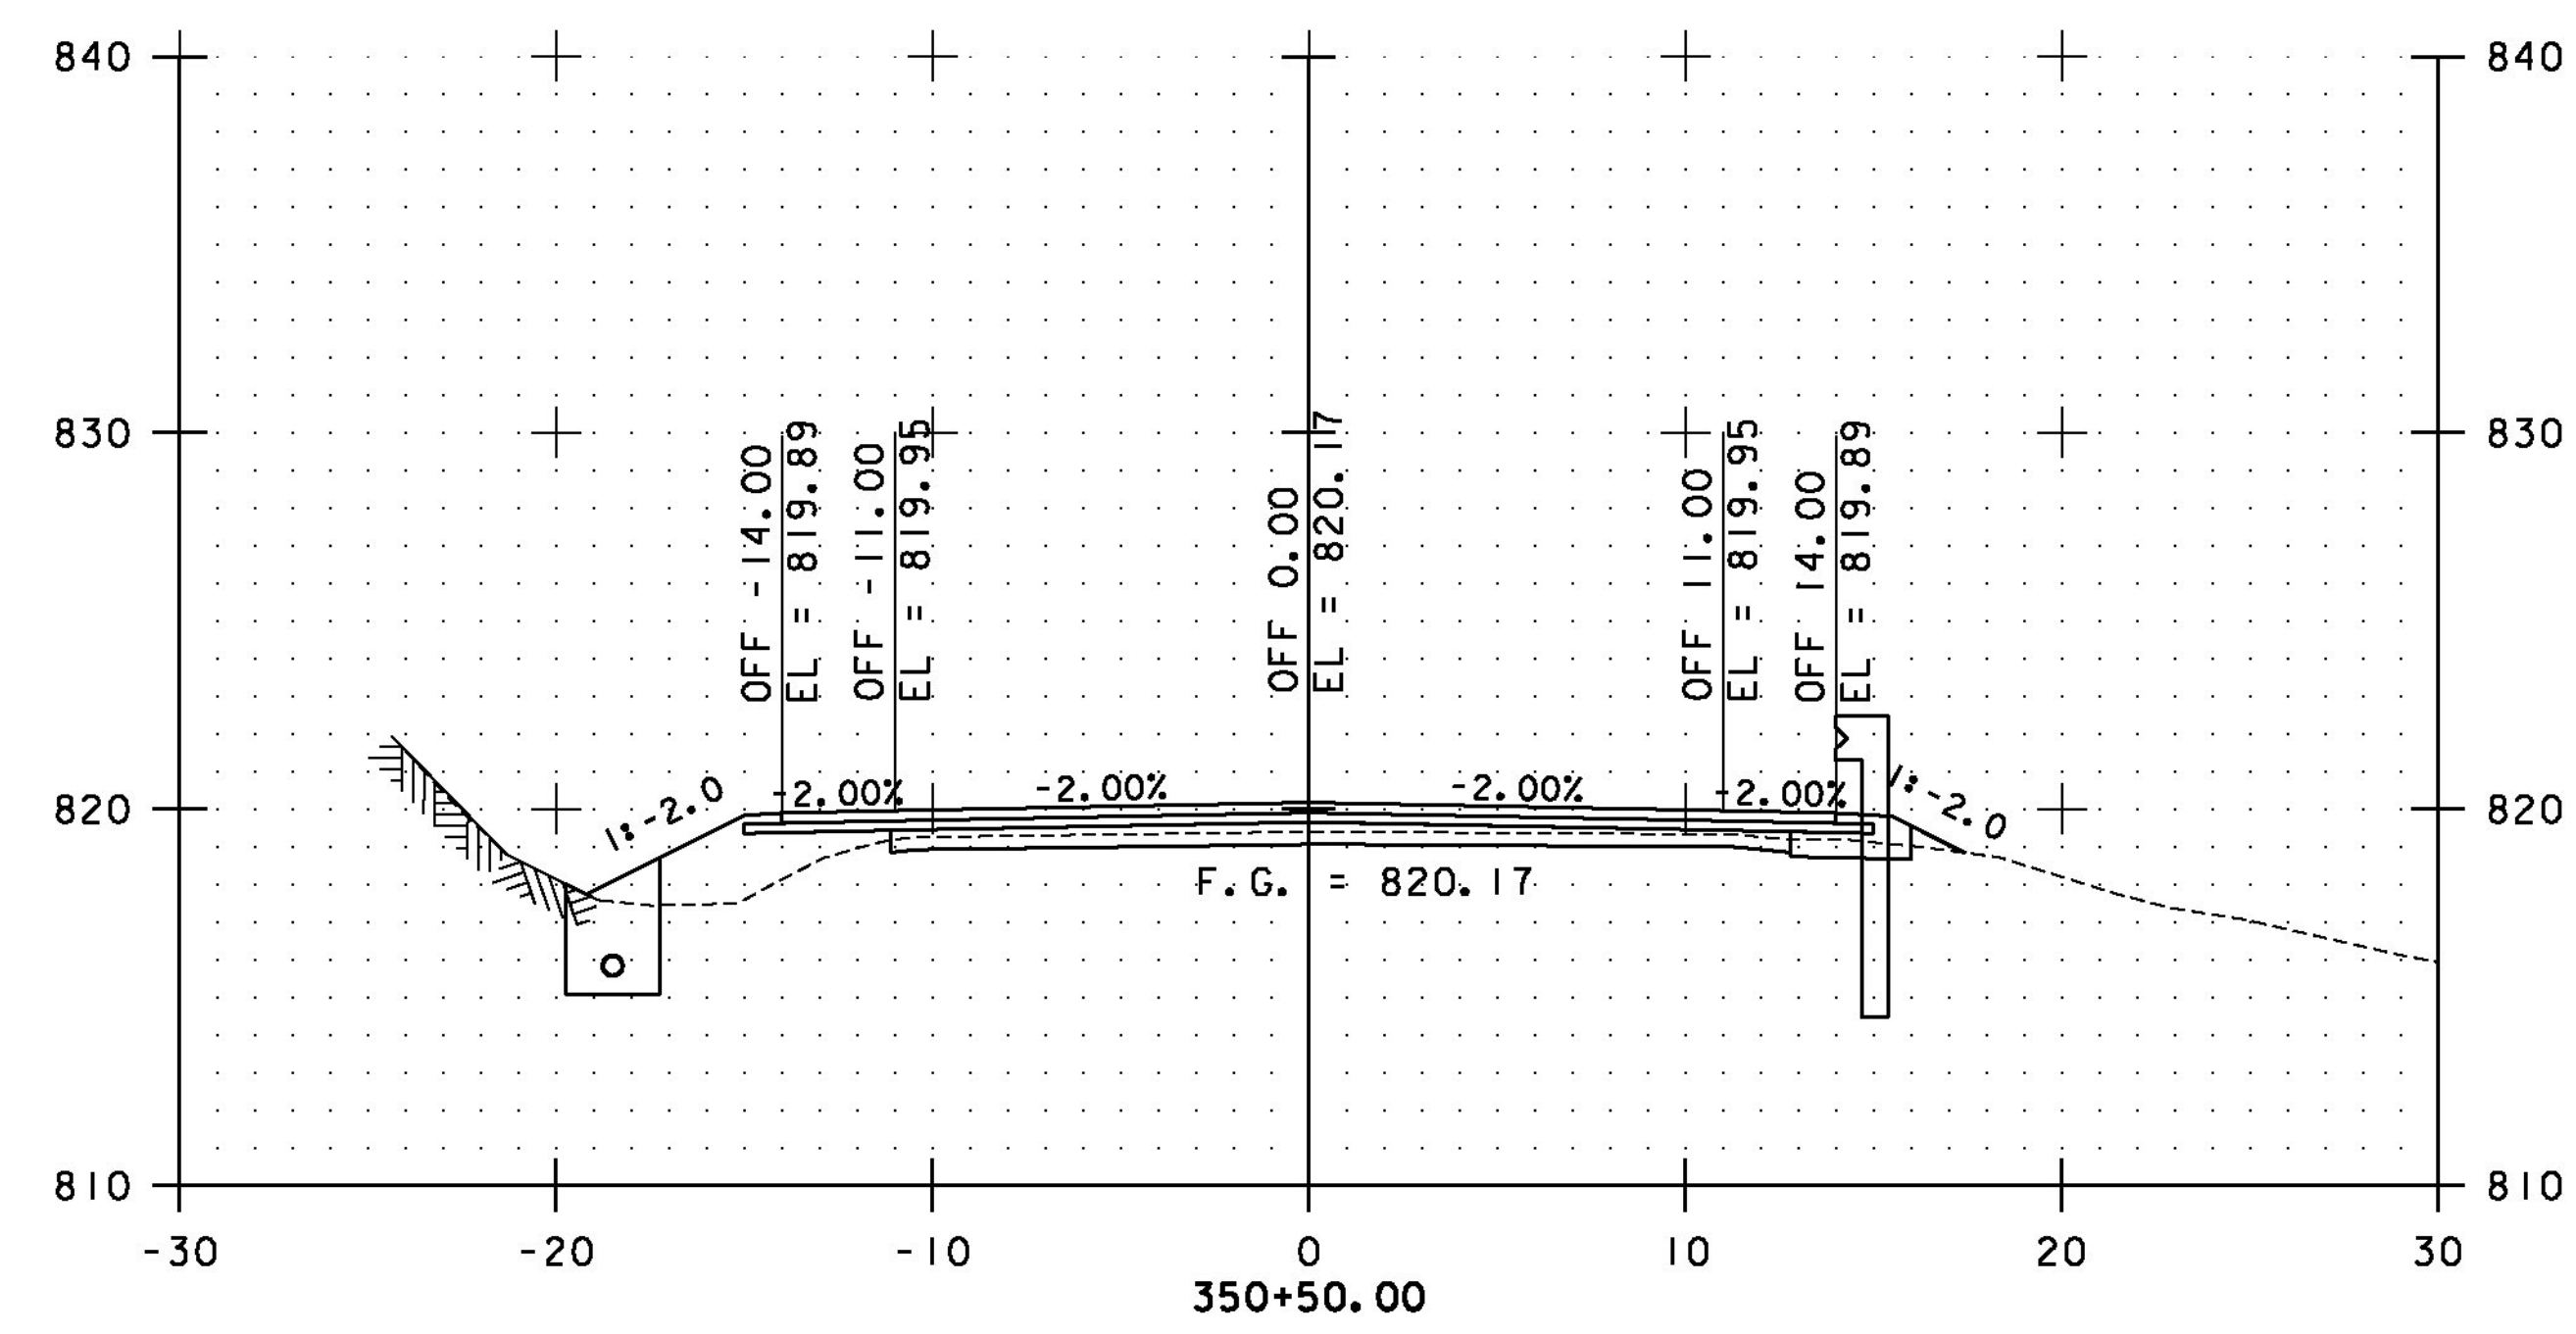
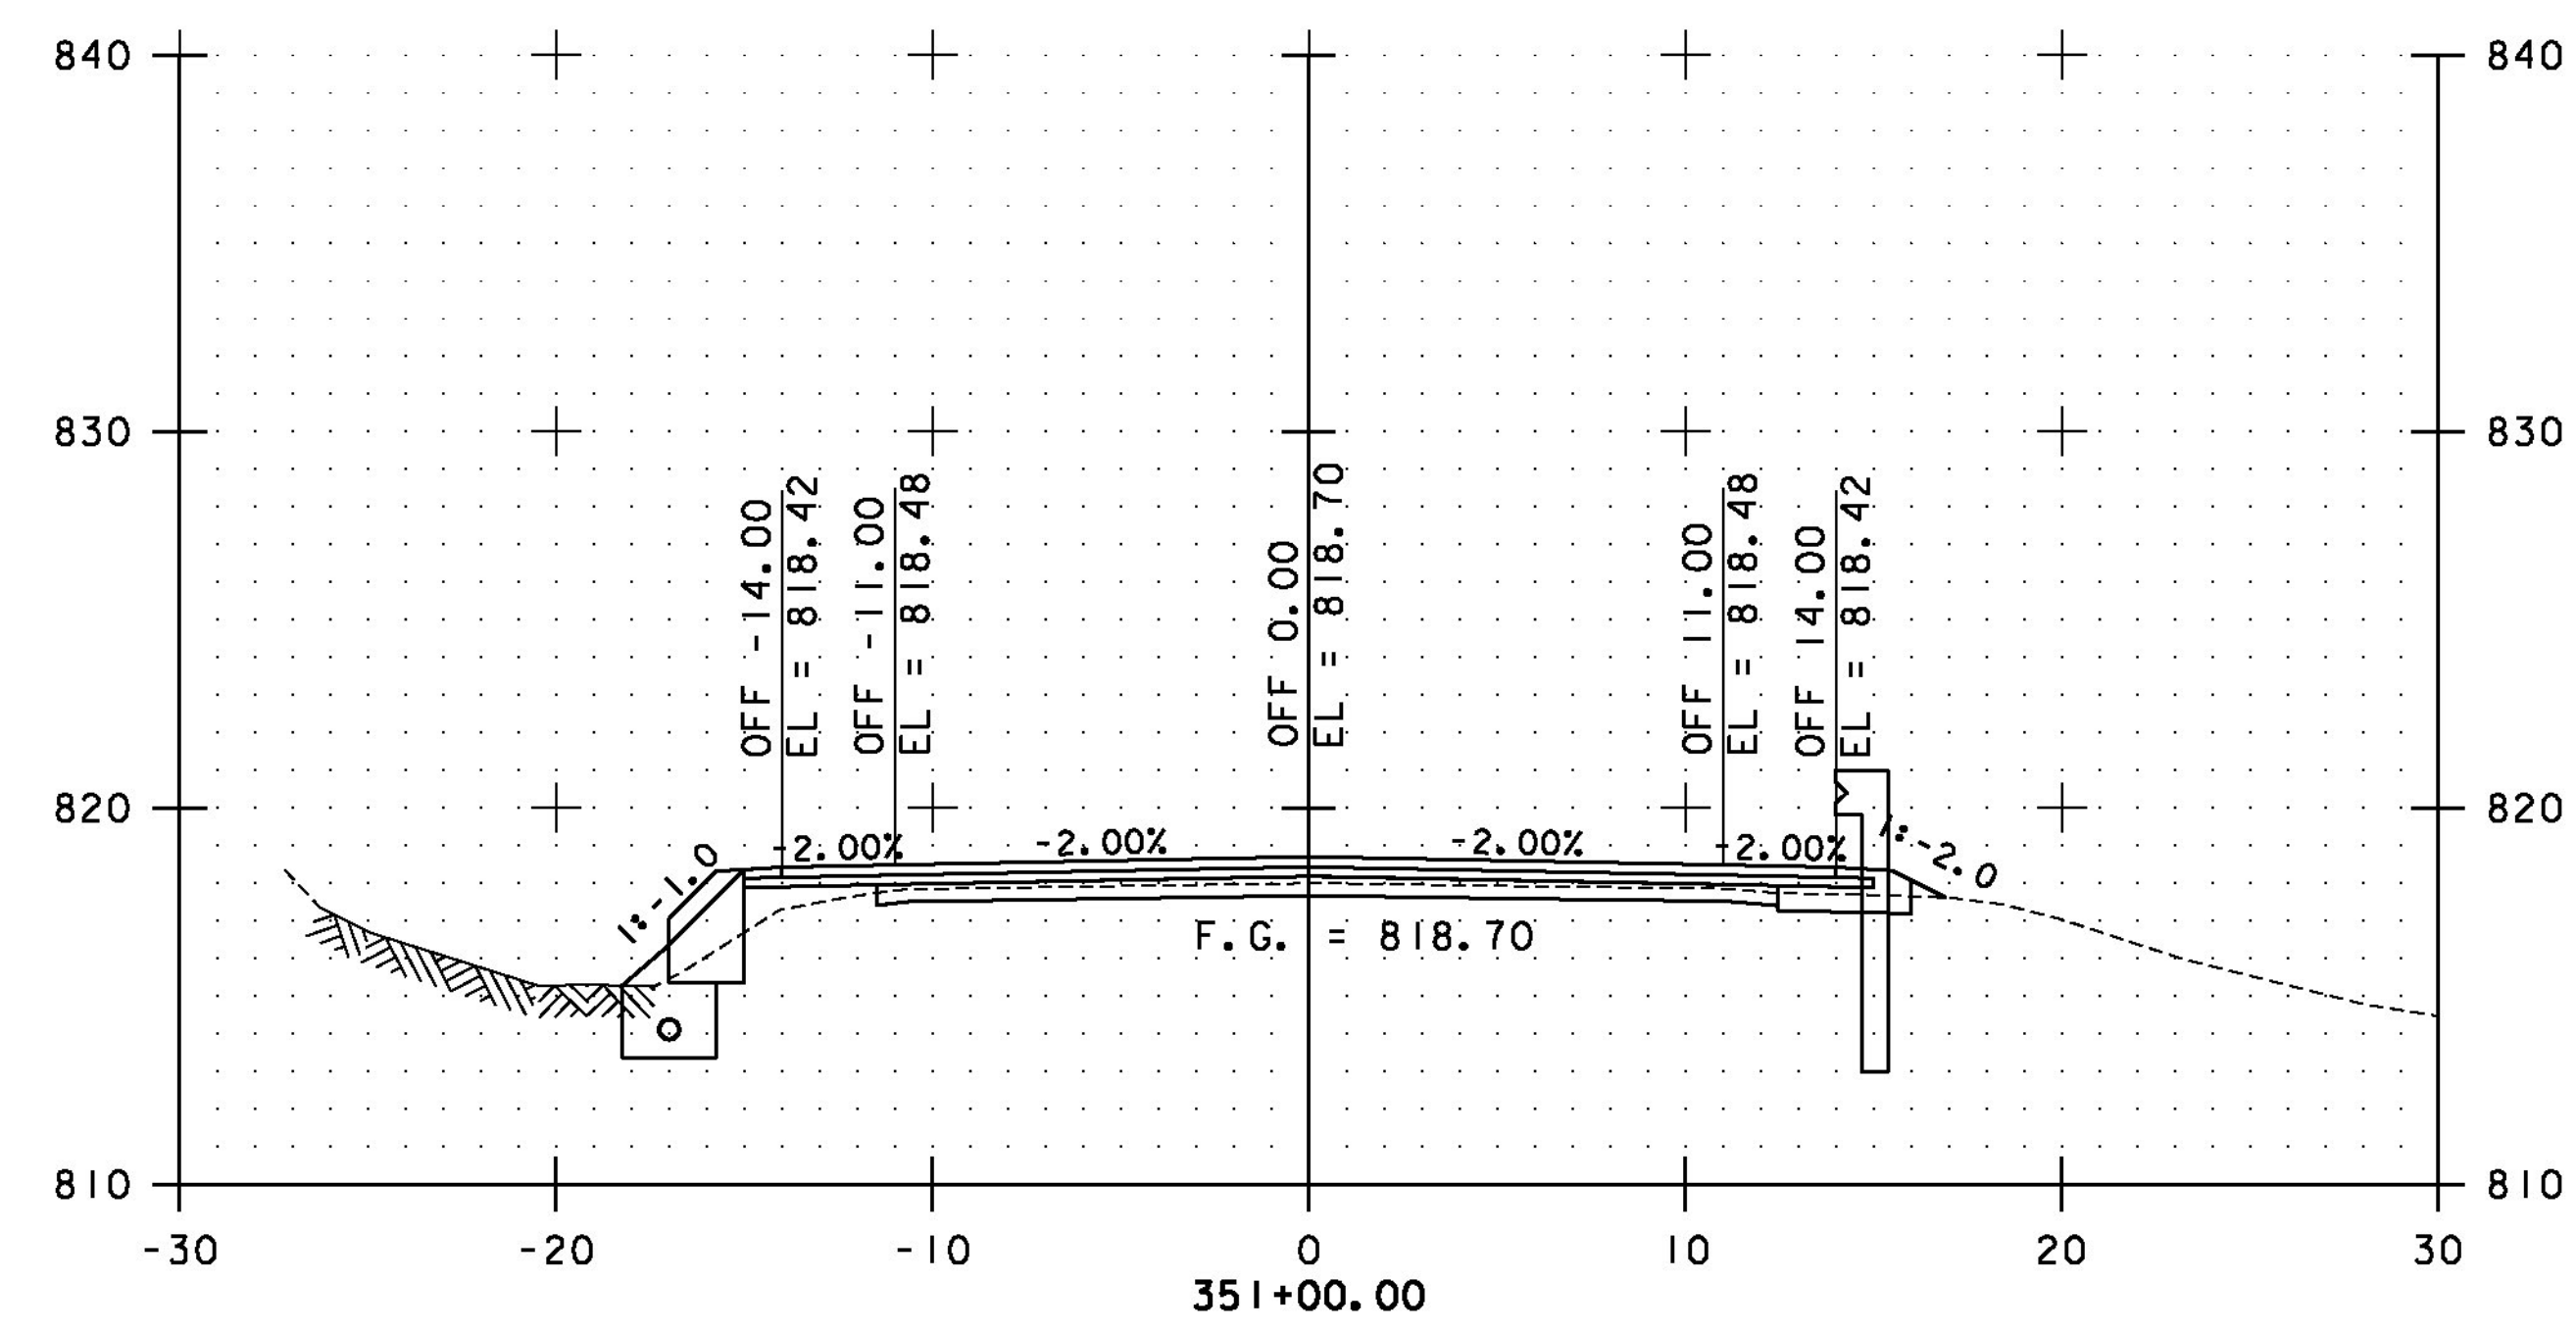


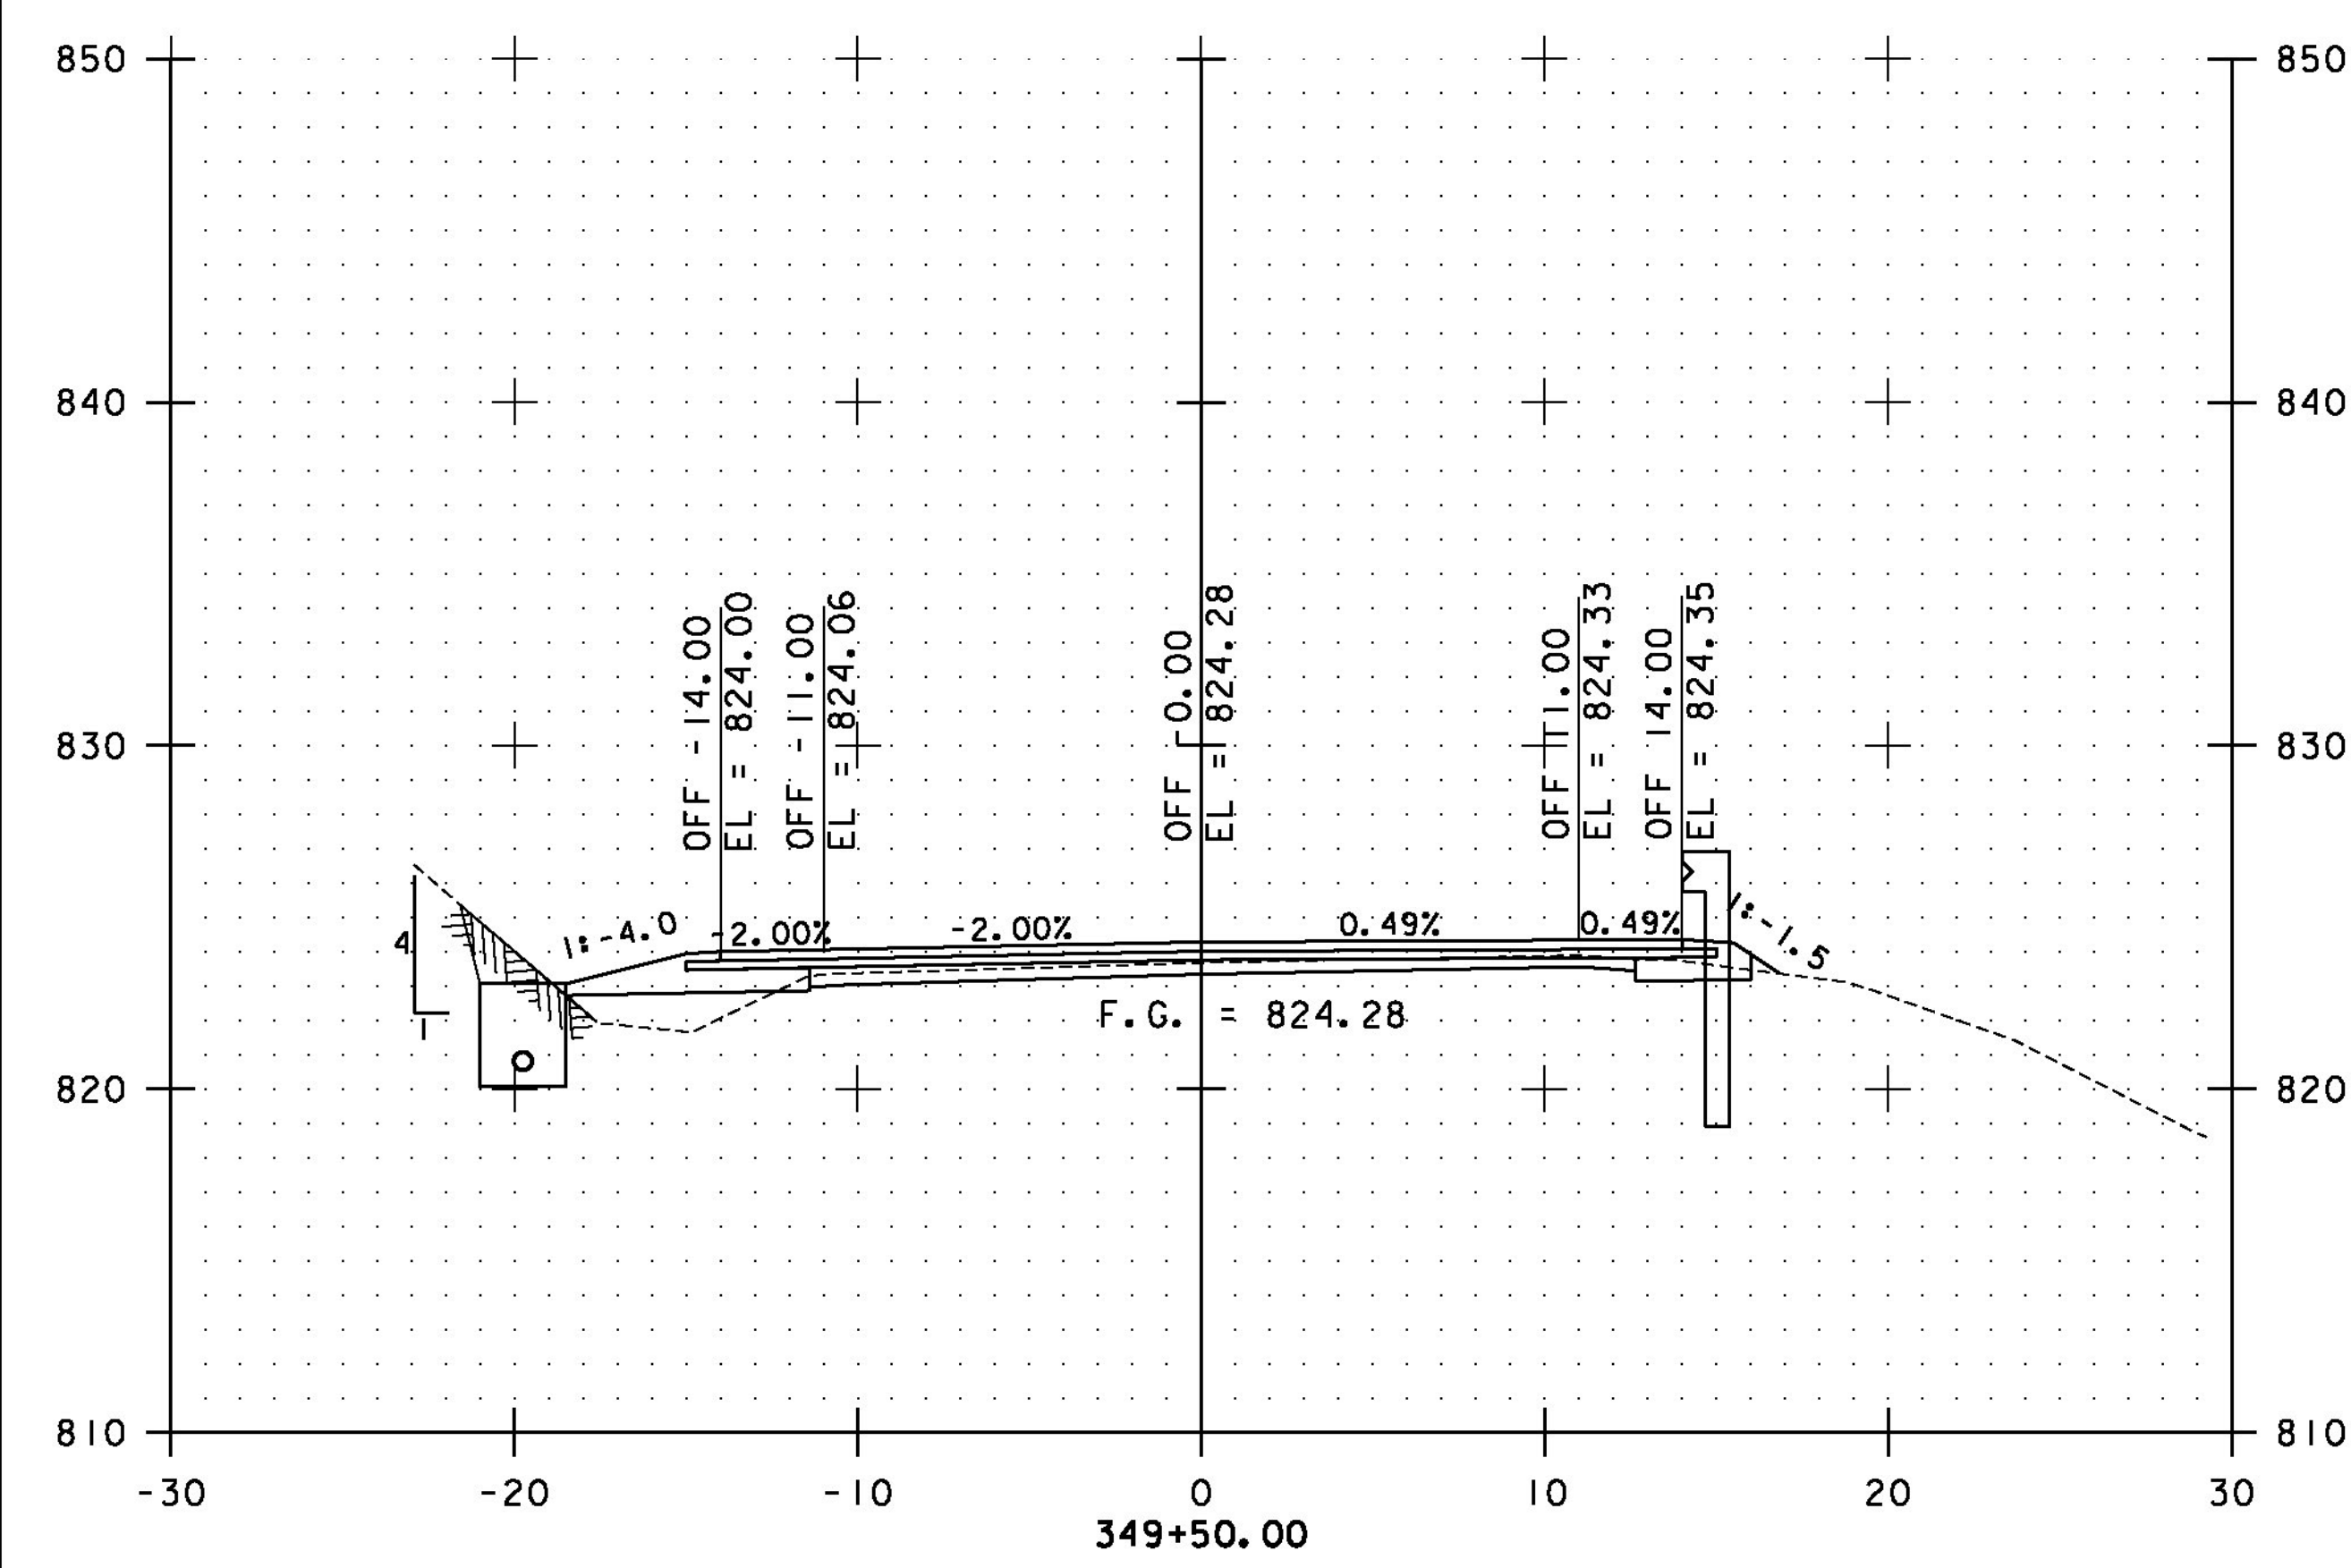

STA. 349+50 TO STA. 351+00

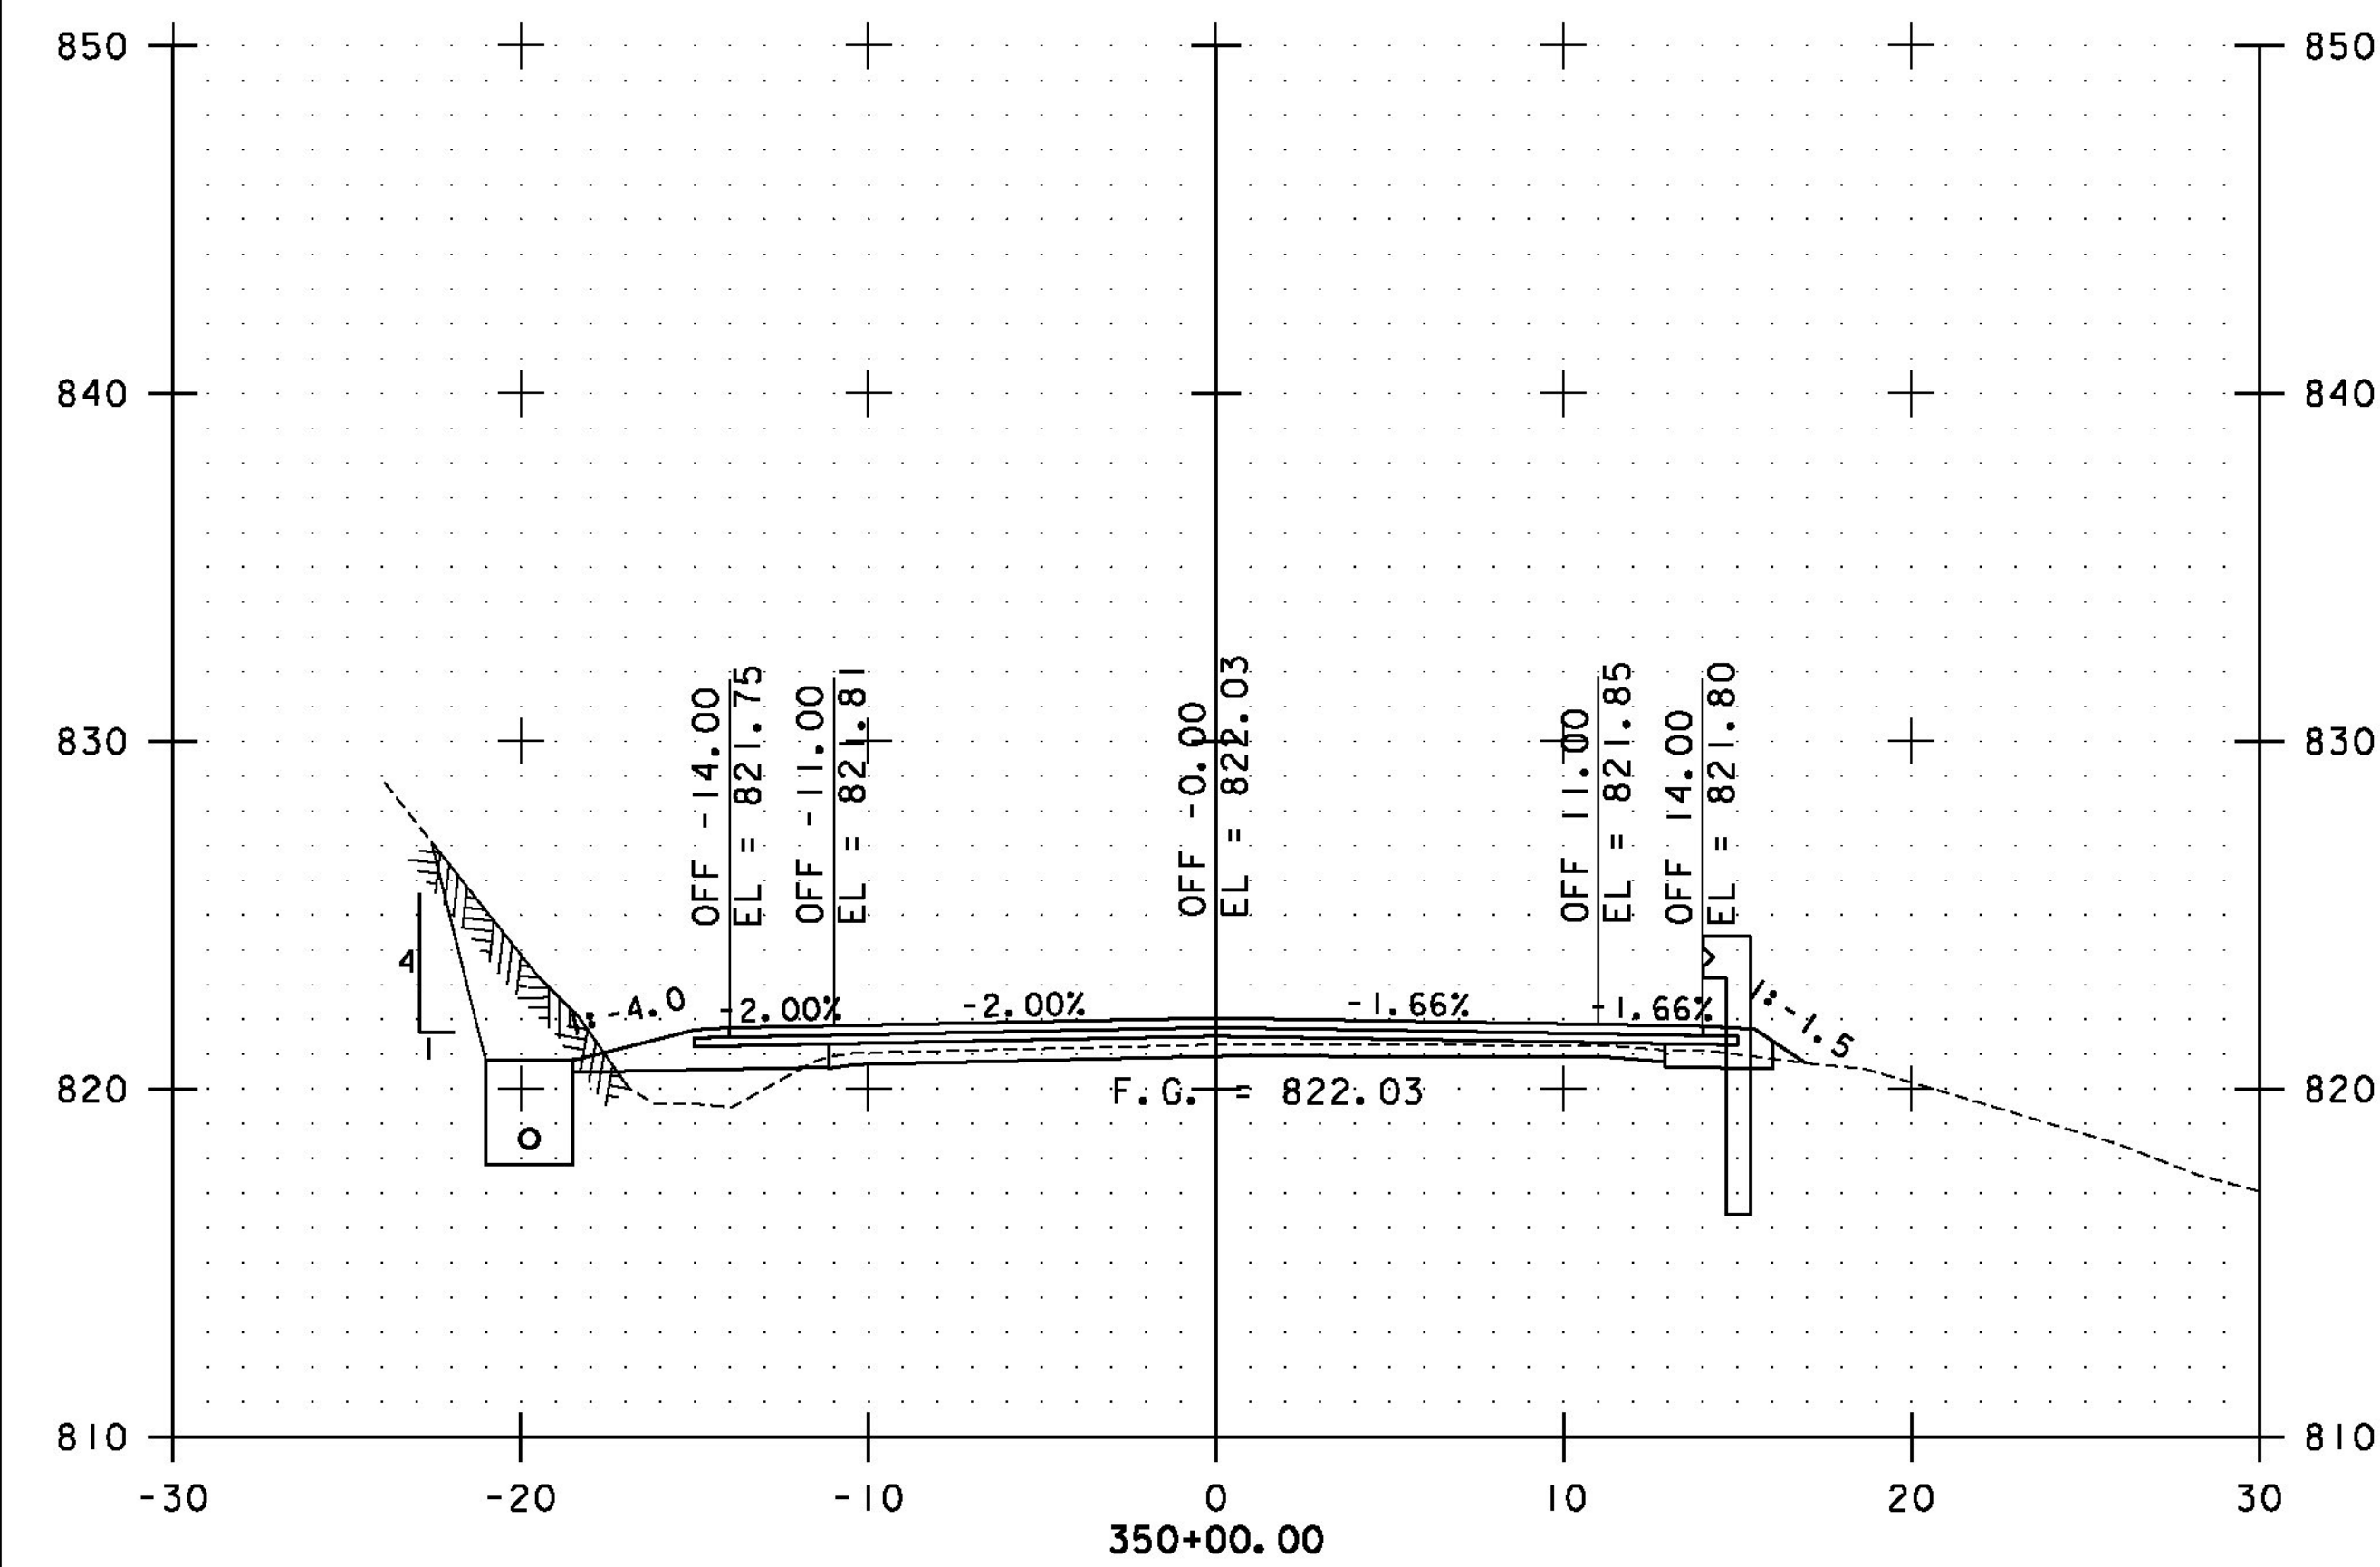

|                                                     |                        |
|-----------------------------------------------------|------------------------|
| PROJECT NAME: RANDOLPH-ROXBURY                      |                        |
| PROJECT NUMBER: ER STP 0187(II)                     |                        |
| FILE NAME: z13ci82xs.dgn                            | PLOT DATE: 11/17/2014  |
| PROJECT LEADER: M. FOISY                            | DRAWN BY: G. BURGMEIER |
| DESIGNED BY: I. MAYNARD                             | CHECKED BY: M. FOISY   |
| BRAINTREE CROSS SECTIONS SHEET 163 SHEET 392 OF 545 |                        |