

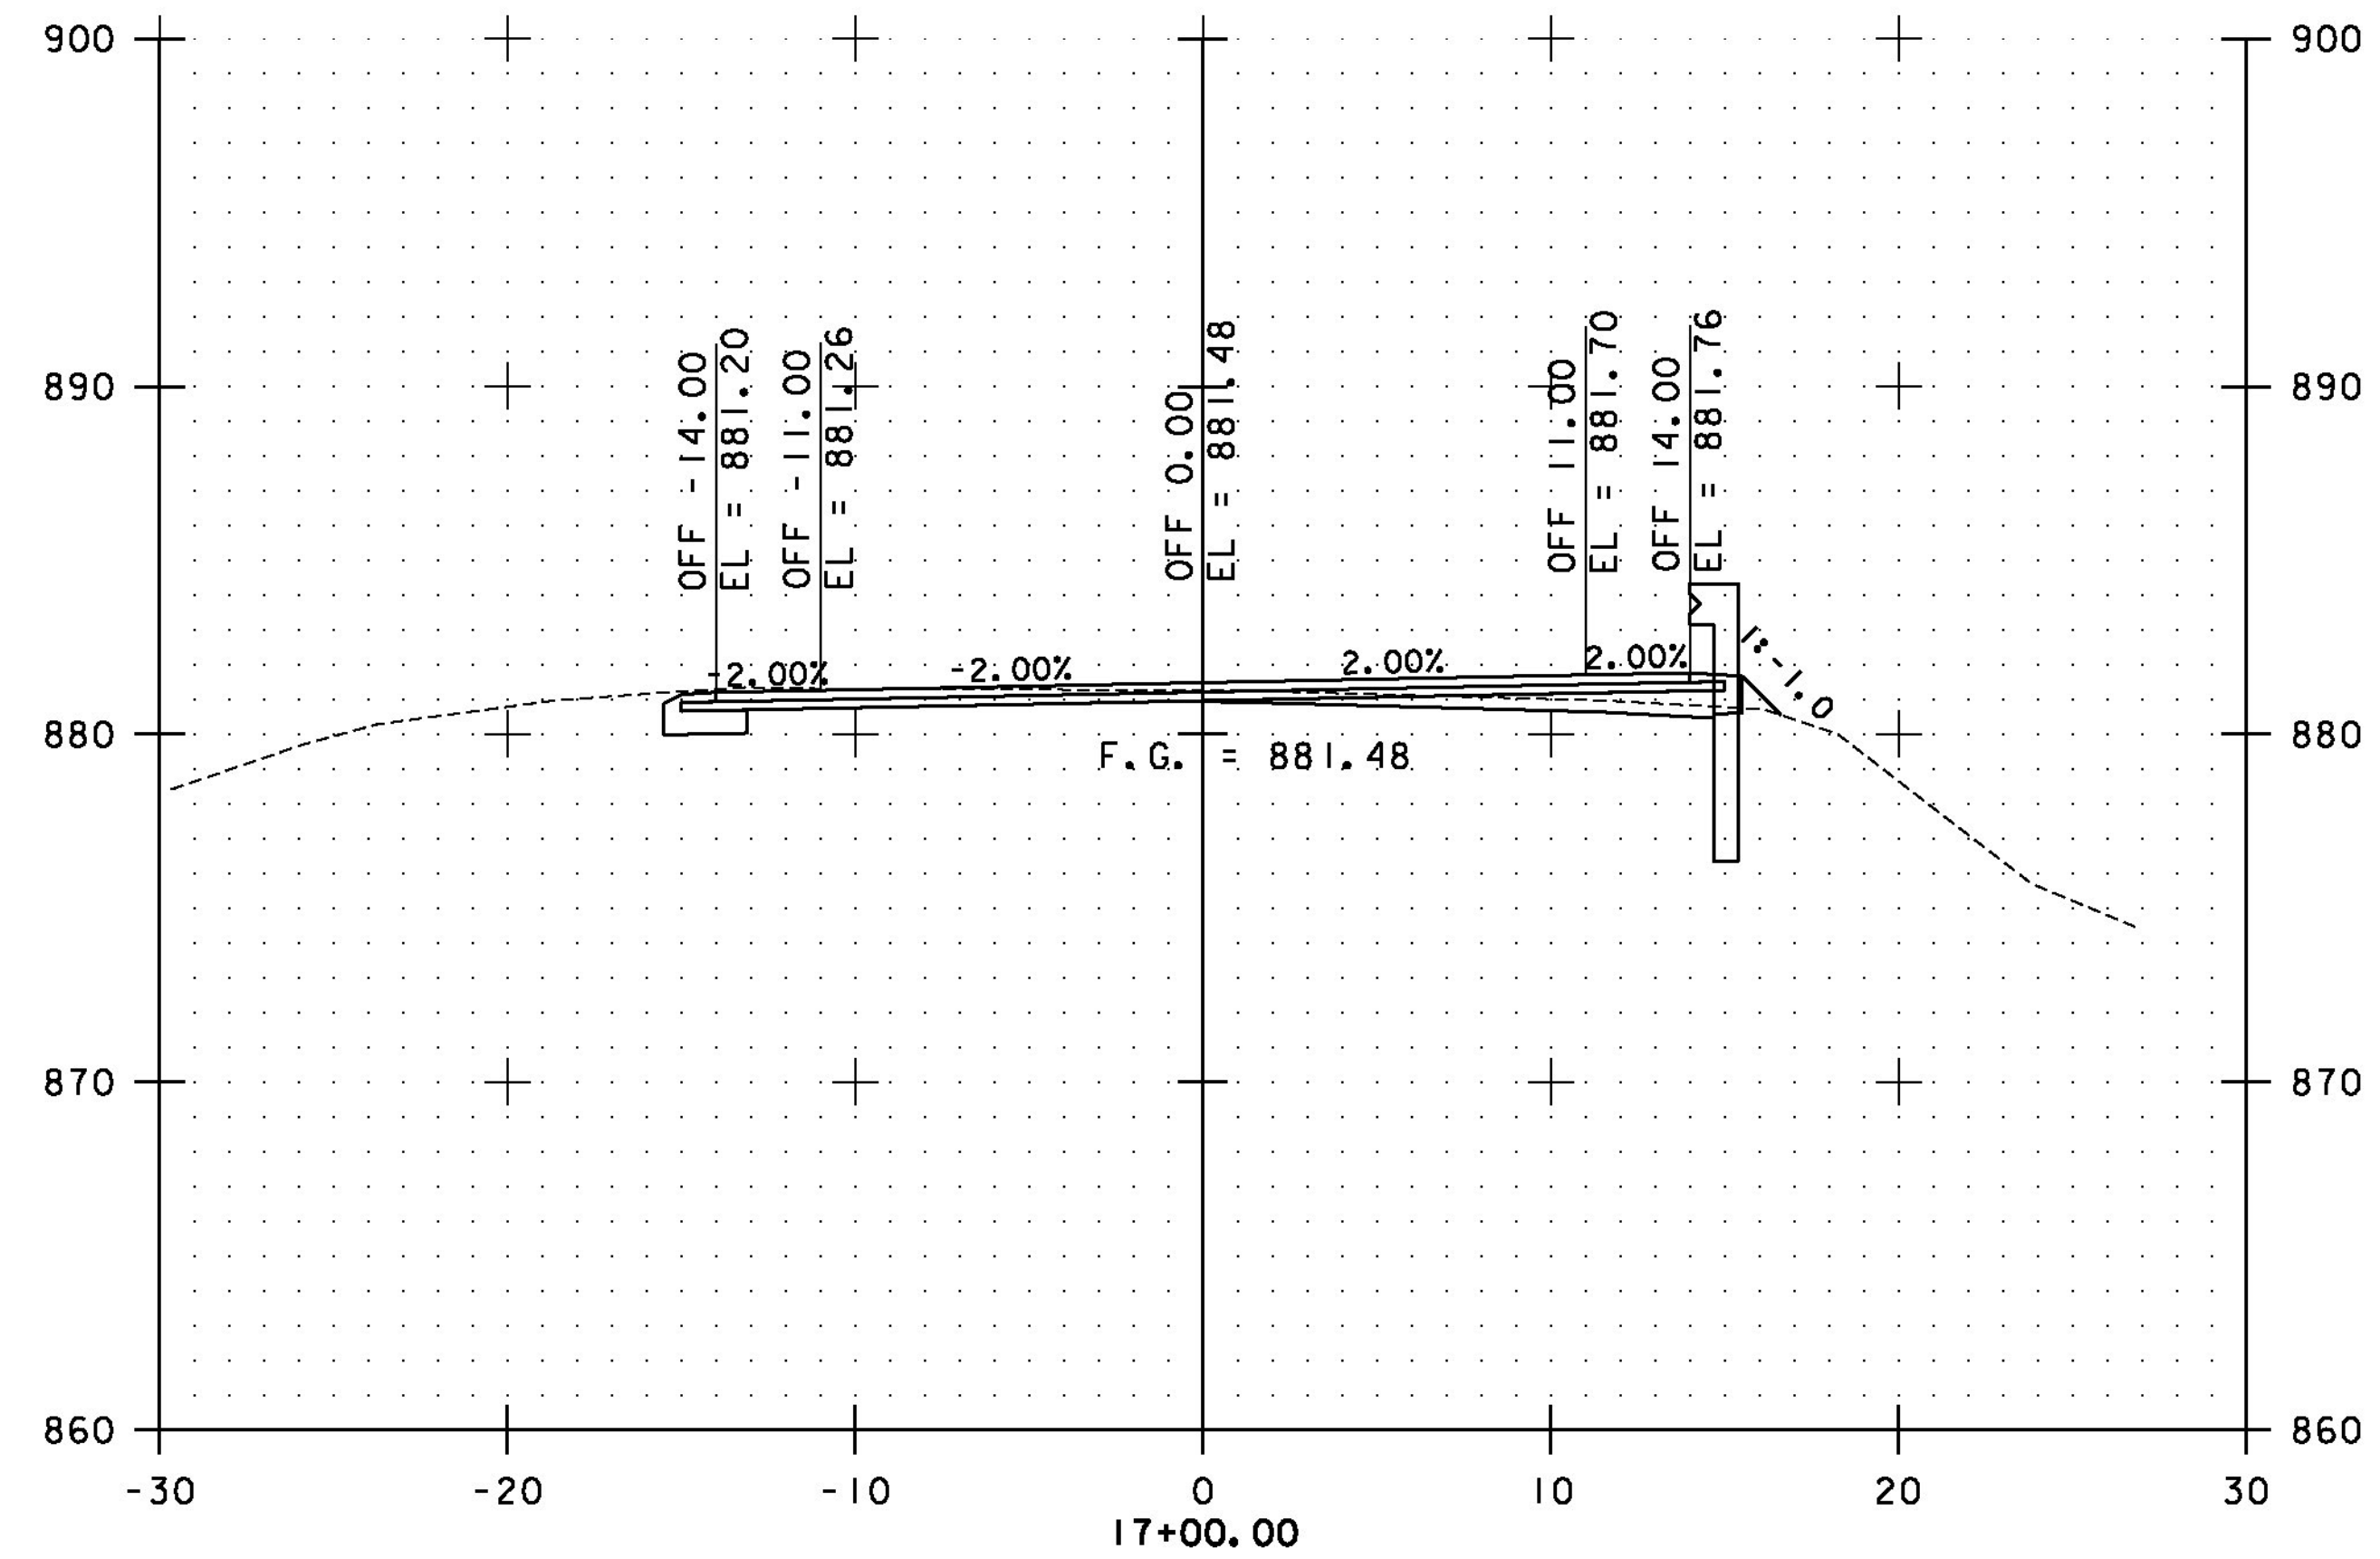
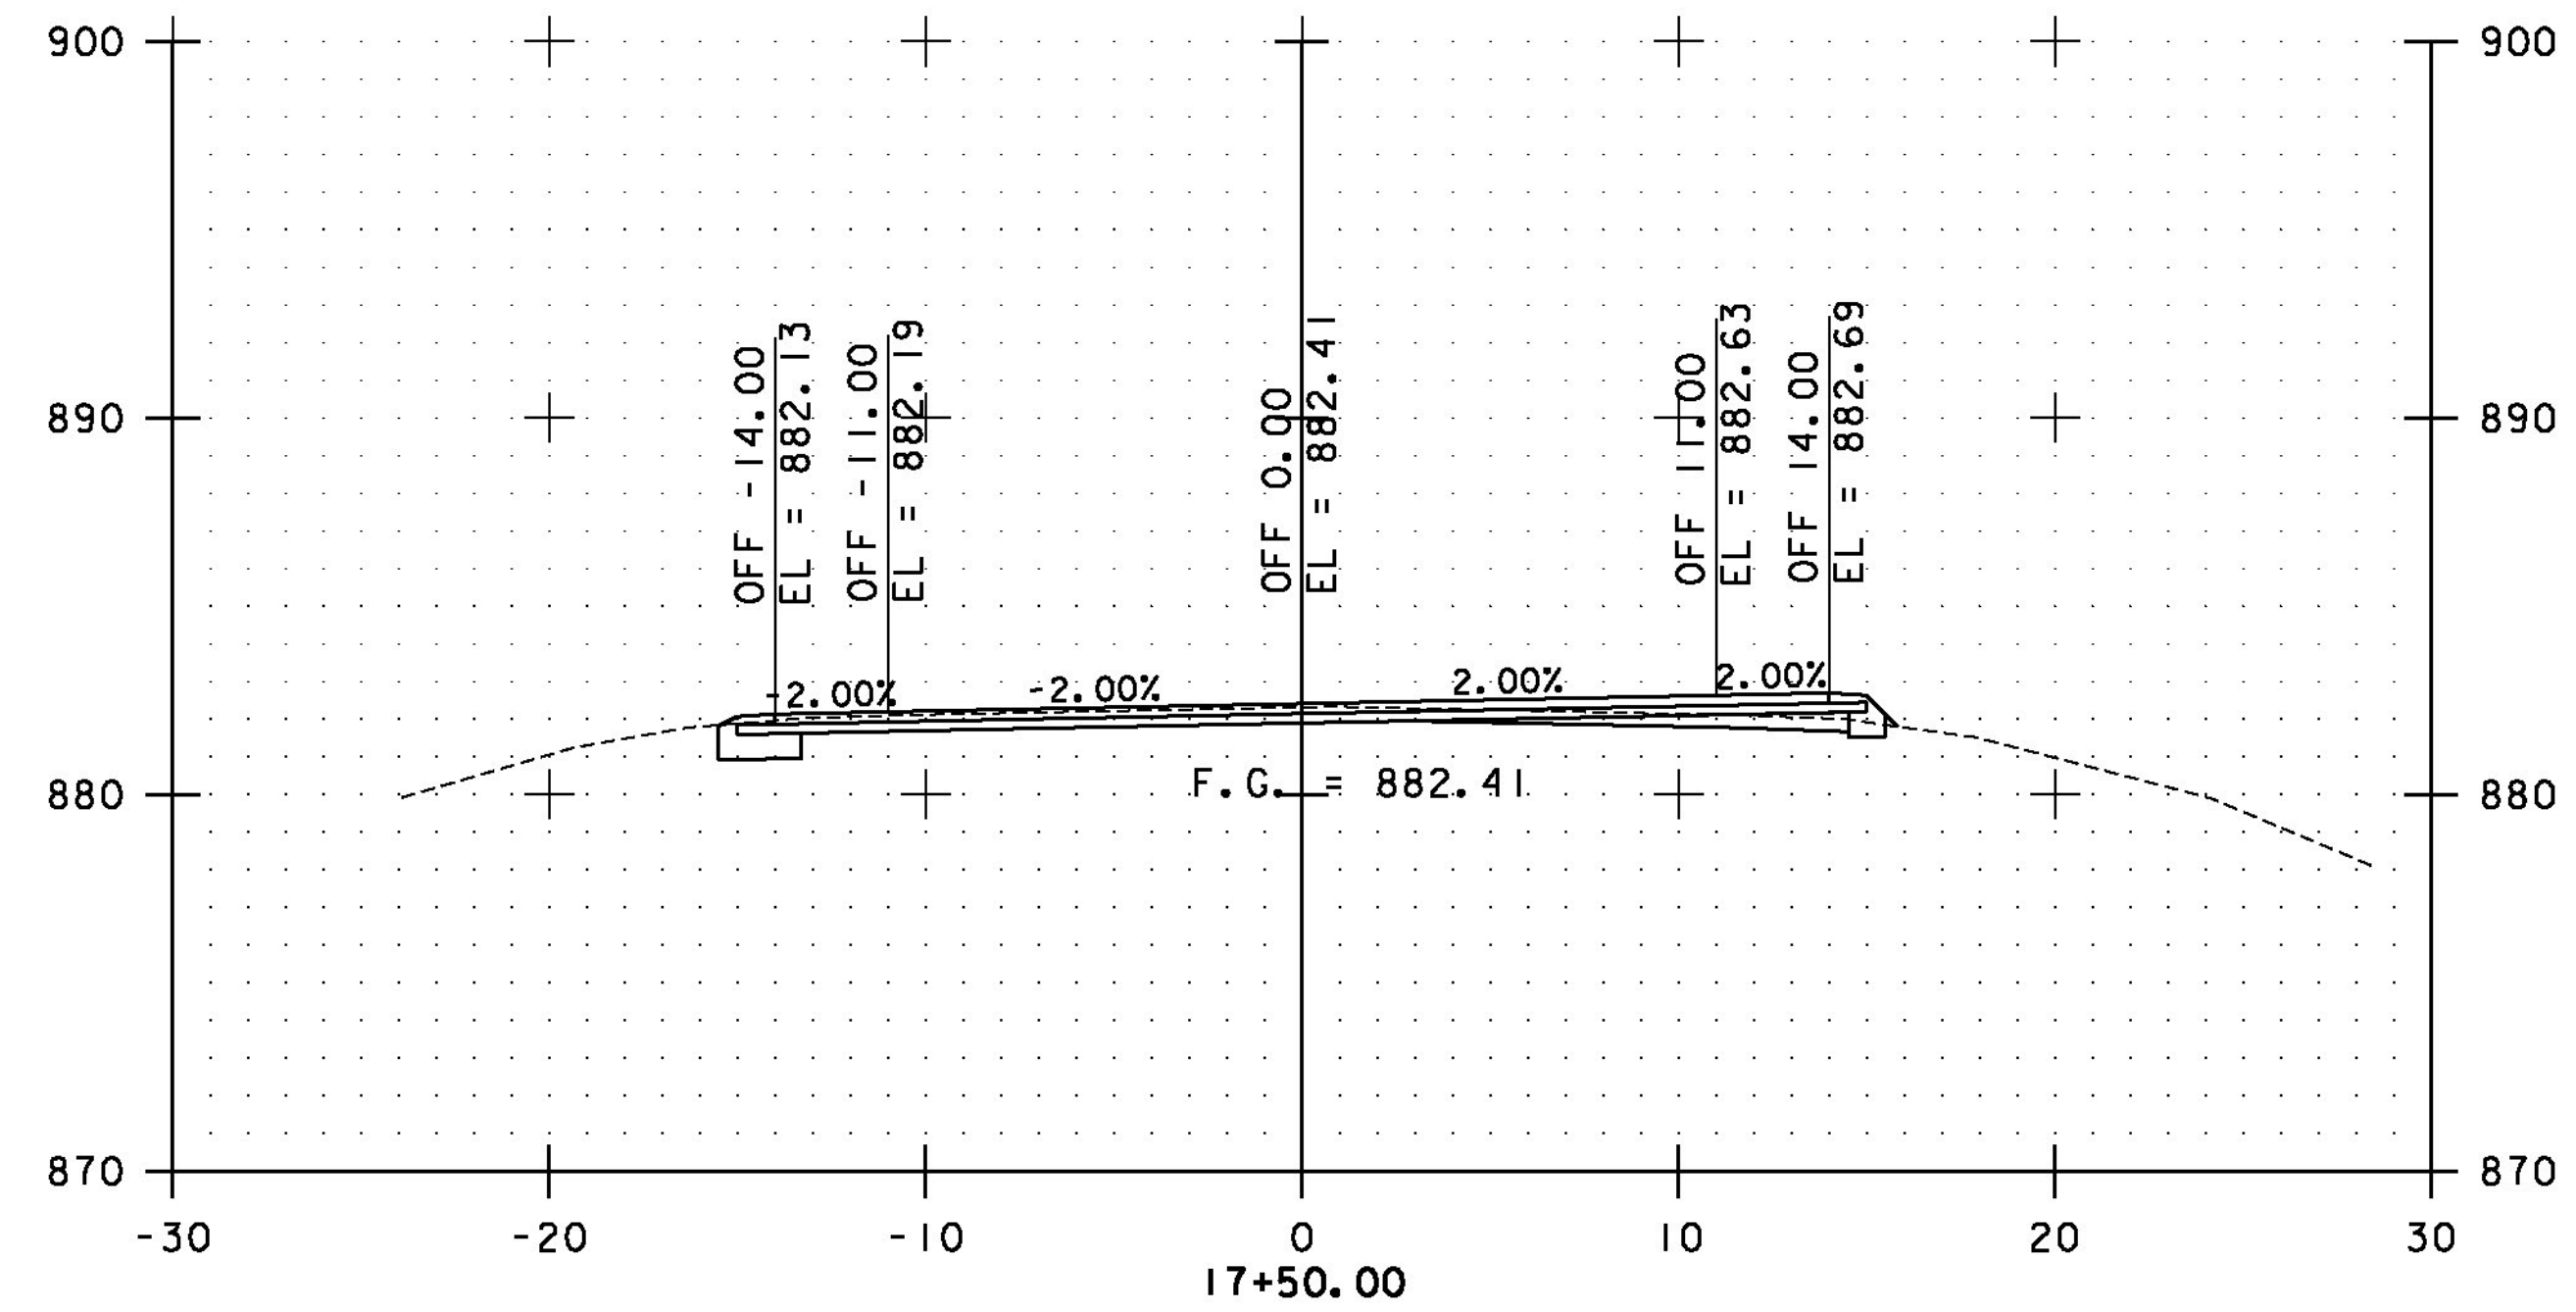


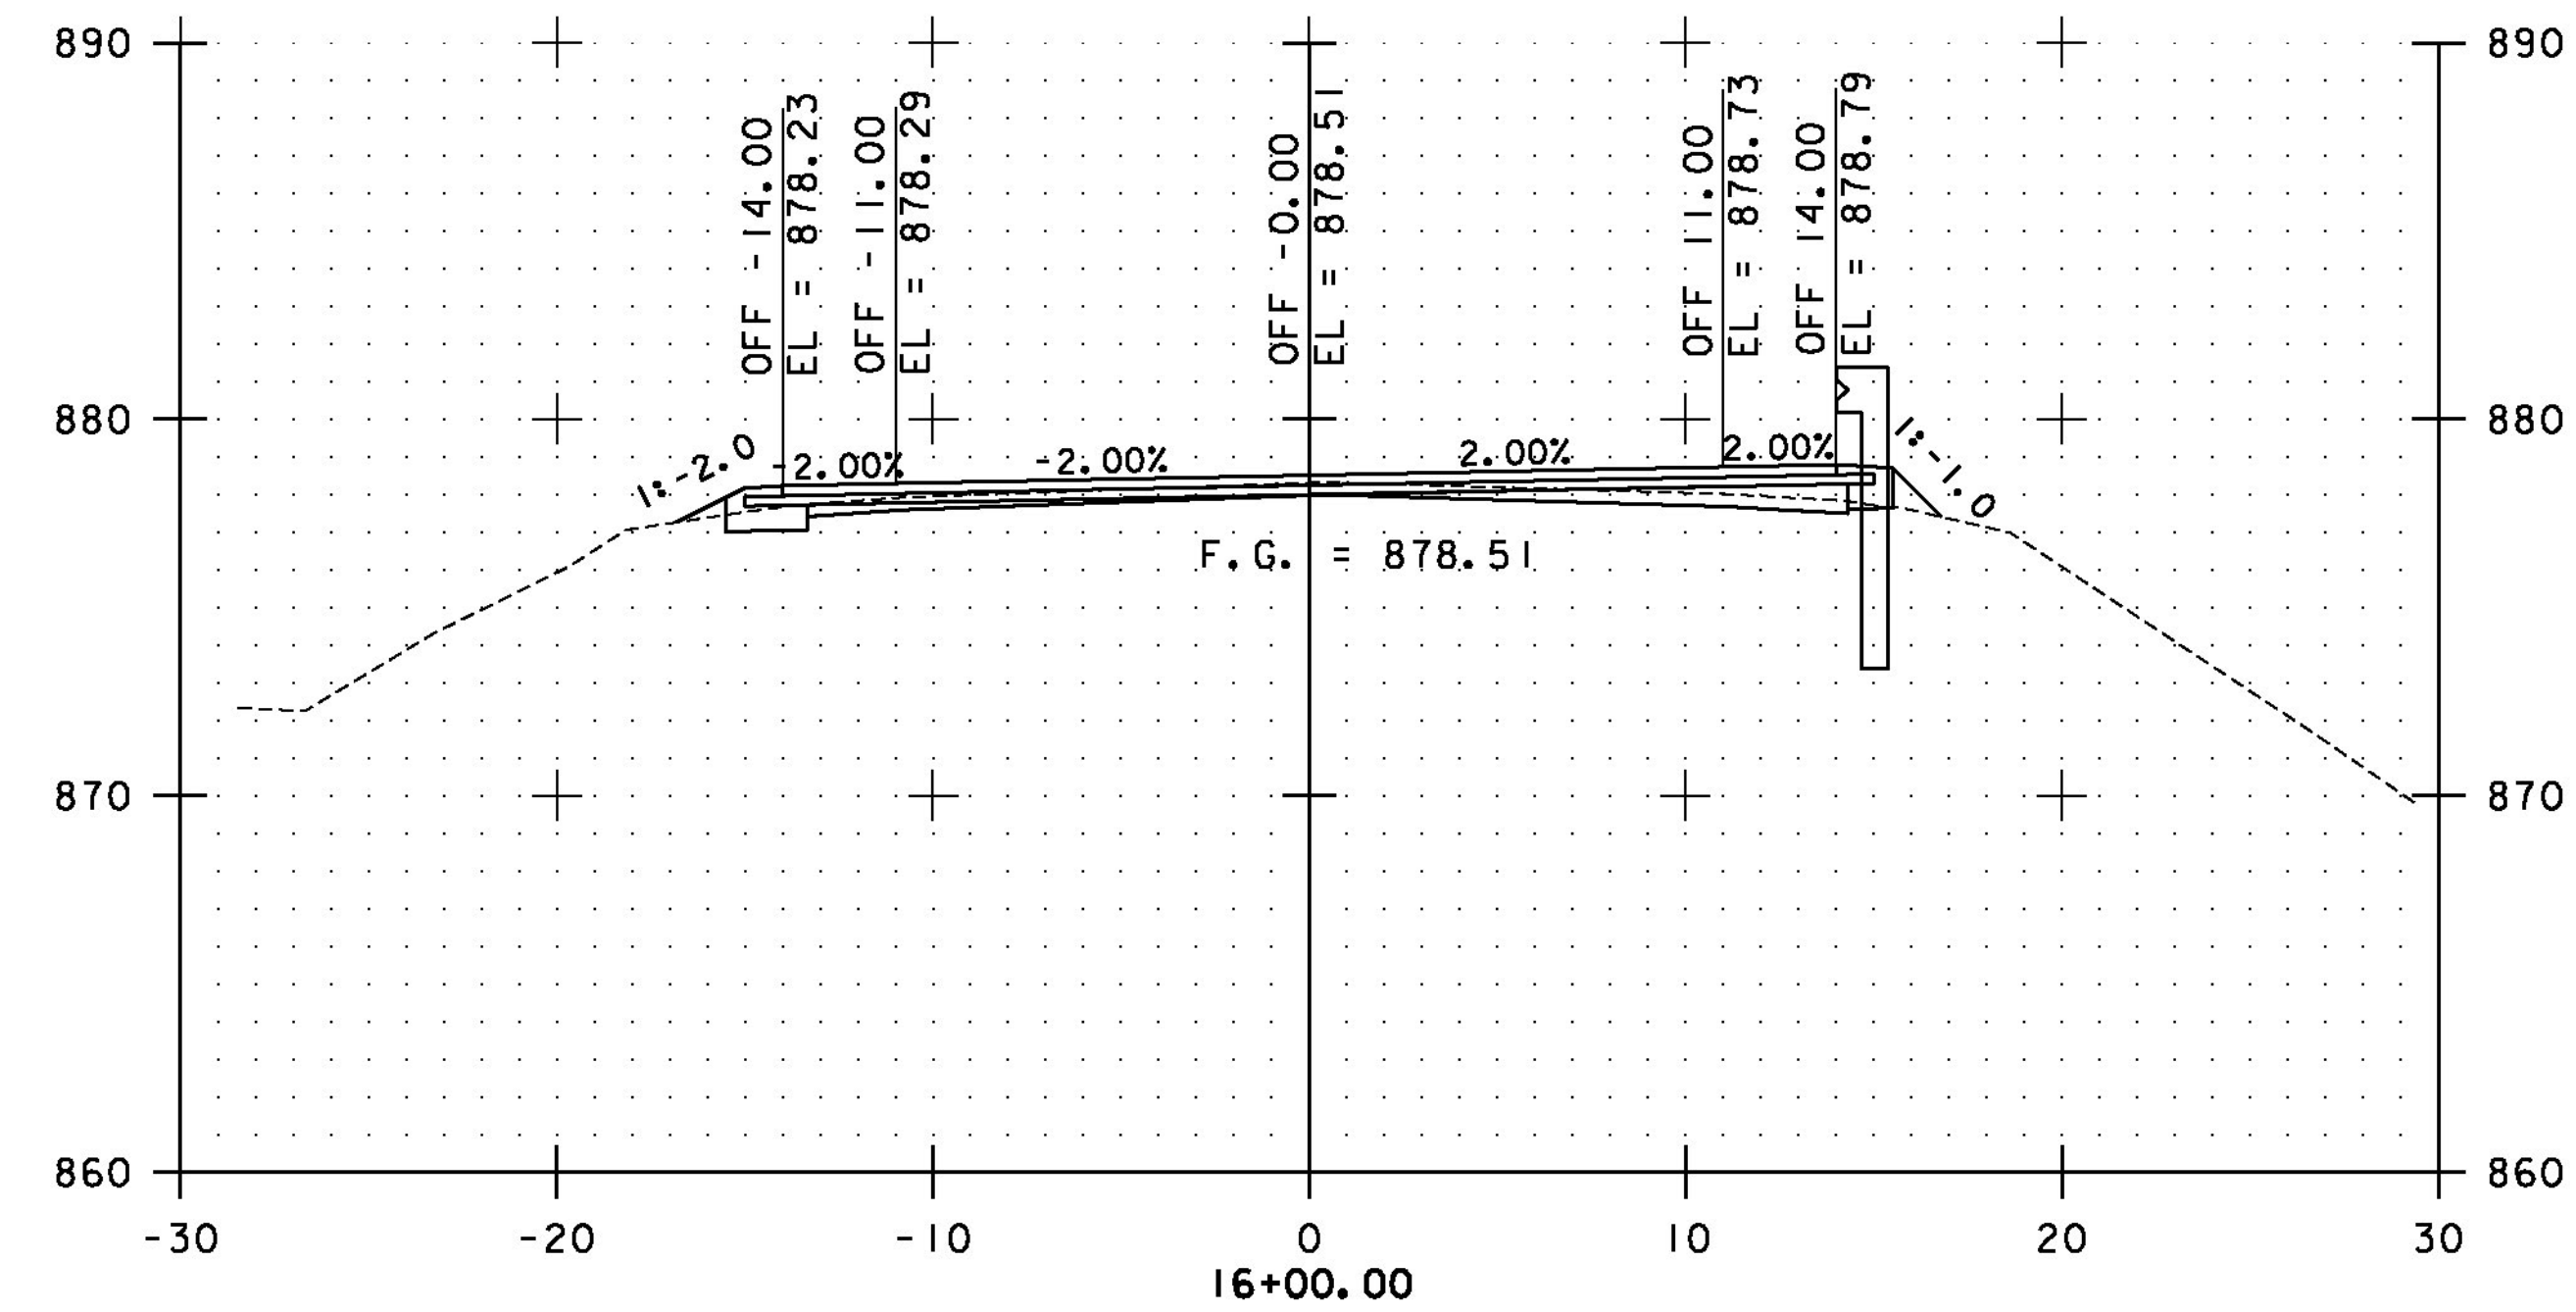

STA. 16+00 TO STA. 17+50

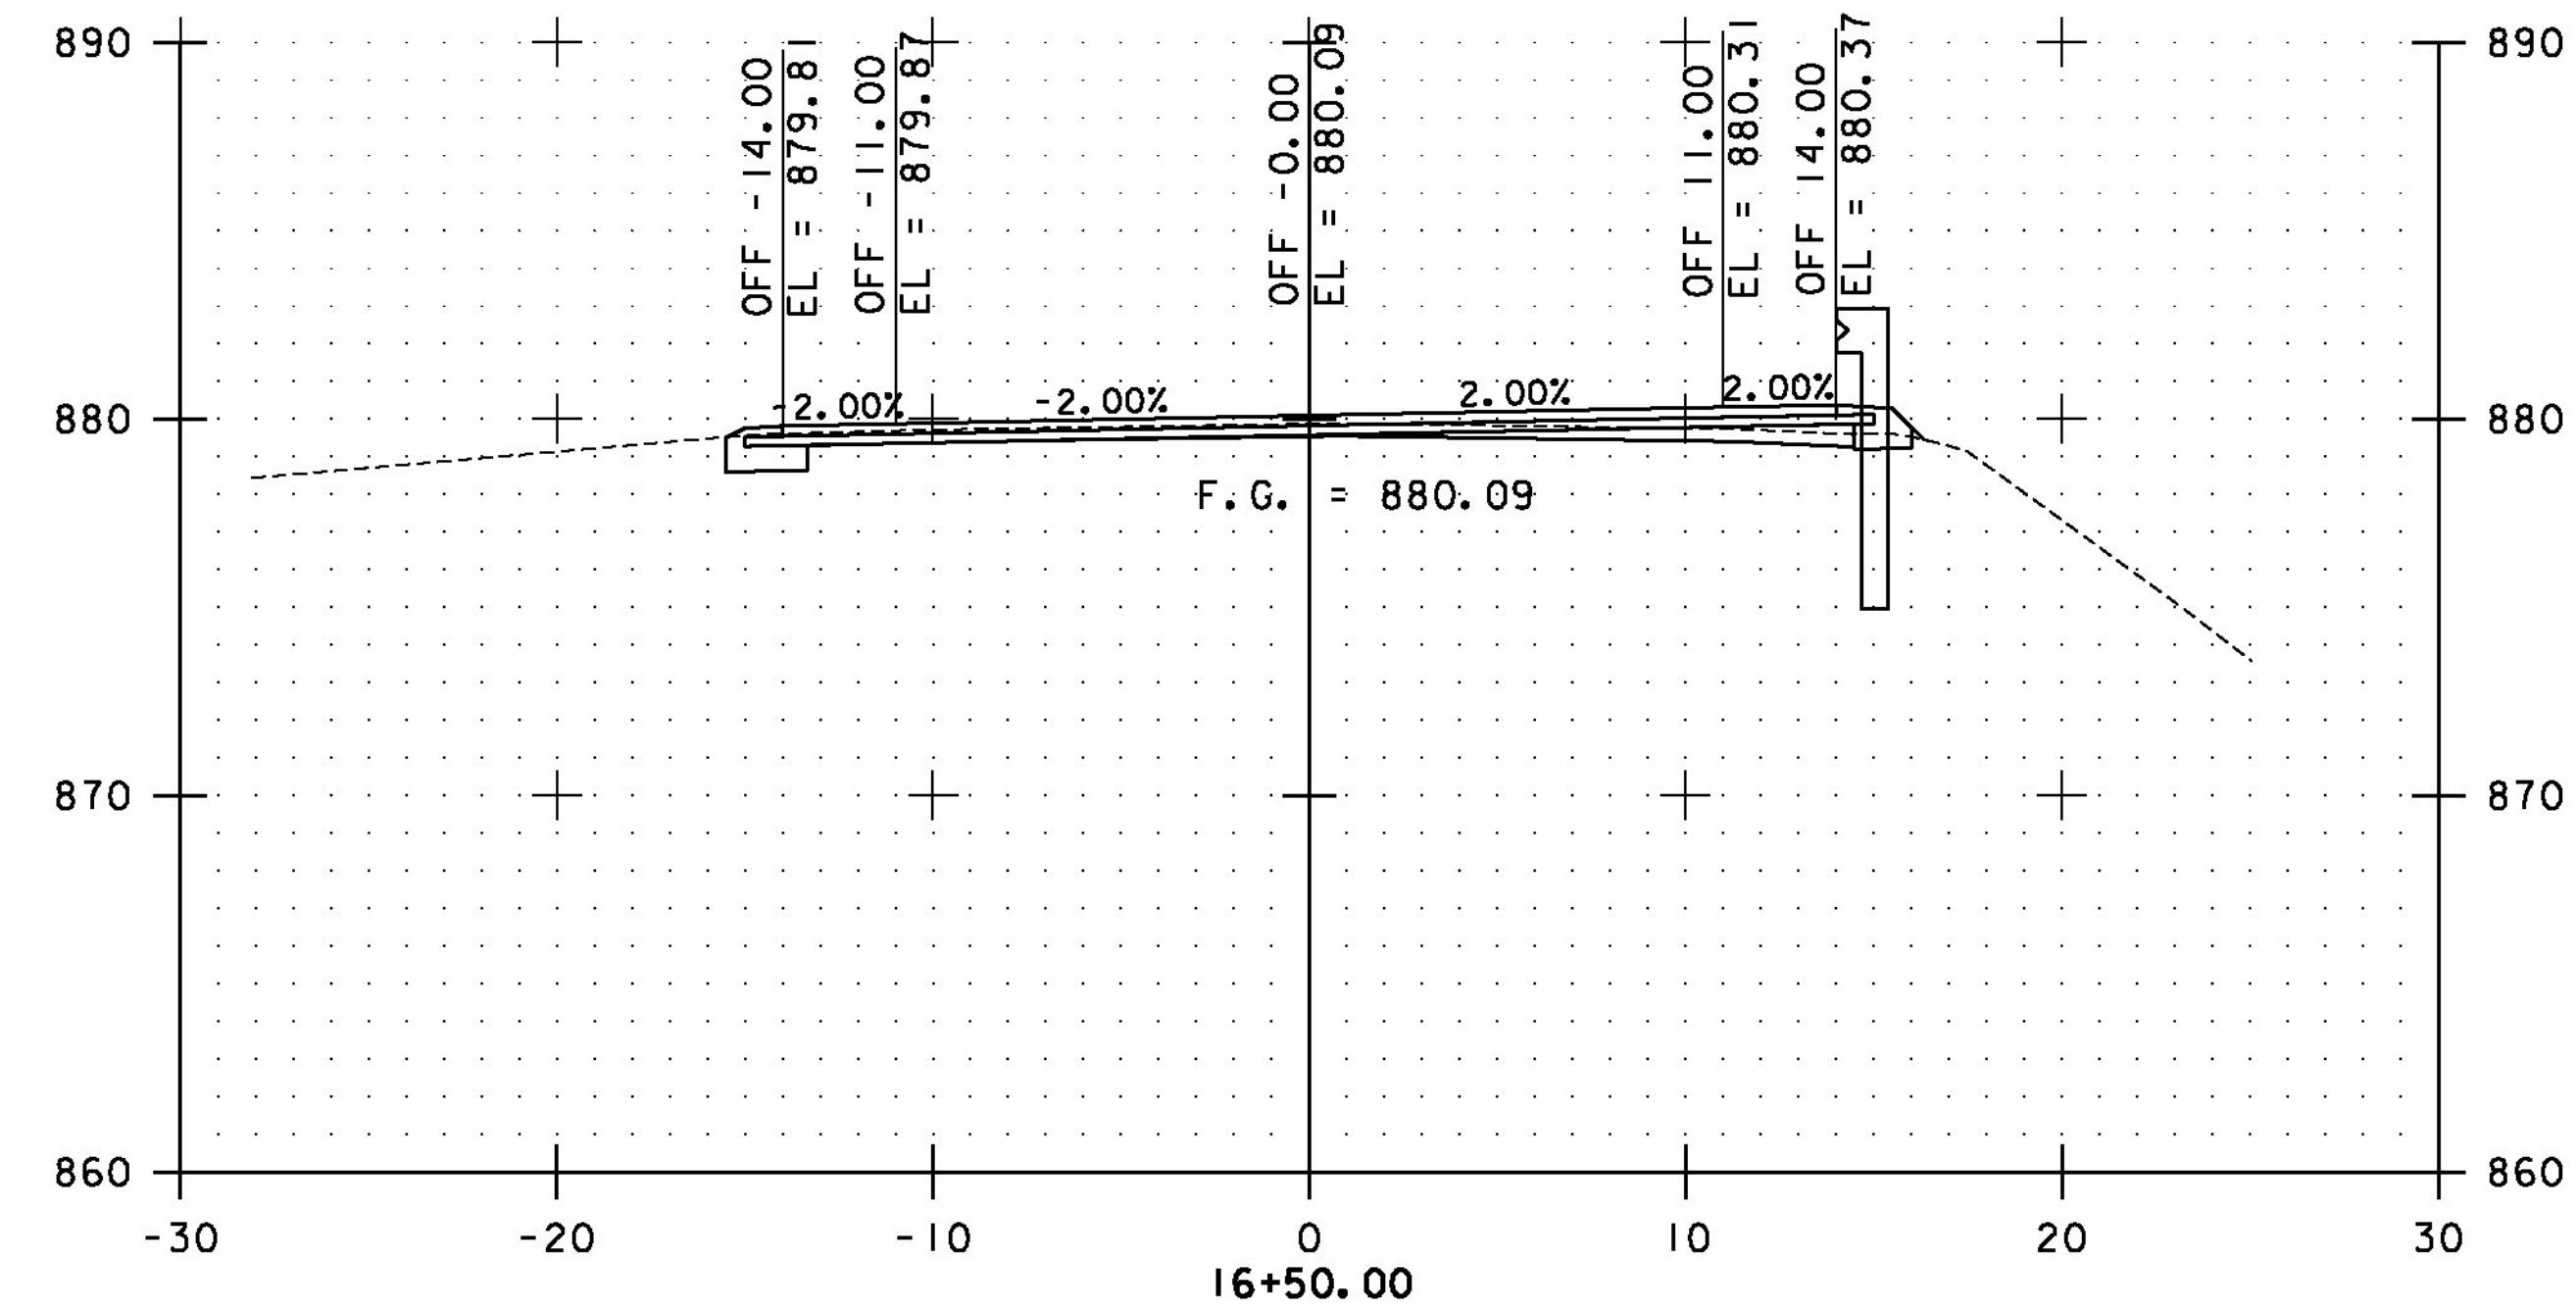

PROJECT NAME: RANDOLPH-ROXBURY	
PROJECT NUMBER: ER STP 0187(II)	
FILE NAME: z13ci82xs.dgn	PLOT DATE: 11/17/2014
PROJECT LEADER: M. FOISY	DRAWN BY: G. BURGMEIER
DESIGNED BY: I. MAYNARD	CHECKED BY: M. FOISY
ROXBURY CROSS SECTIONS SHEET 9	SHEET 456 OF 545