


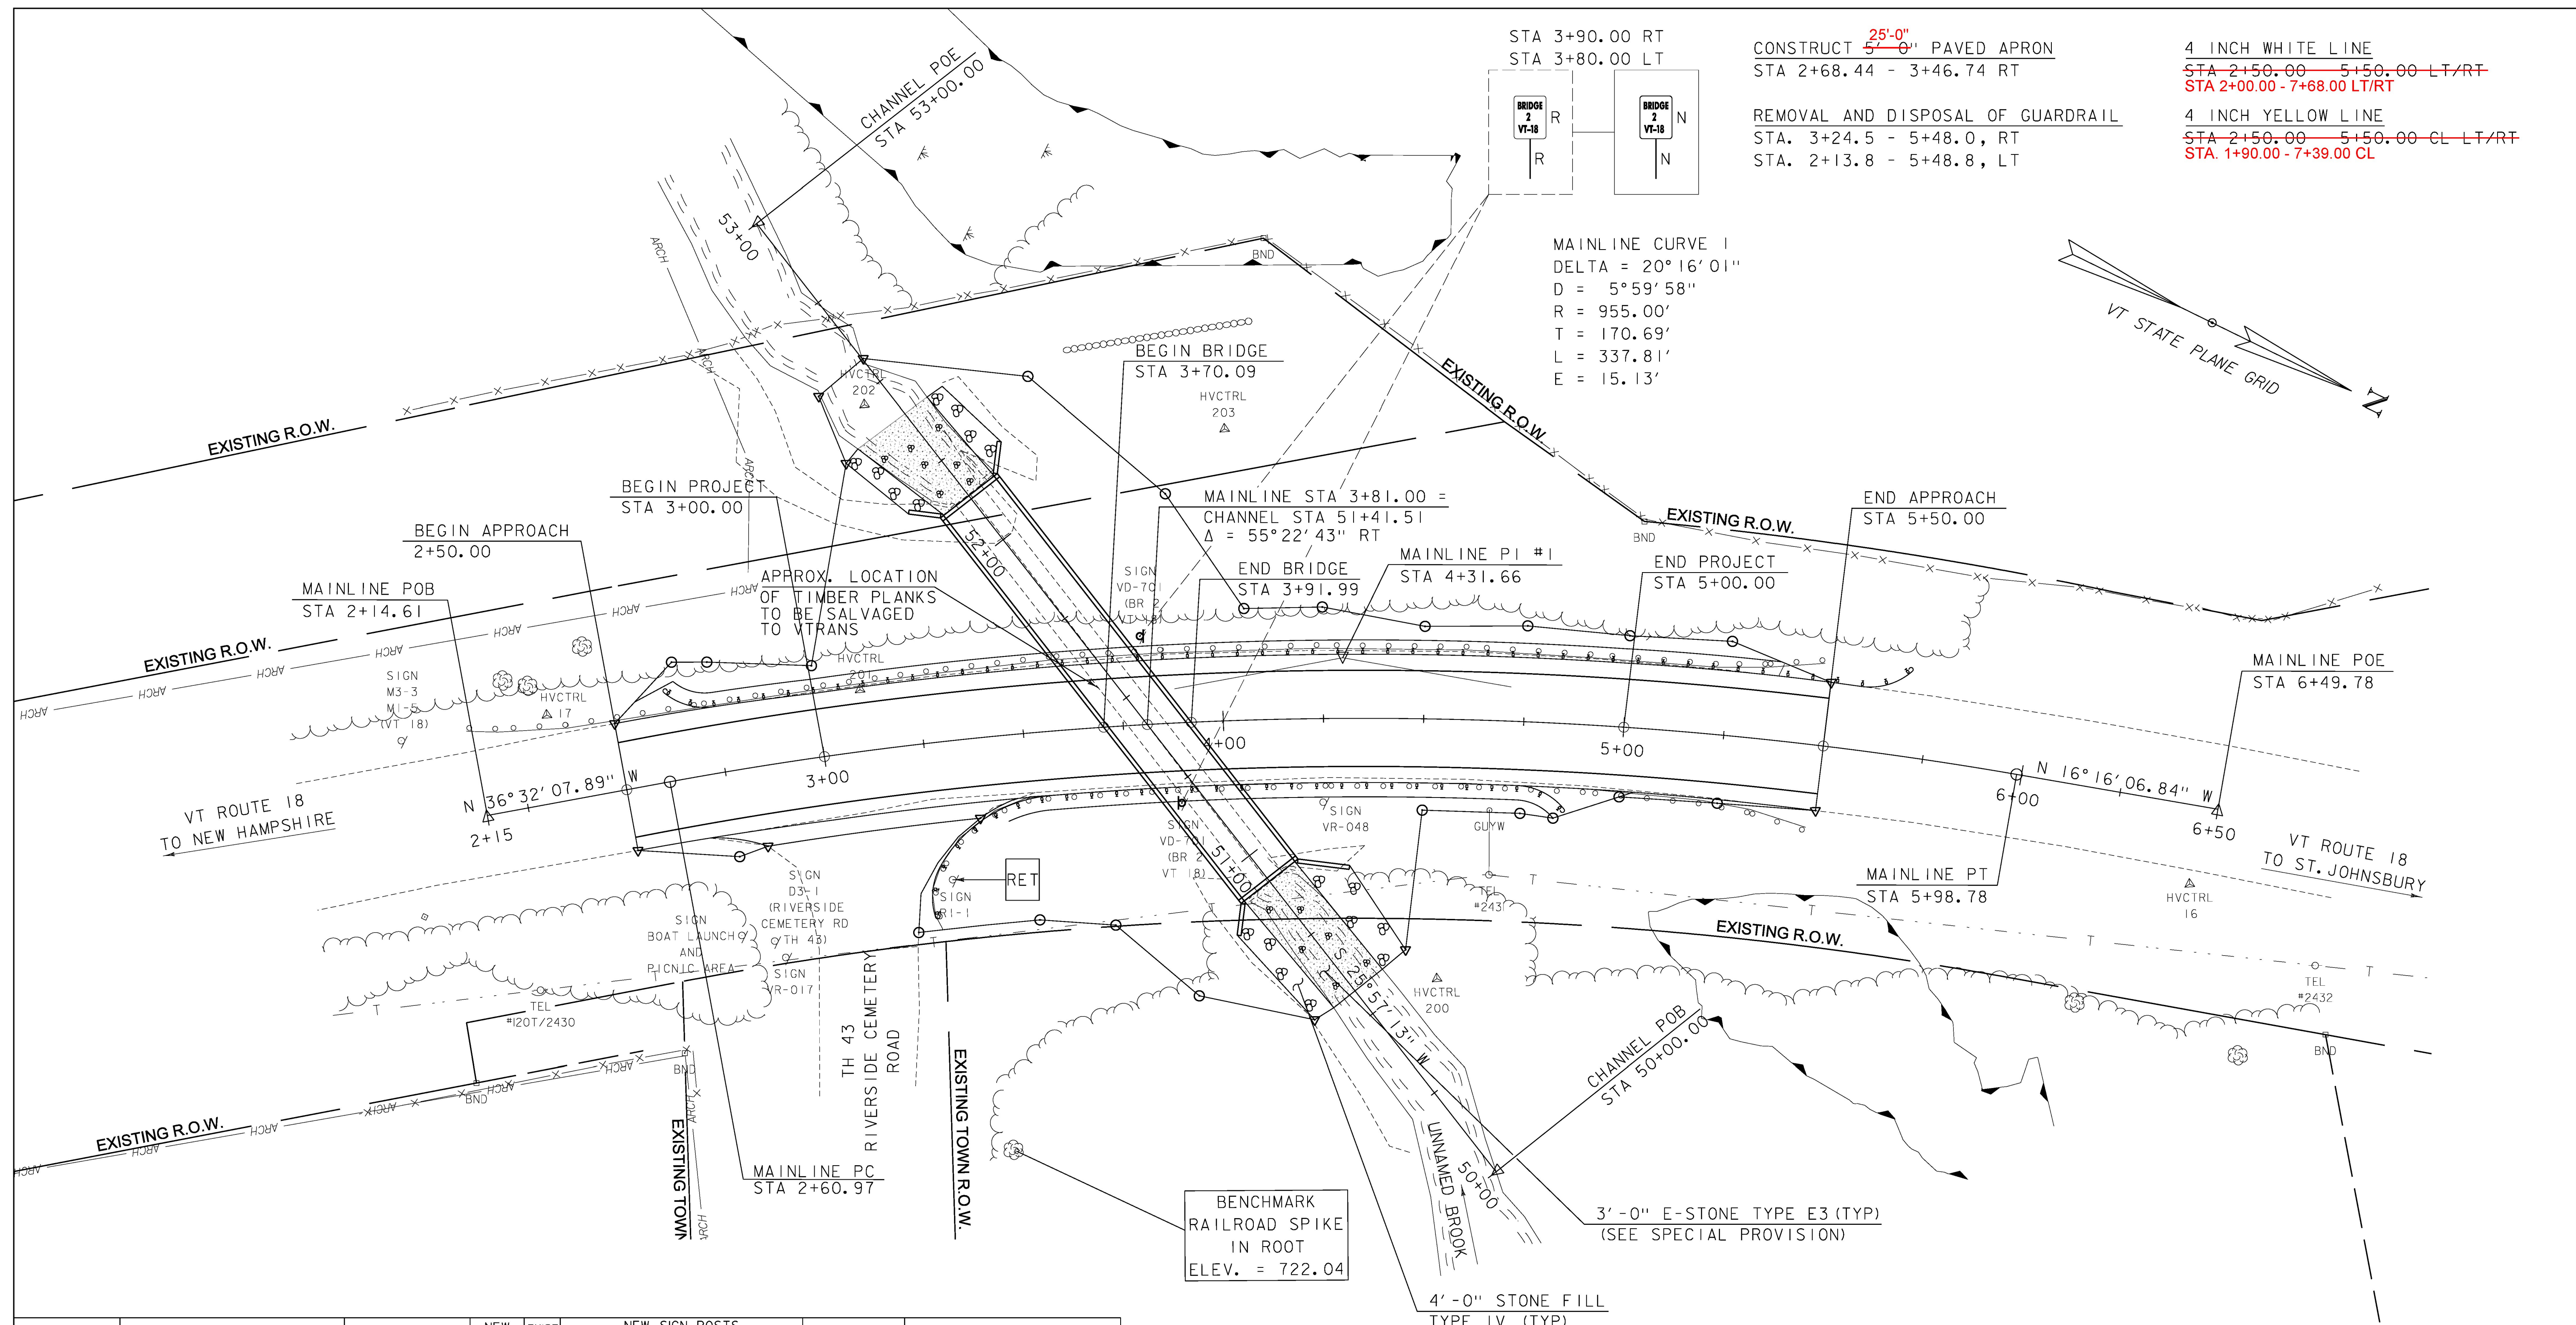

MILEMARKER, STATION, OR SIGN NUMBER	SIGN LEGEND	SIGN DIMENSIONS		NEW SIGN "A"	EXIST POST RETAIN	S S A L V A G E	N O. O F P O S T S	NEW SIGN POSTS SQUARE STEEL (in)					REMARKS	SIGN DETAIL			
		WIDTH (in)	HEIGHT (in)					2.0	2.0	2.5	ANCHOR	PLATE		MARKING	DETAIL IN SHSM	DETAIL ON SHEET NUMBER	STD. SHEET NUMBER
								2.16	16/ft	2.42							
3+90.00 RT	BRIDGE 2 VT-18	6	10	0.42			I	8				X		VD-701			T-42
3+80.00 LT	BRIDGE 2 VT-18	6	10	0.42			I	8				X		VD-701			T-42
FINAL POST LENGTHS ARE TO BE DETERMINED IN THE FIELD. POST SIZES ARE COMPUTED BASED ON INFORMATION FURNISHED ON THE STANDARD SHEETS AND THE VTRANS "SIGN POST DESIGN GUIDELINE."								FT 16	FT	FT		EA	SIGN LEGEND N = NEW R = REMOVE S = SALVAGE RET = RETAIN SHSM = STANDARD HIGHWAY SIGNS AND MARKINGS (MUTCD) (APPROVED BY THE FHWA)				
TOTALS				SF 0.84			FT 16										

LAYOUT

SCALE 1" = 20'-0"



PROJECT NAME: WATERFORD	
PROJECT NUMBER: BF 0225(5)	
FILE NAME: z15b051bdr.dgn	PLOT DATE: 09/27/2017
PROJECT LEADER: T. LEVINS	DRAWN BY: B. WILLIAMS
DESIGNED BY: J. MERCER	CHECKED BY: T. LEVINS
LAYOUT SHEET	SHEET 40 OF 63