




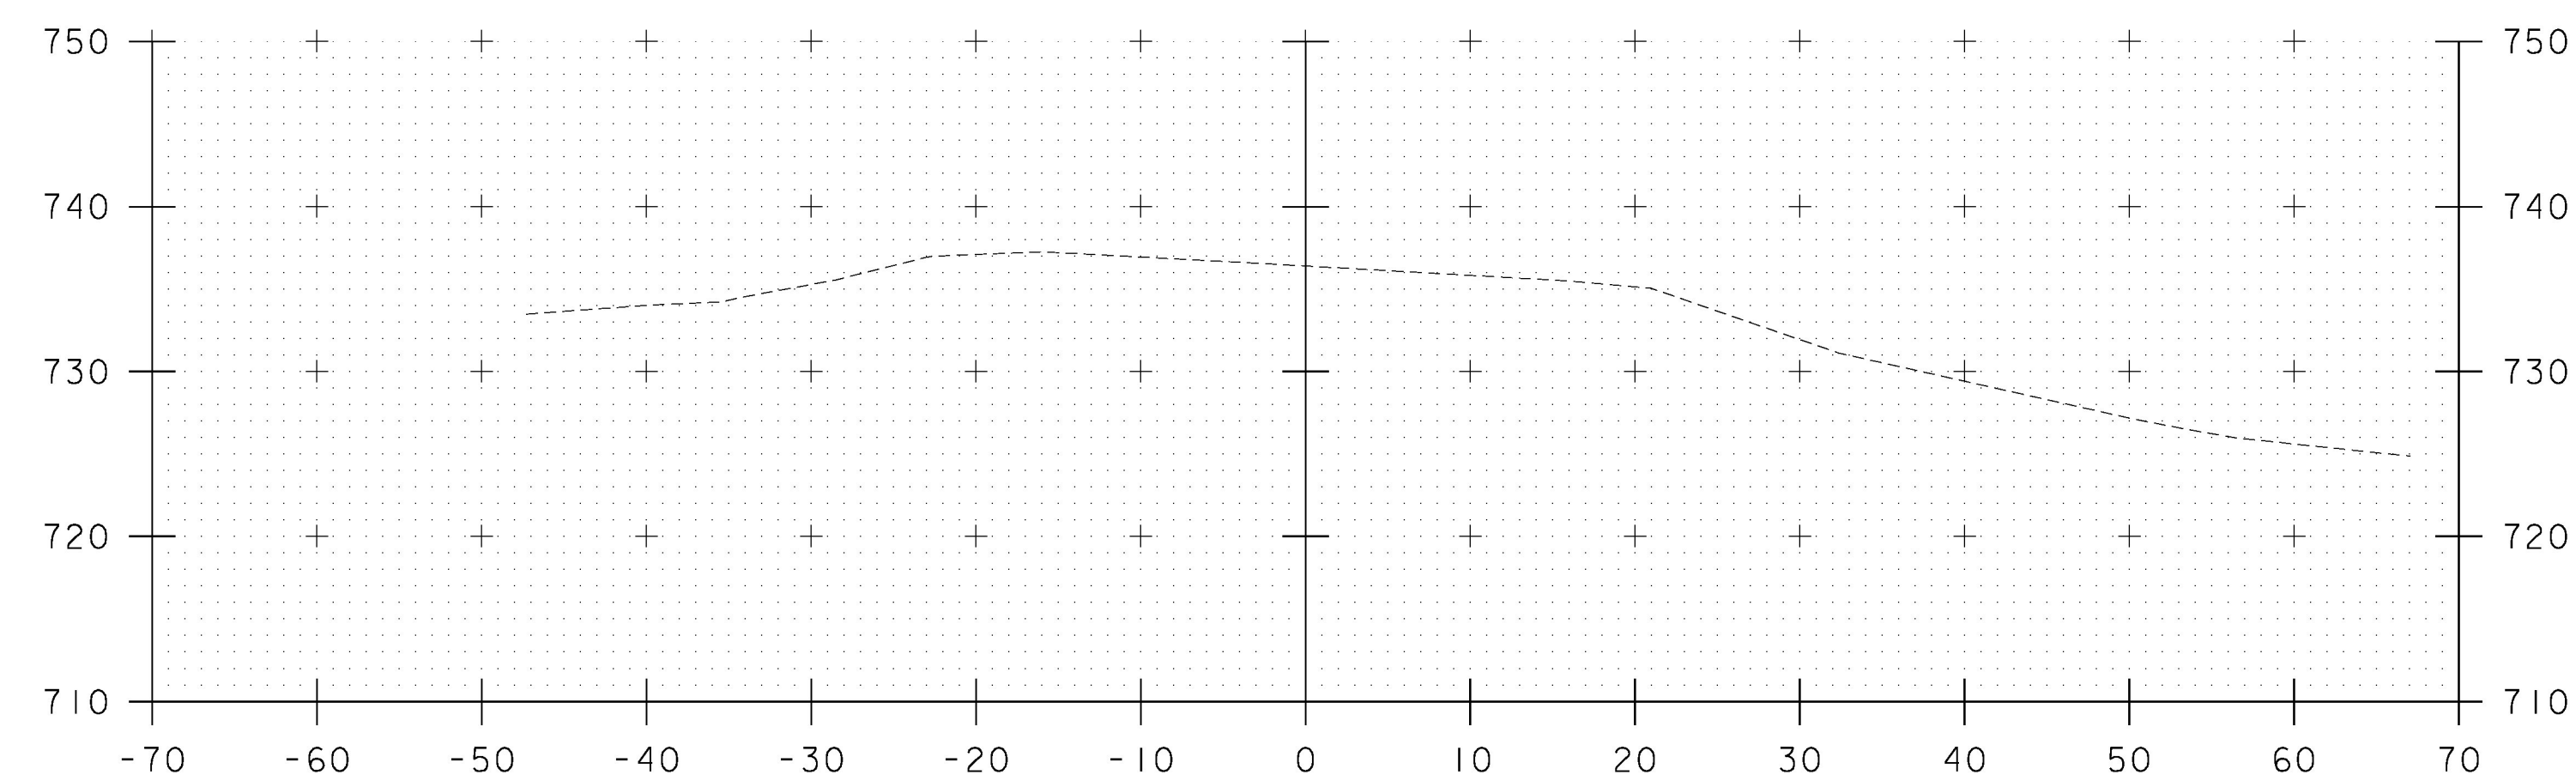


5+75

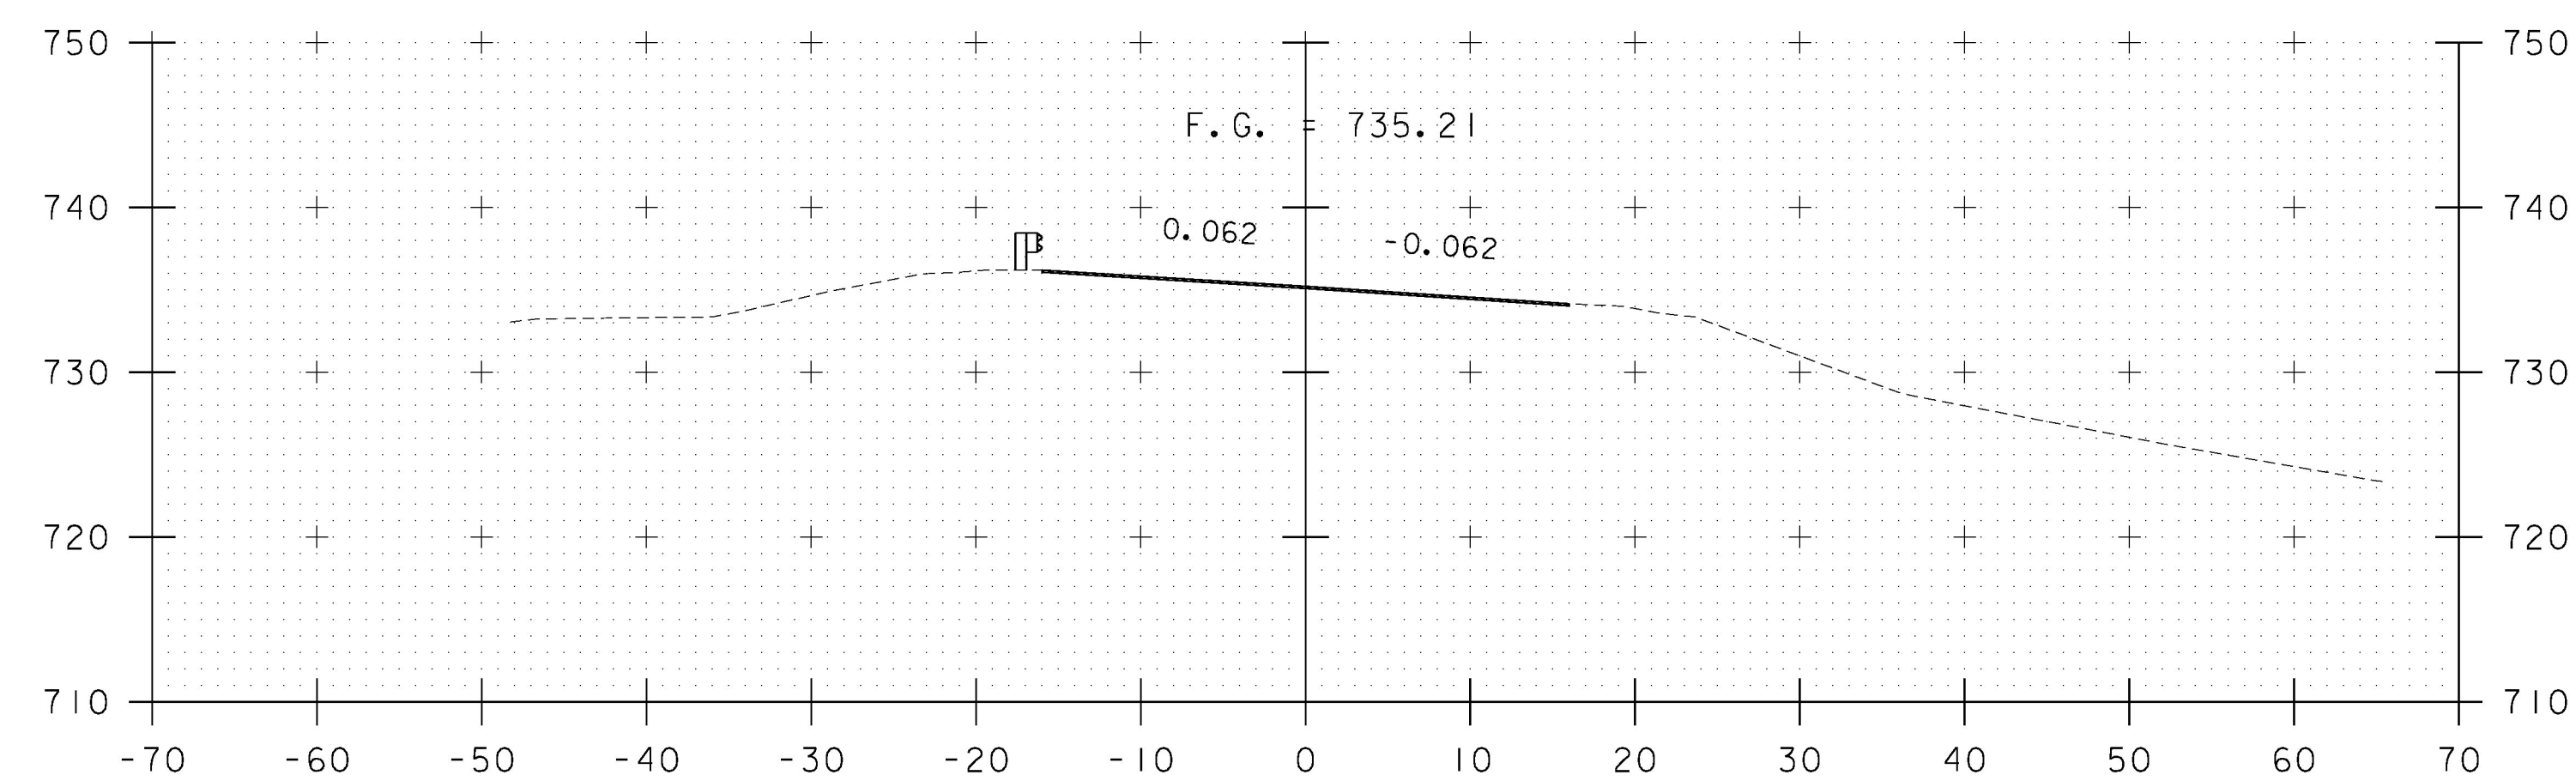


5+50
END APPROACH

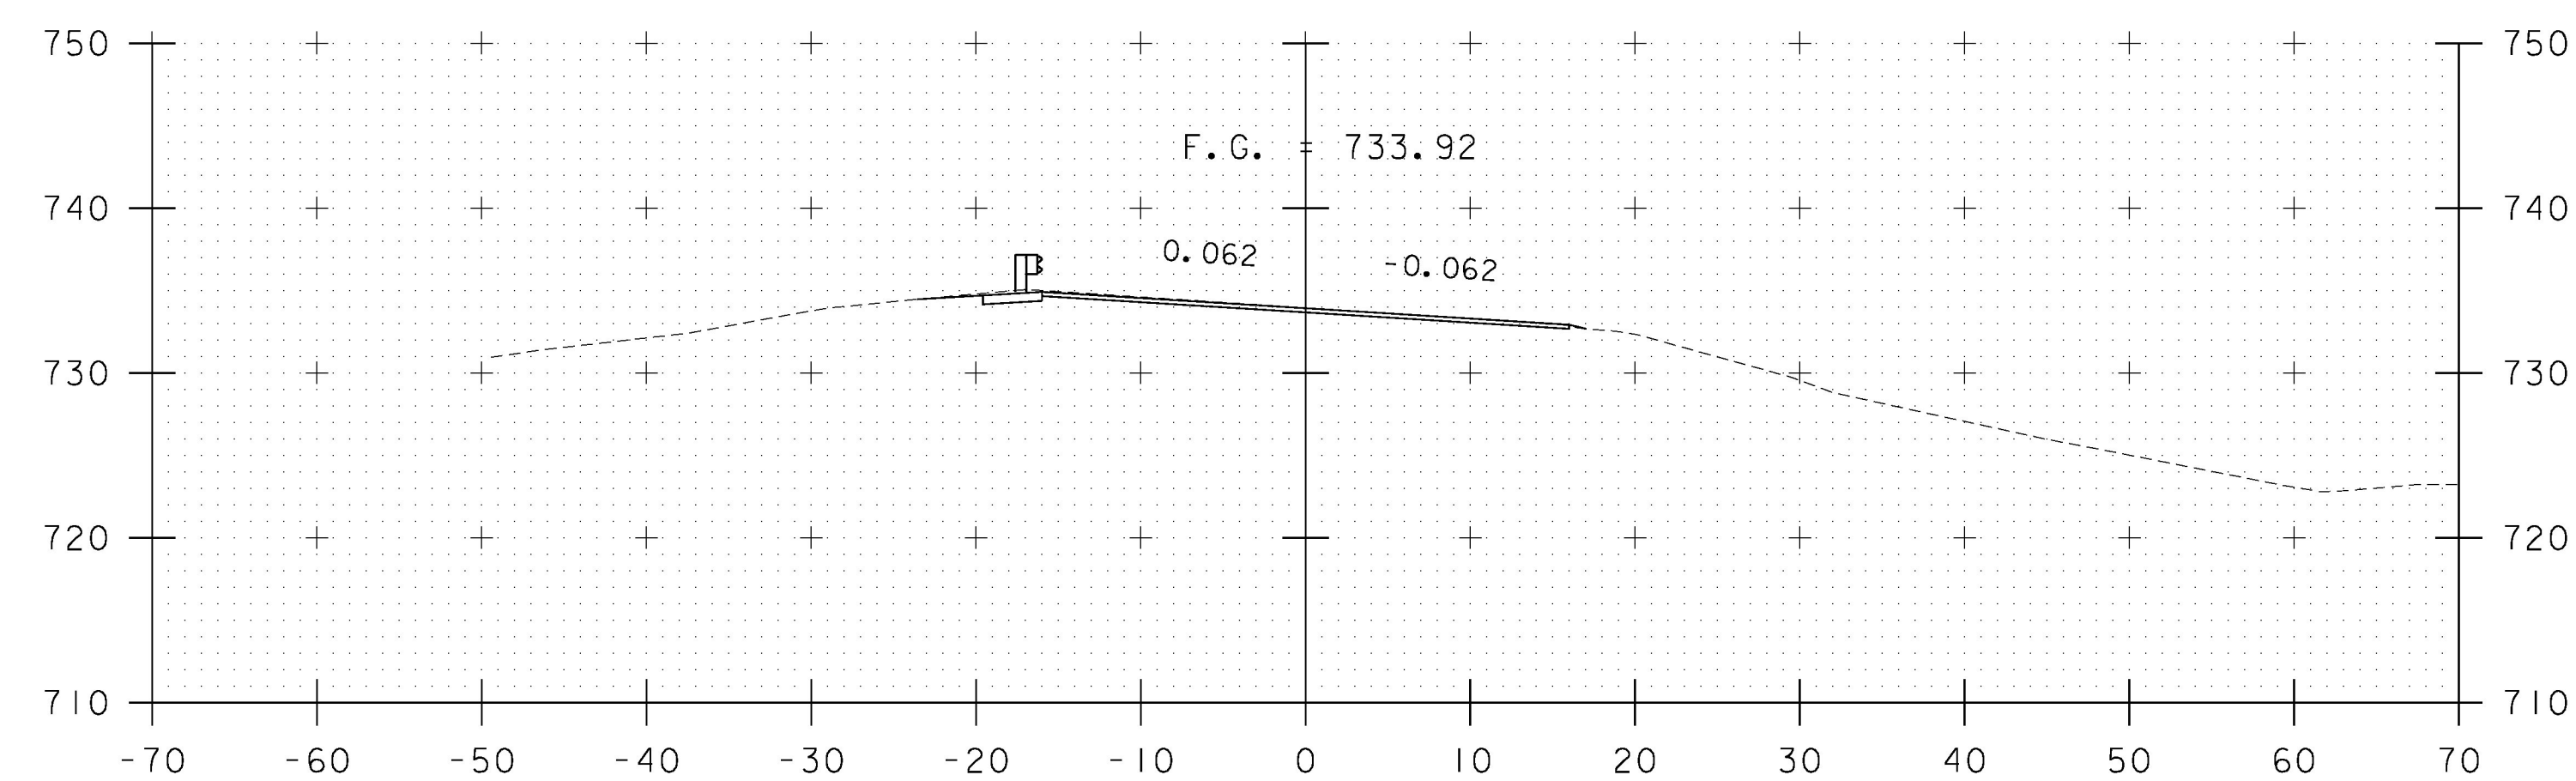


5+25

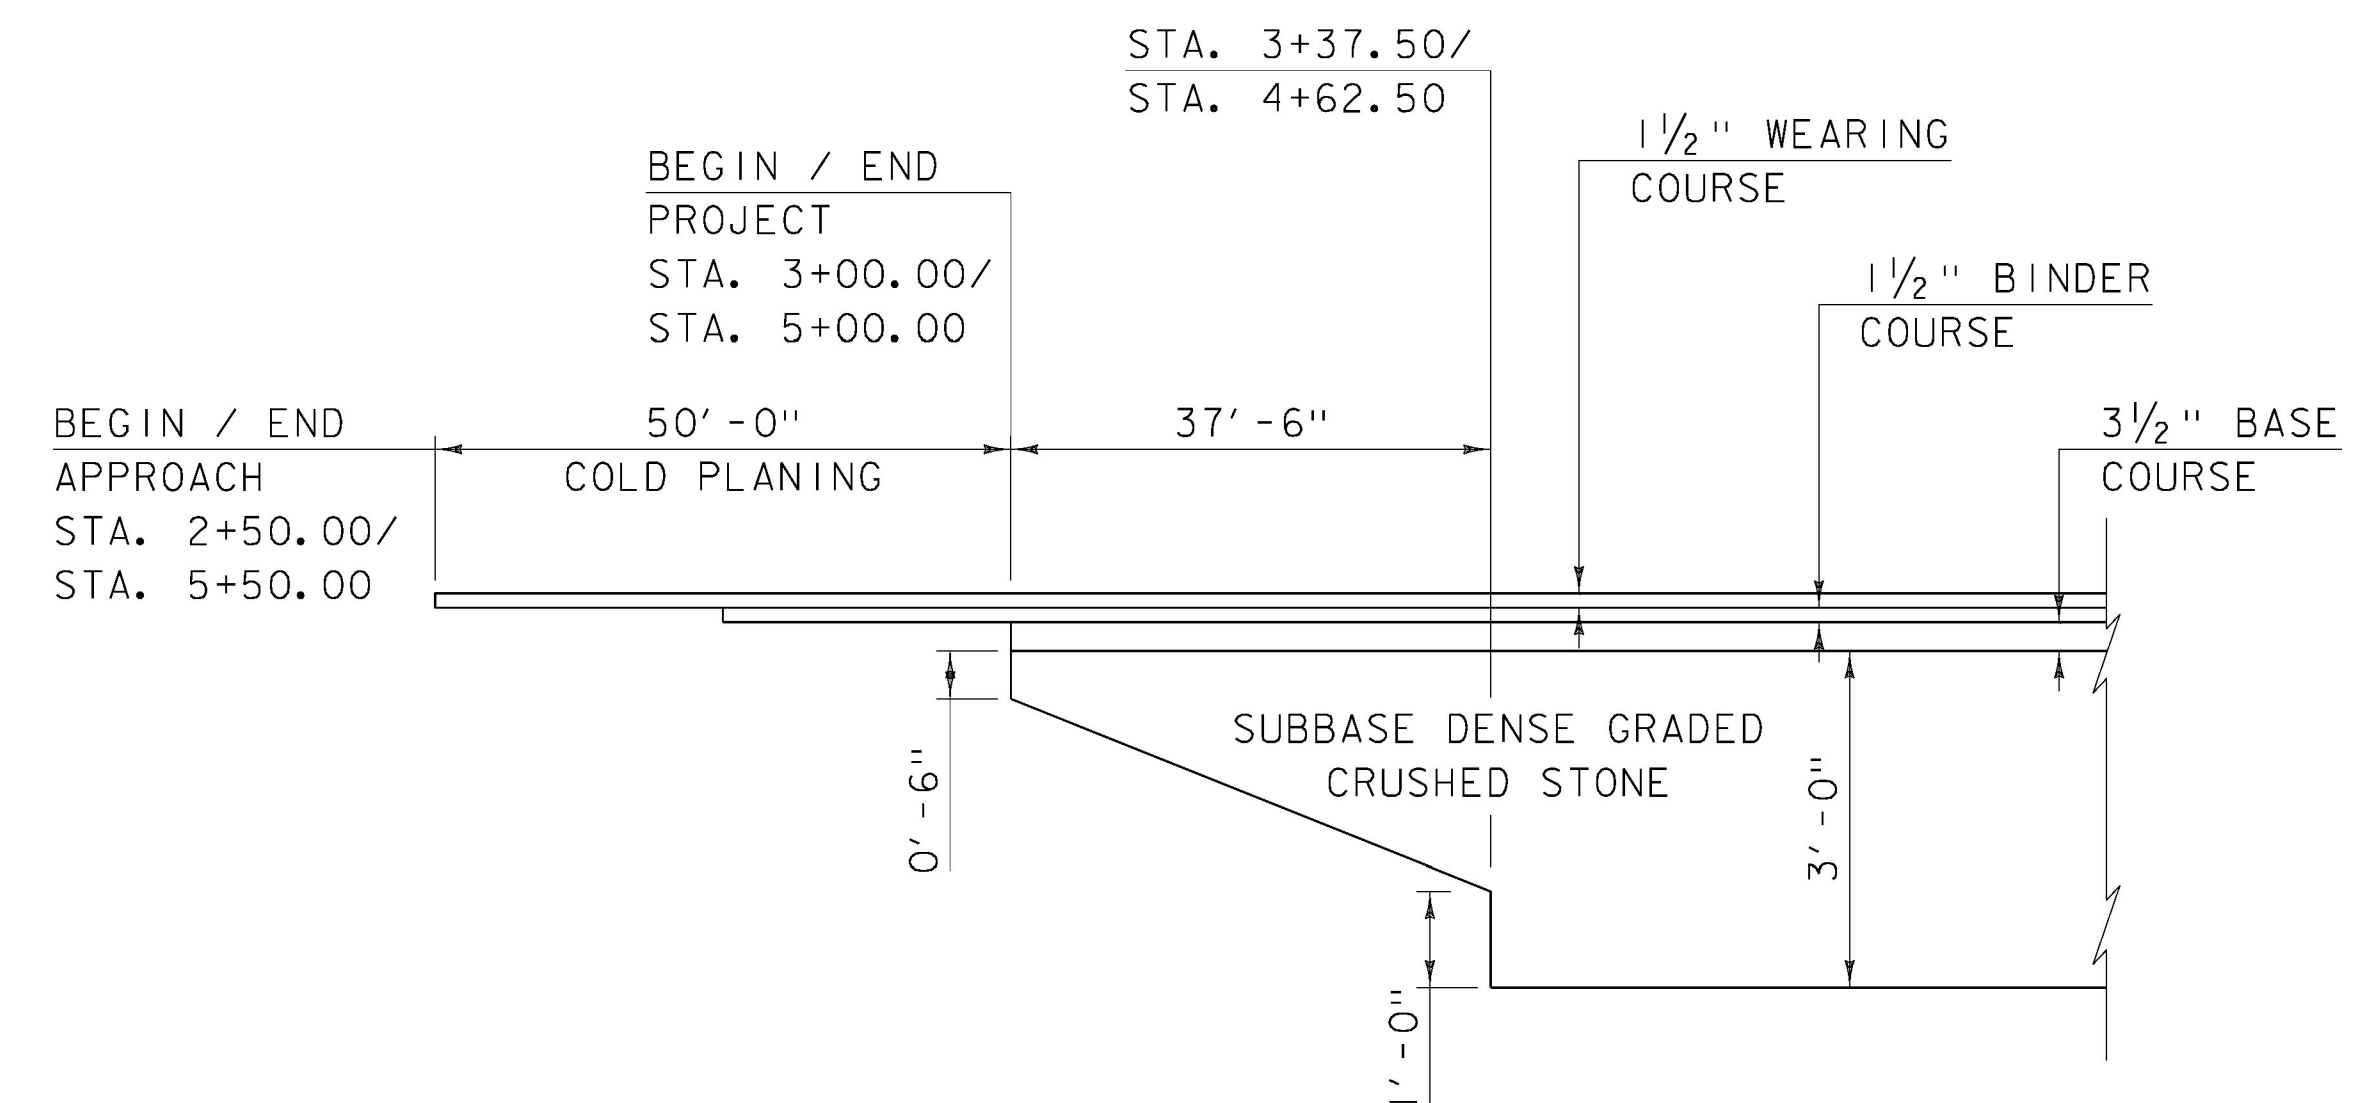

MATERIAL TRANSITION DIAGRAM
NOT TO SCALE

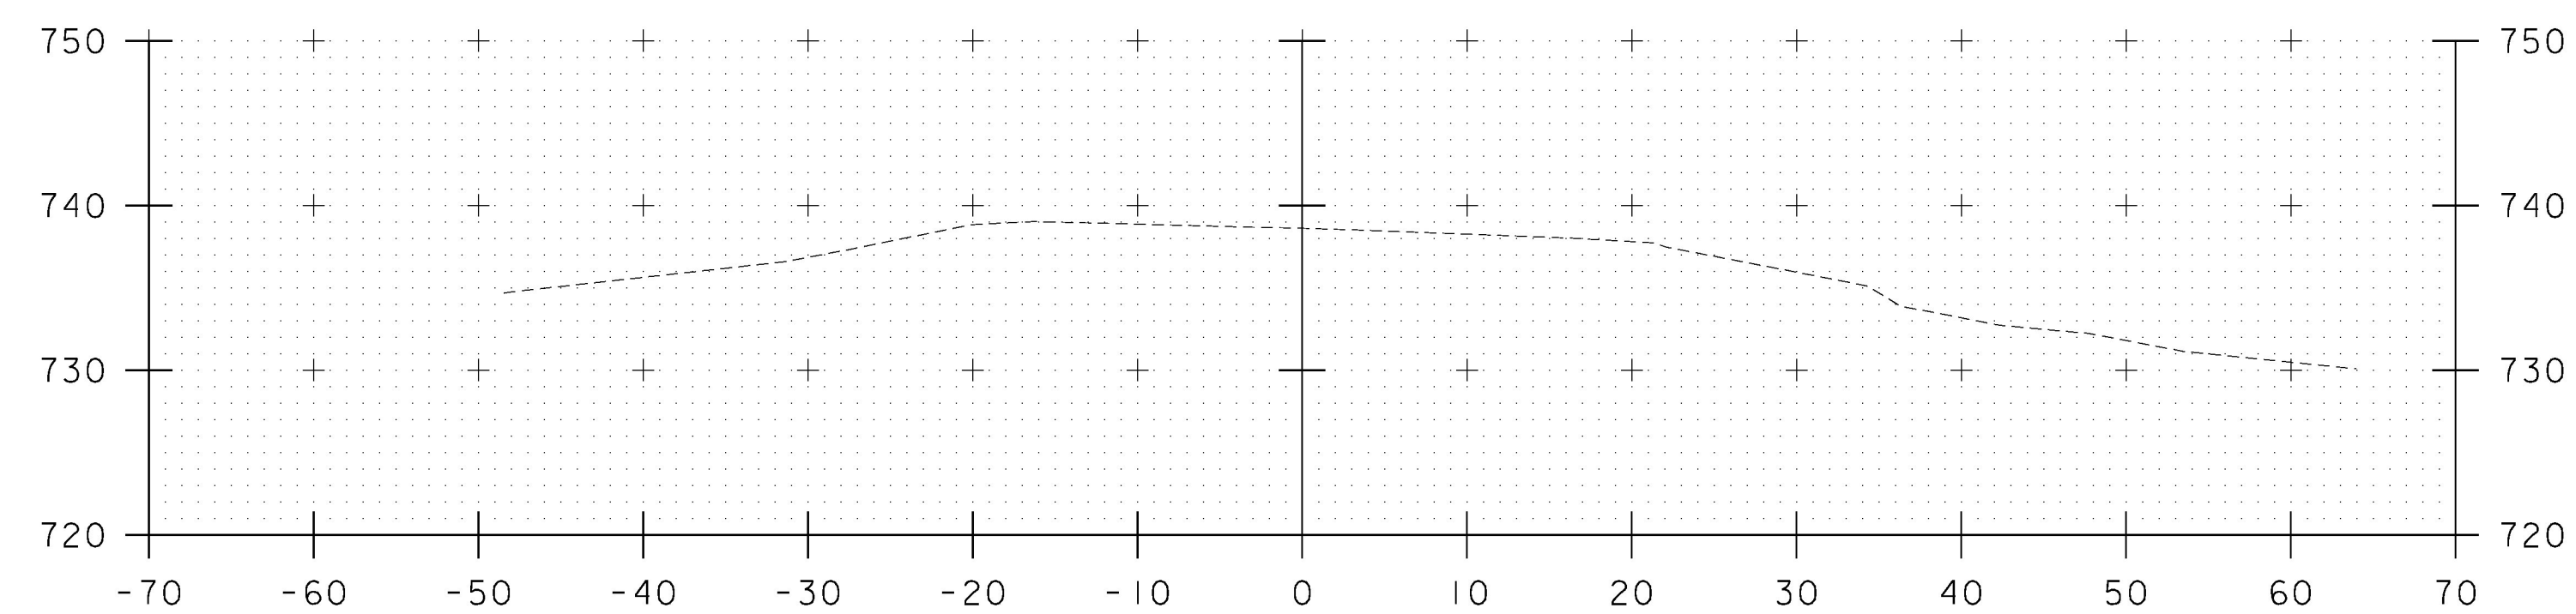

6+25

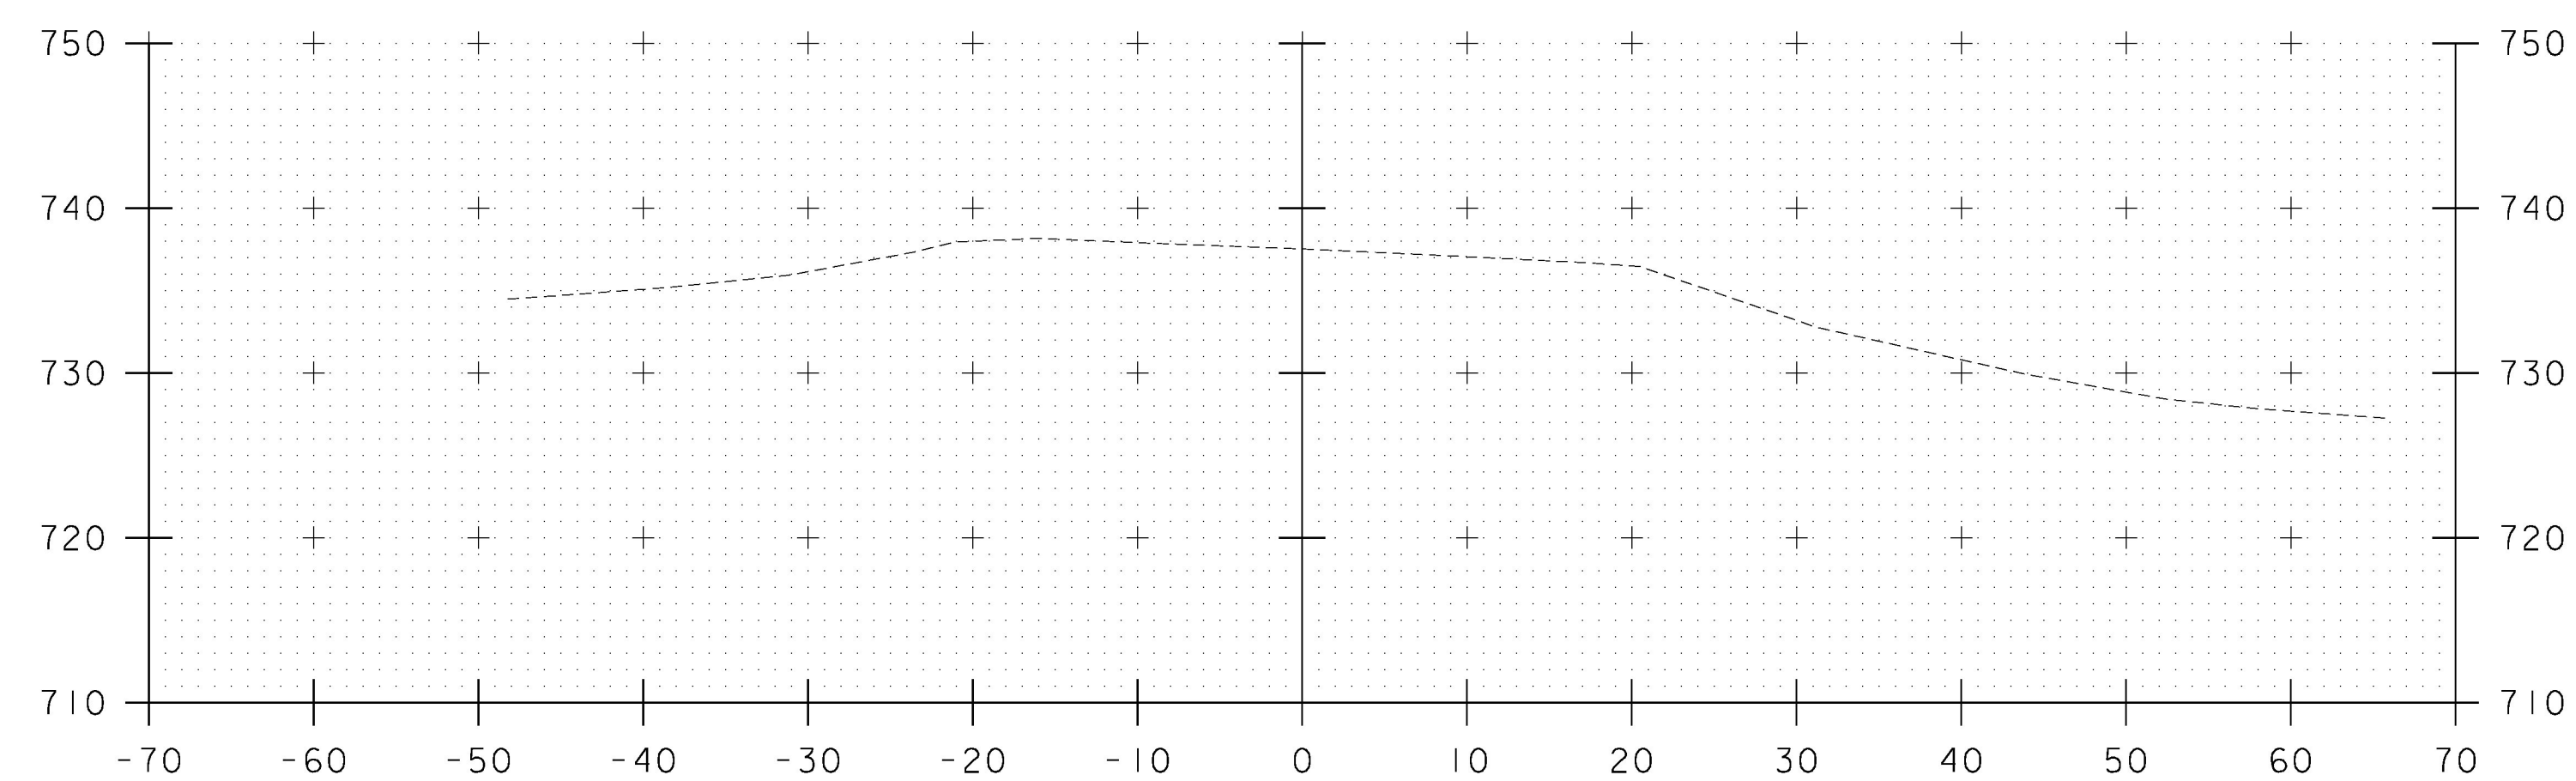

6+00

STA. 5+25 TO STA. 6+50



PROJECT NAME: WATERFORD	
PROJECT NUMBER: BF 0225(5)	
FILE NAME: z15b051xs.dgn	PLOT DATE: 09/27/2017
PROJECT LEADER: T. LEVINS	DRAWN BY: A. KURDEKAR
DESIGNED BY: A. KURDEKAR/ J. MERCER	CHECKED BY: T. LEVINS
MAINLINE SECTIONS 4	SHEET 52 OF 63