


4 INCH WHITE LINE, LOW VOC CHLORINATED RUBBER PAINT AND
TEMPORARY 4 INCH WHITE LINE, PAINT
(ALL LINES WILL INCLUDE EDGE LINE BREAKS AND
RADIUS FOR TOWN HIGHWAYS)
ESSEX JUNCTION:
STA PA 7+50.00 - STA PA 12+50.00 BIKE LANE LINE LT
STA PA 7+50.00 - STA PA 12+50.00 HATCH BUFFER LT
STA PA 7+55.00 - STA PA 9+57.00 BIKE LANE LINE RT
STA PA 7+55.00 - STA PA 9+57.00 HATCH BUFFER RT
STA PA 9+57.00 - STA PA 10+09.00 DOTTED BIKE LANE LINES RT
STA PA 10+08.48 EDGE LINE RT, MILL STREET
STA PA 10+08.48 CURBED ISLAND EDGE LINE RT, MILL STREET
STA PA 10+09.00 - STA PA 10+26.00 BIKE LANE LINE RT
STA PA 10+09.00 - STA PA 10+26.00 HATCH BUFFER RT
STA PA 10+26.00 - STA PA 10+72.00 DOTTED BIKE LANE LINES RT
STA PA 10+72.00 - STA PA 12+50.00 BIKE LANE LINE RT
STA PA 10+72.00 - STA PA 12+50.00 HATCH BUFFER RT

4 INCH YELLOW LINE, LOW VOC CHLORINATED RUBBER PAINT AND
TEMPORARY 4 INCH YELLOW LINE, PAINT
(ALL LINES WILL INCLUDE C/L LINE BREAKS FOR TOWN HIGHWAYS)
S = SOLID, D = DASHED
ESSEX JUNCTION:
STA PA 8+25.00 - STA PA 12+50.00 LT & RT
STA PA 7+50.00 - STA PA 8+25.00 DOUBLE SOLID MEDIAN LT/RT
STA PA 10+08.48 EDGE LINE RT, MILL STREET
STA PA 10+08.48 CURBED ISLAND EDGE LINE RT, MILL STREET

6 INCH WHITE LINE, LOW VOC CHLORINATED RUBBER PAINT AND
TEMPORARY 6 INCH WHITE LINE, PAINT
(ALL LINES WILL INCLUDE EDGE LINE BREAKS AND
RADIUS FOR TOWN HIGHWAYS)
ESSEX JUNCTION:
STA PA 7+50.00 - STA PA 9+57.00 BIKE LANE LINE RT
STA PA 7+50.00 - STA PA 12+50.00 BIKE LANE LINE LT
STA PA 10+09.00 - STA PA 10+26.00 BIKE LANE LINE RT
STA PA 10+72.00 - STA PA 12+50.00 BIKE LANE LINE RT

8 INCH YELLOW LINE, LOW VOC CHLORINATED RUBBER PAINT
ESSEX JUNCTION:
STA PA 7+50.00 - STA PA 8+25.00 HATCHED MEDIAN LT/RT
LETTER OR SYMBOL, LOW VOC CHLORINATED RUBBER PAINT
ESSEX JUNCTION:
STA PA 9+48.00 RT, BIKE LANE SYMBOL (1 EA)
STA PA 10+08.48 RT, YIELD LINE (7 EA), MILL STREET
STA PA 10+25.00 LT, BIKE LANE SYMBOL (1 EA)
STA PA 10+82.00 RT, BIKE LANE SYMBOL (1 EA)
TEMPORARY LETTER OR SYMBOL, PAINT
ESSEX JUNCTION:
STA PA 9+48.00 RT, BIKE LANE SYMBOL (2 EA)
STA PA 10+08.48 RT, YIELD LINE (14 EA), MILL STREET
STA PA 10+25.00 LT, BIKE LANE SYMBOL (2 EA)
STA PA 10+82.00 RT, BIKE LANE SYMBOL (2 EA)
PAINTED CURB (YELLOW)
ESSEX JUNCTION:
STA PA 10+05.00 - STA PA 10+27.00 RT, ISLAND

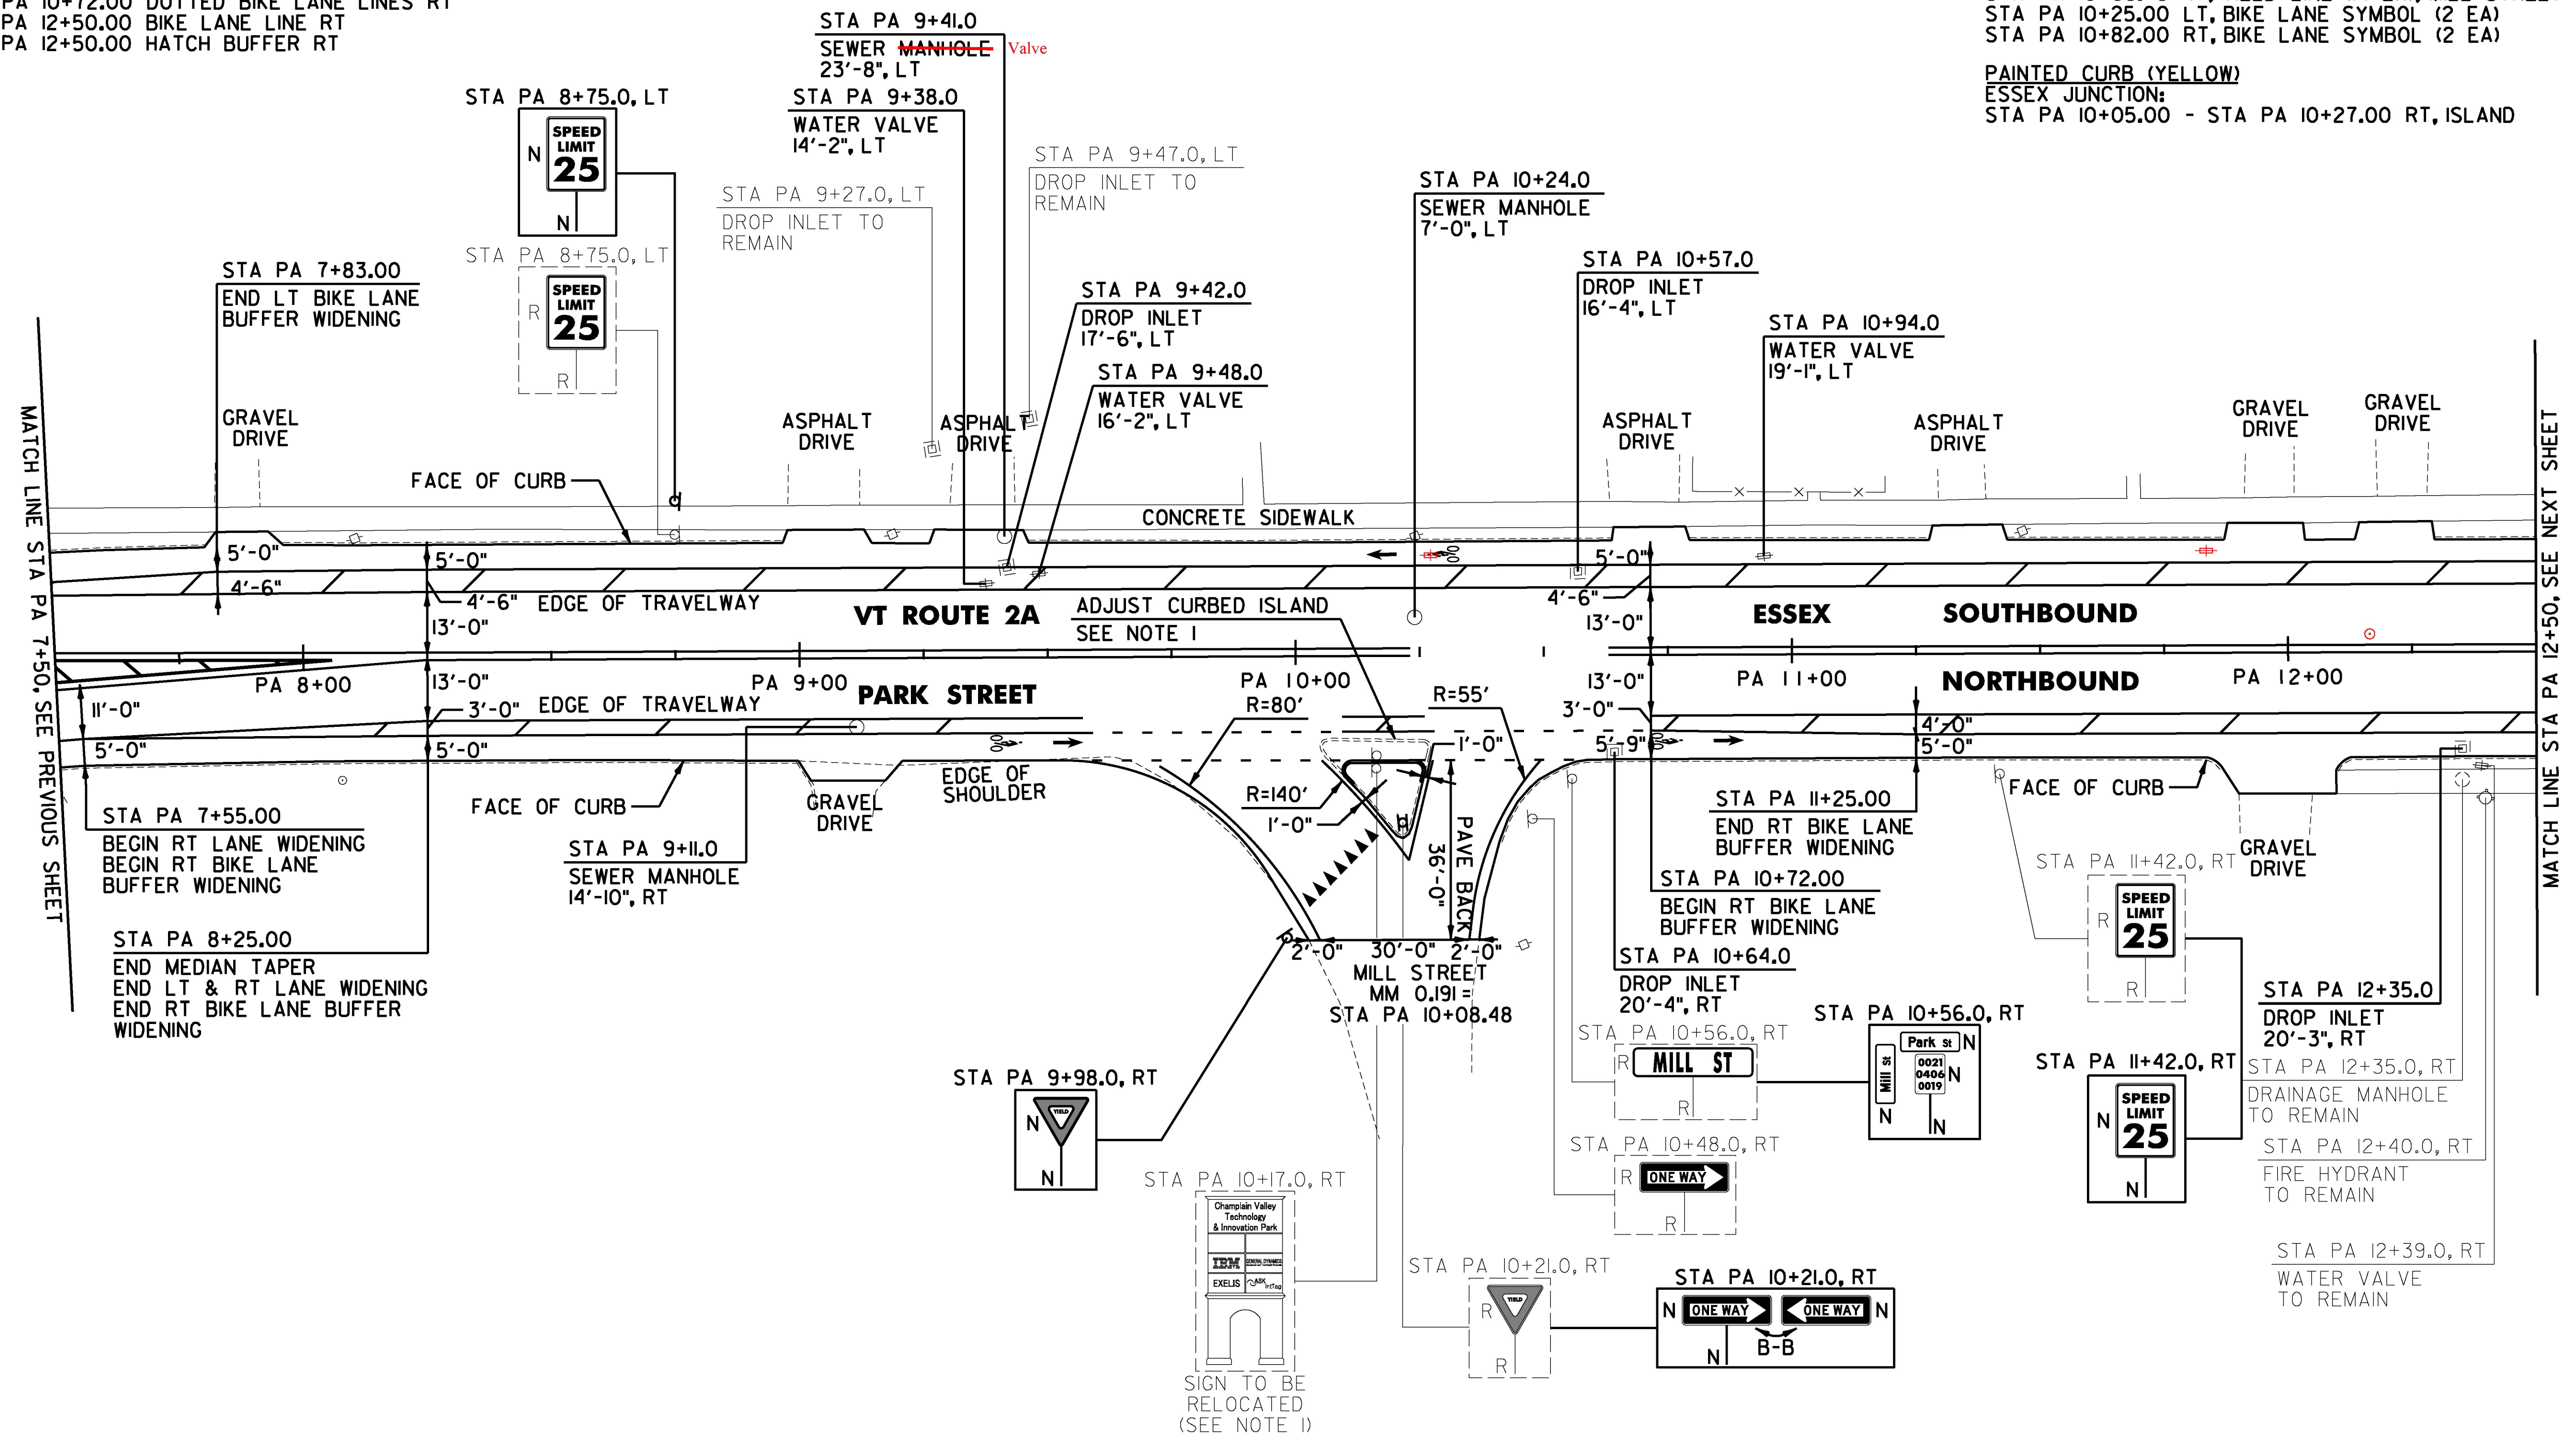

REHAB DROP INLETS, CATCH BASINS,
OR MANHOLES, CLASS I, II, OR III
ESSEX JUNCTION:
~~STA PA 9+42.0 LT~~ PA 12+13 LT
~~STA PA 10+57.0 LT~~ PA 9+11 RT
~~STA PA 10+64.0 RT~~ PA 10+24 LT
STA PA 12+35.0 RT

ADJUST ELEVATION OF VALVE BOX
ESSEX JUNCTION:
STA PA 9+38.0 LT PA 10+28 LT
STA PA 9+48.0 LT PA 11+85 LT
STA PA 10+94.0 LT

REMOVAL OF EXISTING CURB
ESSEX JUNCTION:
STA PA 10+05.0 - STA PA 10+27.0 RT

CAST-IN-PLACE CONCRETE CURB, TYPE B
ESSEX JUNCTION:
STA PA 10+09.0 - STA PA 10+26.0 RT

CHANGING ELEVATION OF SEWER MANHOLES
ESSEX JUNCTION:
~~STA PA 9+11.0 RT~~ PA 9+42 LT
~~STA PA 9+41.0 LT~~ PA 10+57 LT
~~STA PA 10+24.0 LT~~ PA 10+64 RT

SIGN LEGEND
R = REMOVE
S = SALVAGE
N = NEW
RET = RETAIN
B-B = BACK TO BACK
EXISTING =
NEW =
R = RETURN TO VILLAGE
OF ESSEX JUNCTION

NOT TO SCALE
CHA

NOTE:

I. SEE SHEET 27 FOR CURBED ISLAND ADJUSTMENT DETAIL.

PROJECT NAME: ESSEX JUNCTION
PROJECT NUMBER: STP 2956(I)

FILE NAME: z14v25lbd.dgn
PROJECT LEADER: D.GOZALKOWSKI
DESIGNED BY: J. OLSEN
PLAN SHEET 3

PLOT DATE: 4/19/2016
DRAWN BY: A. KIRBY
CHECKED BY: J. SHIELDS
SHEET 30 OF 171