

4 INCH WHITE LINE, LOW VOC CHLORINATED RUBBER PAINT AND TEMPORARY 4 INCH WHITE LINE, PAINT

(ALL LINES WILL INCLUDE EDGE LINE BREAKS AND RADIUS FOR TOWN HIGHWAYS)

ESSEX JUNCTION:
STA PE 66+00.00 - STA PE 66+58.00 DOTTED BIKE LANE LINES LT
STA PE 66+00.00 - STA PE 68+10.00 SOLID LANE LINE RT
STA PE 66+00.00 - STA PE 69+04.00 BIKE LANE LINE RT
STA PE 66+00.00 - STA PE 69+04.00 HATCH BUFFER RT
STA PE 66+58.00 - STA PE 67+92.00 BIKE LANE LINE LT
STA PE 66+58.00 - STA PE 67+92.00 HATCH BUFFER LT
STA PE 67+92.00 - STA PE 68+51.00 DOTTED BIKE LANE LINES LT
STA PE 68+51.00 - STA PE 69+28.00 BIKE LANE LINE LT
STA PE 68+51.00 - STA PE 69+28.00 HATCH BUFFER LT
STA PE 69+04.00 - STA PE 69+48.00 DOTTED BIKE LANE LINES RT
STA PE 69+48.00 - STA PE 70+23.00 BIKE LANE LINE RT
STA PE 69+48.00 - STA PE 70+23.00 HATCH BUFFER RT

4 INCH WHITE LINE, LOW VOC CHLORINATED RUBBER PAINT AND TEMPORARY 4 INCH WHITE LINE, PAINT

(ALL LINES WILL INCLUDE EDGE LINE BREAKS AND RADIUS FOR TOWN HIGHWAYS)

ESSEX JUNCTION:
STA PE 69+28.00 - STA PE 69+68.00 DOTTED BIKE LANE LINES LT
STA PE 69+68.00 - STA PE 70+50.00 BIKE LANE LINE LT
STA PE 69+68.00 - STA PE 70+50.00 HATCH BUFFER LT
STA PE 70+23.00 - STA PE 70+73.00 DOTTED BIKE LANE LINES RT
STA PE 70+50.00 - STA PE 70+94.00 DOTTED BIKE LANE LINES LT
STA PE 70+73.00 - STA PE 71+00.00 BIKE LANE LINE RT
STA PE 70+73.00 - STA PE 71+00.00 HATCH BUFFER RT
STA PE 70+94.00 - STA PE 71+00.00 BIKE LANE LINE LT
STA PE 70+94.00 - STA PE 71+00.00 HATCH BUFFER LT

4 INCH YELLOW LINE, LOW VOC CHLORINATED RUBBER PAINT AND TEMPORARY 4 INCH YELLOW LINE, PAINT

(ALL LINES WILL INCLUDE C/L LINE BREAKS FOR TOWN HIGHWAYS)
S = SOLID, D = DASHED

ESSEX JUNCTION:
STA PE 66+00.00 - STA PE 68+50.00 DOUBLE SOLID LT
STA PE 68+50.00 - STA PE 71+00.00 SOLID/DASH TURN LANE LT & RT

6 INCH WHITE LINE, LOW VOC CHLORINATED RUBBER PAINT AND TEMPORARY 6 INCH WHITE LINE, PAINT

(ALL LINES WILL INCLUDE EDGE LINE BREAKS AND RADIUS FOR TOWN HIGHWAYS)

ESSEX JUNCTION:
STA PE 66+00.00 - STA PE 69+04.00 BIKE LANE EDGE LINE RT
STA PE 66+58.00 - STA PE 67+92.00 BIKE LANE EDGE LINE LT
STA PE 68+51.00 - STA PE 69+28.00 BIKE LANE EDGE LINE LT
STA PE 69+48.00 - STA PE 70+23.00 BIKE LANE EDGE LINE RT
STA PE 69+68.00 - STA PE 70+50.00 BIKE LANE EDGE LINE LT
STA PE 70+73.00 - STA PE 71+00.00 BIKE LANE EDGE LINE RT
STA PE 70+94.00 - STA PE 71+00.00 BIKE LANE EDGE LINE LT

LETTER OR SYMBOL, LOW VOC CHLORINATED RUBBER PAINT


ESSEX JUNCTION:
STA PE 66+52.00 C/L, ARROW (1 EA)
STA PE 67+29.00 C/L, "O,N,L,Y" (4 EA)
STA PE 68+06.00 C/L, ARROW (1 EA)
STA PE 68+74.00 C/L, ARROW (1 EA)
STA PE 68+87.00 C/L, ARROW (1 EA)
STA PE 70+95.00 C/L, ARROW (1 EA)

TEMPORARY LETTER OR SYMBOL, PAINT

ESSEX JUNCTION:
STA PE 66+52.00 C/L, ARROW (2 EA)
STA PE 68+06.00 C/L, ARROW (2 EA)
STA PE 68+74.00 C/L, ARROW (2 EA)
STA PE 68+87.00 C/L, ARROW (2 EA)
STA PE 70+95.00 C/L, ARROW (2 EA)

REMOVING SIGNS
AS SHOWN - 10

ERECTING SALVAGED SIGNS
AS SHOWN - 1

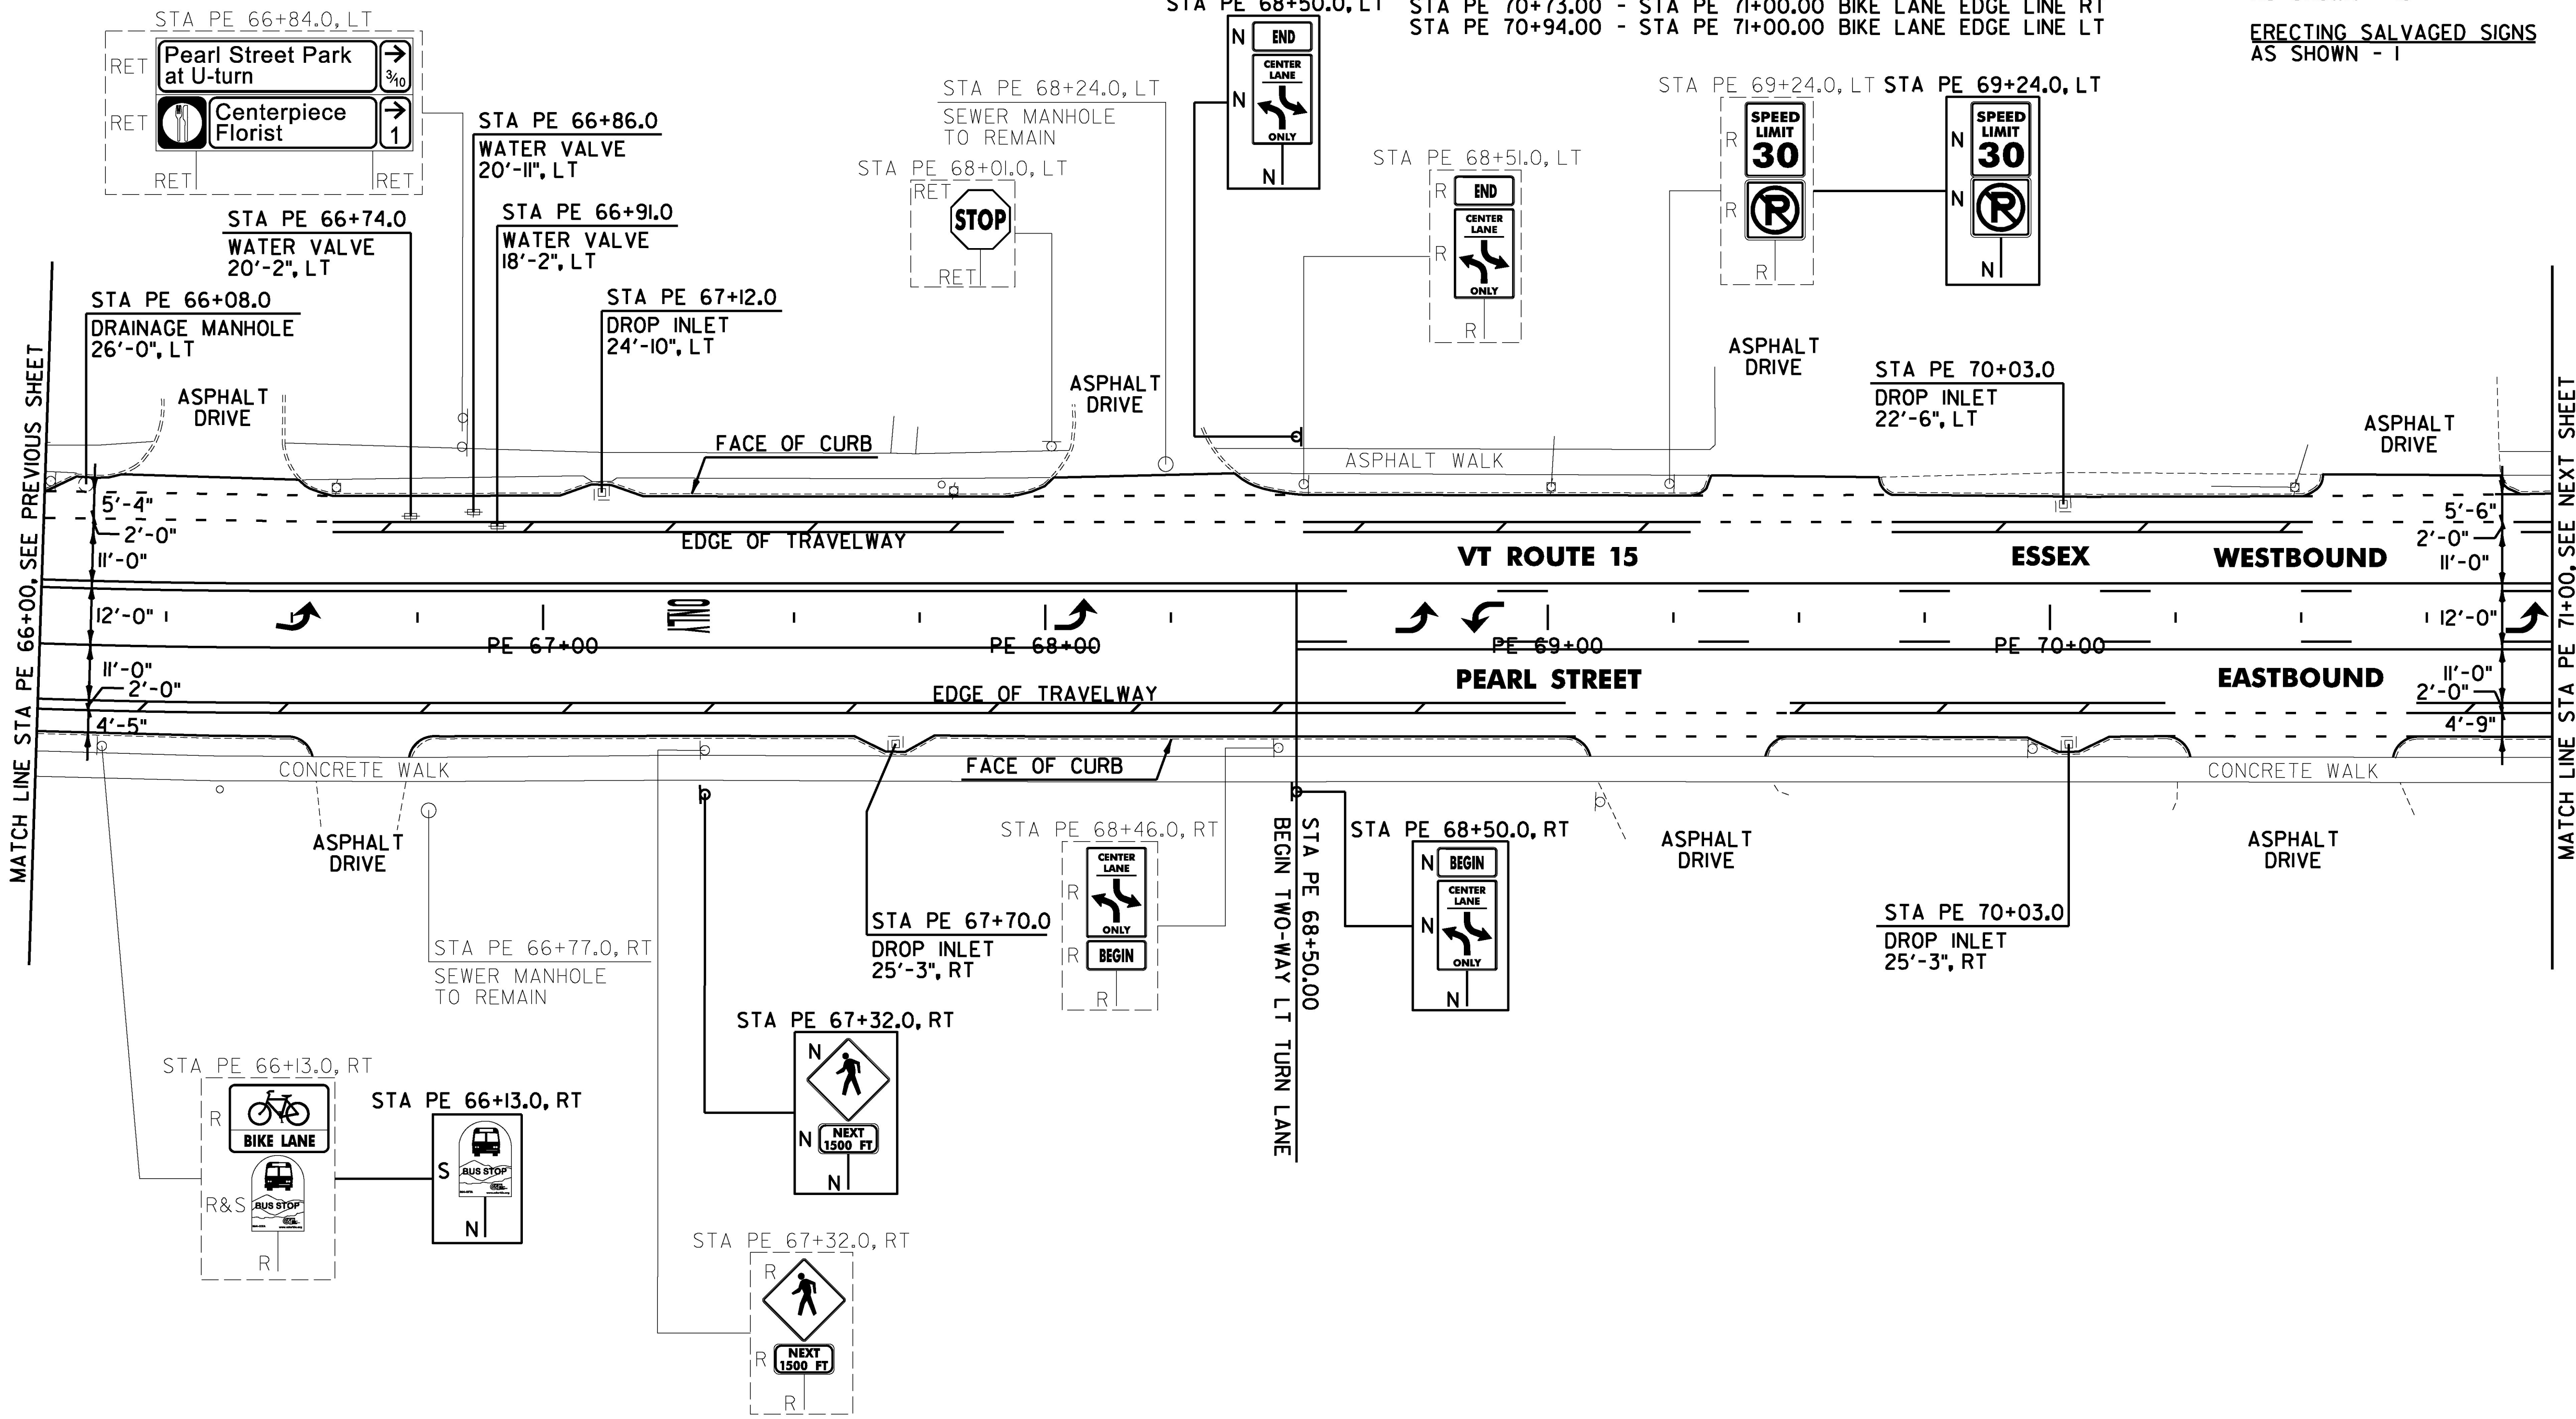

REHAB, DROP INLETS, CATCH BASINS, OR MANHOLES, CLASS I, II, OR III

ESSEX JUNCTION:
STA PE 66+08.0 LT - RETAINED
STA PE 67+12.0 LT - RETAINED
STA PE 67+70.0 RT
STA PE 70+03.0 RT
STA PE 70+03.0 LT - RETAINED

ADJUST ELEVATION OF VALVE BOX

ESSEX JUNCTION:
STA PE 66+74.0 LT
STA PE 66+86.0 LT
STA PE 66+91.0 LT

CHANGING ELEVATION OF SEWER MANHOLES

PE 70+03 LT

SIGN LEGEND

R = REMOVE
S = SALVAGE
N = NEW
RET = RETAIN
B-B = BACK TO BACK
EXISTING =
NEW =
R = RETURN TO VILLAGE
OF ESSEX JUNCTION

NOT TO SCALE

CHA

PROJECT NAME: ESSEX JUNCTION

PROJECT NUMBER: NH 2956(2)

FILE NAME: z15v026bdr.dgn
PROJECT LEADER: D.GOZALKOWSKI
DESIGNED BY: J. SCUDDER
PLAN SHEET 9

PLOT DATE: 4/19/2016
DRAWN BY: C. KAHLBAUGH
CHECKED BY: J. SHIELDS
SHEET 91 OF 171