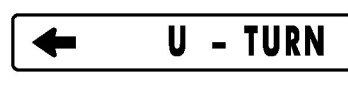
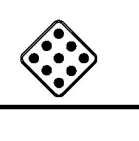
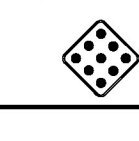


STATE OF VERMONT AGENCY OF TRANSPORTATION										TRAFFIC SIGN SUMMARY SHEET 3																									
MILEMARKER, STATION, OR SIGN NUMBER	SIGN LEGEND	SIGN DIMENSIONS		NEW & SALVAGED SIGNS				EXIST POST		NEW SIGN POSTS																	REMARKS SHSM = FHWA STANDARD HIGHWAY SIGNS AND MARKINGS BOOK	SIGN DETAIL							
		WIDTH (in)	HEIGHT (in)	"A"	SEE NOTE 2	SALV SIGN	SALV TIS	RE TAIN	SALV AGE	NO. OF POSTS	FLANGED CHANNEL			SQUARE STEEL (in)				TUBULAR STEEL Ø (in)				W-SHAPE STEEL				ANCHOR S PACING		FOUND- ATION	FTG. SIZE		WEIGHT	POST SIZE	DETAIL IN SHSM	DETAIL ON DWG. NUMBER	STD. SHEET NUMBER
											1.2	2.0	3.0	1.8	2.0	2.5	3.0	3.5	4.0	5.0	24"	30"													
																							lb/ft	lb/ft	lb/ft										
ESSEX JUNCTION VT ROUTE 15 PE 53+79.0, LT	 	36	36	9.00						2					14.00 X 14.00		X														BACK-TO-BACK	W6-3 W6-3			
PE 53+87.0, RT		36	36	7.07						1					X 13.75		X														SIGN SHALL BE INSTALLED 100 FEET BACK FROM THE STOP BAR ON WEST STREET EXT.	W10-1			
PE 53+95.0, LT		72	18	9.00						2					12.50 X 12.50		X															R3-25bL			
PE 54+00 RT		24	30	5.00																										MOUNTED ON STRAIN POLE					
PE 54+18.0, RT		24	18	3.00						1					X 12.25		X															R3-17			
PE 54+35.0, C/L	   	24 24 24	30 24 24	5.00 4.00 4.00						1					X 15.00		X														BACK-TO-BACK	R4-7 R3-4 R3-2			
		18 18	18 18	2.25 2.25																											BACK-TO-BACK	OMI-1 OMI-1			
PE 54+73.0, LT		30	30	6.25						1					X 13.25		X																RI-1		
PE 54+96.0, LT		36	36	9.00						2					14.00 X 13.91		X																W6-3		
PE 55+08.0, LT	 	30 24	30 24	6.25 4.00						1					X 13.25		X															BACK-TO-BACK	R5-1 R3-2		
NOTES: 1. FINAL POST LENGTHS ARE TO BE DETERMINED IN THE FIELD. POST SIZES ARE COMPUTED BASED ON INFORMATION FURNISHED ON THE STANDARD SHEETS AND THE VTRANS "SIGN POST DESIGN GUIDELINE." 2. SIGN AREAS LABELED IN THIS COLUMN WILL BE PAID FOR UNDER ITEM 900.670 SPECIAL PROVISION (TRAFFIC SIGNS, EXTRUDED).				TOTALS		SF 80.07 85.07	SF	EA.	SF		LF	LF	LF	LF	LF	EA	LB	LB	LB	LB	EA.	EA.	LB		PROJECT NAME: ESSEX JUNCTION PROJECT NUMBER: NH 2956(2) FILE NAME: z15v026tss.dgn PROJECT LEADER: D.GOZALKOWSKI DESIGNED BY: J. SCUDDER TRAFFIC SIGN SUMMARY SHEET 3		PLOT DATE: 5/2/2016 DRAWN BY: C. KAHLBAUGH CHECKED BY: J. SHIELDS SHEET 121 OF 171								