

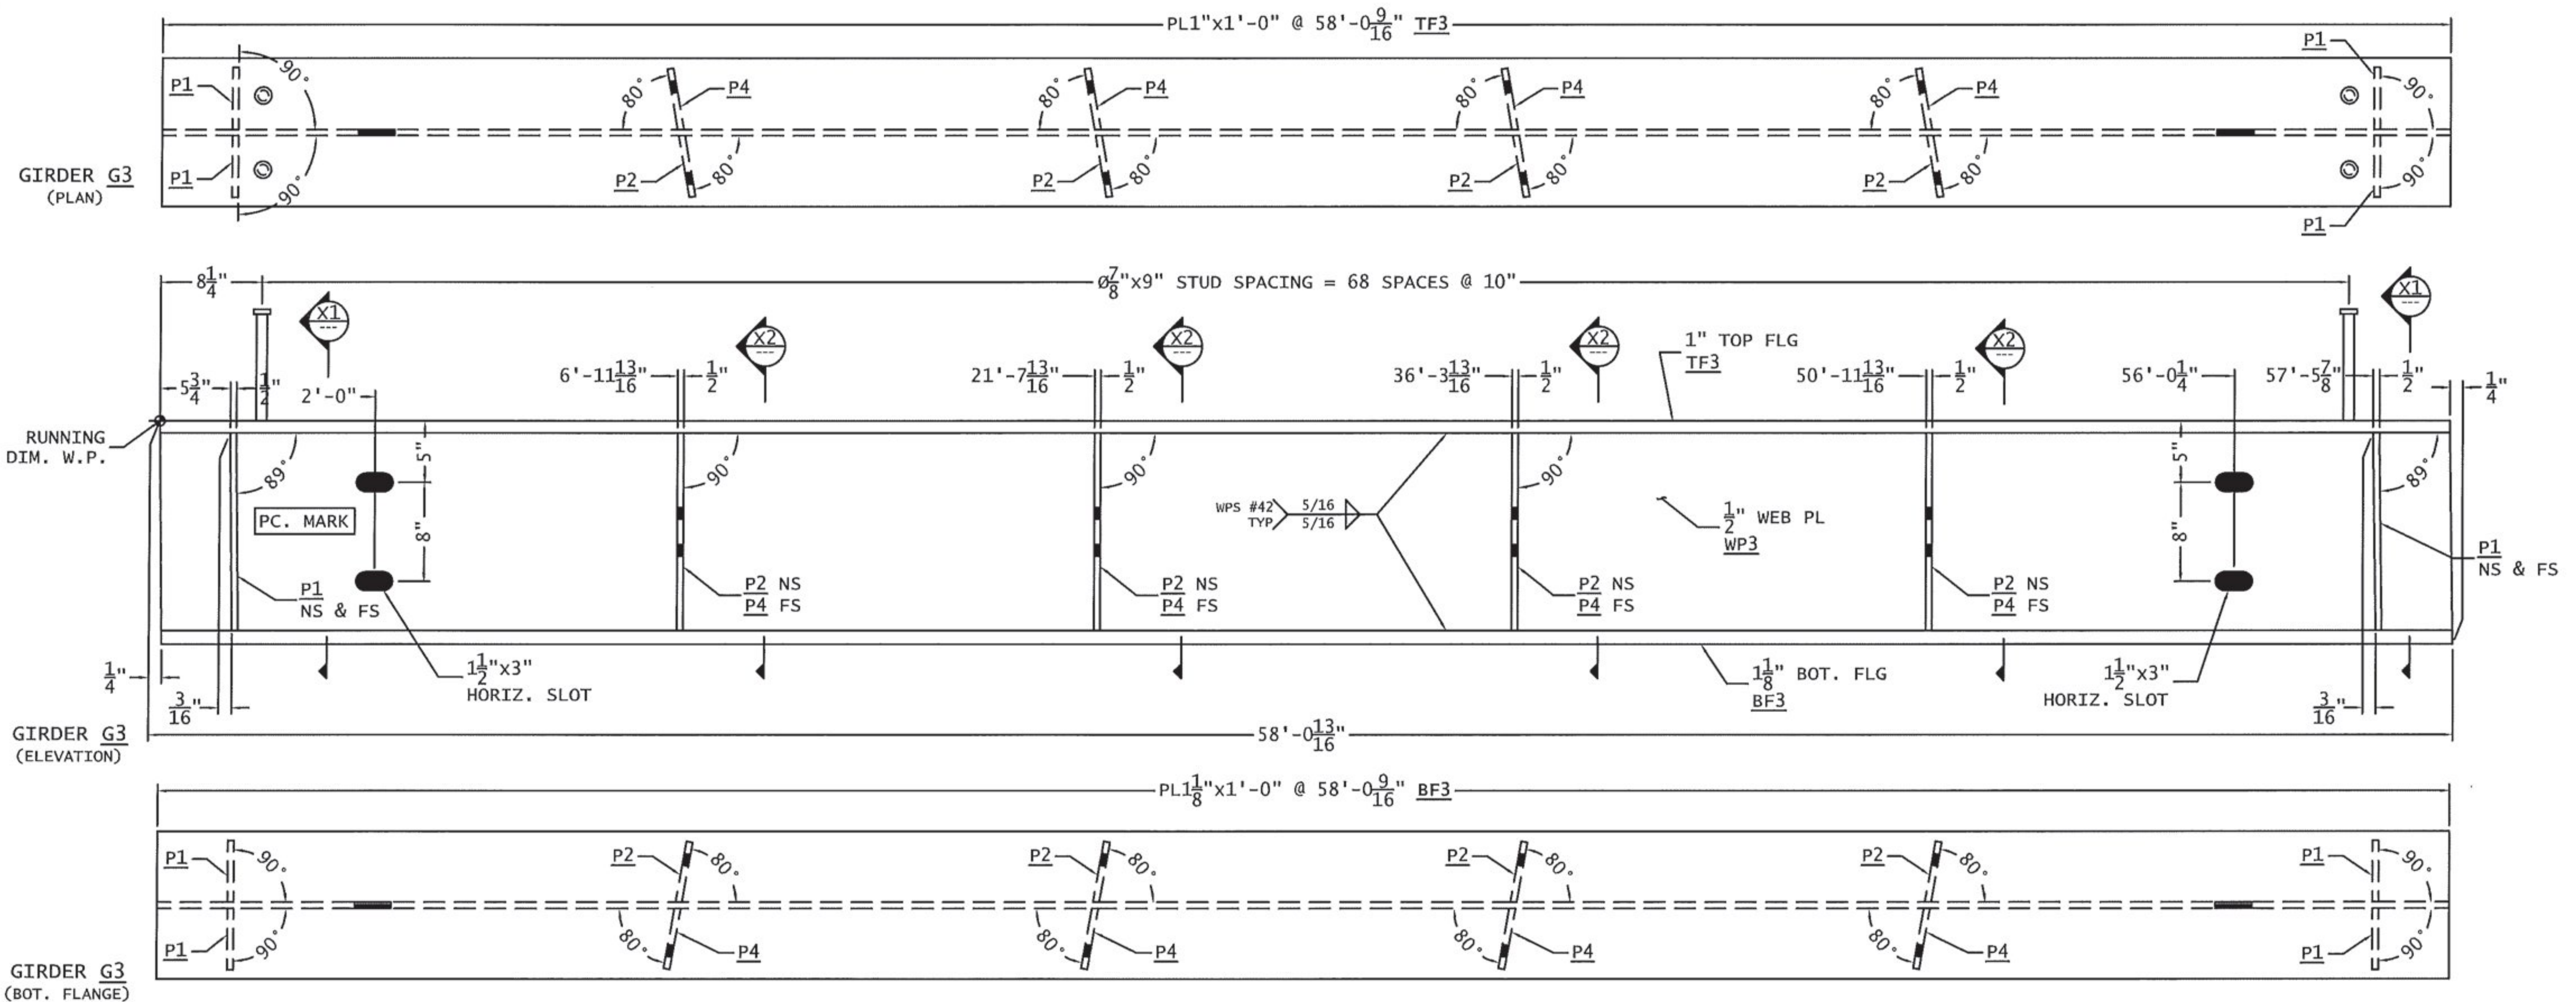
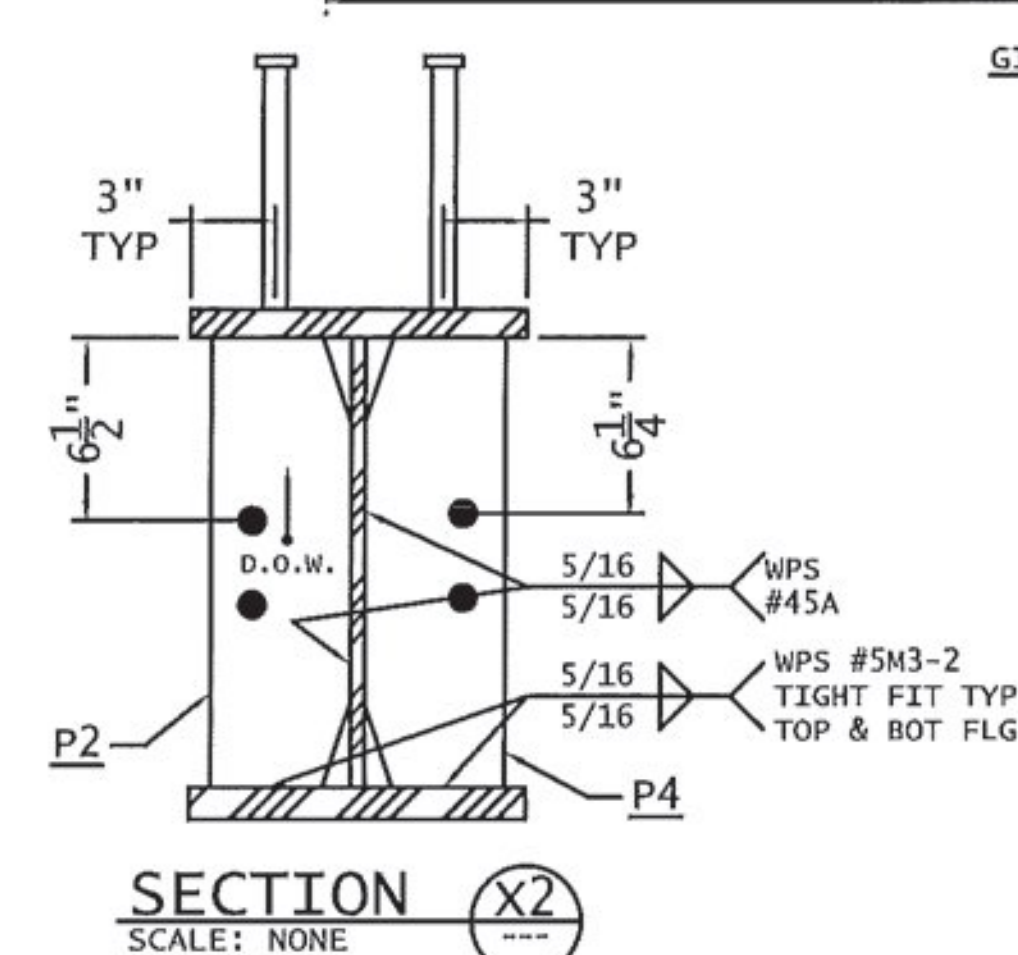


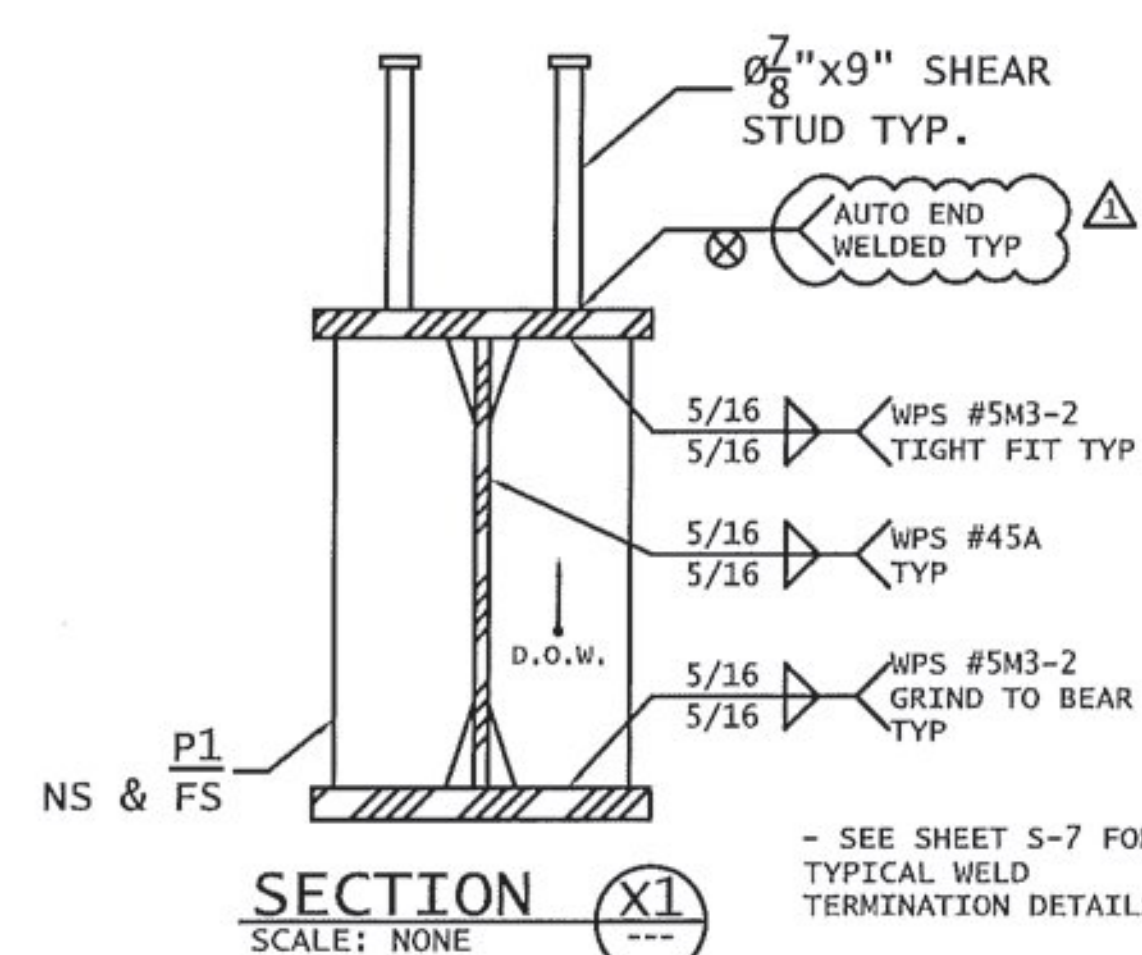

Vermont Agency of Transportation
RECEIVED
 CK'D BY RSF, TAM OK'D BY JDG
 February 9, 2017
 RESUBMIT No Approved
 BY Kristin Higgins DATE 2/14/2017

BILL OF MATERIALS								
SHIP MARK	SHIP QTY	PIECE MARK	PC. QTY	DESCRIPTION	LENGTH		WT. lbs. ea.	WT. lbs. tot.
					Ft.	In.		
G3	1			GIRDER ASSEMBLY	58	13/16	6746.9	6746.9
		WP3	1	PL 1/2 " x 16 "	58	13/16	1580.4	1580.4
		TF3	1	PL 1 " x 12 "	58	9/16	2369.7	2369.7
		BF3	1	PL 1 1/8 " x 12 "	58	9/16	2665.9	2665.9
		P1	4	PL 1/2 " x 5 "	1	4	10.9	43.6
		P2	4	PL 1/2 " x 5 "	1	4	10.9	43.6
		P4	4	PL 1/2 " x 5 "	1	4	10.9	43.6
			138	7/8" DIA. SHEAR STUD	0	9		
TOTAL WEIGHT =							6746.9	

THE TWO CAMBER DIMENSIONS REPRESENT THE FOLLOWING:
 -TOP DIMENSION = TOTAL CAMBER IN FINISHED BEAM
 -BOTTOM DIMENSION = TOTAL CAMBER @ TIME OF FABRICATION

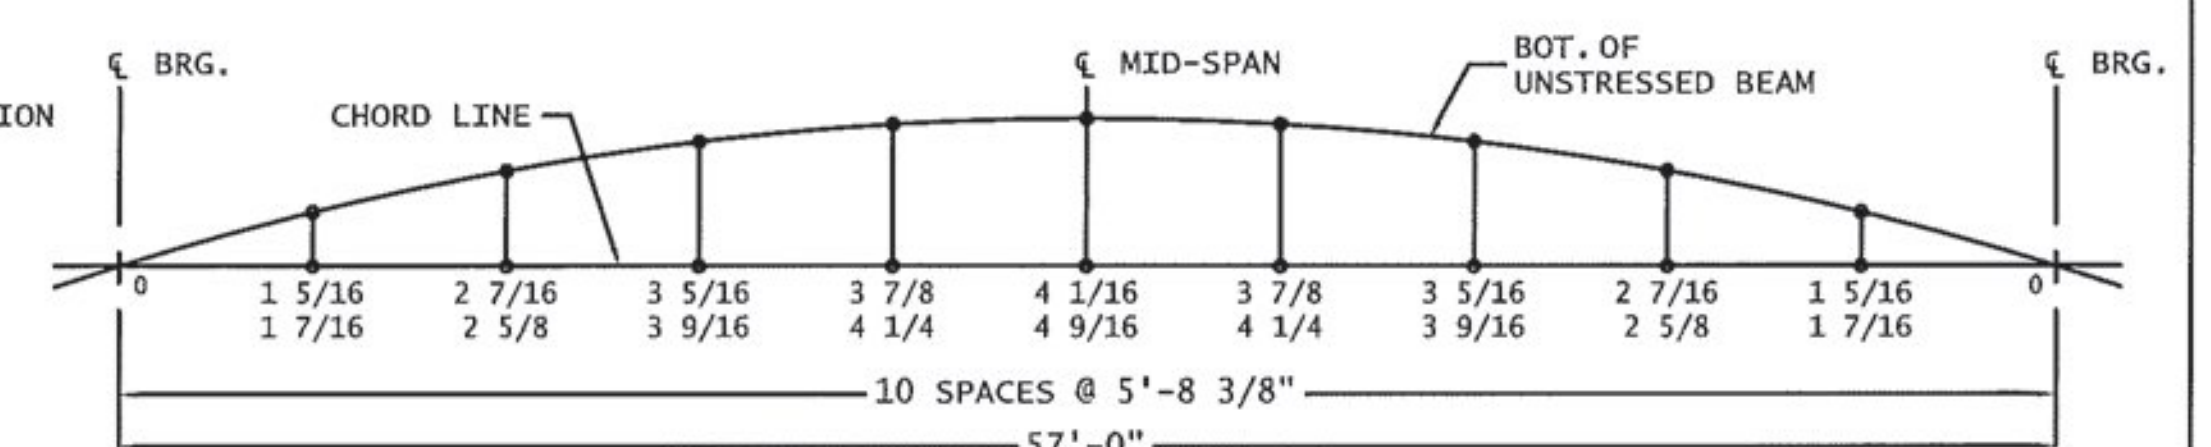

FINISH:	HOT-DIP GALVANIZED		
MATERIAL:	AASHTO M270 GR.50		
HOLES:	Ø15" U.N.O		
ELECTRODES:	PER WELD PROCEDURE	REVISOR	1/6/17
WELDS:	PER WELD PROCEDURE	ISSUED FOR APPROVAL	12/6/16
SURFACE PREP:	SSPC-SP6	No.	Revision
DATE:	12/6/16		
Drawn By:	DAP	Checked By:	BLB
QC:		QC:	MILLER CONSTRUCTION

Job Number:	16-181	Sheet No:	5 OF 10
Original Submittal Date:	12/6/16	Drawing No:	S-3
Drawn By:	DAP	Checked By:	BLB
QC:		QC:	MILLER CONSTRUCTION