




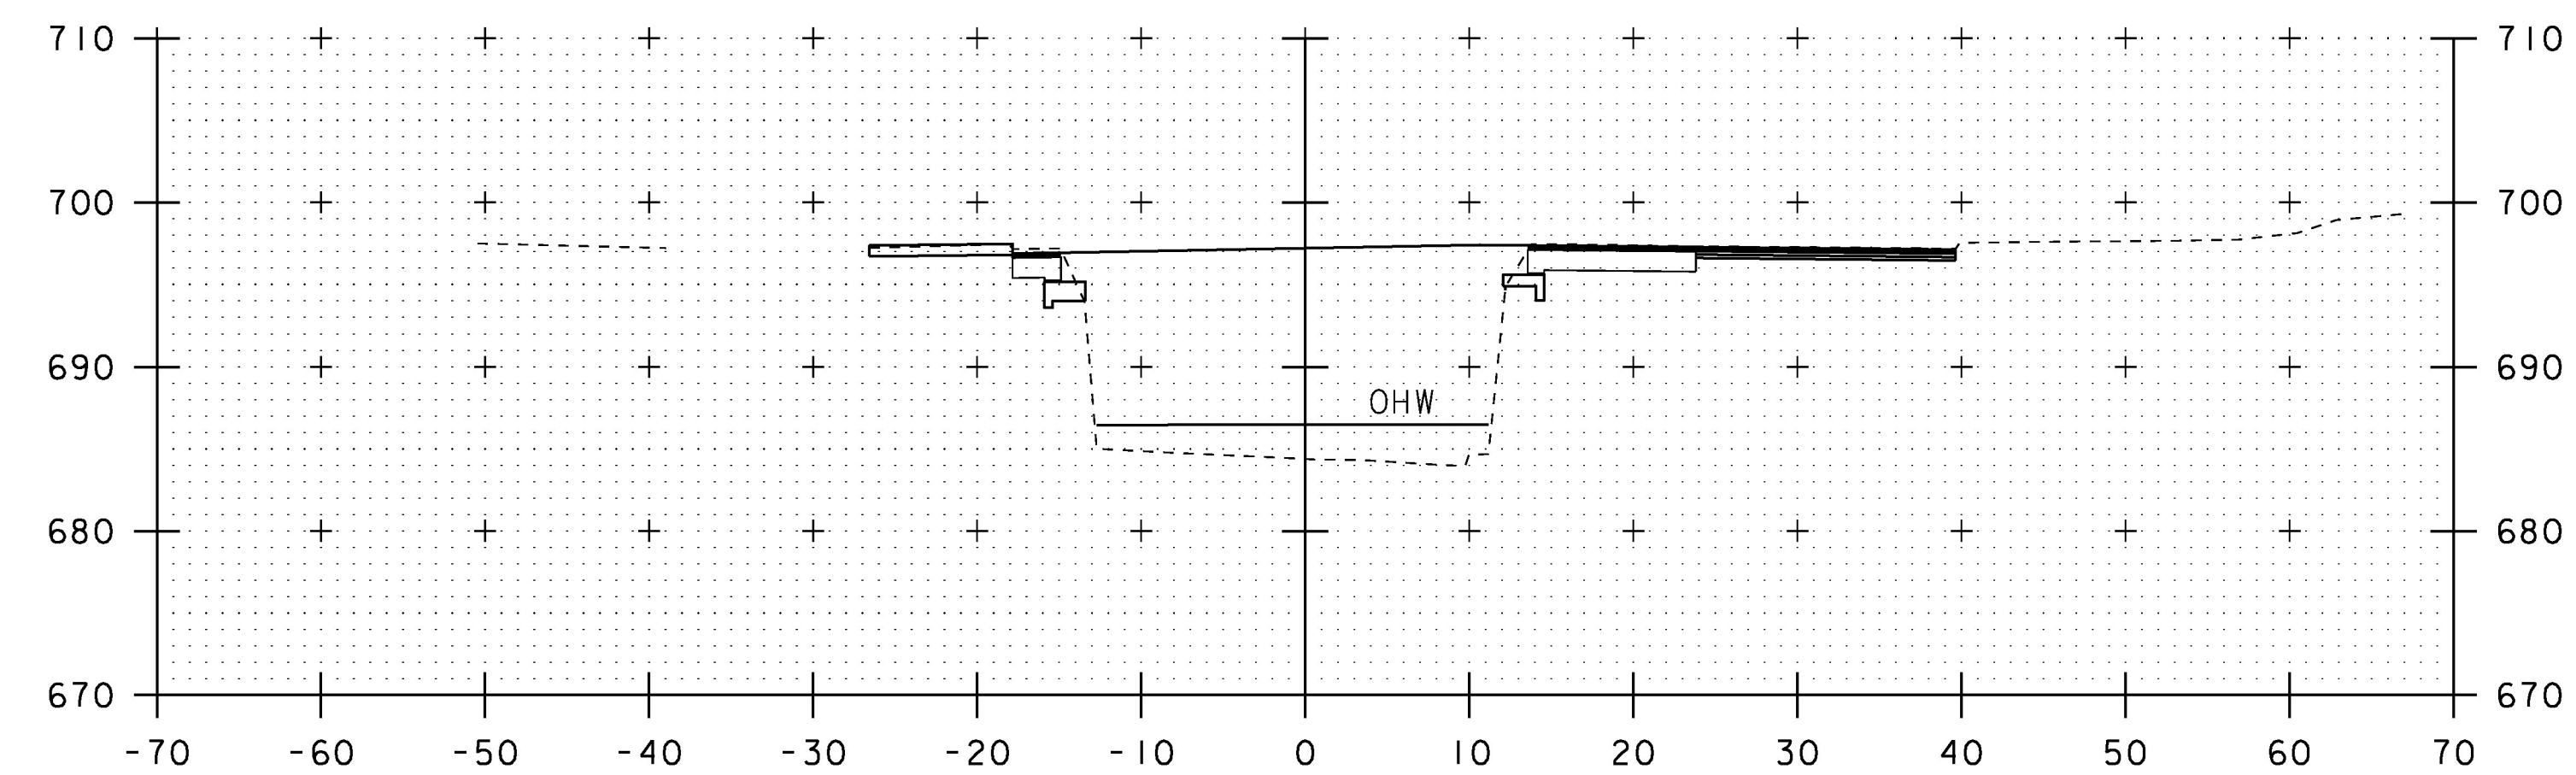


51+10

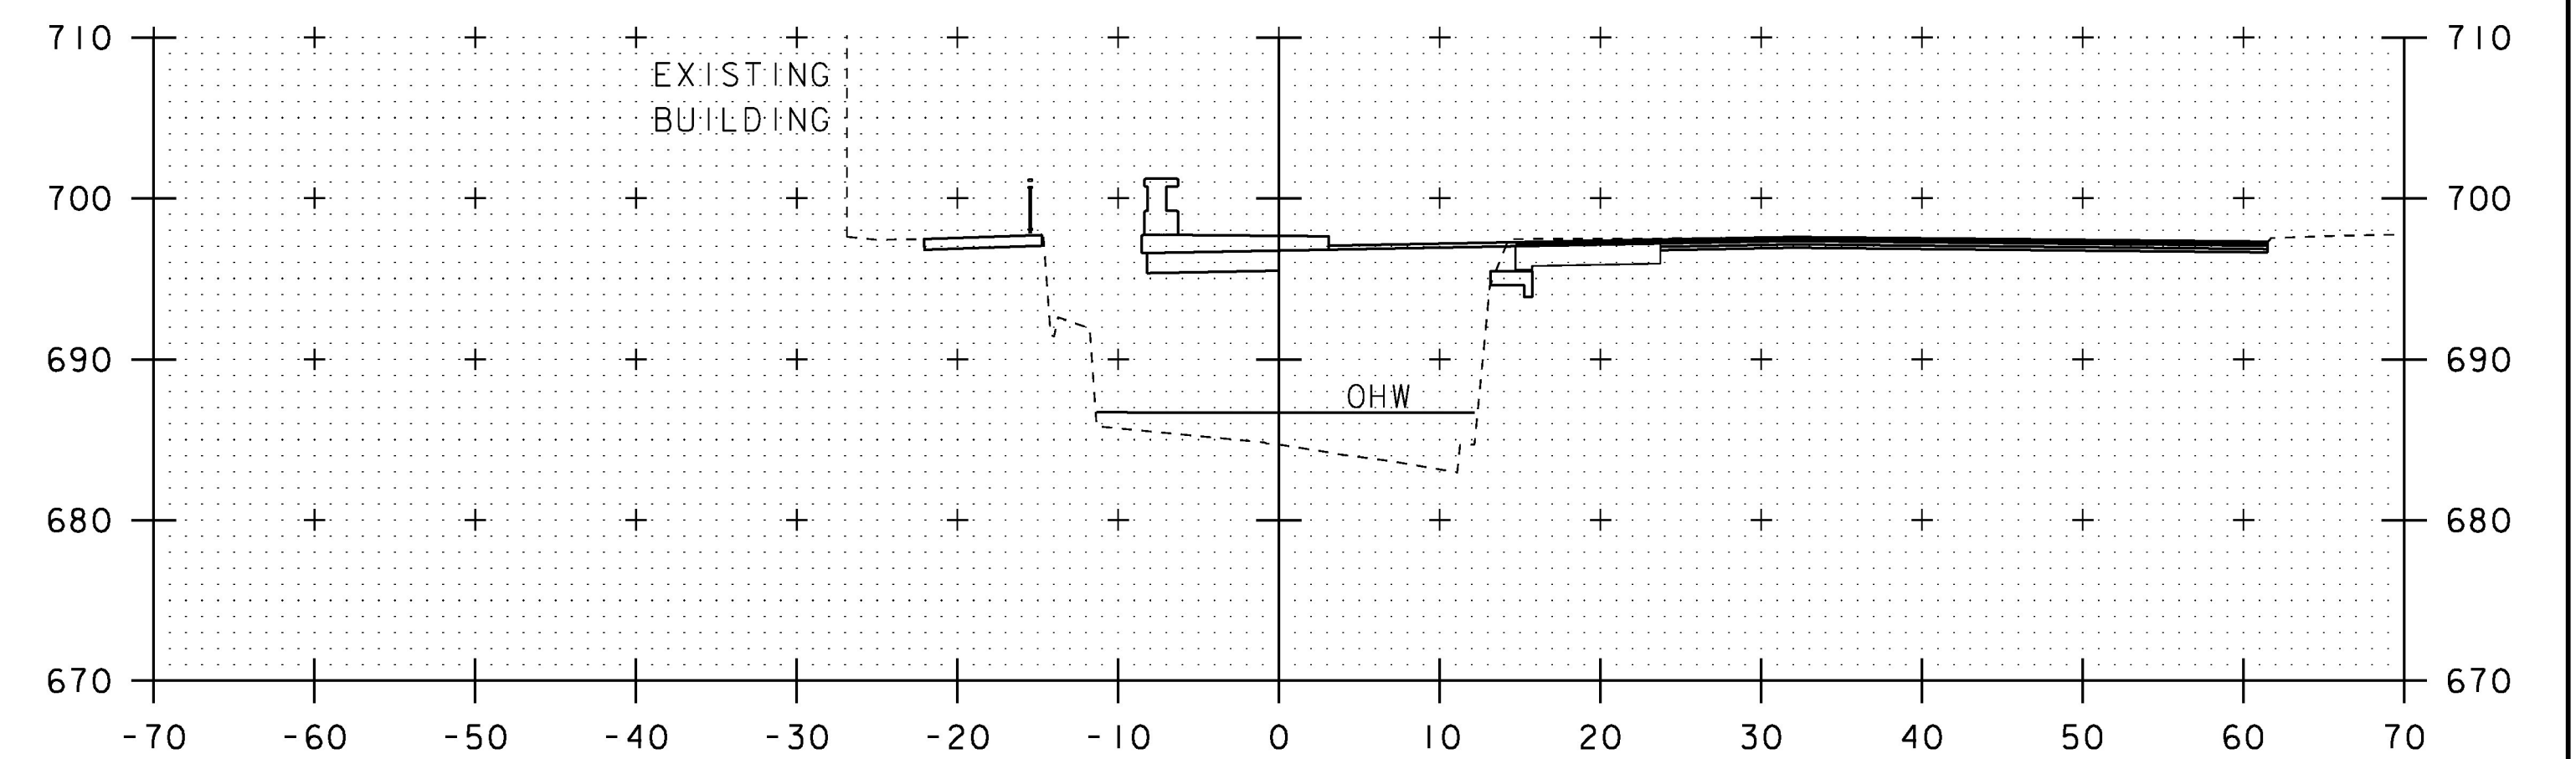

51+30

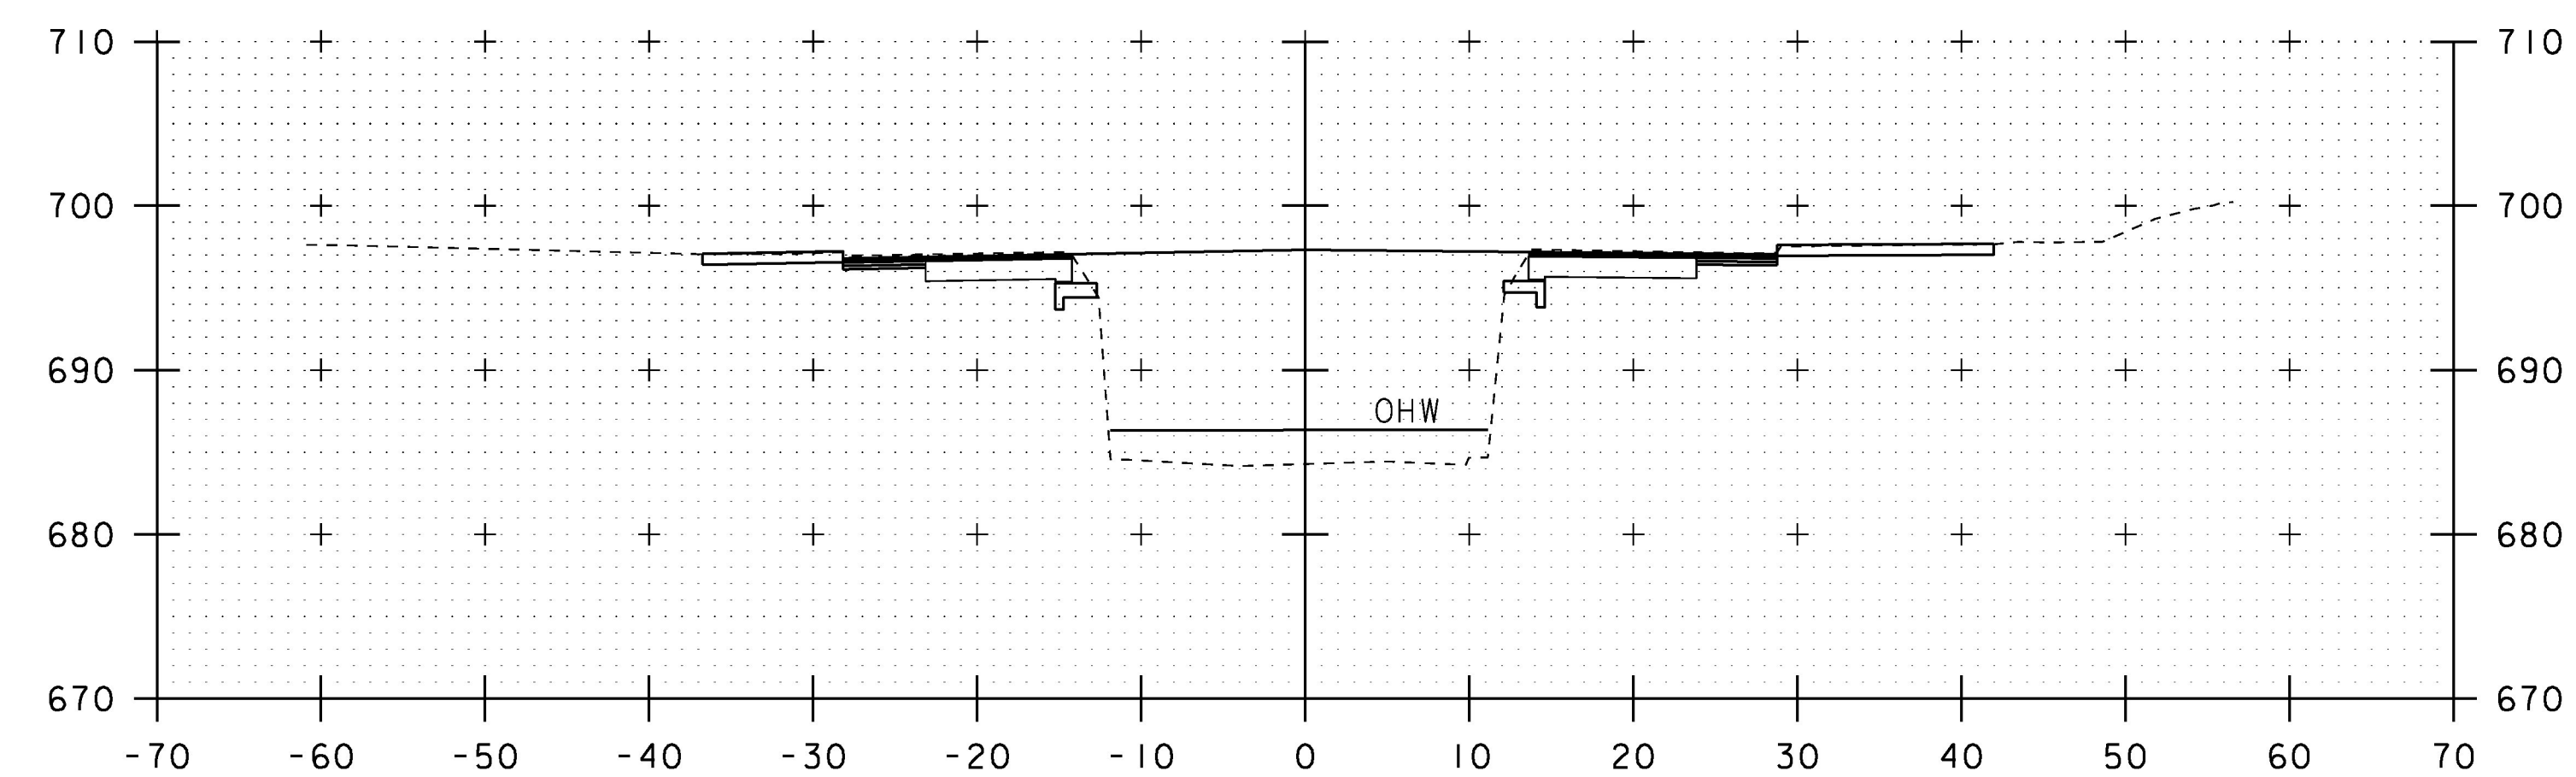

51+00

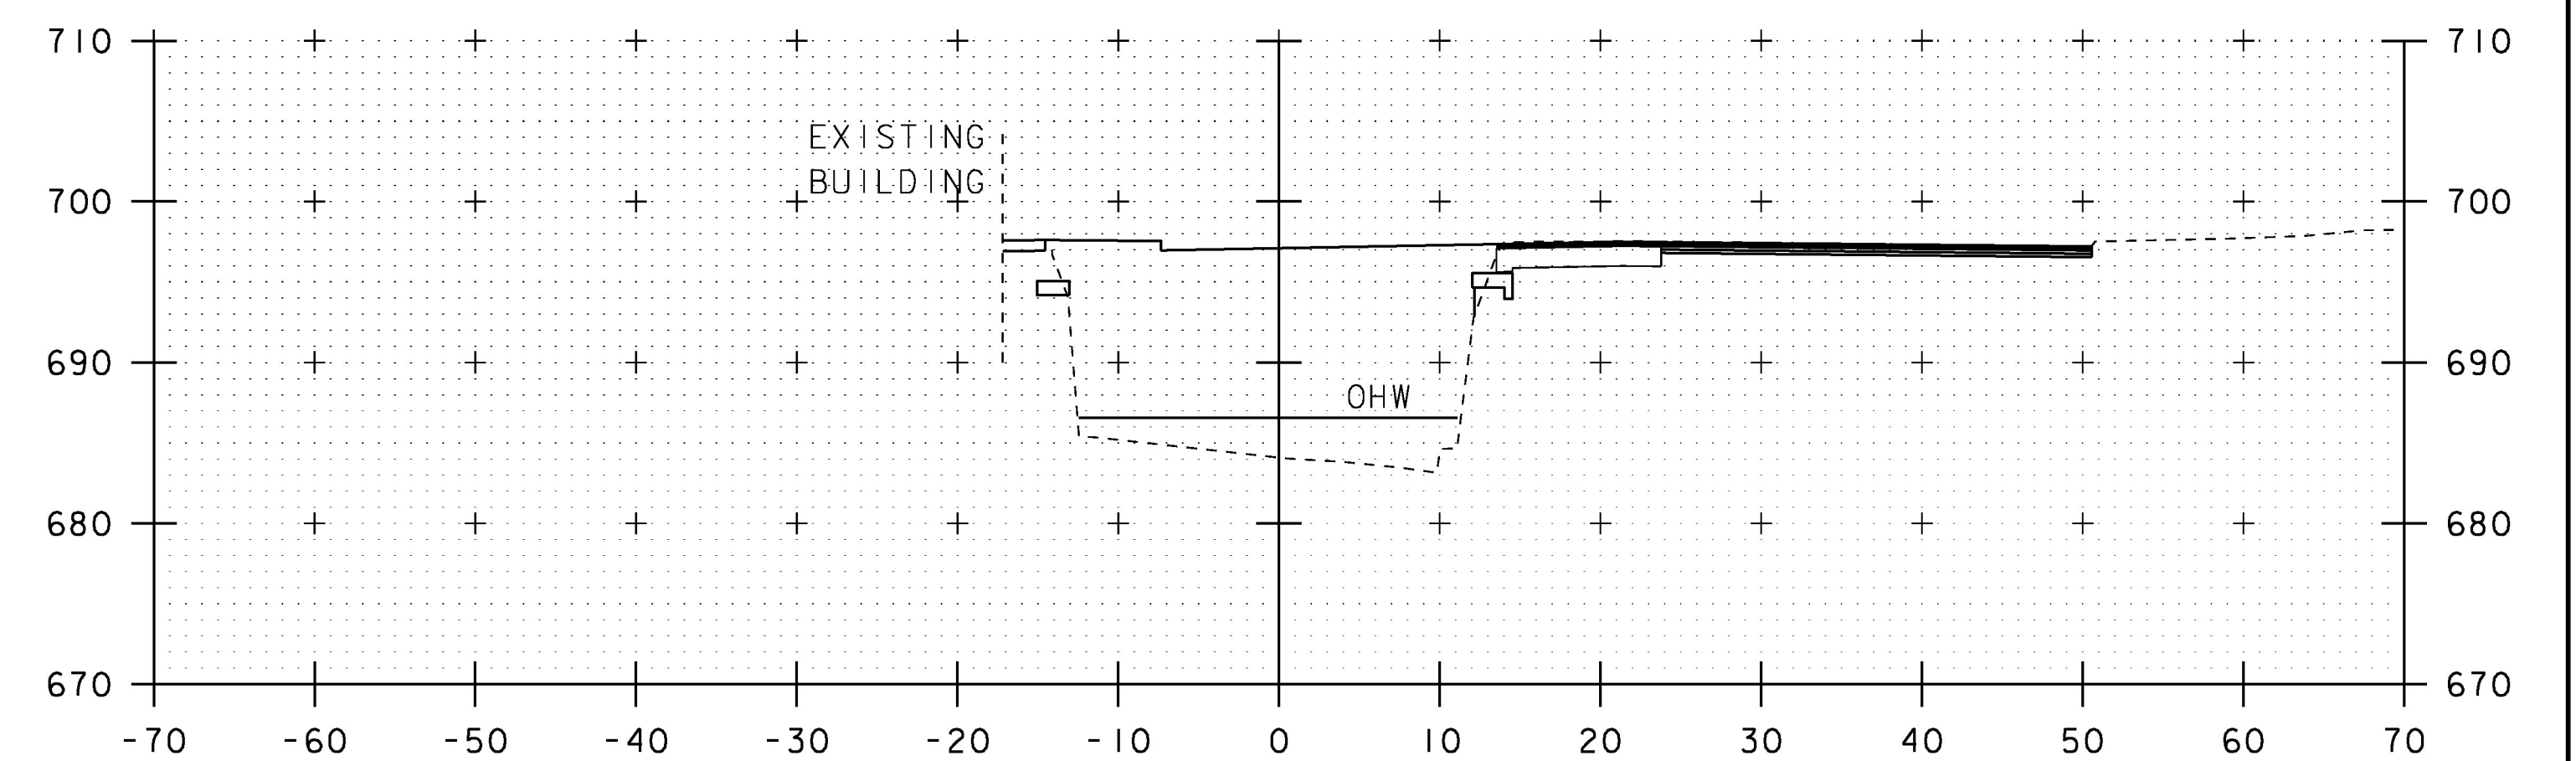

51+20

STA. 51+00 TO STA. 51+30

PROJECT NAME: WOODSTOCK VILLAGE	
PROJECT NUMBER: BF 020-2(43)	
FILE NAME: sl3j280xs.dgn	PLOT DATE: 18-JUL-2017
PROJECT LEADER: R. YOUNG	DRAWN BY: S. COLEY
DESIGNED BY: S. COLEY	CHECKED BY: W. LAMMER
CHANNEL CROSS SECTIONS 3	SHEET 46 OF 53