


CHANGING ELEVATION OF SEWER MANHOLES
WILMINGTON:
MM 2.178 LT
MM 2.228 LT
MM 2.311 LT
MM 2.344 LT

TEMPORARY 4 INCH WHITE LINE, PAINT &
DURABLE 4 INCH WHITE LINE (OPTION BID ITEM)
(ALL LINES WILL INCLUDE EDGE LINE BREAKS AND
RADIUS FOR TOWN HIGHWAYS)
WILMINGTON:
MM 2.046 - 2.349 EDGE LINE LT & RT

TEMPORARY 4 INCH YELLOW LINE, PAINT &
DURABLE 4 INCH YELLOW LINE (OPTION BID ITEM)
(ALL LINES WILL INCLUDE C/L BREAKS FOR
TOWN HIGHWAYS)
WILMINGTON:
MM 2.046 - 2.349 DOUBLE SOLID C/L

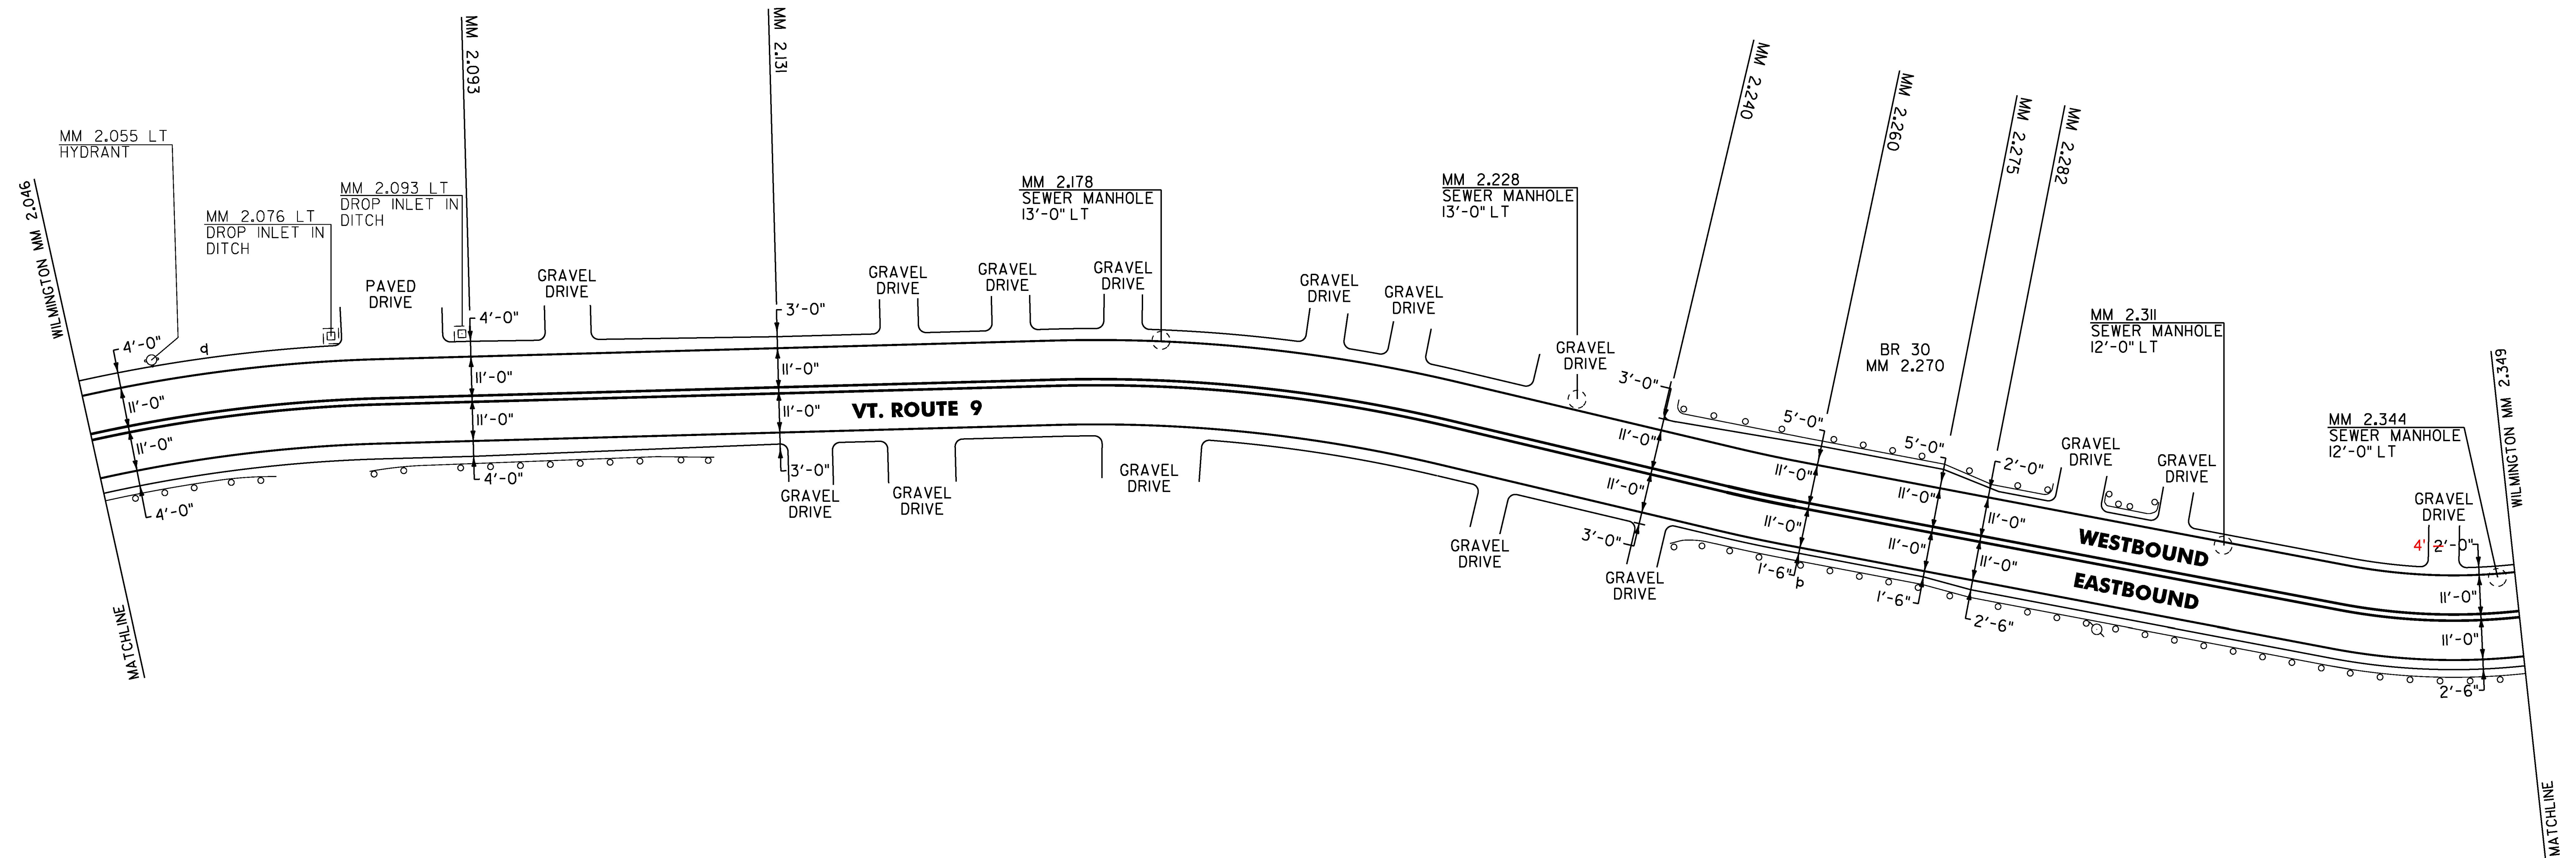

LEGEND: COLD PLANE AREA

NOT TO SCALE

PROJECT NAME:	BENNINGTON-WILMINGTON
PROJECT NUMBER:	NH SURF (51)
FILE NAME:	pl4v201Bennington-Wilmington.dgn
PROJECT LEADER:	M. FOWLER
DESIGNED BY:	N. PAPPAS
LAYOUT SHEET 14	
DATE:	28-MAR-2017
DRAWN BY:	N. PAPPAS
CHECKED BY:	M. FOWLER
SHEET 33	OF 64