



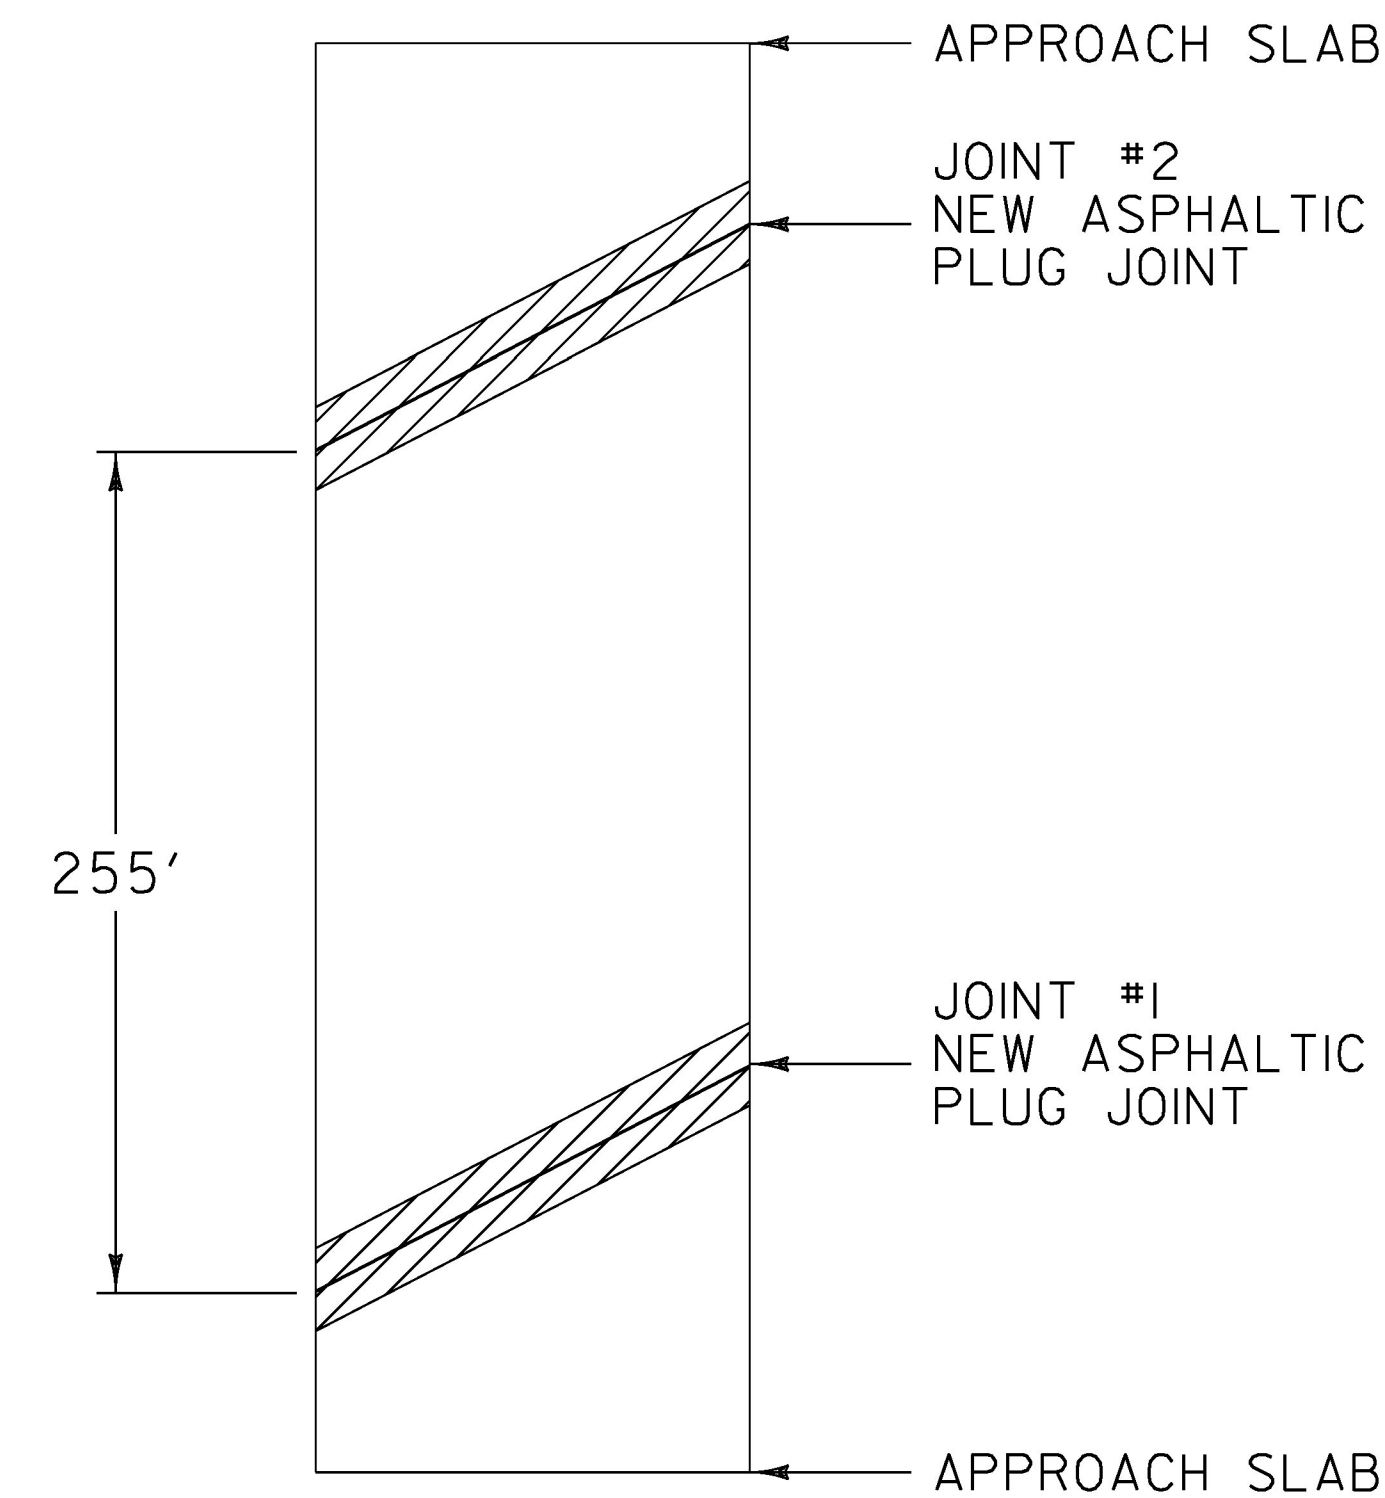

BRIDGE 9

MM 6.420 BENNINGTON
LENGTH OF ASPHALTIC PLUG JOINTS:
JOINT #1 - 45'
JOINT #2 - 45'


TOTAL = 90'

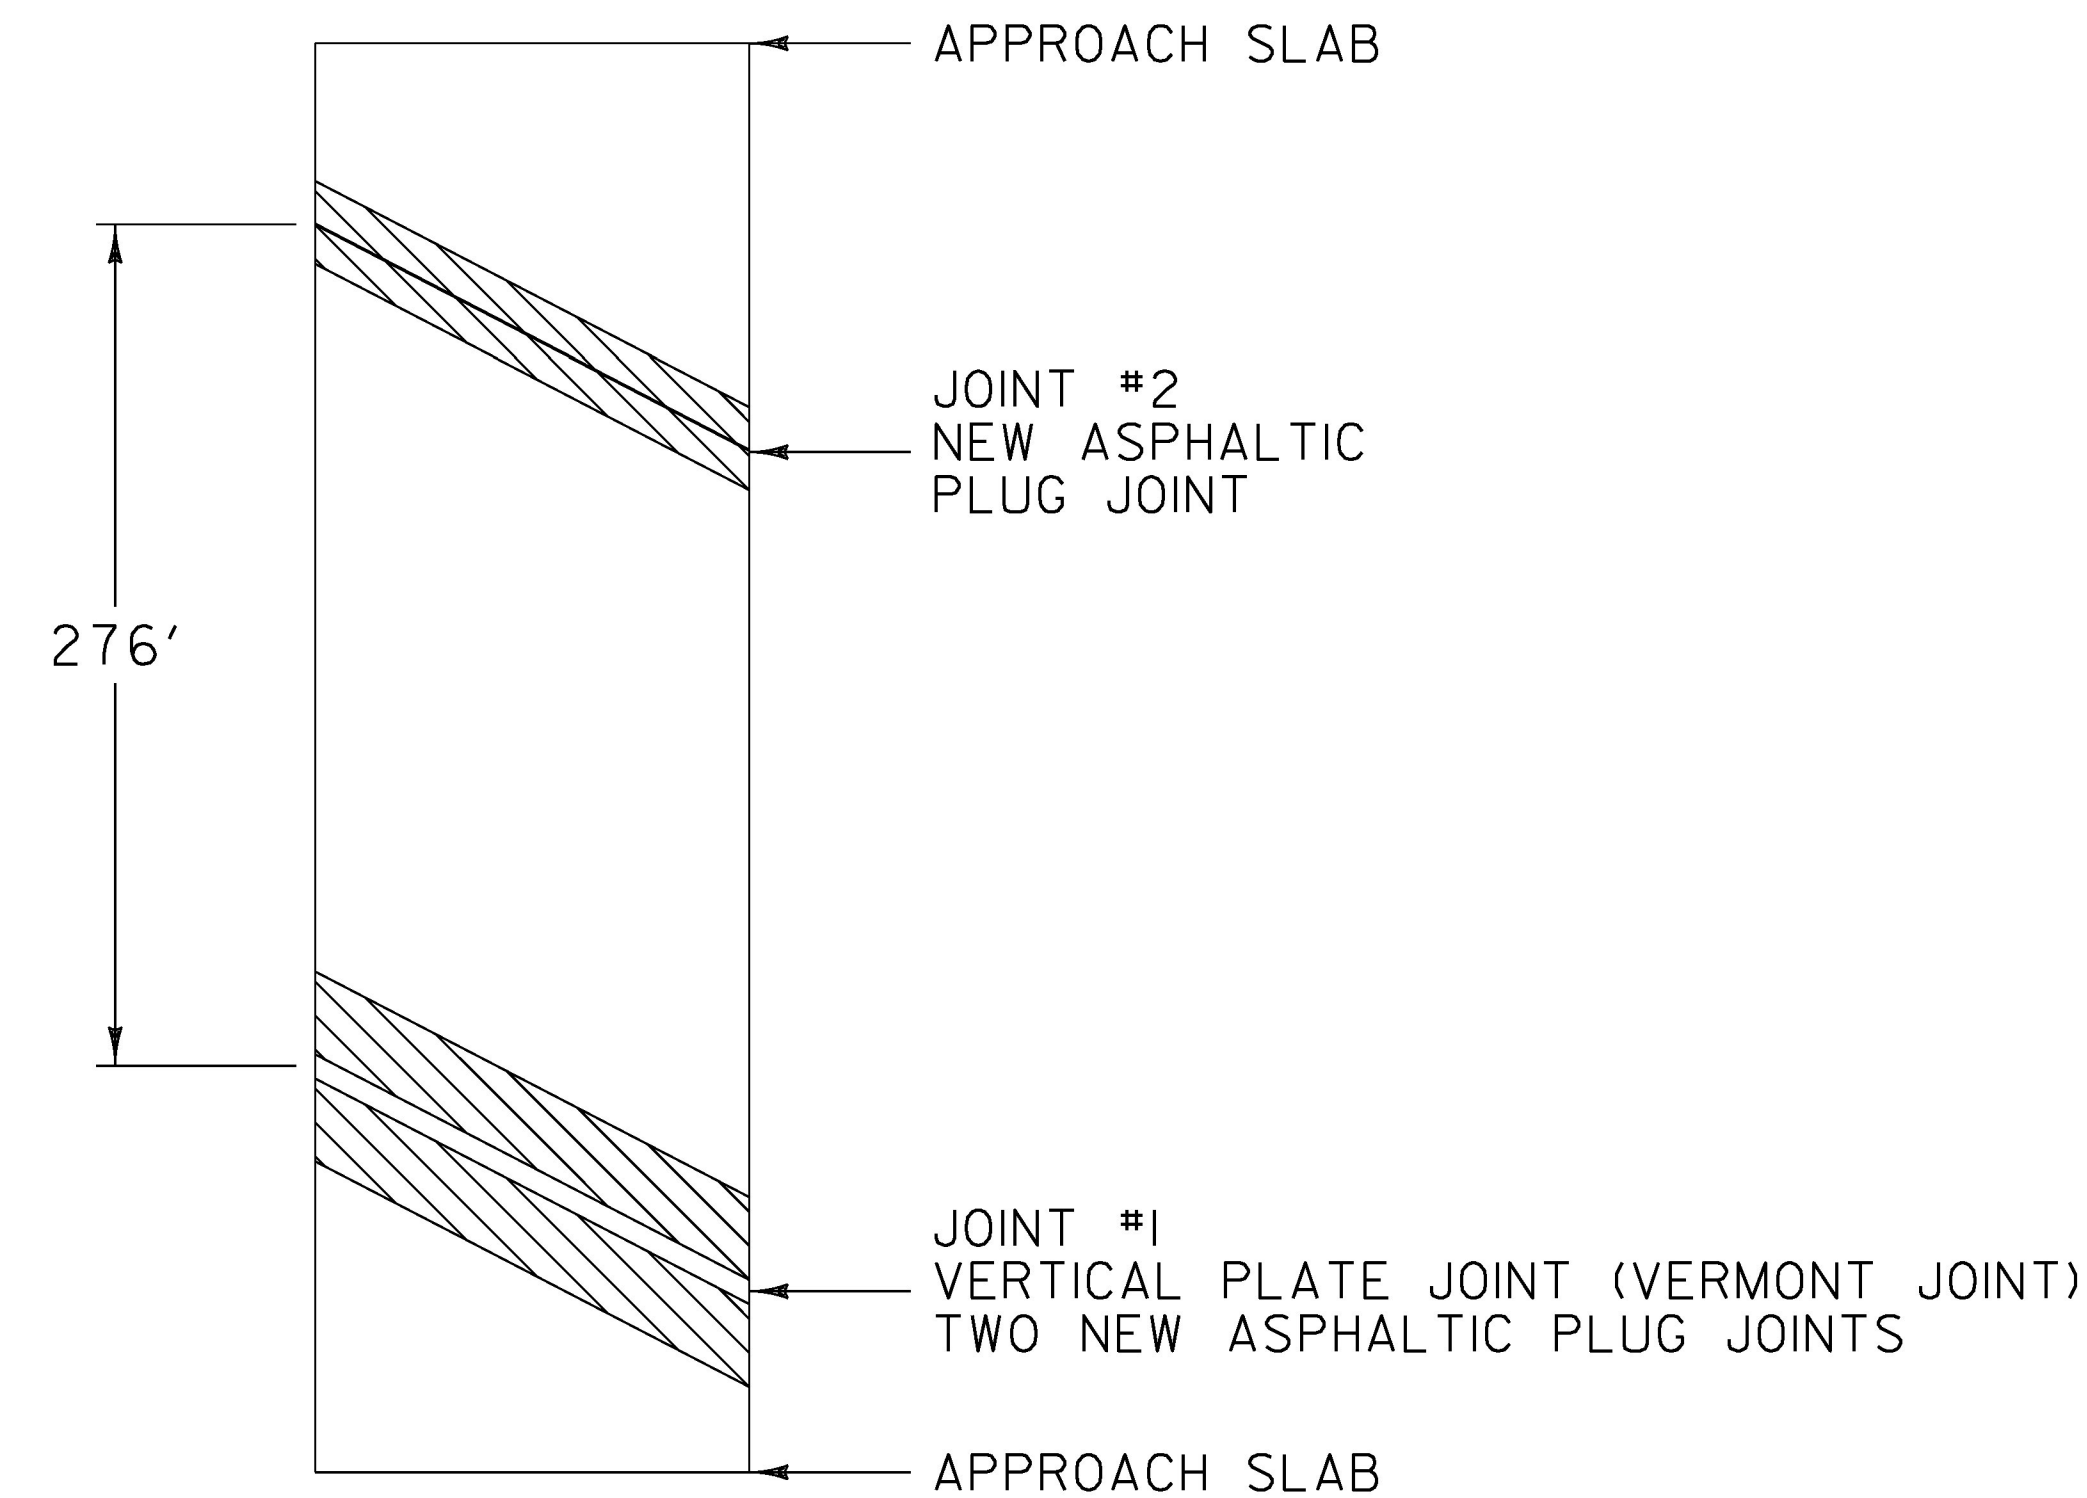

BRIDGE 11

MM 1.215 WOODFORD
LENGTH OF ASPHALTIC PLUG JOINTS:
JOINT #1 - 2 X 62' = 124'
JOINT #2 - 62'


TOTAL = 186'

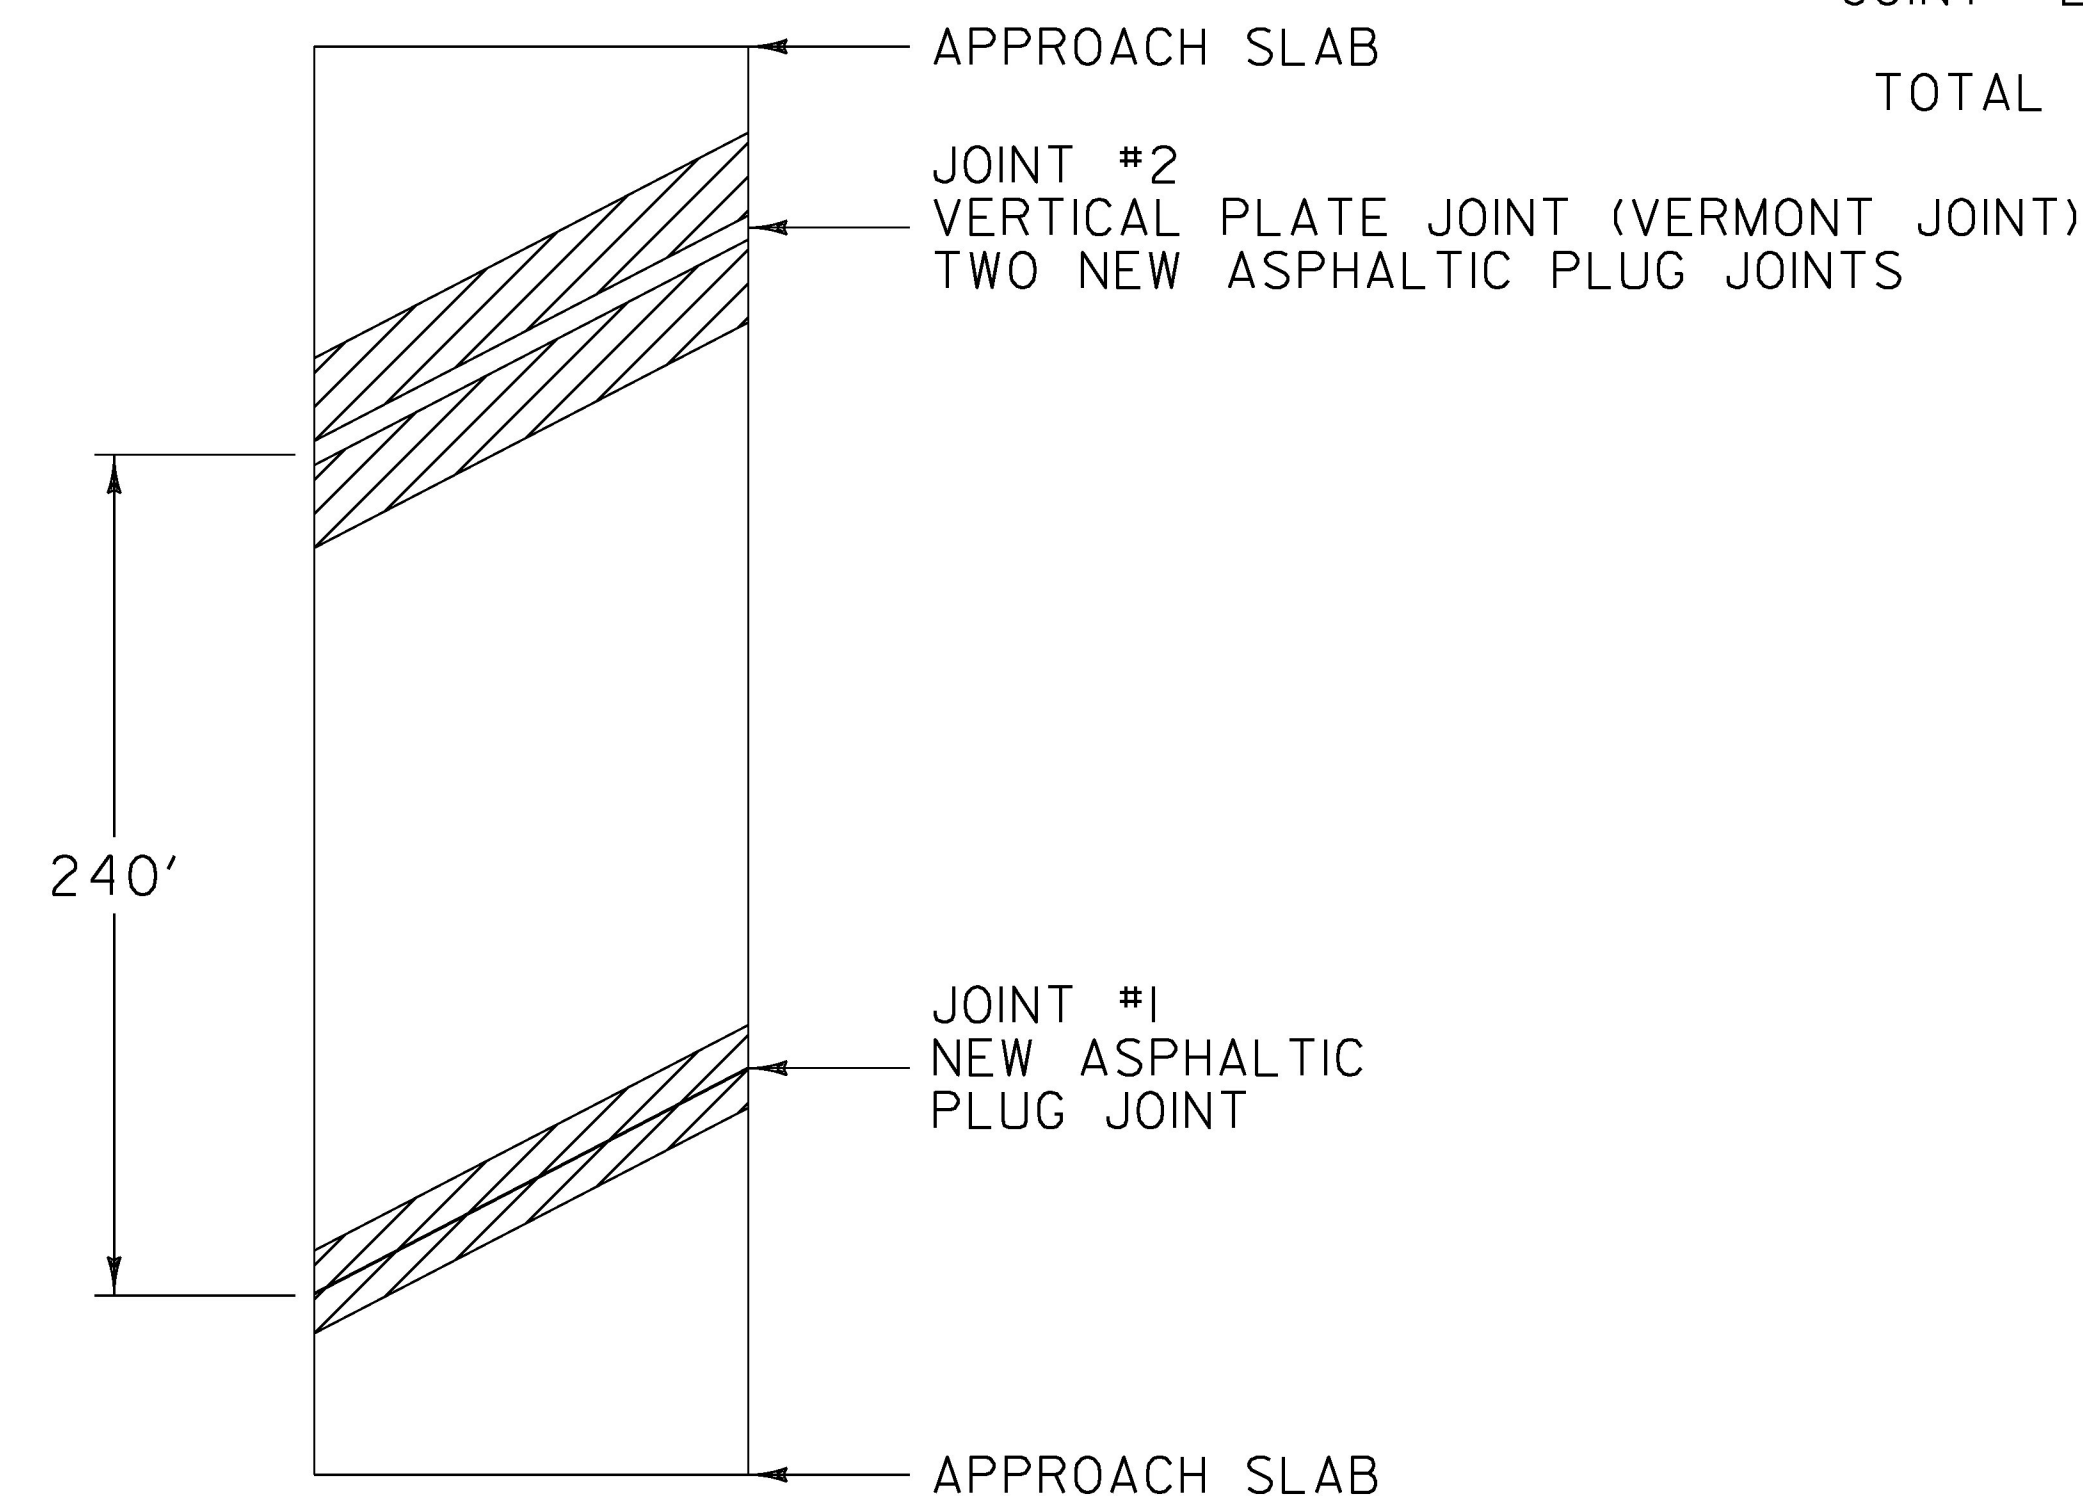

BRIDGE 12

MM 2.814 WOODFORD
LENGTH OF ASPHALTIC PLUG JOINTS:
JOINT #1 - 54'
JOINT #2 - 2 X 54' = 108'

TOTAL = 162'

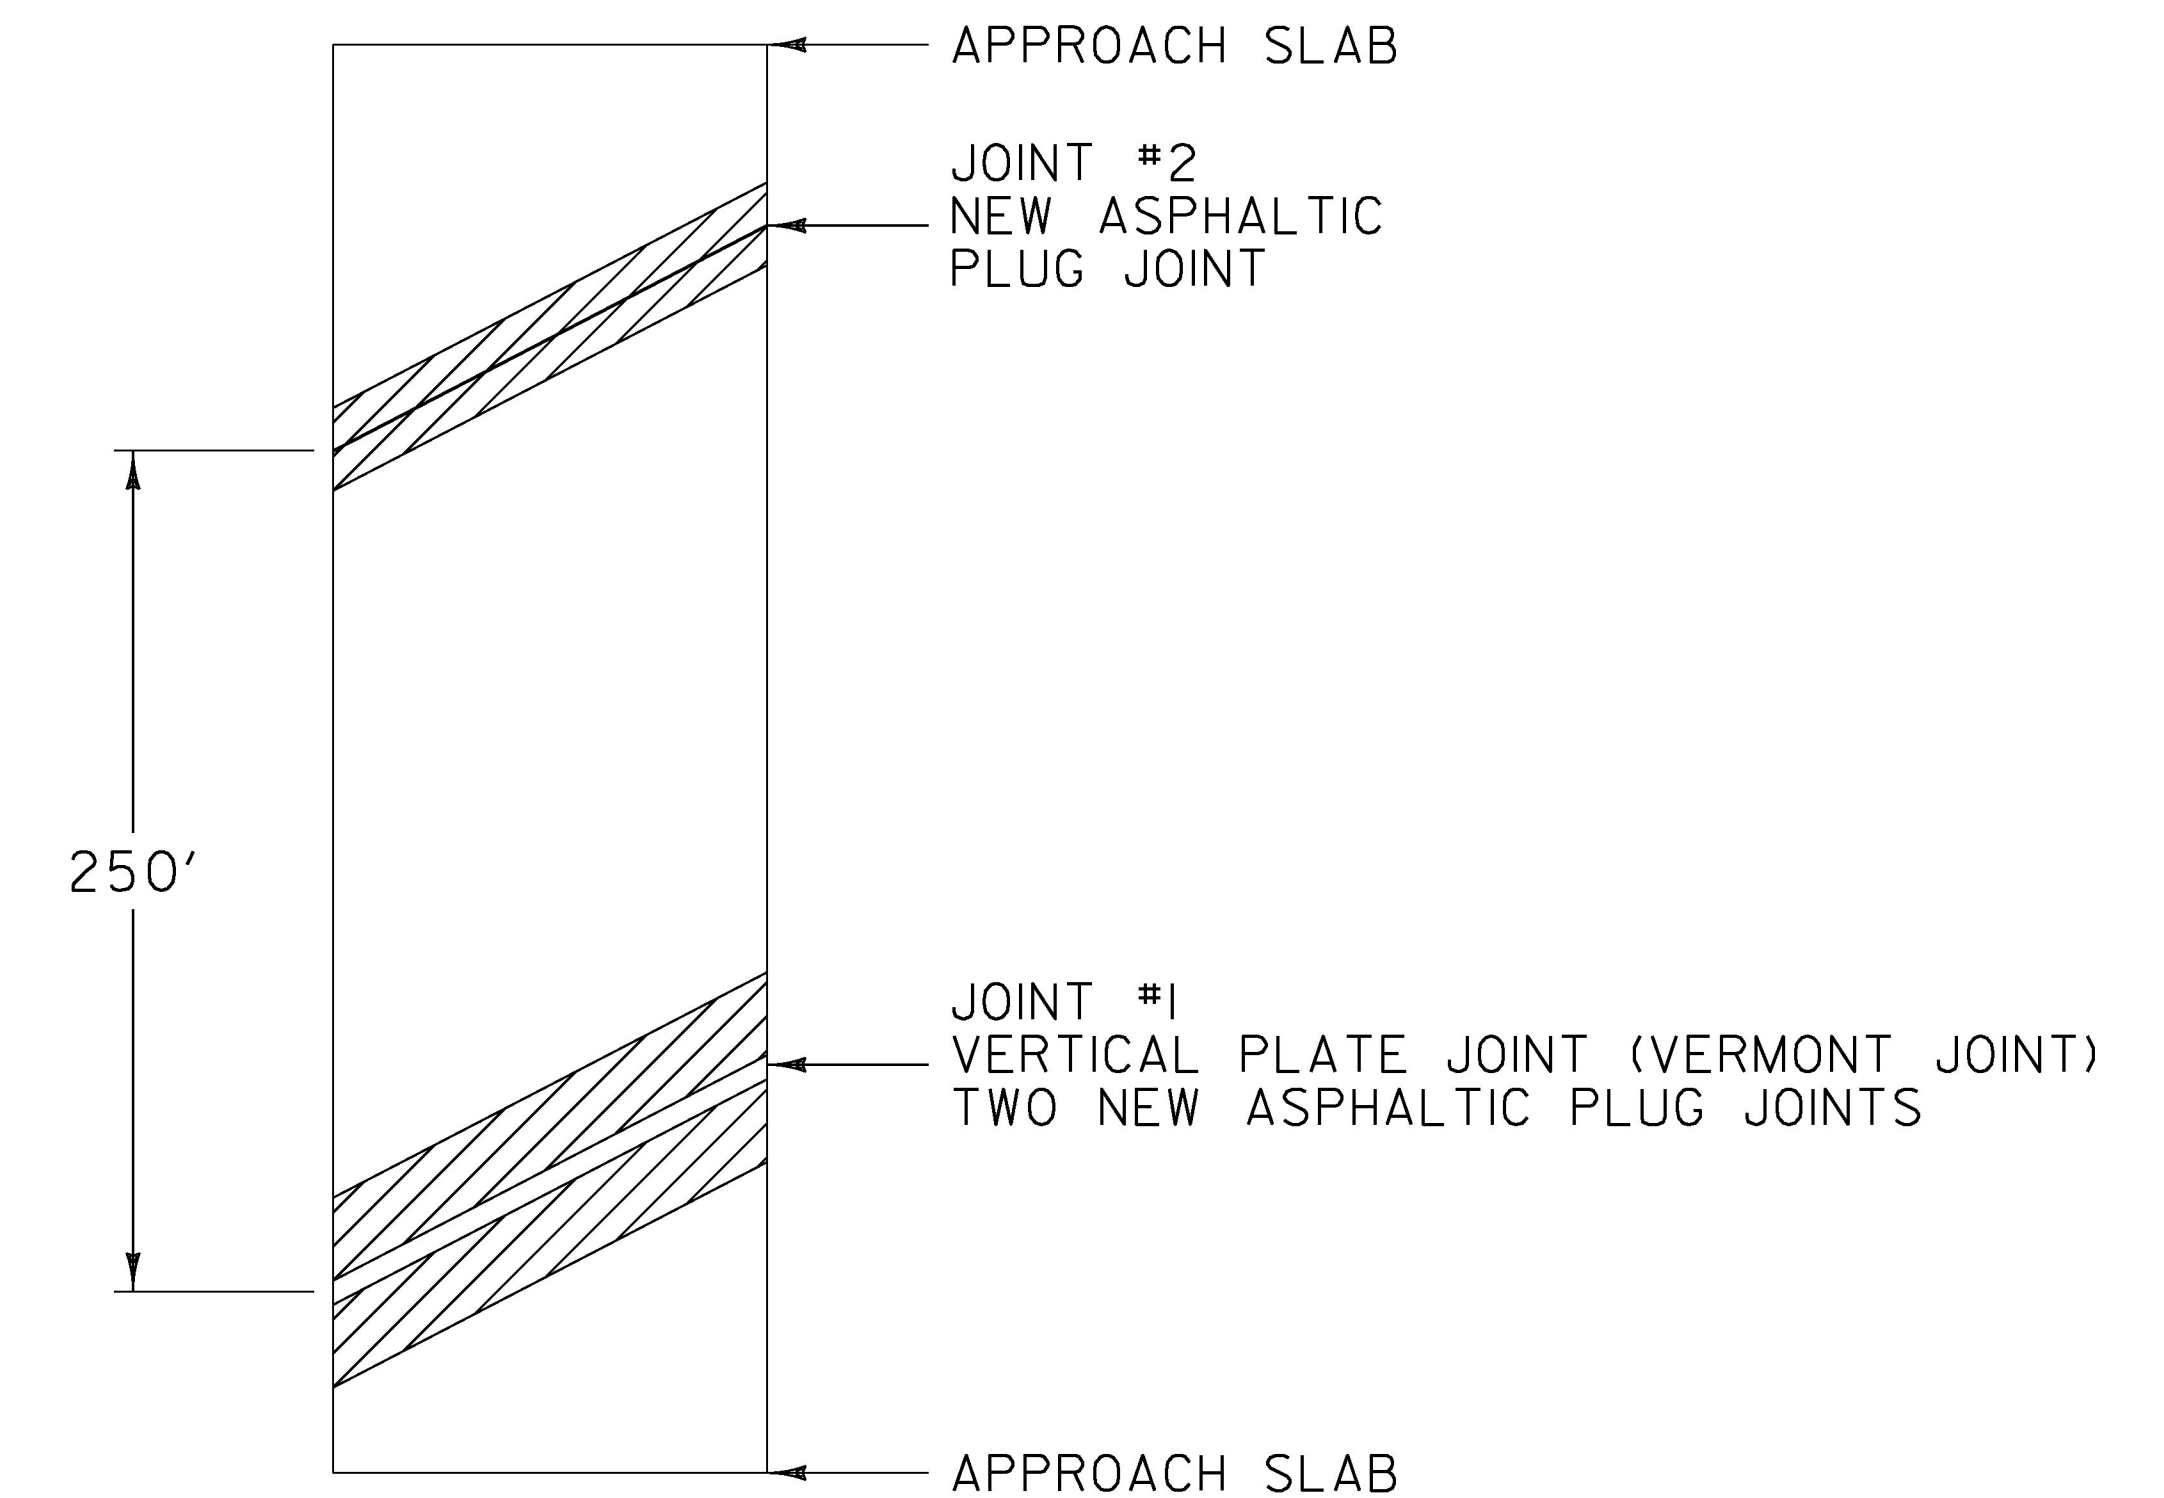

BRIDGE 25

MM 3.972 SEARSBURG
LENGTH OF ASPHALTIC PLUG JOINTS:
JOINT #1 - 2 X 60' = 120'
JOINT #2 - 60'

TOTAL = 180'

LEGEND

EXISTING BRIDGE JOINTS TO BE
REPAIRED WITH ASPHALTIC PLUG JOINT

NOT TO SCALE

PROJECT NAME:	BENNINGTON-WILMINGTON
PROJECT NUMBER:	NH SURF (5I)
FILE NAME:	pl4v201Bennington-Wilmington.dg
PROJECT LEADER:	M. FOWLER
DESIGNED BY:	N. PAPPAS
BRIDGE EXPANSION JOINT DETAIL SHEET I	CHECKED BY: M. FOWLER
	DATE: 28-MAR-2017
	DRAWN BY: N. PAPPAS
	SHEET 58 OF 64