

MILLED RUMBLE STRIPS
STA. A 554+25 - STA. A 559+75 CTR

STEEL BEAM GUARDRAIL, GALVANIZED
STA. A 558+11 - STA. A 558+48.5 LT

ANCHOR FOR STEEL BEAM GUARDRAIL
AS SHOWN - I
(SEE STD G1-D) **A 558+11 LT**

REMOVE AND RESET GUARDRAIL
STA. A 558+48.5 - STA. A 559+75 LT

REPLACE GUARDRAIL POST ASSEMBLY
SEE ITEM DETAIL SHEETS

REPLACE GUARDRAIL BEAM UNIT
SEE ITEM DETAIL SHEETS


REMOVAL AND DISPOSAL OF GUARDRAIL
STA. A 558+11 - STA. A 558+48.5 LT

DURABLE 4 INCH WHITE LINE, (SEE OPTION ITEMS) &
TEMPORARY 4 INCH WHITE LINE, PAINT
(ALL LINES WILL INCLUDE EDGE LINE BREAKS AND
RADII FOR SIDE ROADS)
STA. A 554+25 - STA. A 559+75 (SOLID LT & RT)

DURABLE 4 INCH YELLOW LINE, (SEE OPTION ITEMS) &
TEMPORARY 4 INCH YELLOW LINE, PAINT
(ALL LINES WILL INCLUDE CENTERLINE BREAKS FOR SIDE ROADS)
STA. A 554+25 - STA. A 559+75 (SOLID LT & RT)

REMOVING SIGNS
AS SHOWN - I

MATCHLINE STA. A 554+25 SEE PREVIOUS SHEET

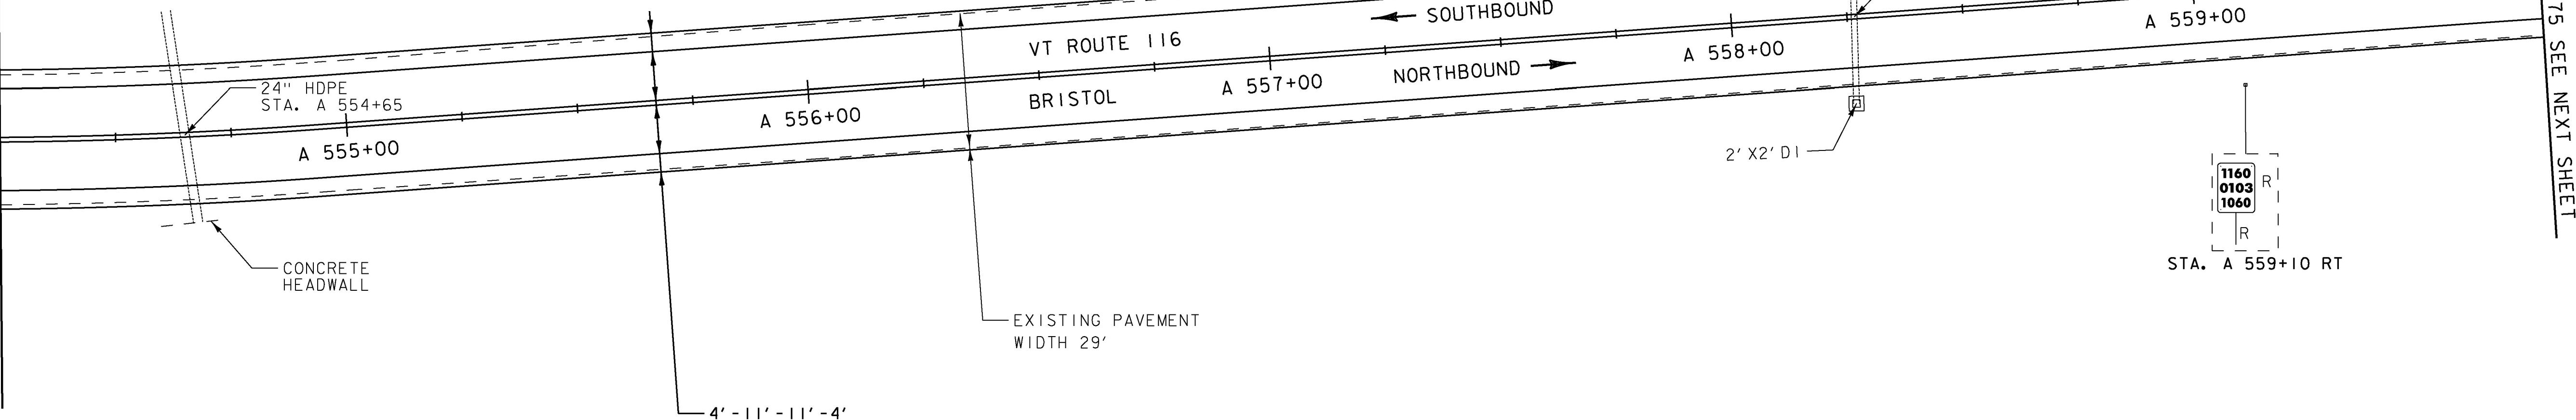

MILLED RUMBLE STRIPS
STA. A 559+75 - STA. A 565+50 CTR

REMOVE AND RESET GUARDRAIL
STA. A 559+75 - STA. A 565+50 LT


REPLACE GUARDRAIL POST ASSEMBLY
SEE ITEM DETAIL SHEETS

REPLACE GUARDRAIL BEAM UNITS
SEE ITEM DETAIL SHEETS

DURABLE 4 INCH WHITE LINE, (SEE OPTION ITEMS) &
TEMPORARY 4 INCH WHITE LINE, PAINT
(ALL LINES WILL INCLUDE EDGE LINE BREAKS AND
RADII FOR SIDE ROADS)
STA. A 559+75 - STA. A 565+50 (SOLID LT & RT)

DURABLE 4 INCH YELLOW LINE, (SEE OPTION ITEMS) &
TEMPORARY 4 INCH YELLOW LINE, PAINT
(ALL LINES WILL INCLUDE CENTERLINE BREAKS FOR SIDE ROADS)
STA. A 559+75 - STA. A 561+00 (SOLID LT & RT)
STA. A 561+00 - STA. A 565+50 (SOLID LT, DASHED RT)

MATCHLINE STA. A 559+75 SEE PREVIOUS SHEET

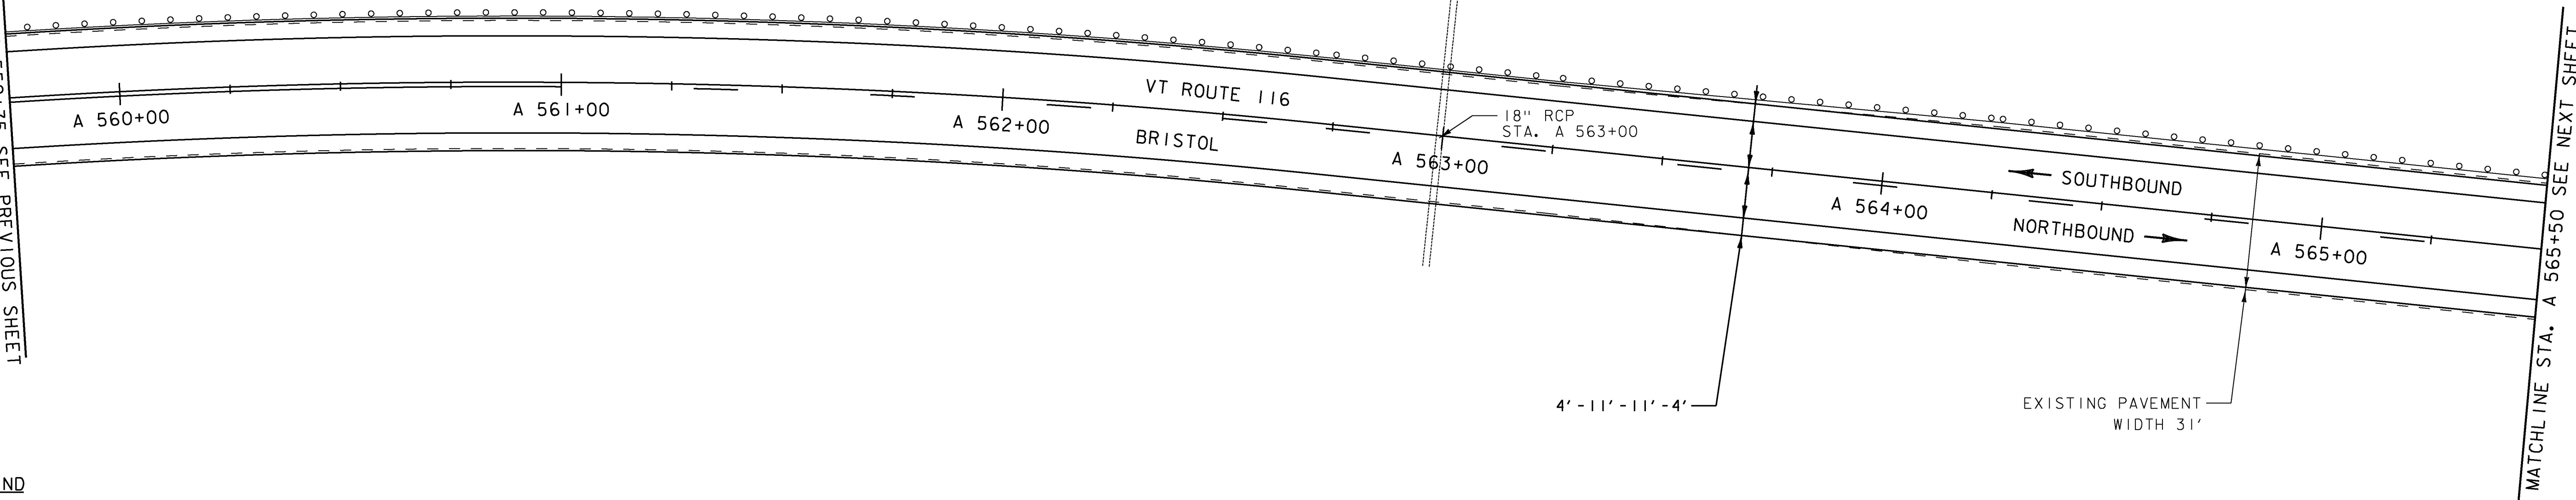

SIGN LEGEND

R = REMOVE
R&S = REMOVE AND SALVAGE
RET = RETAIN
S = SALVAGED
N = NEW
B-B = BACK TO BACK
- - = EXISTING
— = NEW

0 20 40
SCALE IN FEET

PROJECT NAME: MIDDLEBURY-STARKSBORO
PROJECT NUMBER: STP 2953(I)

FILE NAME: z14V227bdr.dgn
PROJECT LEADER: C.LATHROP
DESIGNED BY: J. GOODALL
PLAN SHEET 82

PLOT DATE: 5/4/2017
DRAWN BY: J. GOODALL
CHECKED BY: C.LATHROP
SHEET 108 OF 186