

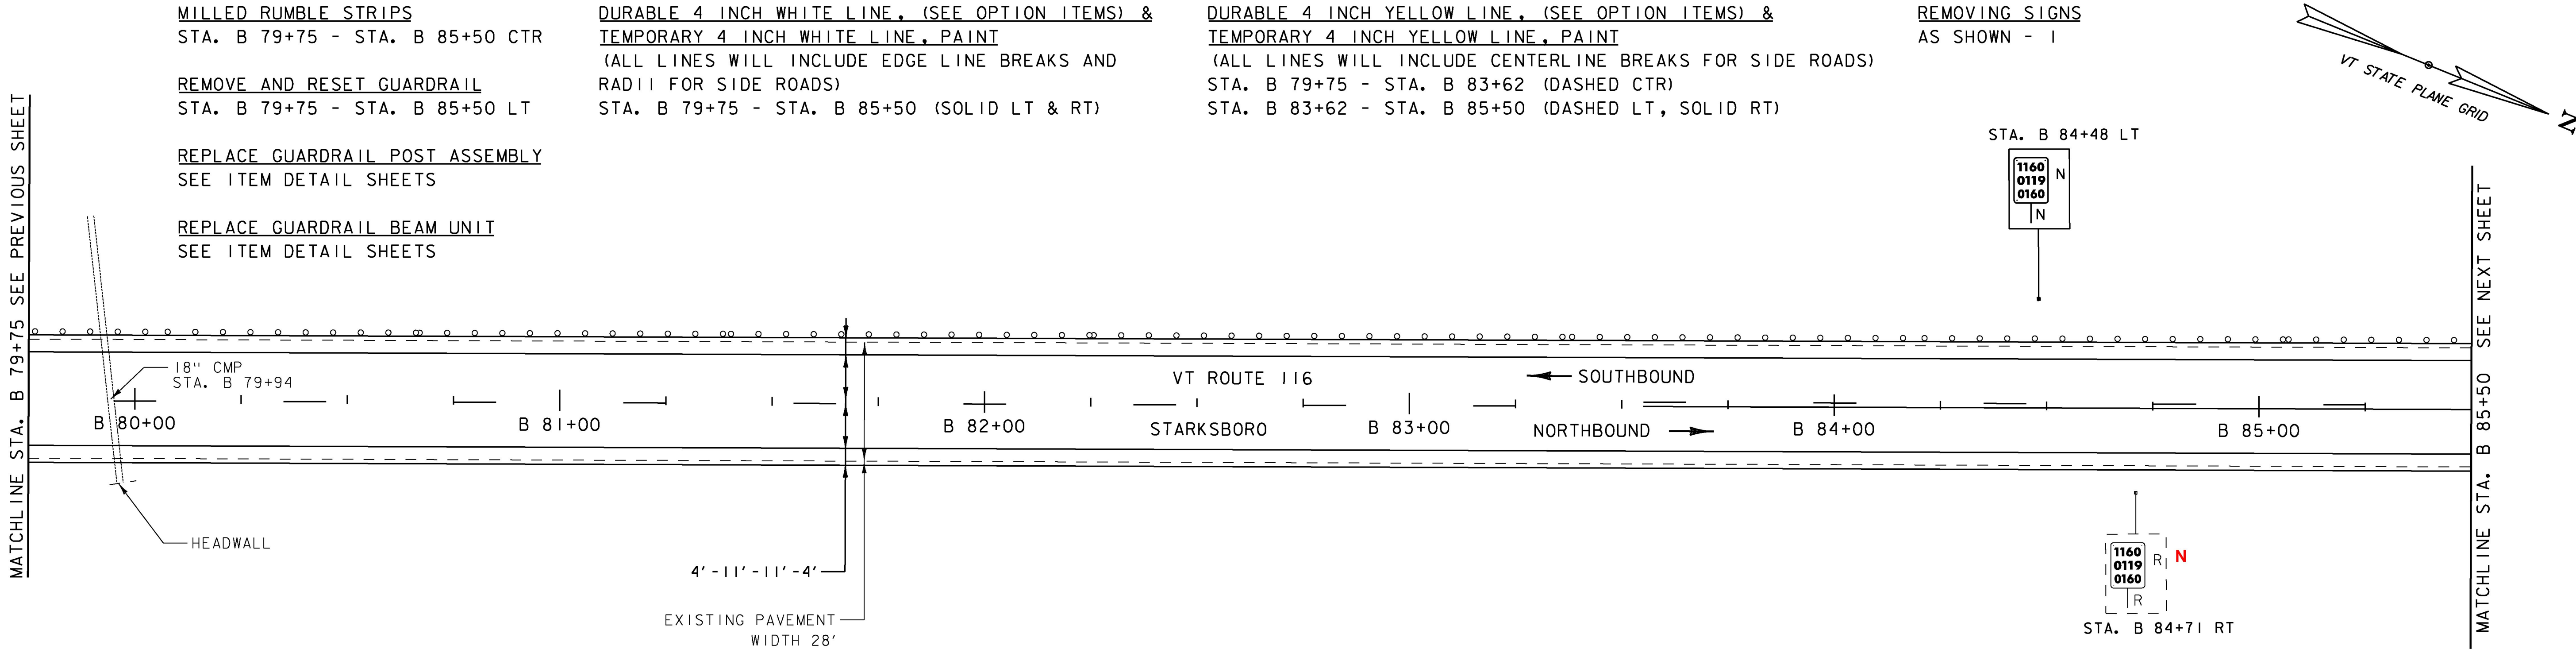


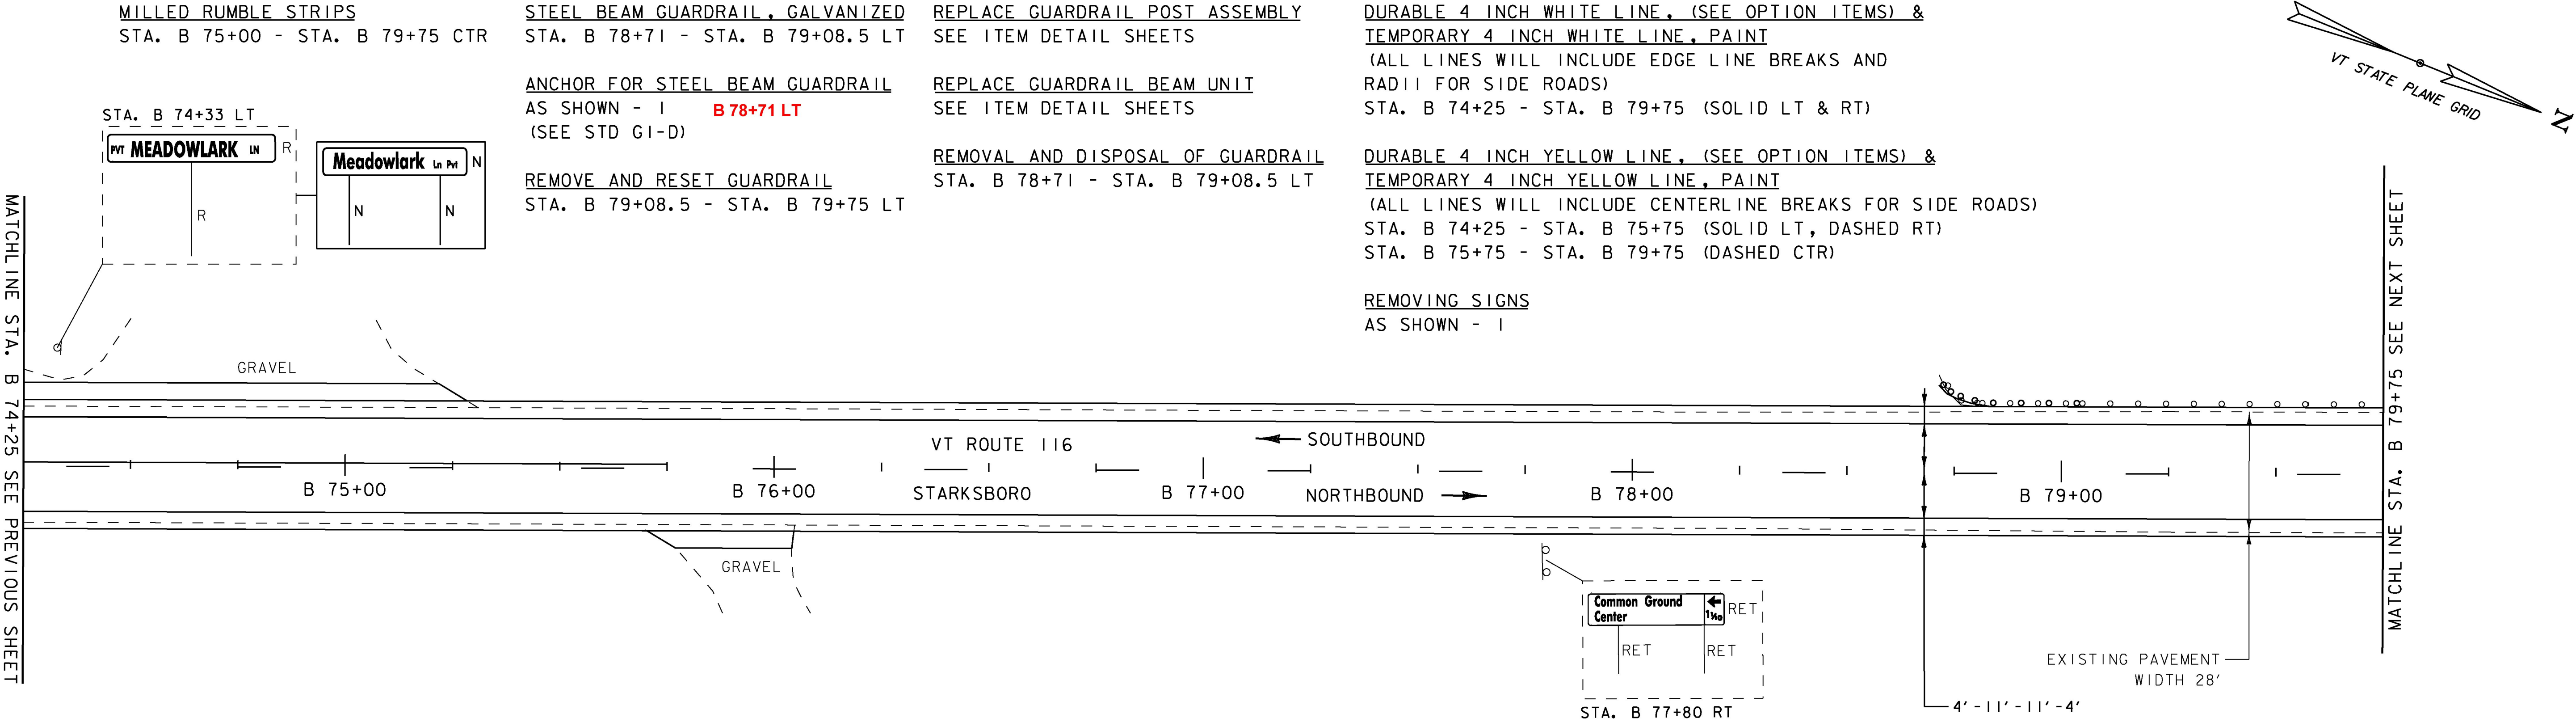

SIGN LEGEND
R = REMOVE
R&S = REMOVE AND SALVAGE
RET = RETAIN
S = SALVAGED
N = NEW
B-B = BACK TO BACK
- - = EXISTING
— = NEW

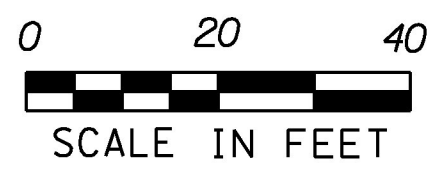

PROJECT NAME: MIDDLEBURY-STARKSBORO	
PROJECT NUMBER: STP 2953(I)	
FILE NAME: z14V227bdr.dgn	PLOT DATE: 5/4/2017
PROJECT LEADER: C.LATHROP	DRAWN BY: J. GOODALL
DESIGNED BY: J. GOODALL	CHECKED BY: C.LATHROP
PLAN SHEET 97	SHEET 123 OF 186