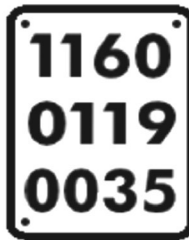


**STATE OF VERMONT
AGENCY OF TRANSPORTATION**

TRAFFIC SIGN SUMMARY SHEET 34

MILE MARKER, STATION OR SIGN NUMBER		SIGN DIMENSIONS			NEW & SALVAGED SIGNS				EXIST POST		NO. OF POST	FLANGED CHANNEL			SQUARE STEEL (in)			TUBULAR ALUMINUM Ø (IN)			TUBULAR STEEL Ø (IN)				W-SHAPE STEEL					REMARKS SHSM = FHWA STANDARD HIGHWAY SIGNS AND MARKINGS BOOK	SIGN DETAIL									
		EACH	WIDTH (in)	HEIGHT (in)	"A"	"B"	SALV SIGN	SALV TIS	RETAIN	SALVAGE						ANCHOR	SLEEVE				FOUND- ATION	(LB / FT)				FTG. SIZE		WEIGHT	POST SIZE		SIGN FRAME REQUIRED	DETAIL IN SHSM	DETAIL ON SHEET NUMBER	STANDARD SHEET NUMBER						
																						(LB / FT)			(LB / FT)										(LB / FT)					
																						1.12	2.00	3.00	1.88	2.42	3.35								1.30	1.70	1.70	7.60	9.00	10.80
OPTION ITEMS																																								
STA. B 18+30 RT STARKSBORO	R		1	30	30	6.25				1																							R1-1 MOUNT SIGN ON EXISTING POST	SHSM						
	R		1	6	10	0.42																												VD-700 MOUNT SIGN ON EXISTING POST			T-44			
STA. B 21+12 LT STARKSBORO	R		1	6	10	0.42					1				8		X																	VD-700			T-44			
STA. B 31+68 RT STARKSBORO	R		1	6	10	0.42					1				7.75 8		X																		VD-700			T-44		
STA. B 33+74 RT STARKSBORO			1	30	30	6.25					1				16.75 15 16.75		X																		W2-2	SHSM				
	R		1	30	30	6.25																													W11-7	SHSM				
STA. B 38+60 RT STARKSBORO	R		1	54	12	4.50					2				10.25 30 10.00		X																		D3-1		177			
STA. B 38+80 RT STARKSBORO	R		1	24	30	5.00					1				12.25 15		X																			VR-017			T-70	
STA. B 39+25 RT STARKSBORO	R		1	30	30	6.25					1				12.25 15		X																			R1-1	SHSM			
	R		1	6	10	0.42																														VD-700			T-44	
FINAL POST LENGTHS ARE TO BE DETERMINED IN THE FIELD. POST SIZES ARE COMPUTED BASED ON INFORMATION FURNISHED ON THE STANDARD SHEETS AND THE VTRANS "SIGN POST DESIGN GUIDELINE."												FT	FT	FT	FT	FT	FT	EA	LB	LB	LB		LB	LB	LB	LB							PROJECT NAME: MIDDLEBURY-STARKSBORO PROJECT NUMBER: STP 2953(I) FILE NAME: z14V227tsss.dgn PROJECT LEADER: C.LATHROP DESIGNED BY: J. GOODALL TRAFFIC SIGN SUMMARY SHEET 34				PLOT DATE: 5/4/2017 DRAWN BY: J. GOODALL CHECKED BY: C.LATHROP SHEET 171 OF 186			
TOTALS						SF 36.18	SF	EA.	SF			FT			FT 94.00 34			LB			EA.	LB				EA.	EA.	LB												